

IHC DREDGERS BV - TSHD5500 DCI-3

CO1266

TSHD5500 DCI-3

ELECTRIC INSTALLATION

"11L" MAIN DISTRIBUTION BOARD 3X230V

 **Alewijnse Marine Systems**

ENERGIEWEG 46/c 6541 CX NIJMEGEN
P.O. BOX 6973 6503 GL NIJMEGEN
THE NETHERLANDS


TEL : +31 243716311
FAX : +31 243716310
EMAIL : am@alewijnse.nl

CUSTOMER SUPPORT


TEL : +31 243716342
EMAIL : service.amn@alewijnse.nl

No part of this work may be copied, stored or published without prior written permission of Alewijnse Marine Systems.	01		02		03		04		05		06		07		08		09		10		11		12		13		14			
	TABLE OF CONTENTS																													
	PAGE				SYSTEM								DESCRIPTION										STATUS				REV.		REV. DATE	
	11L -0				"11L" MAIN DISTRIBUTION BOARD 3X230V								TITLE PAGE										AS BUILT				1		5-12-2013	
	11L -1				"11L" MAIN DISTRIBUTION BOARD 3X230V								TABLE OF CONTENTS										AS BUILT				1		5-12-2013	
	11L -1.a				"11L" MAIN DISTRIBUTION BOARD 3X230V								TABLE OF CONTENTS										AS BUILT				1		5-12-2013	
	11L -10				"11L" MAIN DISTRIBUTION BOARD 3X230V								INCOMING FEEDER PS MAIN CIRCUIT										AS BUILT				1		5-12-2013	
	11L -11				"11L" MAIN DISTRIBUTION BOARD 3X230V								INCOMING FEEDER PS CONTROL CIRCUIT										AS BUILT				1		5-12-2013	
	11L -12				"11L" MAIN DISTRIBUTION BOARD 3X230V								INCOMING FEEDER PS MEASURING AND PROTECTION										AS BUILT				1		5-12-2013	
	11L -13				"11L" MAIN DISTRIBUTION BOARD 3X230V								INCOMING FEEDER PS SIGNALING										AS BUILT				1		5-12-2013	
	11L -15				"11L" MAIN DISTRIBUTION BOARD 3X230V								DISTRIBUTION GROUPS										AS BUILT				1		5-12-2013	
	11L -16				"11L" MAIN DISTRIBUTION BOARD 3X230V								DISTRIBUTION GROUPS										AS BUILT				1		5-12-2013	
	11L -17				"11L" MAIN DISTRIBUTION BOARD 3X230V								DISTRIBUTION GROUPS										AS BUILT				1		5-12-2013	
	11L -18				"11L" MAIN DISTRIBUTION BOARD 3X230V								DISTRIBUTION GROUPS										AS BUILT				1		5-12-2013	
	11L -19				"11L" MAIN DISTRIBUTION BOARD 3X230V								DISTRIBUTION GROUPS										AS BUILT				1		5-12-2013	
	11L -20				"11L" MAIN DISTRIBUTION BOARD 3X230V								DISTRIBUTION GROUPS										AS BUILT				1		5-12-2013	
	11L -21				"11L" MAIN DISTRIBUTION BOARD 3X230V								DISTRIBUTION GROUPS										AS BUILT				1		5-12-2013	
	11L -22				"11L" MAIN DISTRIBUTION BOARD 3X230V								DISTRIBUTION GROUPS										AS BUILT				1		5-12-2013	
	11L -23				"11L" MAIN DISTRIBUTION BOARD 3X230V								DISTRIBUTION GROUPS										AS BUILT				1		5-12-2013	
	11L -24				"11L" MAIN DISTRIBUTION BOARD 3X230V								DISTRIBUTION GROUPS										AS BUILT				1		5-12-2013	
	11L -25				"11L" MAIN DISTRIBUTION BOARD 3X230V								DISTRIBUTION GROUPS										AS BUILT				1		5-12-2013	
	11L -26				"11L" MAIN DISTRIBUTION BOARD 3X230V								DISTRIBUTION GROUPS										AS BUILT				1		5-12-2013	
	11L -27				"11L" MAIN DISTRIBUTION BOARD 3X230V								DISTRIBUTION GROUPS										AS BUILT				1		5-12-2013	
	11L -30				"11L" MAIN DISTRIBUTION BOARD 3X230V								BUSTIE MAIN CIRCUIT										AS BUILT				1		5-12-2013	
	11L -31				"11L" MAIN DISTRIBUTION BOARD 3X230V								BUSTIE INCOMING 24VDC MAIN CIRCUIT										AS BUILT				1		5-12-2013	
	11L -32				"11L" MAIN DISTRIBUTION BOARD 3X230V								BUSTIE VOLTAGE CONTROL										AS BUILT				1		5-12-2013	
	11L -33				"11L" MAIN DISTRIBUTION BOARD 3X230V								BUSTIE CONTROL CIRCUIT										AS BUILT				1		5-12-2013	
	11L -34				"11L" MAIN DISTRIBUTION BOARD 3X230V								BUSTIE SIGNALING										AS BUILT				1		5-12-2013	
	11L -35				"11L" MAIN DISTRIBUTION BOARD 3X230V								VENTILATION / LIGHTING / HEATING										AS BUILT				1		5-12-2013	
	11L -36				"11L" MAIN DISTRIBUTION BOARD 3X230V								OUTDOOR LIGHTING CONTROL CIRCUIT										AS BUILT				1		5-12-2013	
	11L -37				"11L" MAIN DISTRIBUTION BOARD 3X230V								OUTDOOR LIGHTING CONTROL CIRCUIT										AS BUILT				1		5-12-2013	
	11L -40				"11L" MAIN DISTRIBUTION BOARD 3X230V								DISTRIBUTION GROUPS										AS BUILT				1		5-12-2013	
	11L -41				"11L" MAIN DISTRIBUTION BOARD 3X230V								DISTRIBUTION GROUPS										AS BUILT				1		5-12-2013	
	11L -42				"11L" MAIN DISTRIBUTION BOARD 3X230V								EXHAUST FAN SANITARY SPACE AFT SHIP - E9 CONTROL CIRCUIT										AS BUILT				1		5-12-2013	
	11L -43				"11L" MAIN DISTRIBUTION BOARD 3X230V								EXHAUST FAN PAINT STORE - E8 CONTROL CIRCUIT										AS BUILT				1		5-12-2013	
	11L -44				"11L" MAIN DISTRIBUTION BOARD 3X230V								DISTRIBUTION GROUPS										AS BUILT				1		5-12-2013	
	11L -45				"11L" MAIN DISTRIBUTION BOARD 3X230V								DISTRIBUTION GROUPS										AS BUILT				1		5-12-2013	
	11L -46				"11L" MAIN DISTRIBUTION BOARD 3X230V								DISTRIBUTION GROUPS										AS BUILT				1		5-12-2013	
	11L -47				"11L" MAIN DISTRIBUTION BOARD 3X230V								DISTRIBUTION GROUPS										AS BUILT				1		5-12-2013	
	11L -48				"11L" MAIN DISTRIBUTION BOARD 3X230V								DISTRIBUTION GROUPS										AS BUILT				1		5-12-2013	
	11L -49				"11L" MAIN DISTRIBUTION BOARD 3X230V								DISTRIBUTION GROUPS										AS BUILT				1		5-12-2013	
	11L -50				"11L" MAIN DISTRIBUTION BOARD 3X230V								DISTRIBUTION GROUPS										AS BUILT				1		5-12-2013	
	11L -51				"11L" MAIN DISTRIBUTION BOARD 3X230V								DISTRIBUTION GROUPS										AS BUILT				1		5-12-2013	
	< 0																													
	1.a >																													
	D	24-1-2011		PVR								IHC DREDGERS BV - TSHD5500 DCI-3 "11L" MAIN DISTRIBUTION BOARD 3X230V TABLE OF CONTENTS										Yard no : CO1266								
	M	5-12-2013		IEN		REV 1																Project : 23000143								
	STAT	AS BUILT																				Class : LROS/IRS								
		05-12-2013		IEN		CHK																Page : 11L -1								

No part of this work may be copied, stored or published without prior written permission of Alewijnse Marine Systems.

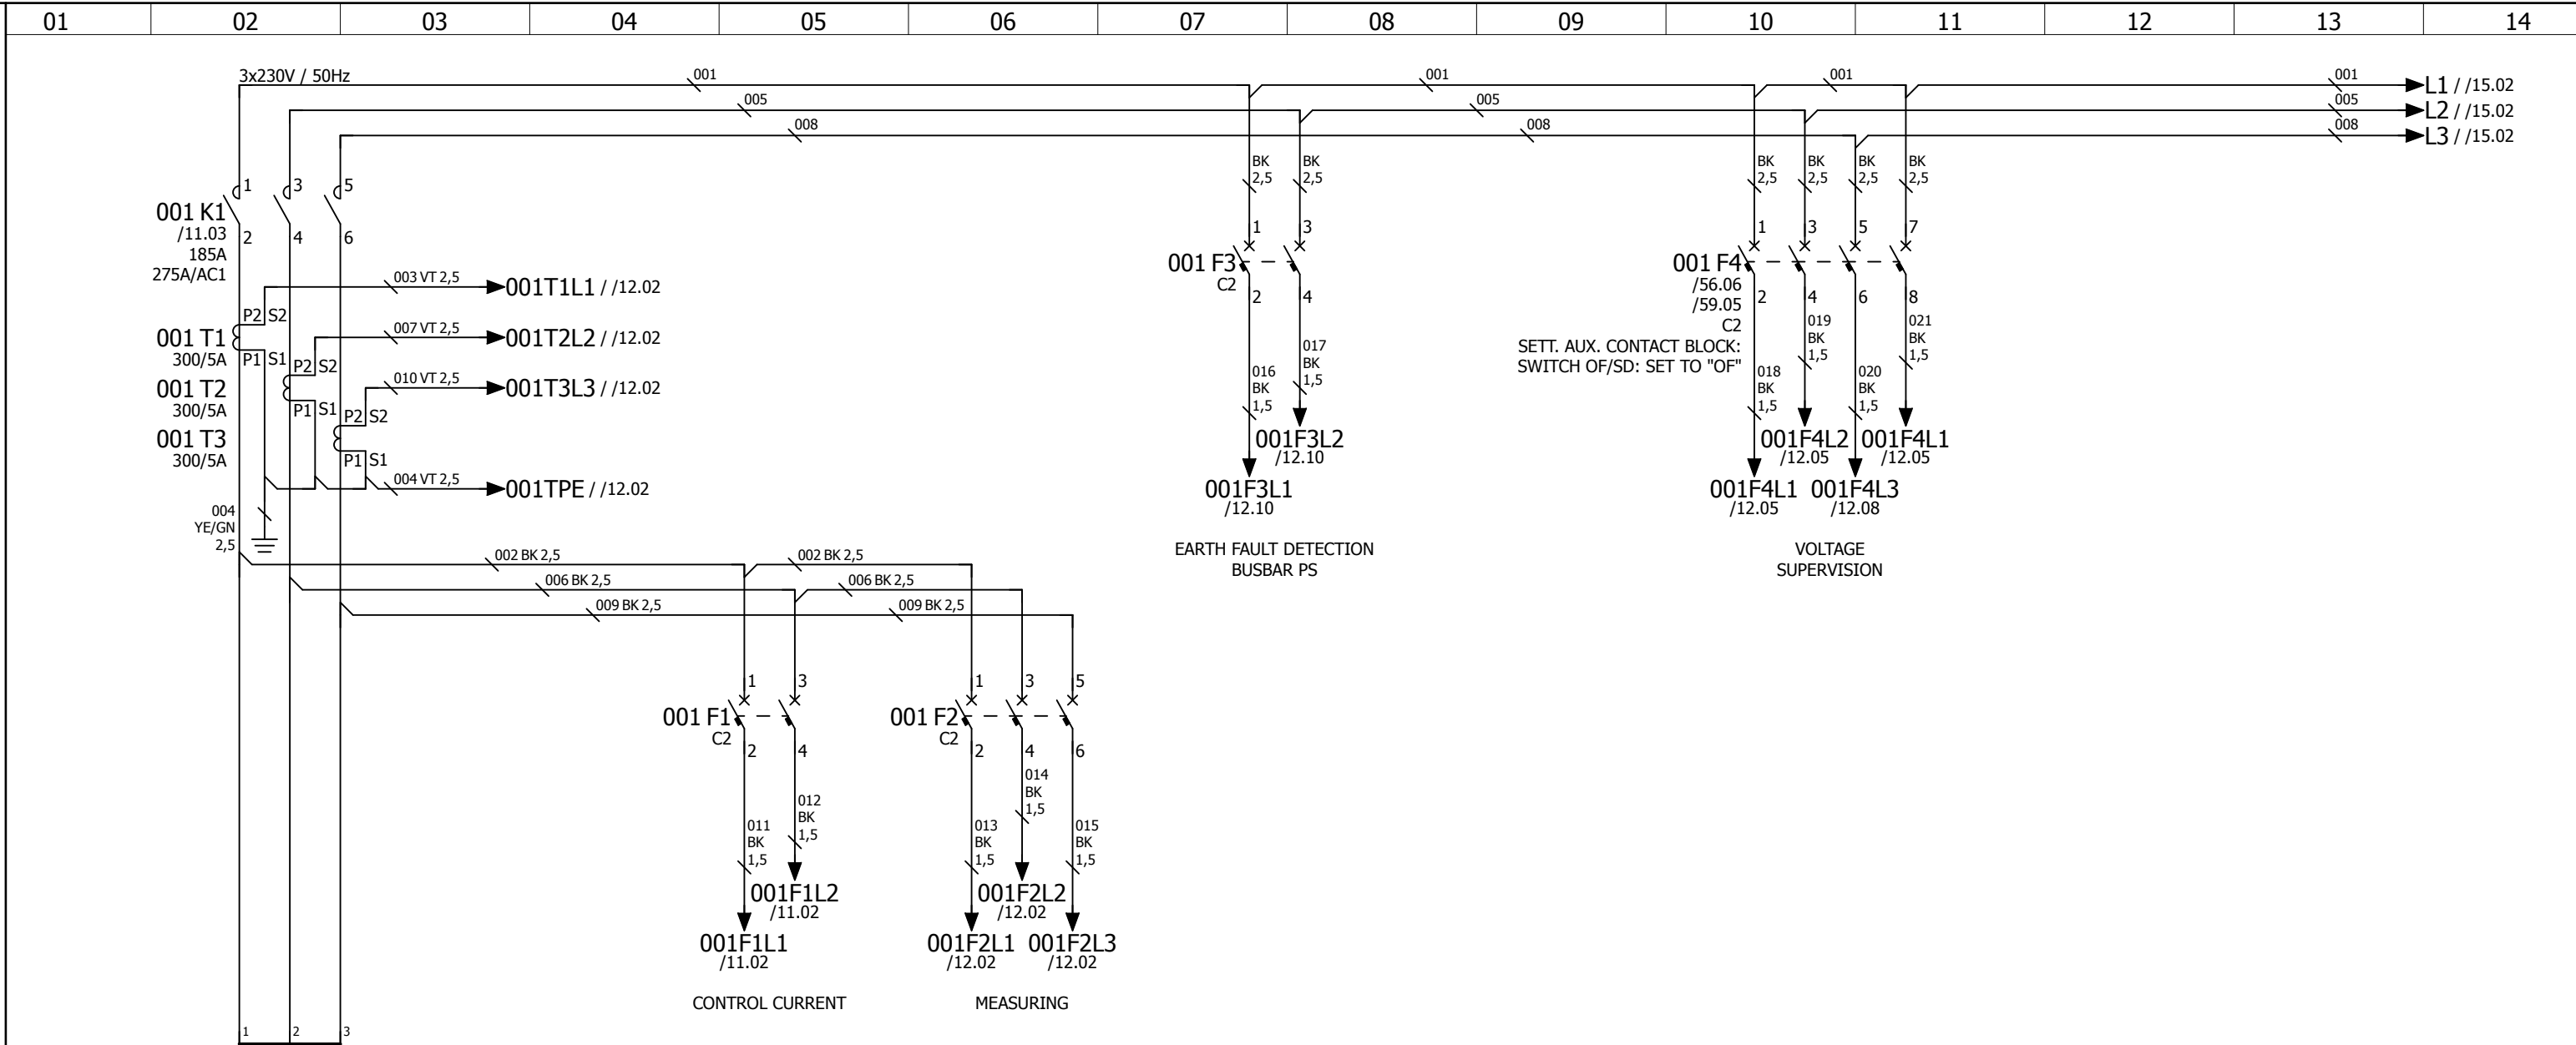


No part of this work may be copied, stored or published without prior written permission of Alewijnse Marine Systems.

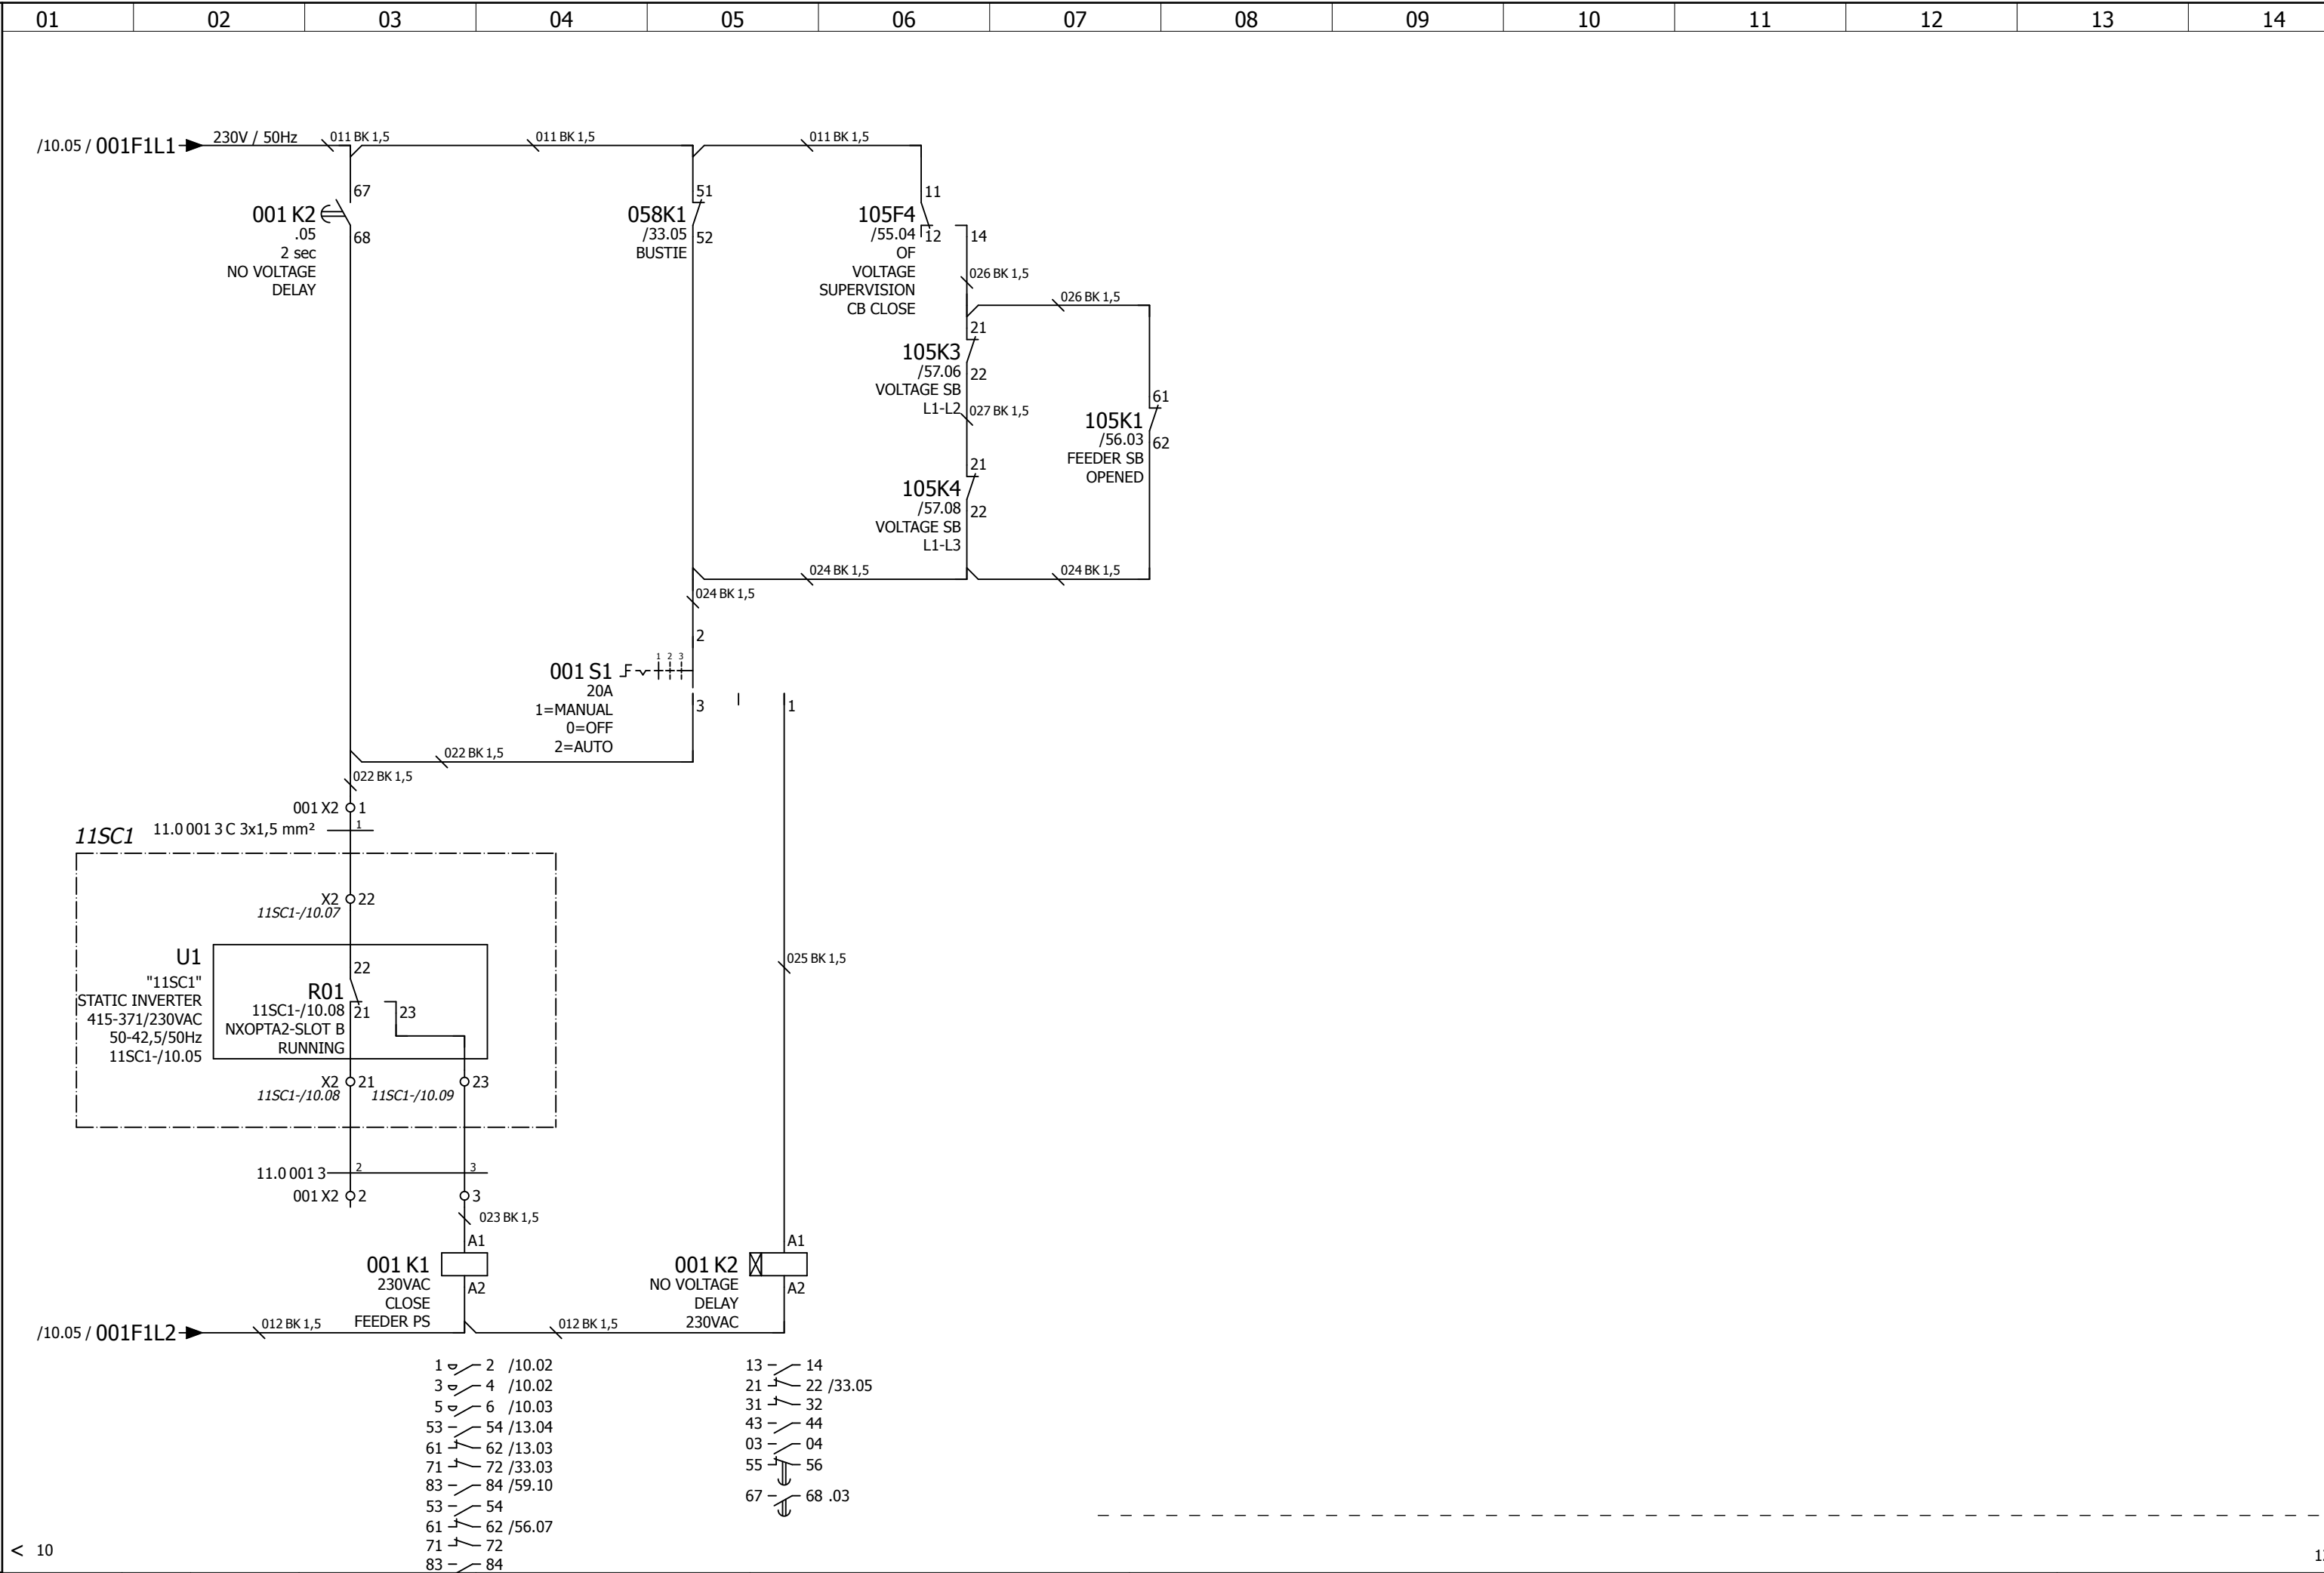



D	24-1-2011	PVR			* NO DELIVERY ALEWIJNSE			ALEWIJNSE MARINE B.V. ENERGIEWEG 46/C 6541 CX NIJMEGEN	IHC DREDGERS BV - TSHD5500 DCI-3 "11L" MAIN DISTRIBUTION BOARD 3X230V INCOMING FEEDER PS CONTROL CIRCUIT SECTION 1	Yard no : CO1266
M	5-12-2013	IEN	REV	1	PANEL IP23					Project : 23000143
STAT	AS BUILT									Class : LROS/IRS
	05-12-2013	IEN	CHK							Page : 11L -11

No part of this work may be copied, stored or published without prior written permission of Alewijnse Marine Systems.

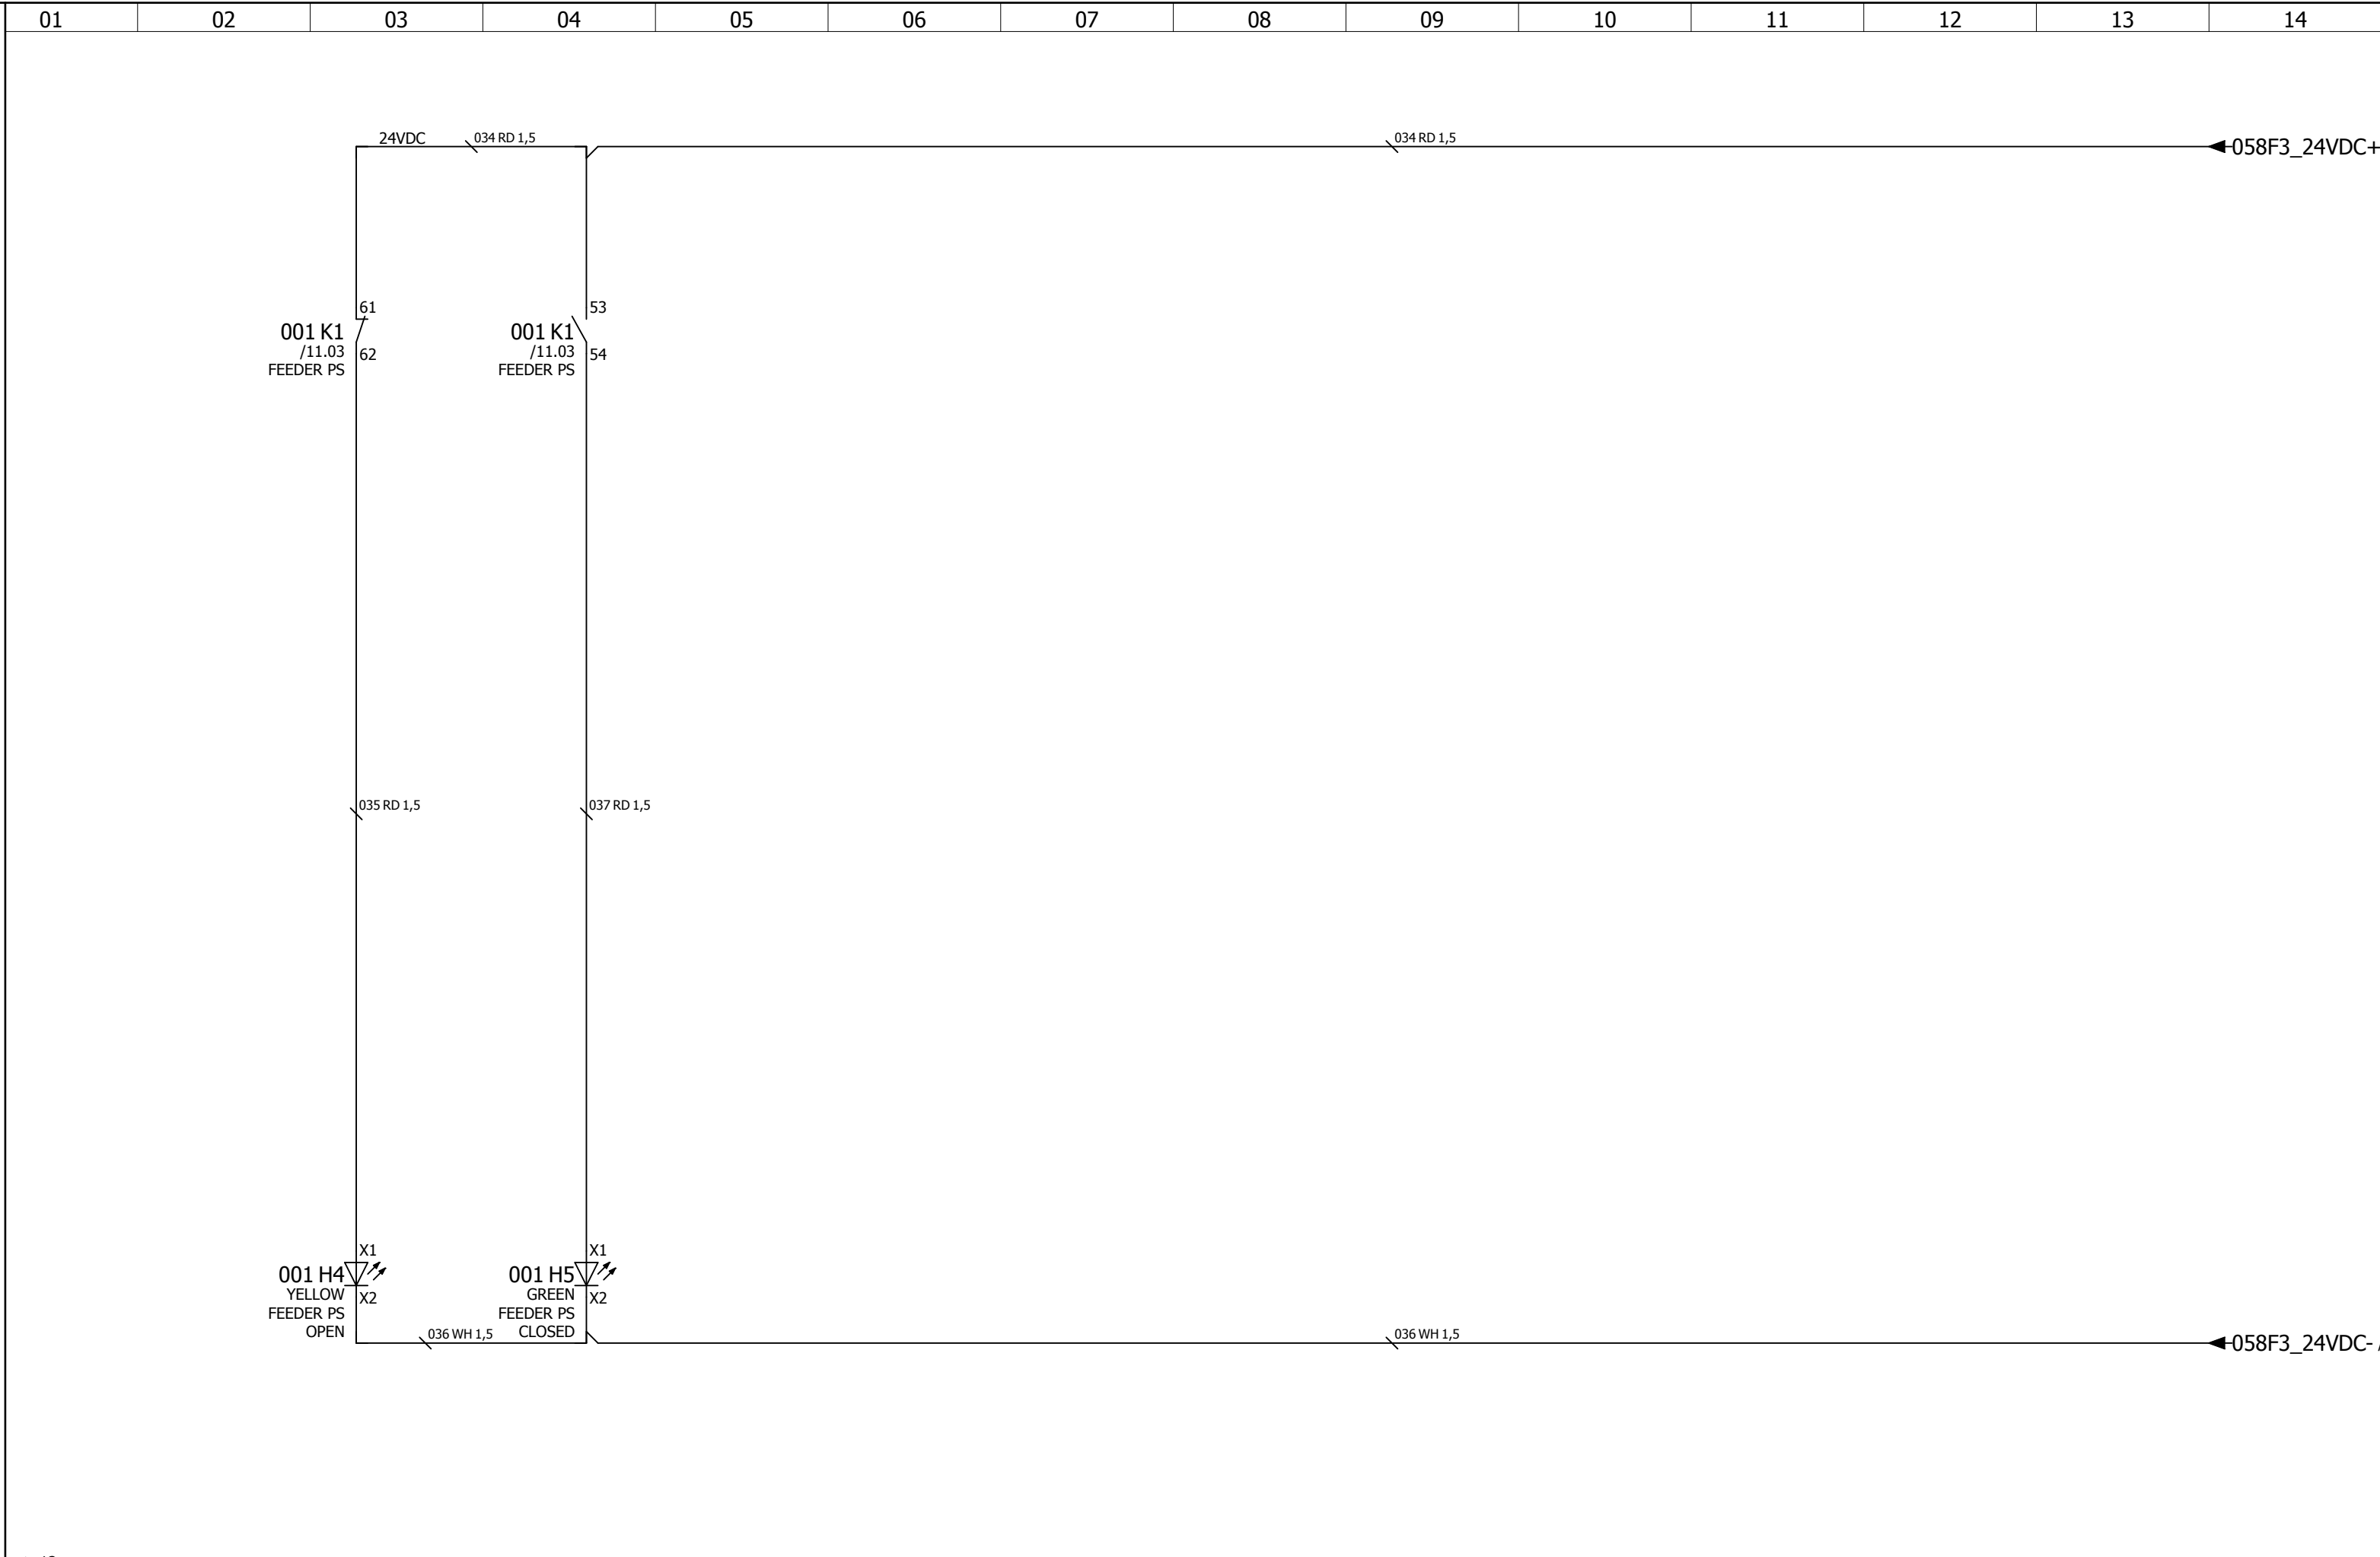


STAT	D	24-1-2011	PVR			* NO DELIVERY ALEWIJNSE			ALEWIJNSE MARINE B.V. ENERGIEWEG 46/C 6541 CX NIJMEGEN	IHC DREDGERS BV - TSHD5500 DCI-3 "11L" MAIN DISTRIBUTION BOARD 3X230V INCOMING FEEDER PS SIGNALING SECTION 1	Yard no : CO1266			
	M	5-12-2013	IEN	REV	1						Project : 23000143			
	AS BUILT										PANEL IP23		Class : LROS/IRS	
		05-12-2013	IEN	CHK							Page : 11L -13			

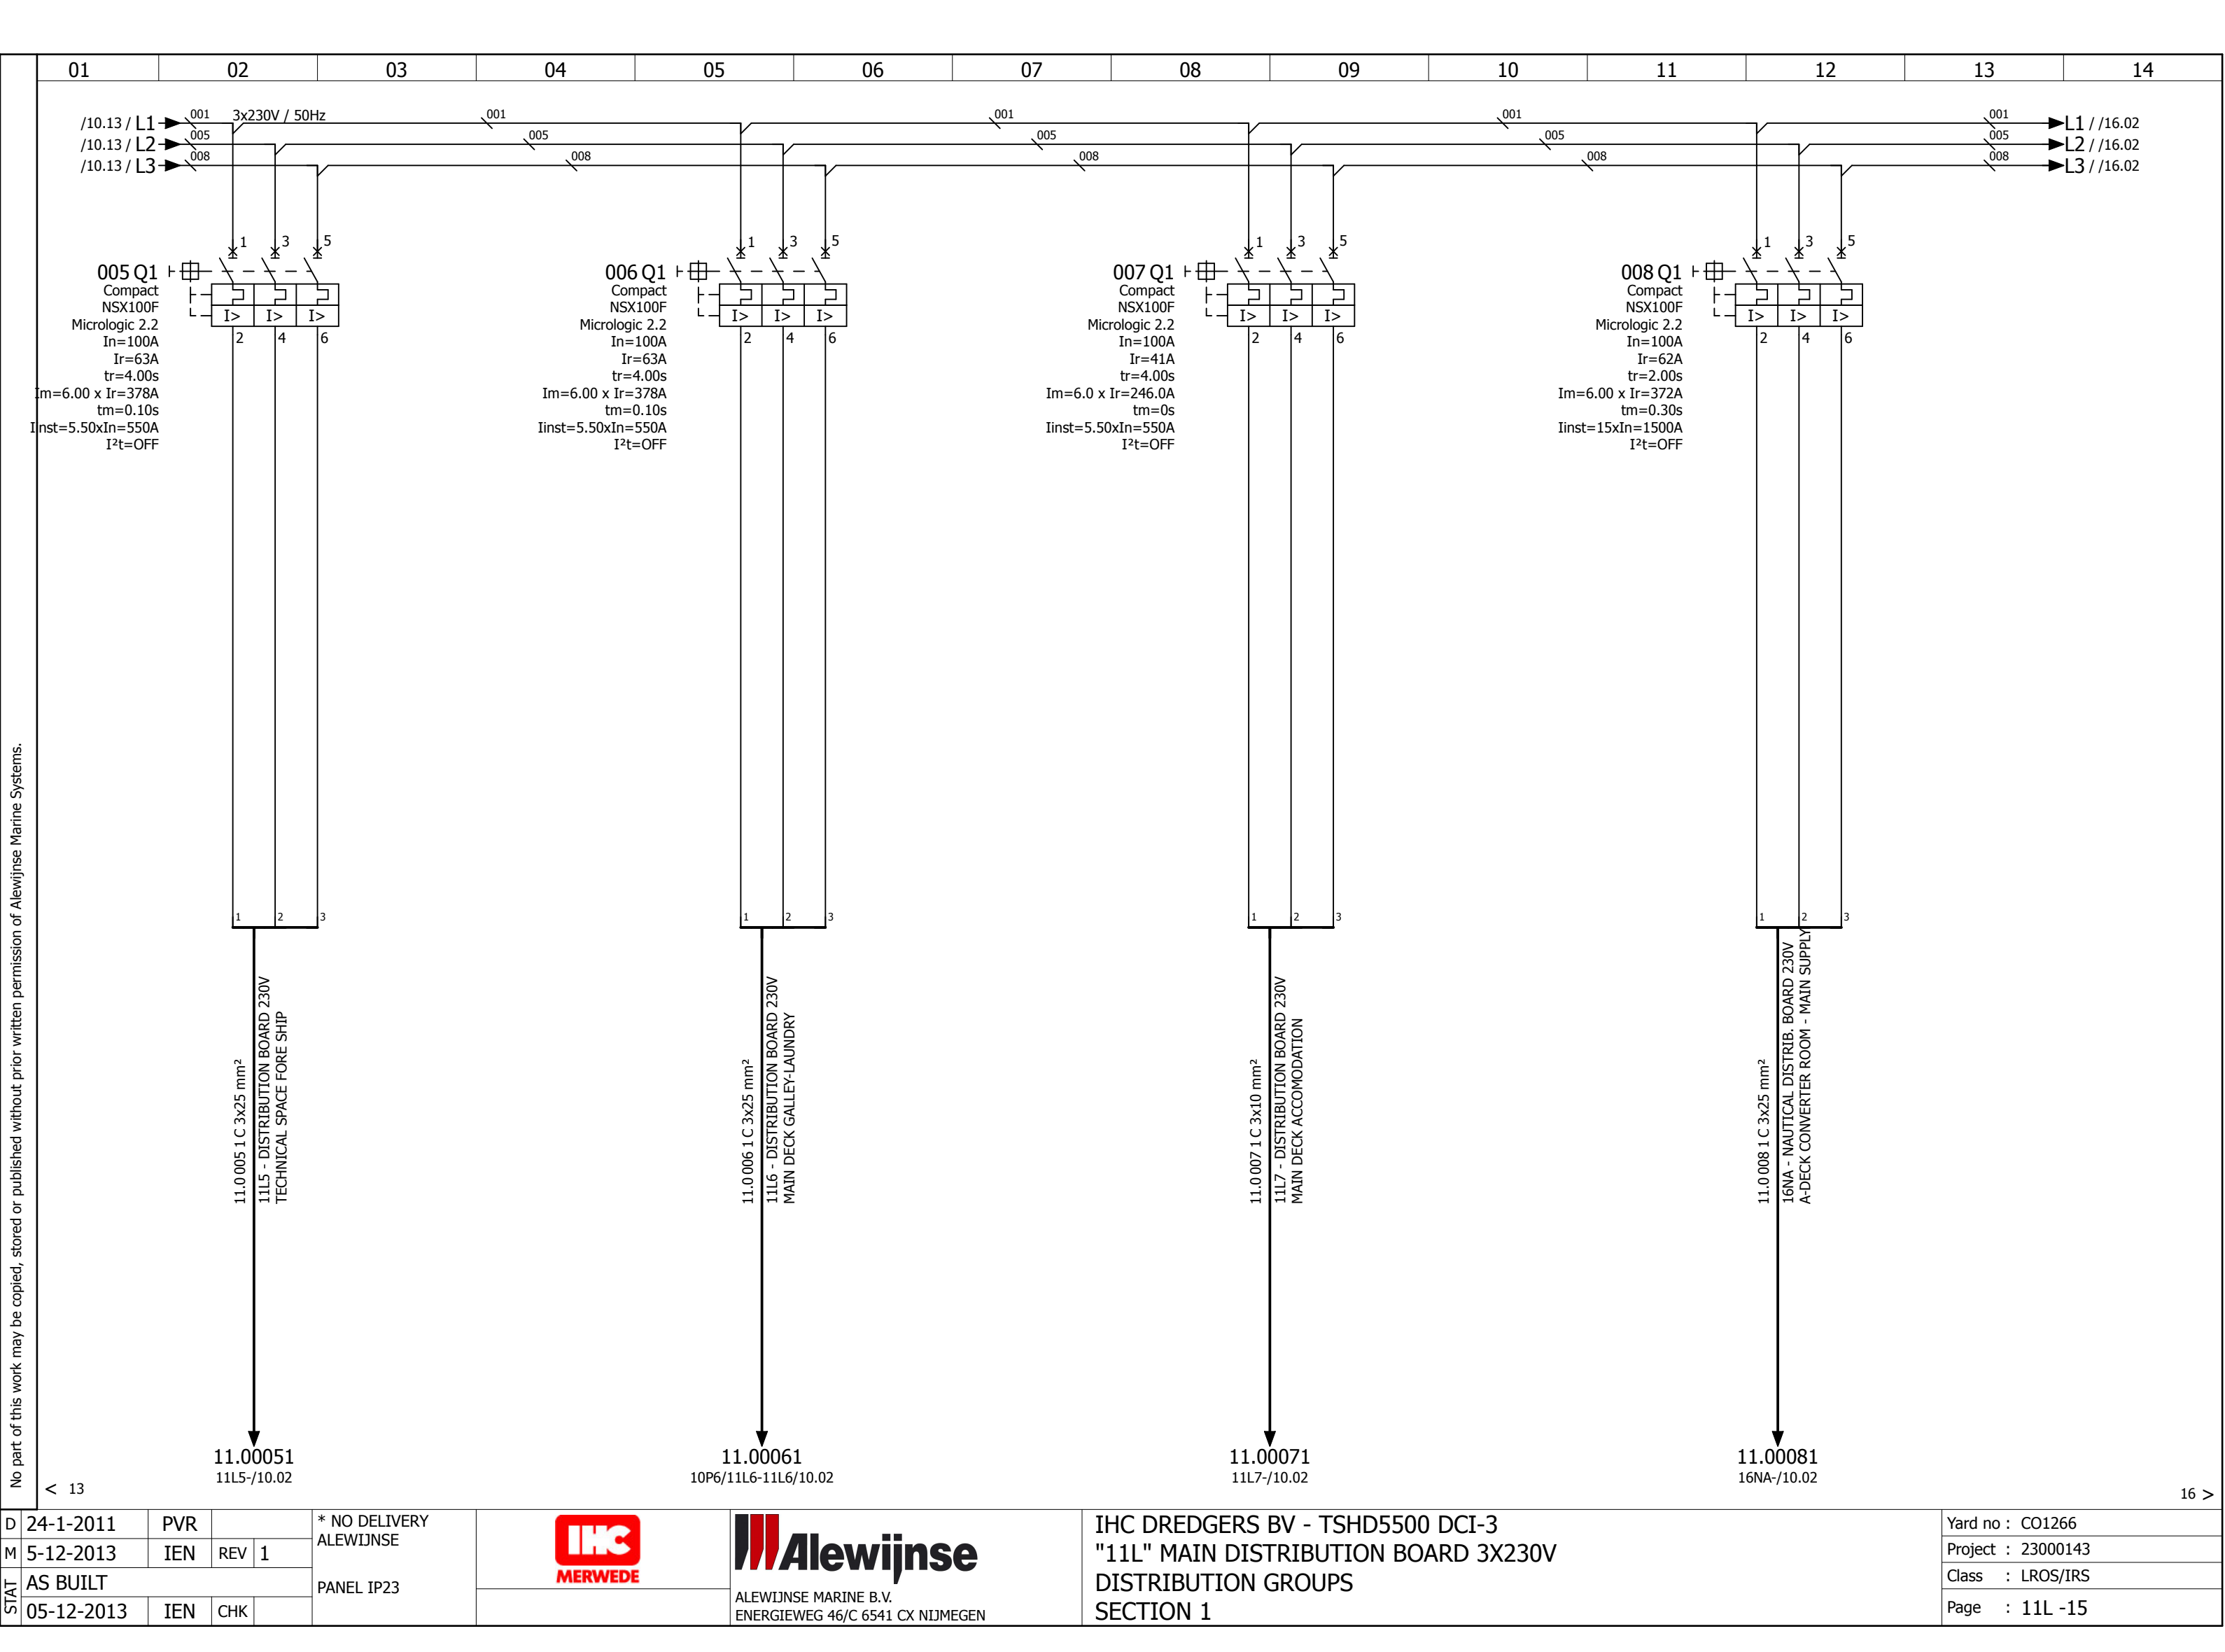

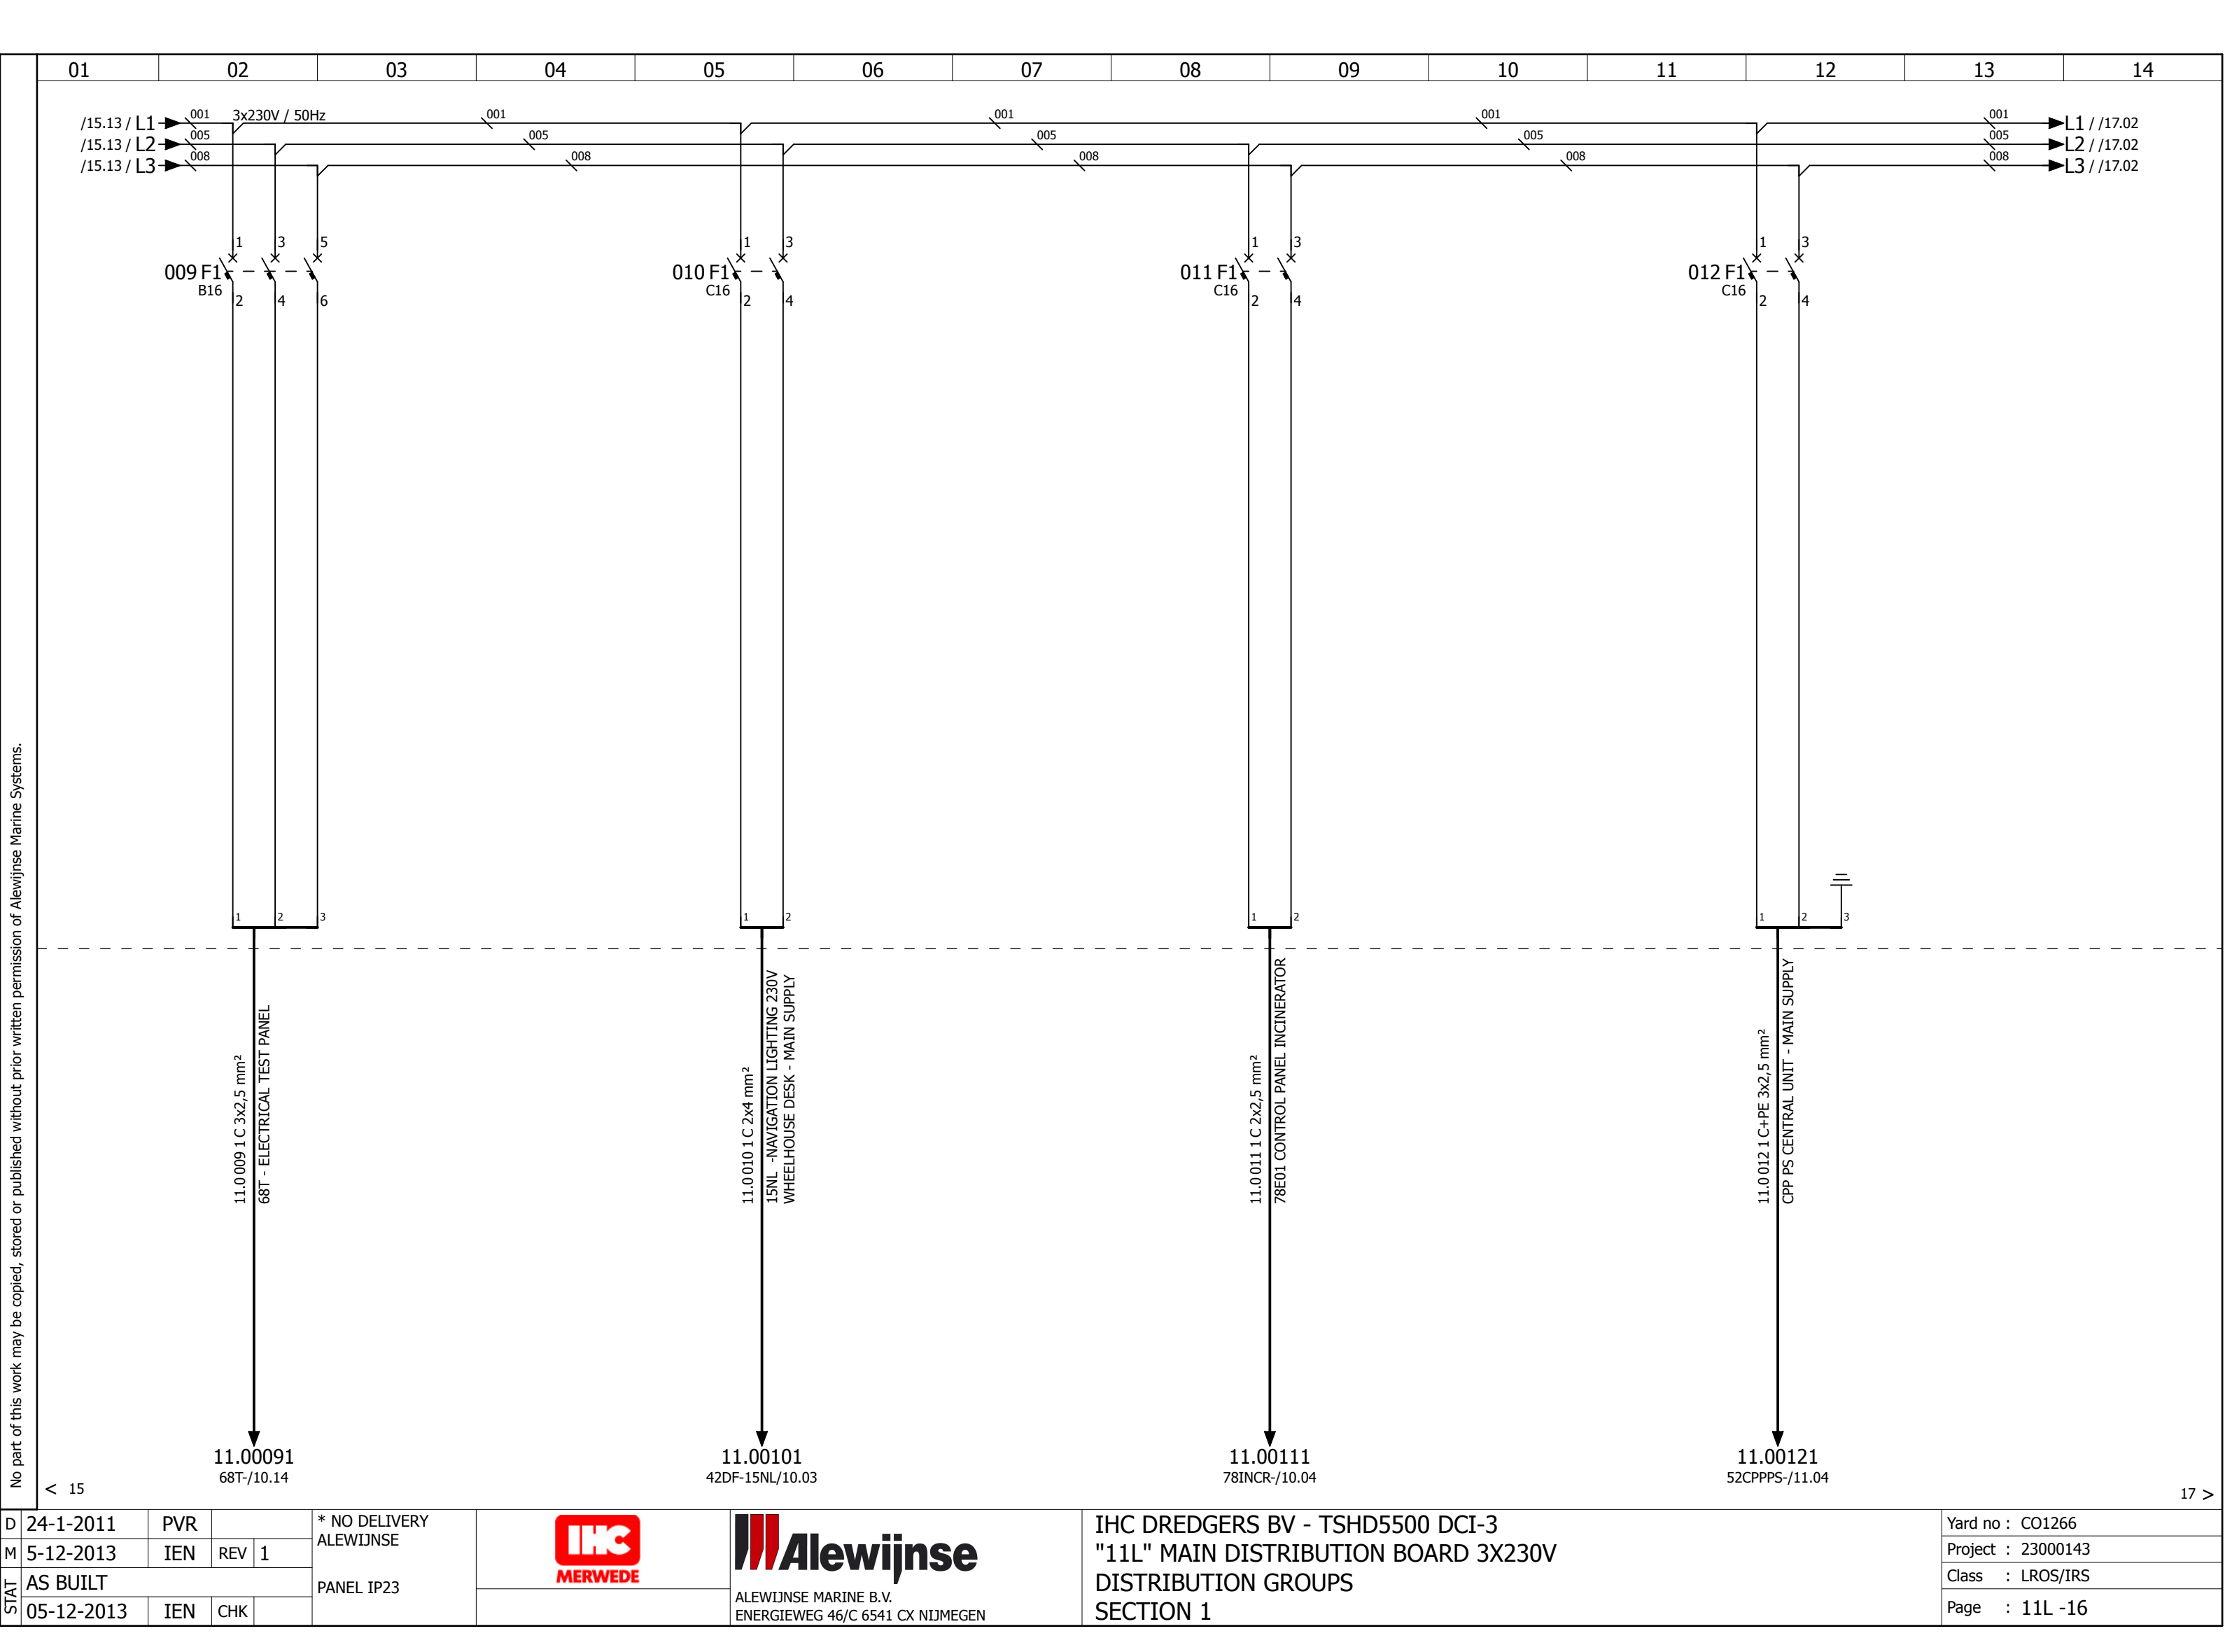


D	24-1-2011	PVR			* NO DELIVERY ALEWIJNSE			ALEWIJNSE MARINE B.V. ENERGIEWEG 46/C 6541 CX NIJMEGEN	IHC DREDGERS BV - TSHD5500 DCI-3 "11L" MAIN DISTRIBUTION BOARD 3X230V DISTRIBUTION GROUPS SECTION 1	Yard no : CO1266
M	5-12-2013	IEN	REV	1						Project : 23000143
STAT	AS BUILT				PANEL IP23		Class : LROS/IRS			
	05-12-2013	IEN	CHK				Page : 11L -16			

No part of this work may be copied, stored or published without prior written permission of Alewijnse Marine Systems.

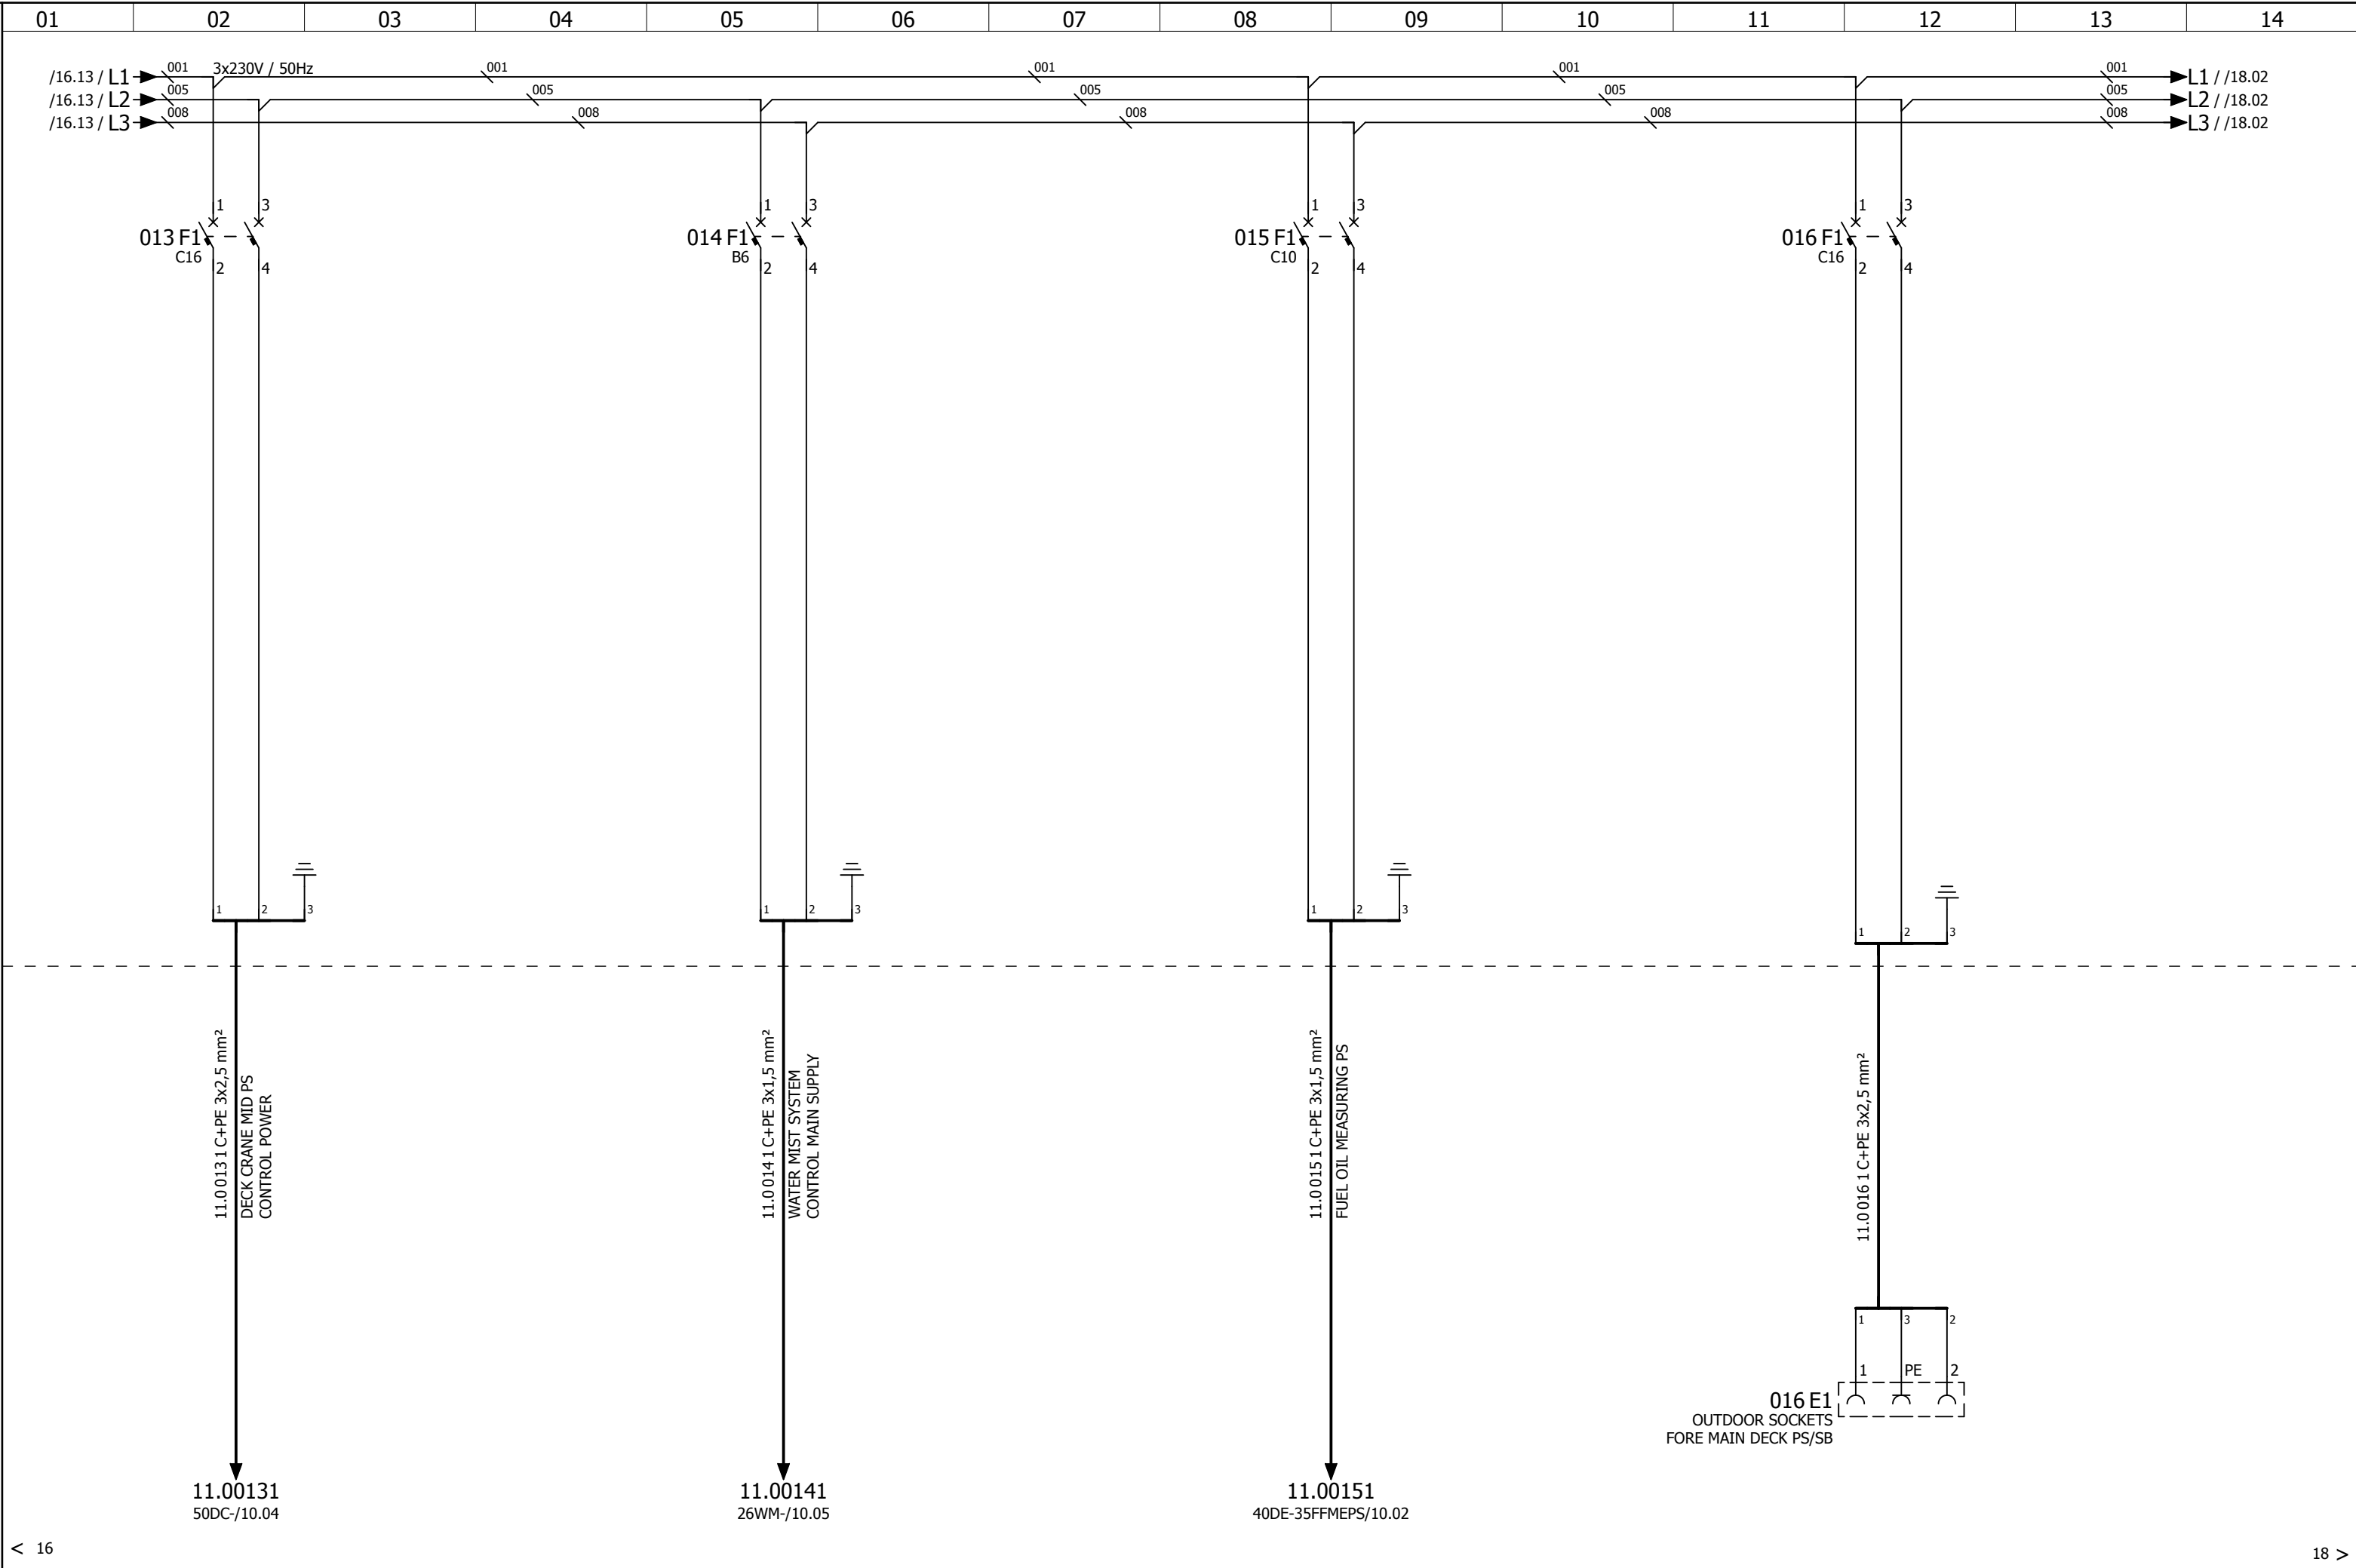

STAT	D	24-1-2011	PVR			* NO DELIVERY ALEWIJNSE		 ALEWIJNSE MARINE B.V. ENERGIEWEG 46/C 6541 CX NIJMEGEN	IHC DREDGERS BV - TSHD5500 DCI-3 "11L" MAIN DISTRIBUTION BOARD 3X230V DISTRIBUTION GROUPS SECTION 1	Yard no : CO1266	
	M	5-12-2013	IEN	REV	1					Project : 23000143	
	AS BUILT					PANEL IP23	Class : LROS/IRS				
		05-12-2013	IEN	CHK			Page : 11L -17				


No part of this work may be copied, stored or published without prior written permission of Alewijnse Marine Systems.

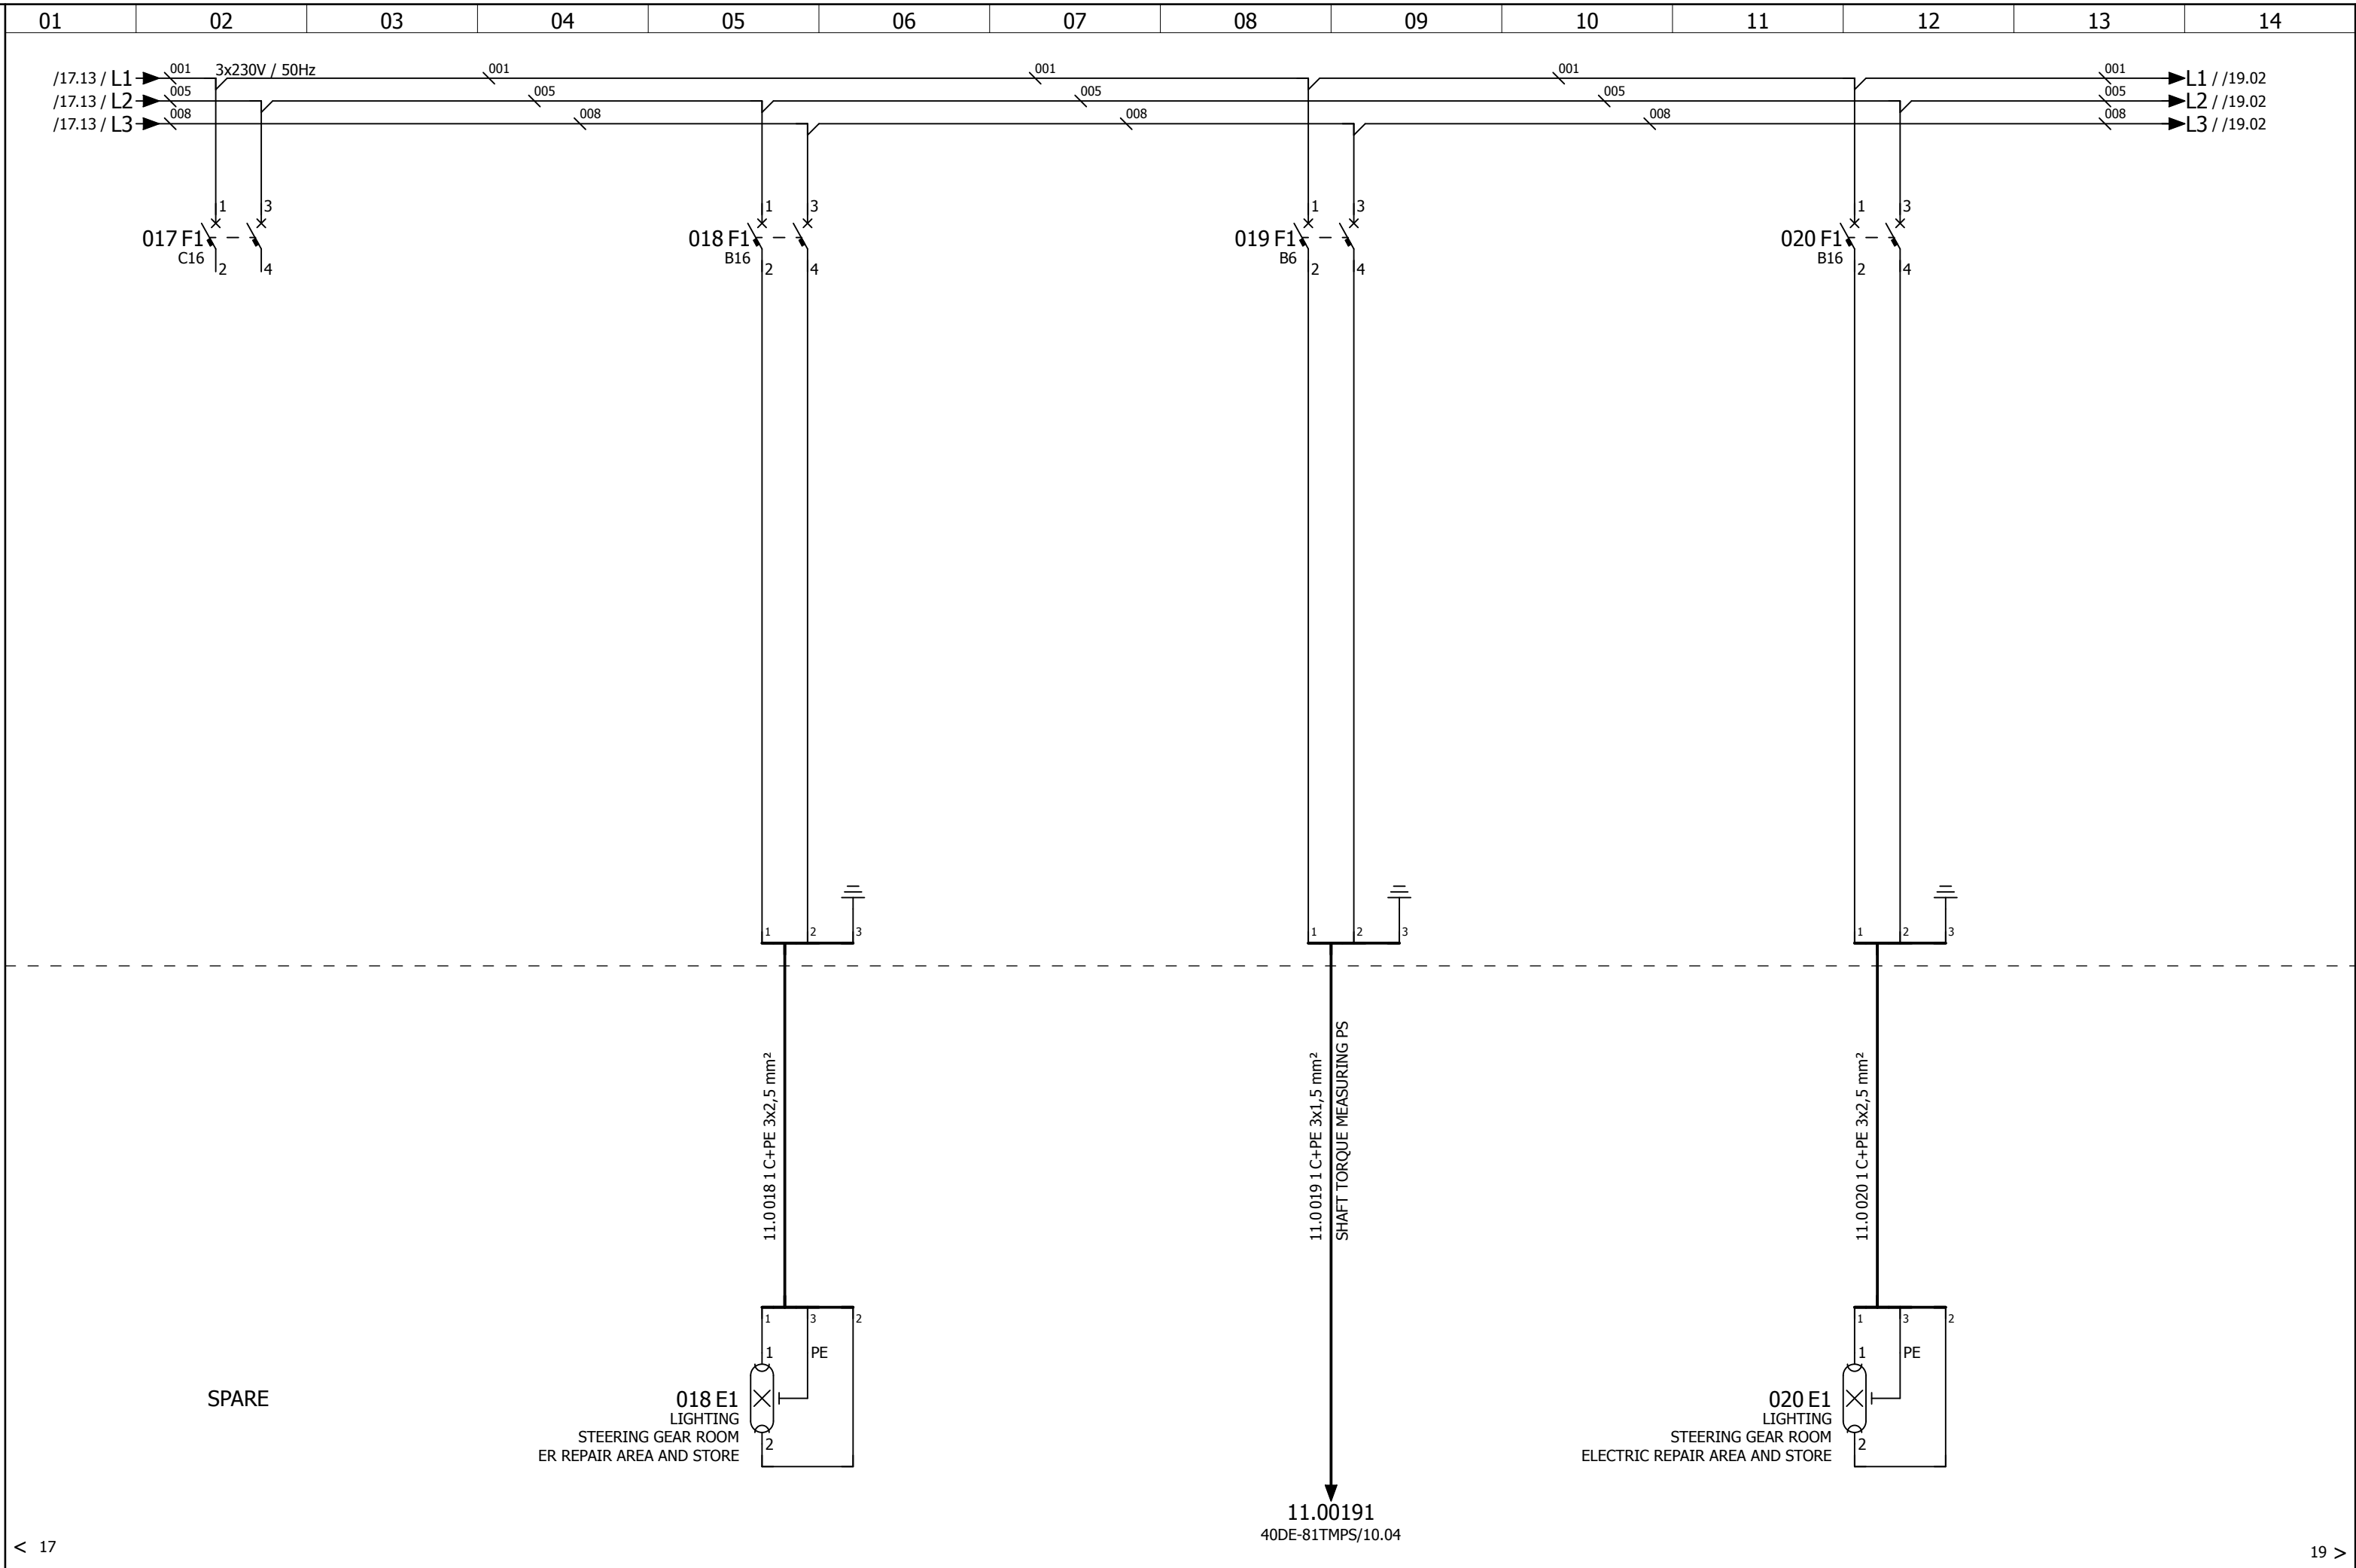

D	24-1-2011	PVR		* NO DELIVERY ALEWIJNSE			ALEWIJNSE MARINE B.V. ENERGIEWEG 46/C 6541 CX NIJMEGEN	IHC DREDGERS BV - TSHD5500 DCI-3 "11L" MAIN DISTRIBUTION BOARD 3X230V DISTRIBUTION GROUPS SECTION 1	Yard no : CO1266
M	5-12-2013	IEN	REV 1						Project : 23000143
STAT	AS BUILT				PANEL IP23				Class : LROS/IRS
	05-12-2013	IEN	CHK						Page : 11L -18



STAT	D	24-1-2011	PVR			* NO DELIVERY			ALEWIJNSE MARINE B.V. ENERGIEWEG 46/C 6541 CX NIJMEGEN	IHC DREDGERS BV - TSHD5500 DCI-3 "11L" MAIN DISTRIBUTION BOARD 3X230V DISTRIBUTION GROUPS SECTION 1	Yard no : CO1266
	M	5-12-2013	IEN	REV	1	ALEWIJNSE					Project : 23000143
	AS BUILT					PANEL IP23					Class : LROS/IRS
		05-12-2013	IEN	CHK							Page : 11L -19

No part of this work may be copied, stored or published without prior written permission of Alewijnse Marine Systems.

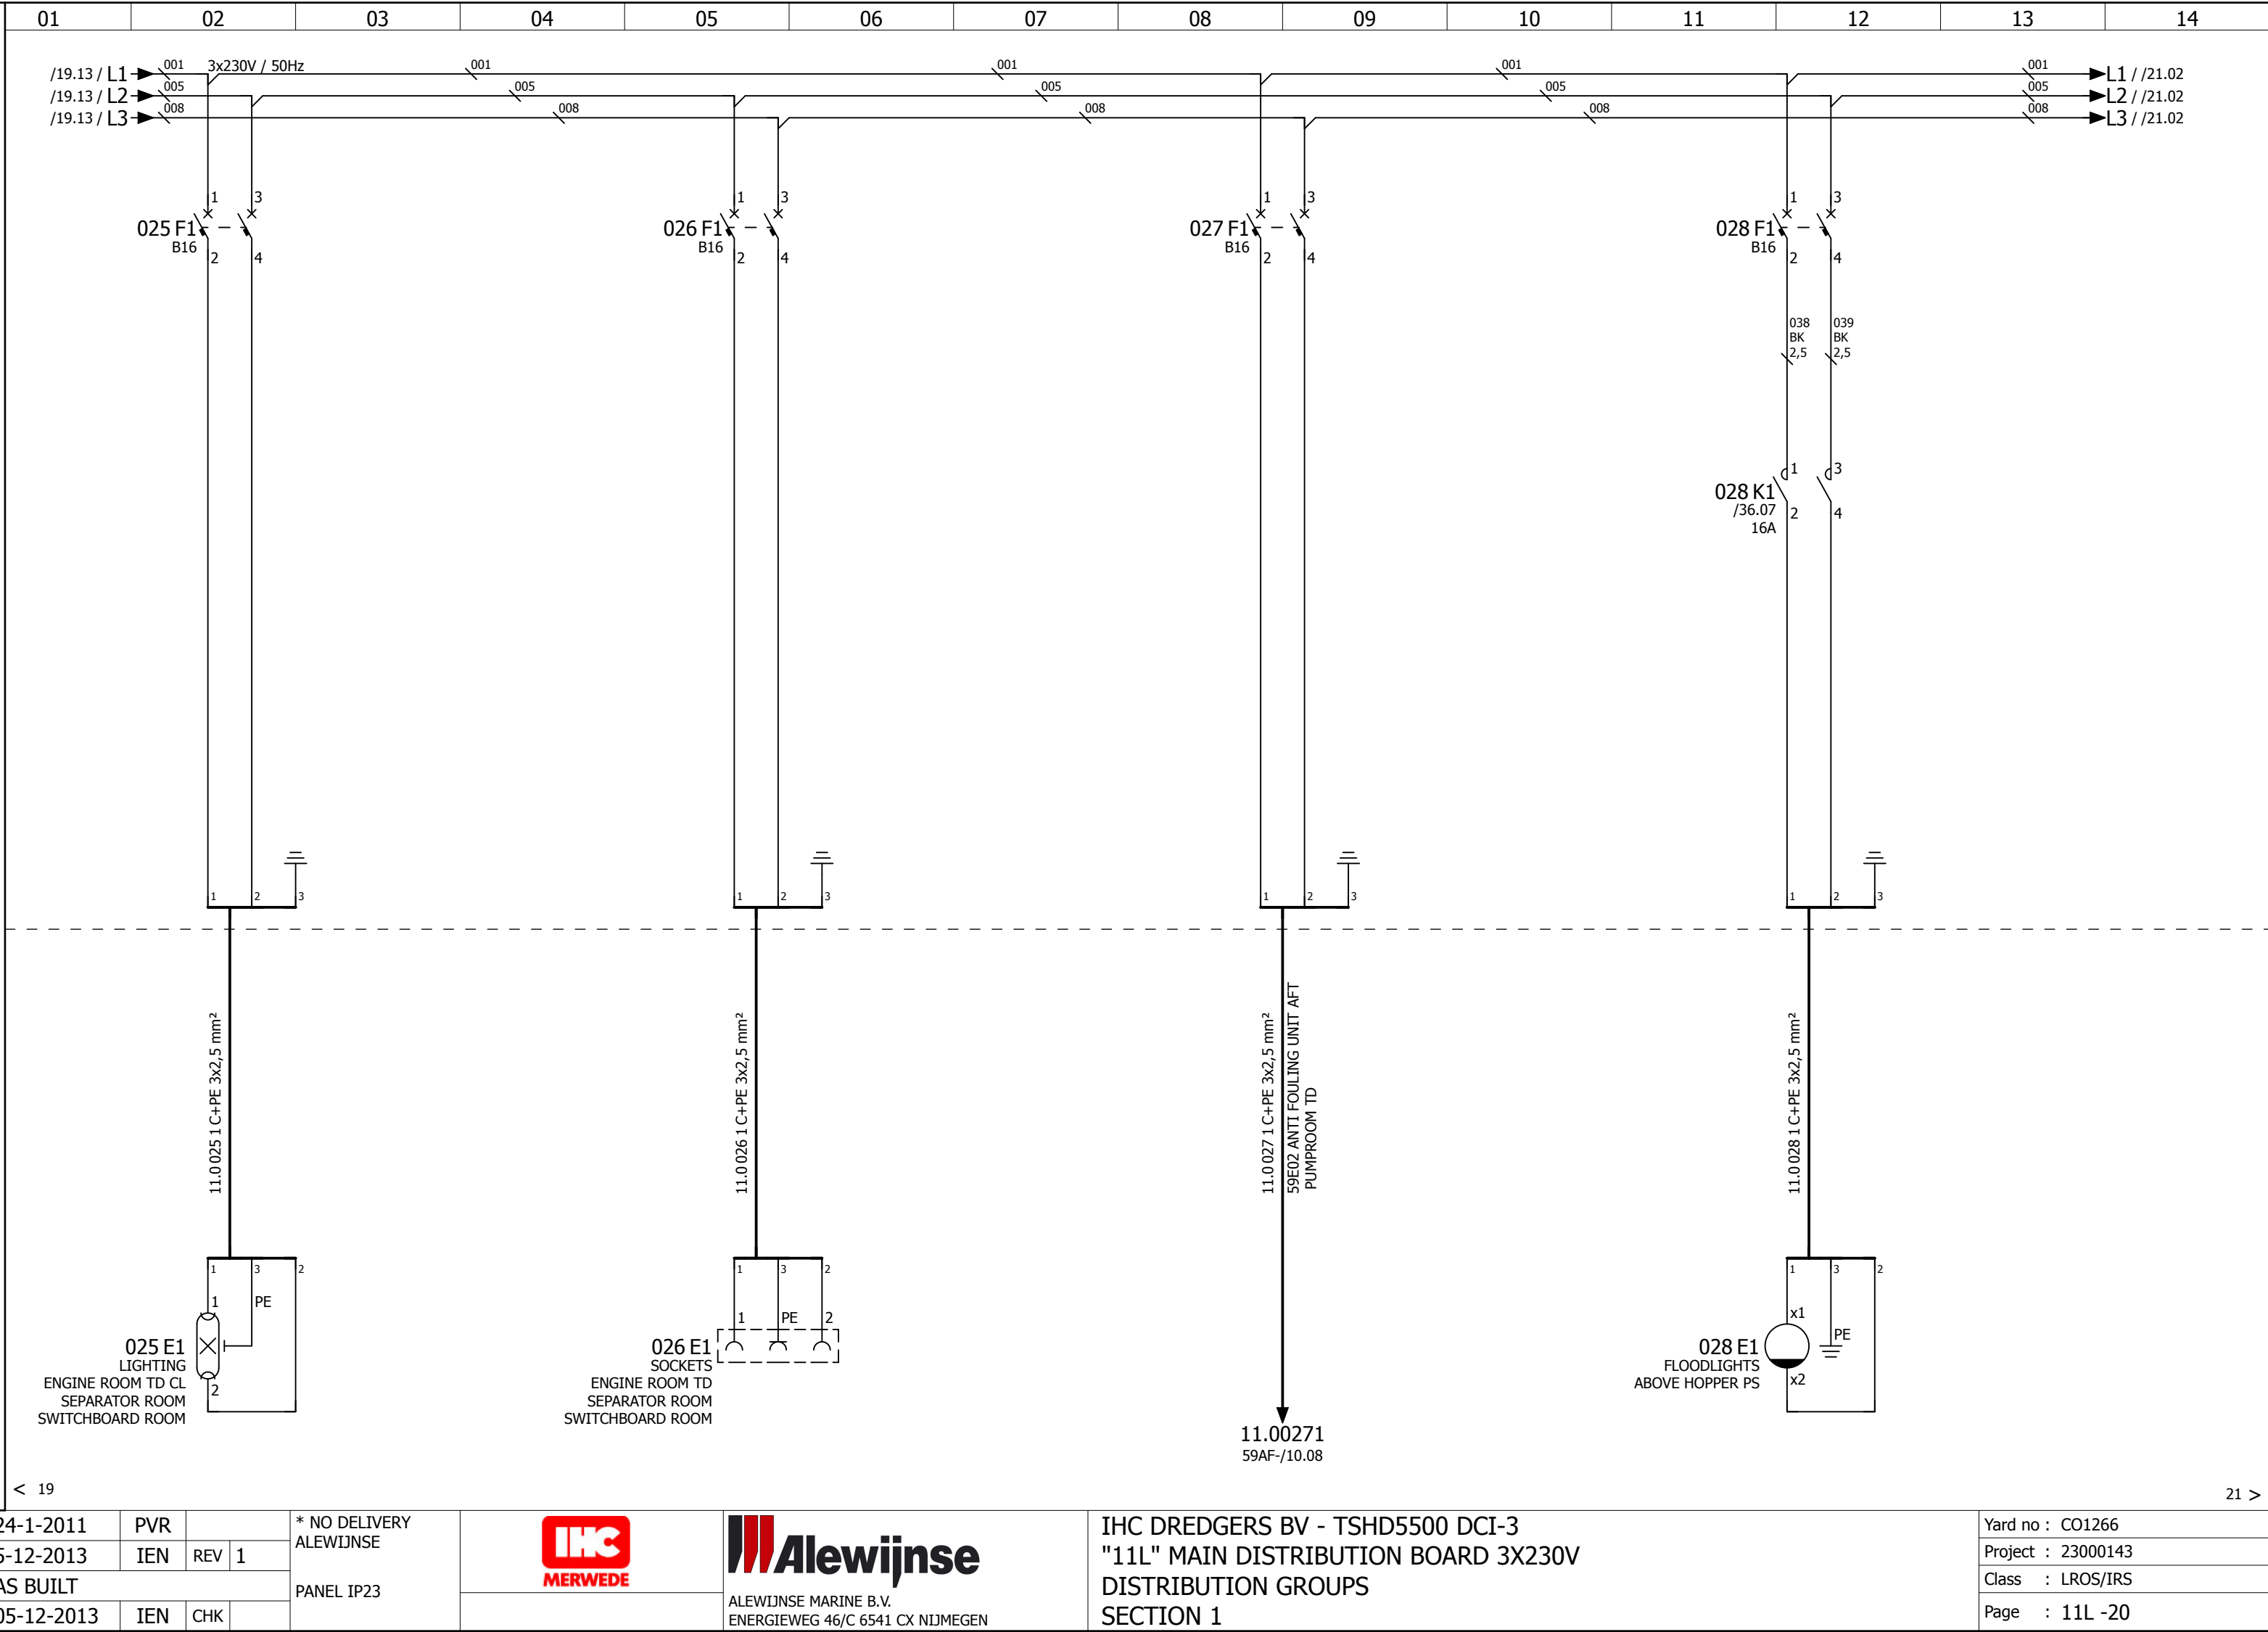



D	24-1-2011	PVR		* NO DELIVERY ALEWIJNSE			ALEWIJNSE MARINE B.V. ENERGIEWEG 46/C 6541 CX NIJMEGEN	IHC DREDGERS BV - TSHD5500 DCI-3 "11L" MAIN DISTRIBUTION BOARD 3X230V DISTRIBUTION GROUPS SECTION 1	Yard no : CO1266				
M	5-12-2013	IEN	REV	1					Project : 23000143				
STAT	AS BUILT				PANEL IP23				Class : LROS/IRS				
	05-12-2013	IEN	CHK						Page : 11L -20				

No part of this work may be copied, stored or published without prior written permission of Alewijnse Marine Systems.

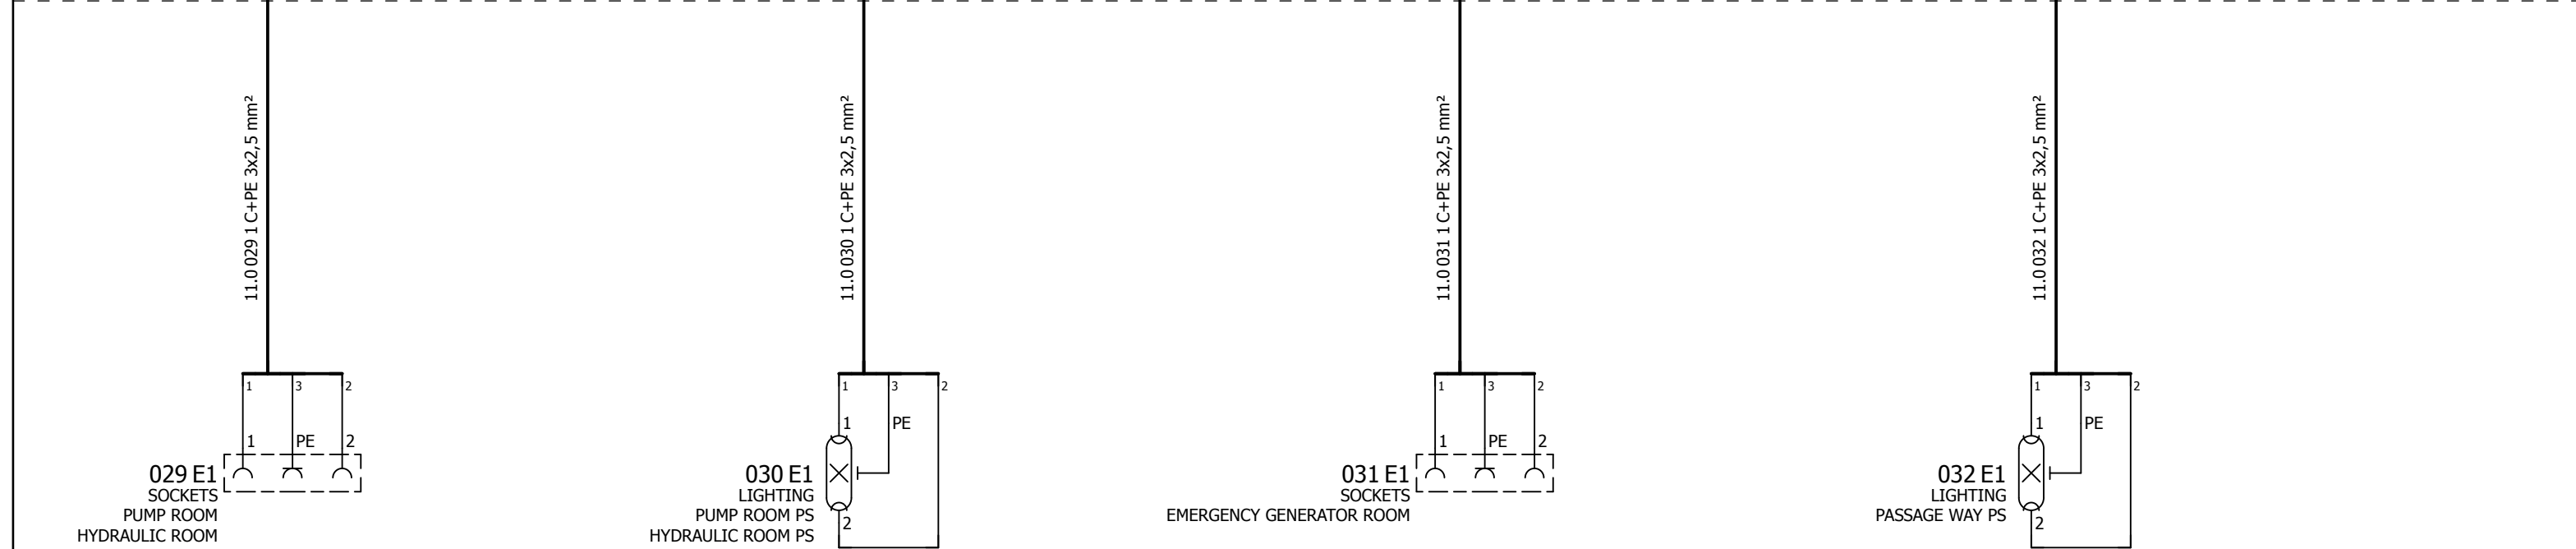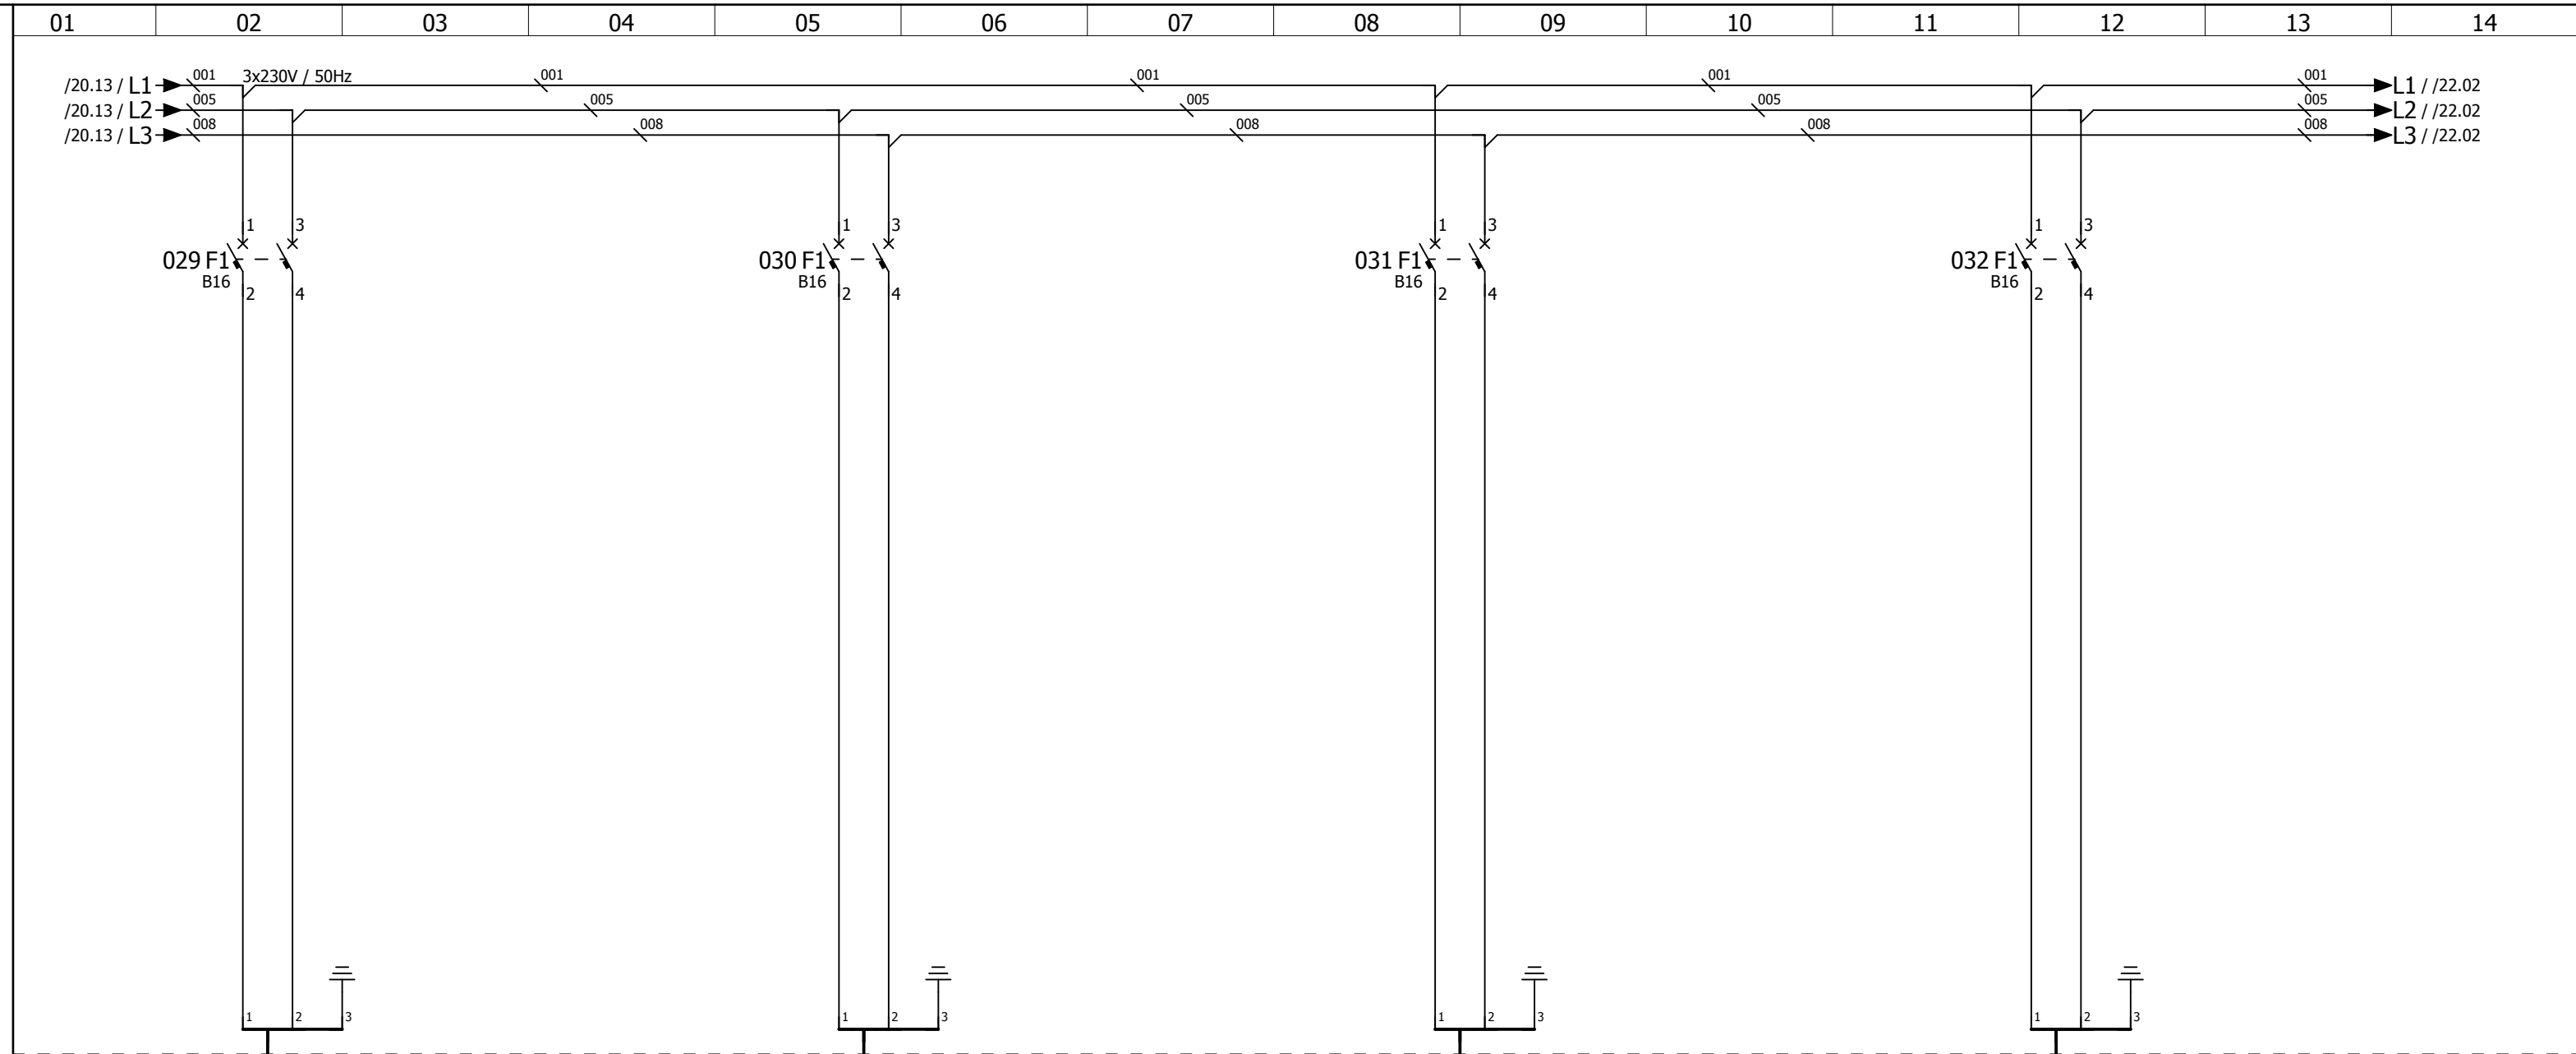


D	24-1-2011	PVR		* NO DELIVERY ALEWIJNSE			ALEWIJNSE MARINE B.V. ENERGIEWEG 46/C 6541 CX NIJMEGEN	IHC DREDGERS BV - TSHD5500 DCI-3 "11L" MAIN DISTRIBUTION BOARD 3X230V DISTRIBUTION GROUPS SECTION 1	Yard no : CO1266
M	5-12-2013	IEN	REV 1						Project : 23000143
STAT	AS BUILT			PANEL IP23					Class : LROS/IRS
	05-12-2013	IEN	CHK						Page : 11L -21

No part of this work may be copied, stored or published without prior written permission of Alewijnse Marine Systems.

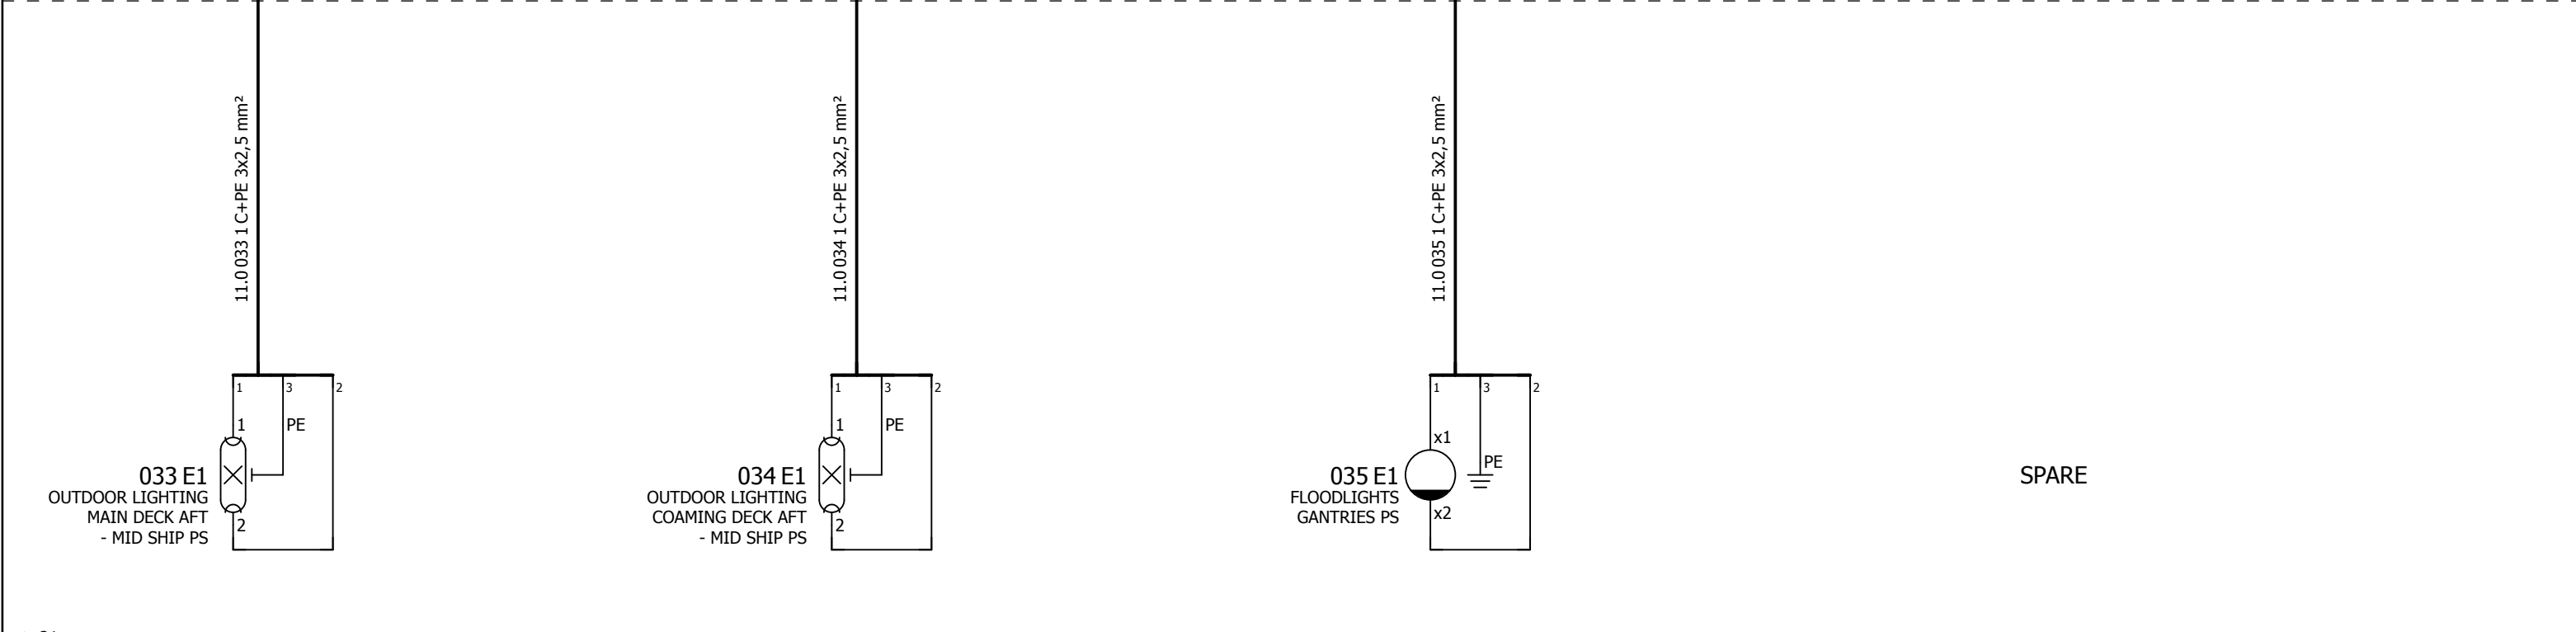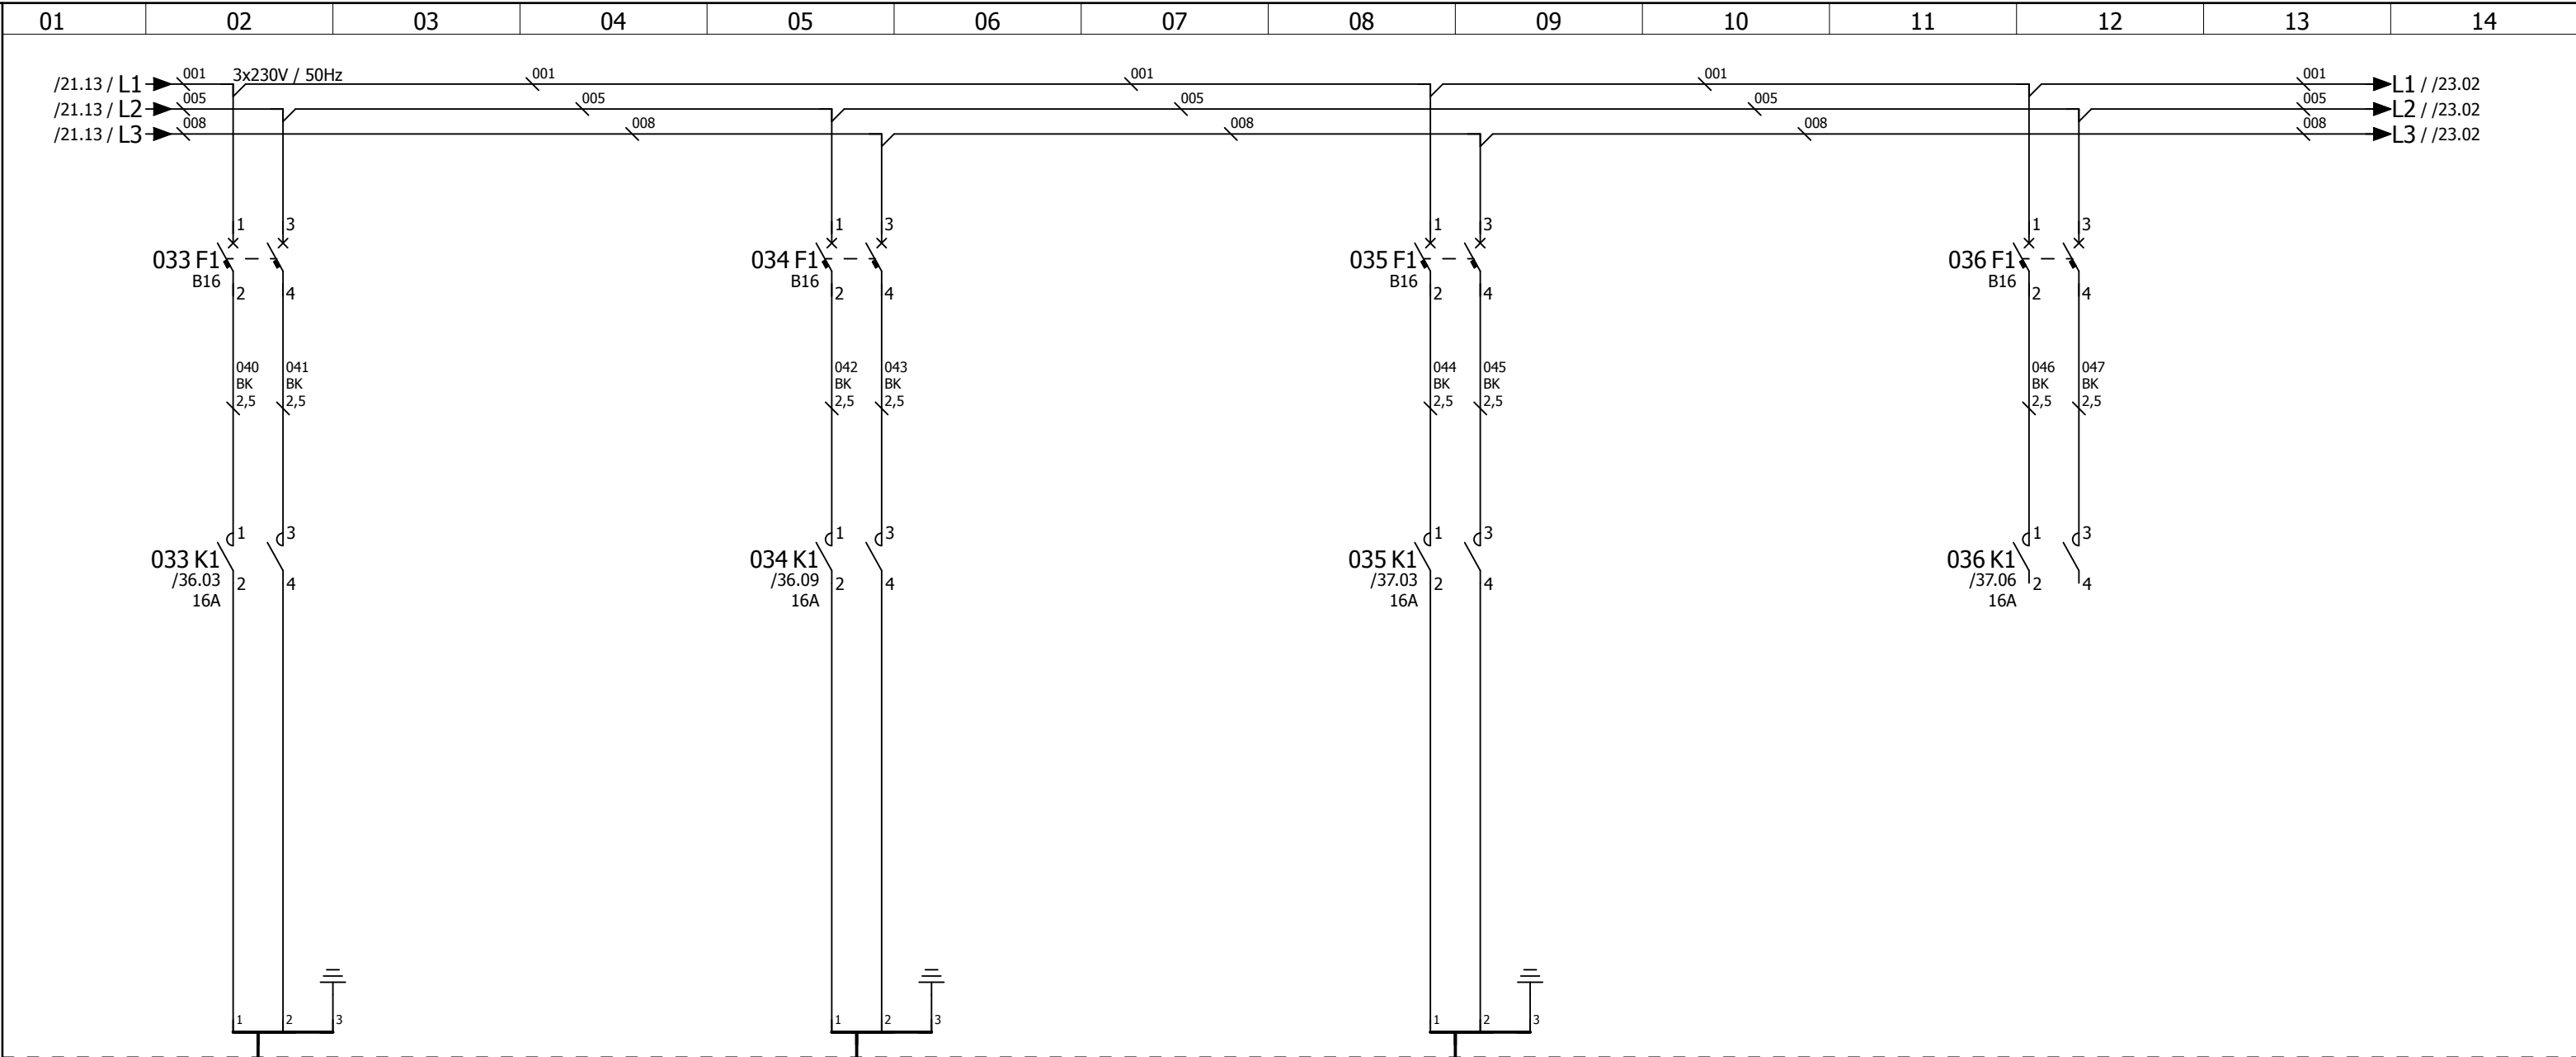


STAT	D	24-1-2011	PVR		* NO DELIVERY ALEWIJNSE			ALEWIJNSE MARINE B.V. ENERGIEWEG 46/C 6541 CX NIJMEGEN	IHC DREDGERS BV - TSHD5500 DCI-3 "11L" MAIN DISTRIBUTION BOARD 3X230V DISTRIBUTION GROUPS SECTION 1	Yard no : CO1266
	M	5-12-2013	IEN	REV						1
		AS BUILT				PANEL IP23		Class : LROS/IRS		
		05-12-2013	IEN	CHK				Page : 11L -22		

No part of this work may be copied, stored or published without prior written permission of Alewijnse Marine Systems.

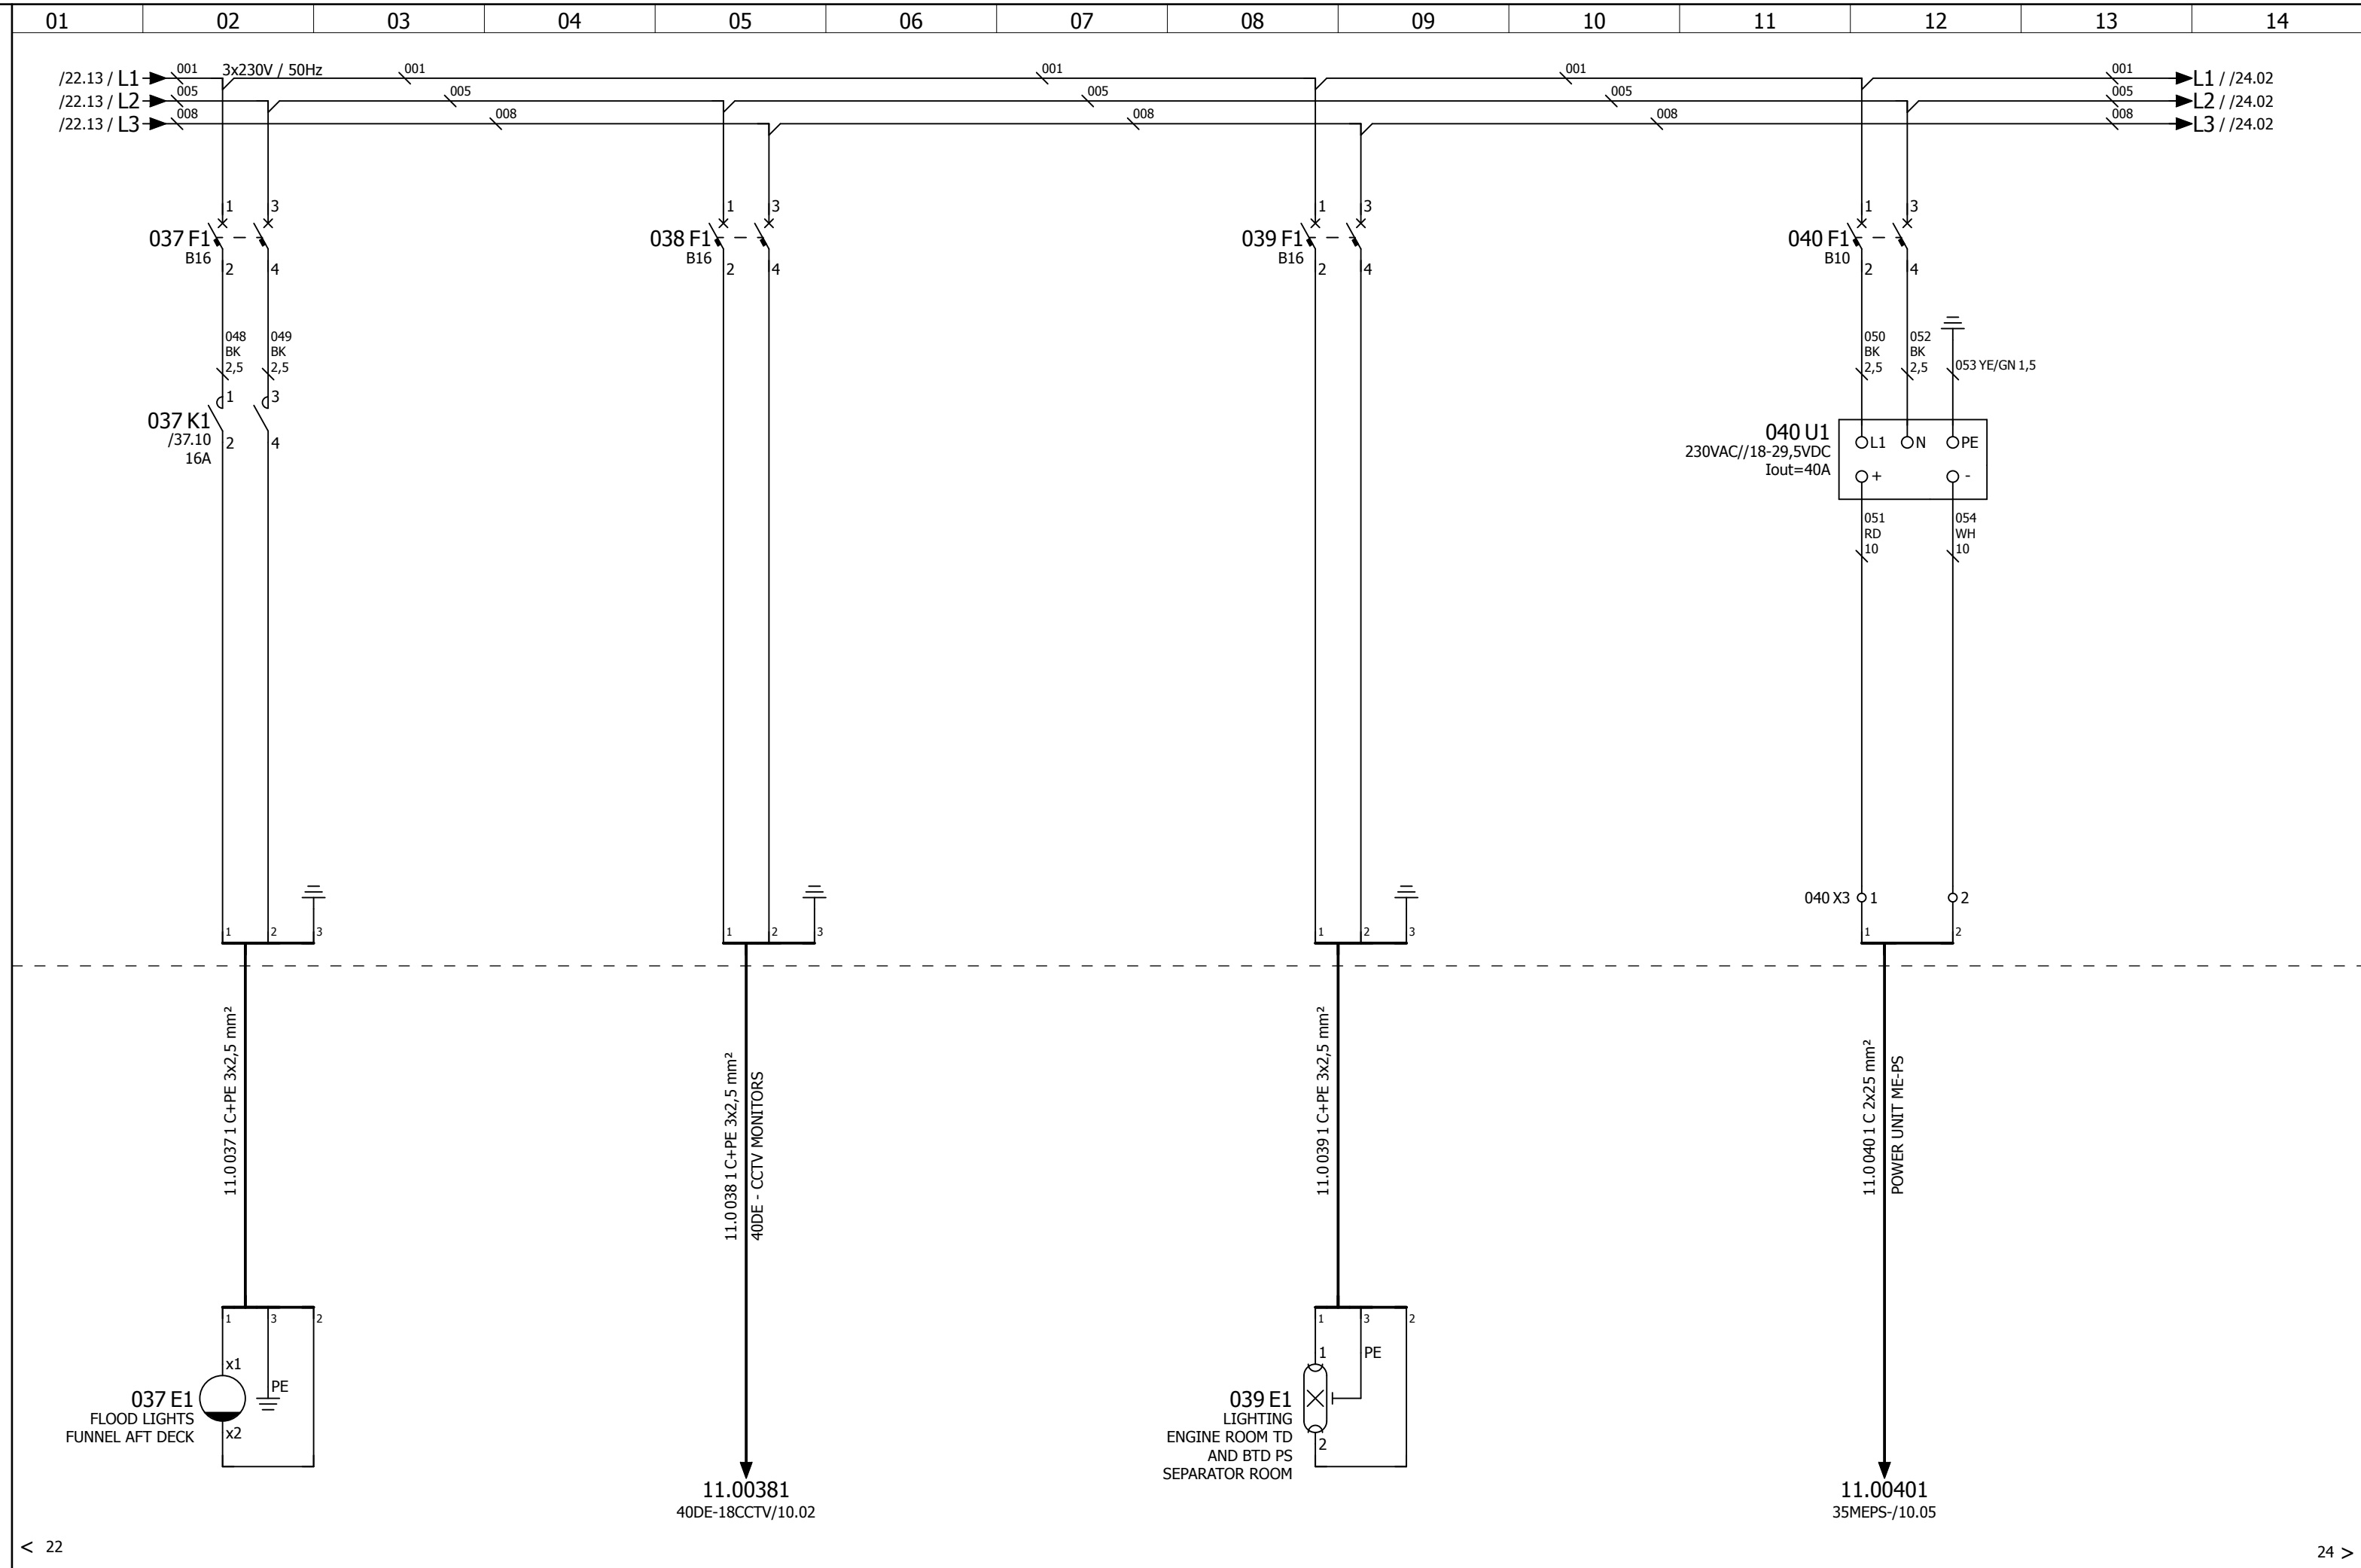


D	24-1-2011	PVR			* NO DELIVERY ALEWIJNSE			ALEWIJNSE MARINE B.V. ENERGIEWEG 46/C 6541 CX NIJMEGEN	IHC DREDGERS BV - TSHD5500 DCI-3 "11L" MAIN DISTRIBUTION BOARD 3X230V DISTRIBUTION GROUPS SECTION 1	Yard no : CO1266
M	5-12-2013	IEN	REV	1	PANEL IP23					Project : 23000143
STAT	AS BUILT									Class : LROS/IRS
	05-12-2013	IEN	CHK							Page : 11L -23


No part of this work may be copied, stored or published without prior written permission of Alewijnse Marine Systems.

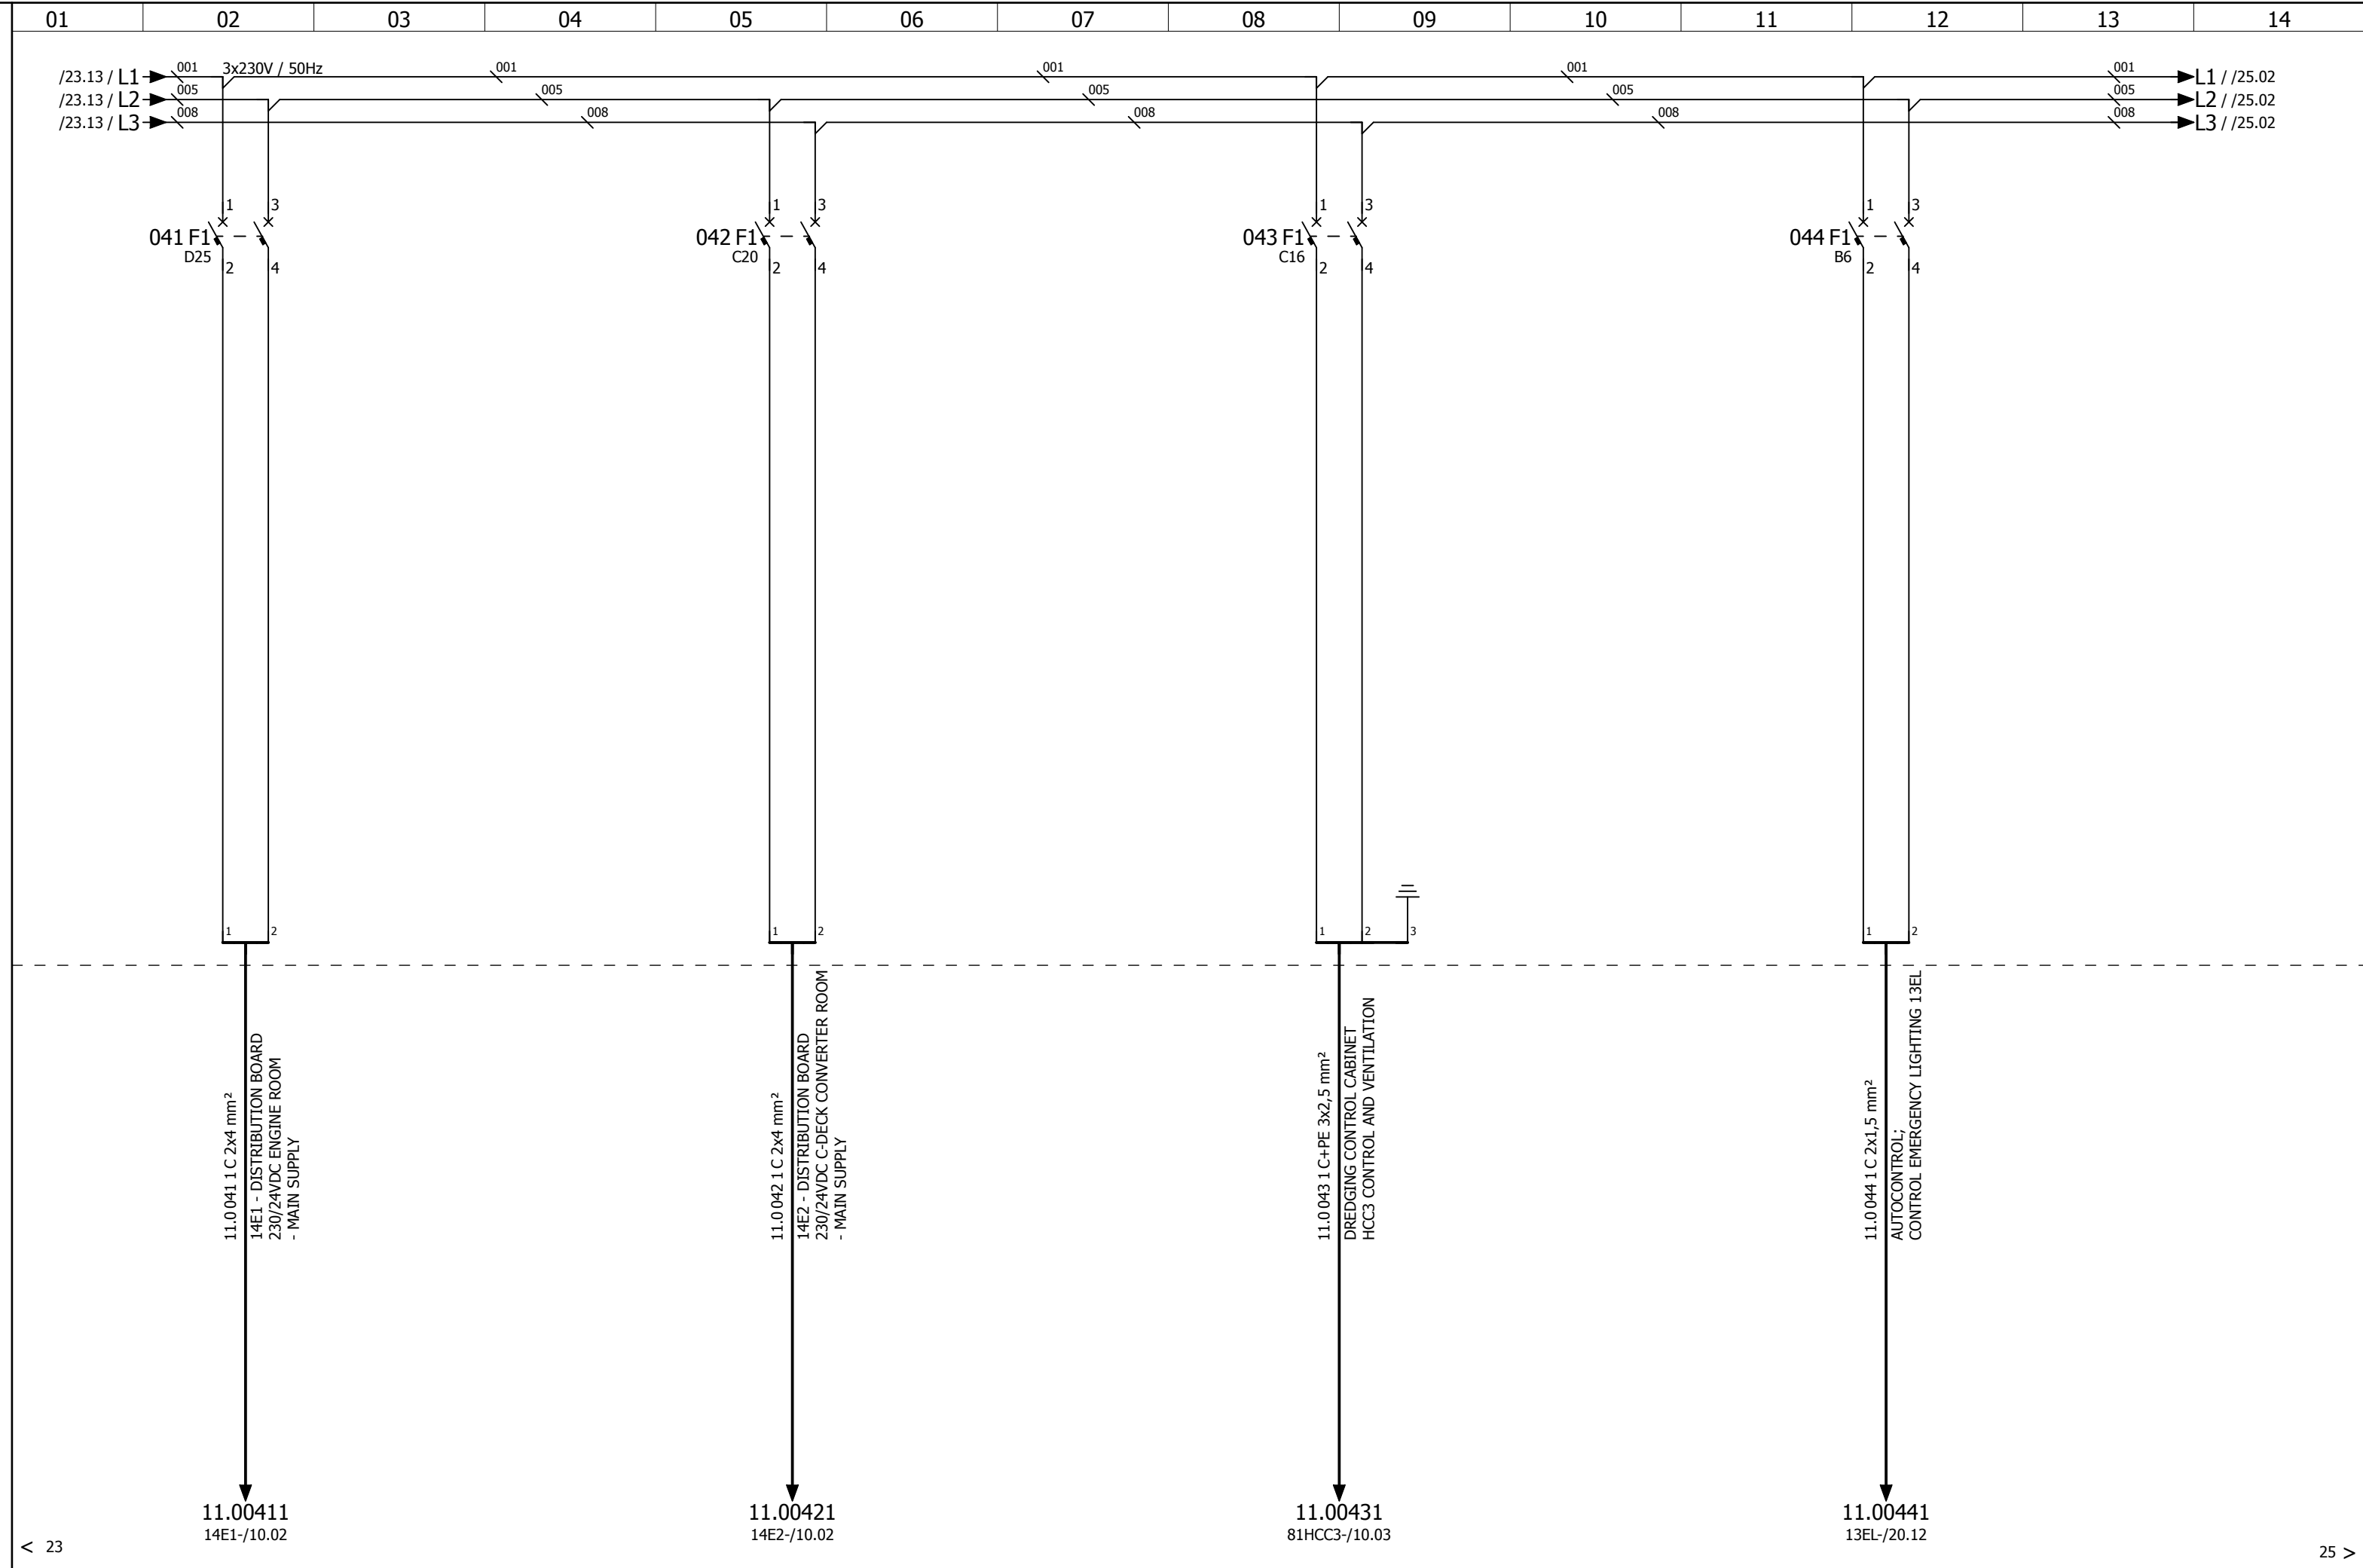

STAT	D	24-1-2011	PVR		* NO DELIVERY ALEWIJNSE		 ALEWIJNSE MARINE B.V. ENERGIEWEG 46/C 6541 CX NIJMEGEN	IHC DREDGERS BV - TSHD5500 DCI-3 "11L" MAIN DISTRIBUTION BOARD 3X230V DISTRIBUTION GROUPS SECTION 1	Yard no : CO1266
	M	5-12-2013	IEN	REV					1
		AS BUILT				PANEL IP23	Class : LROS/IRS		
		05-12-2013	IEN	CHK			Page : 11L -24		

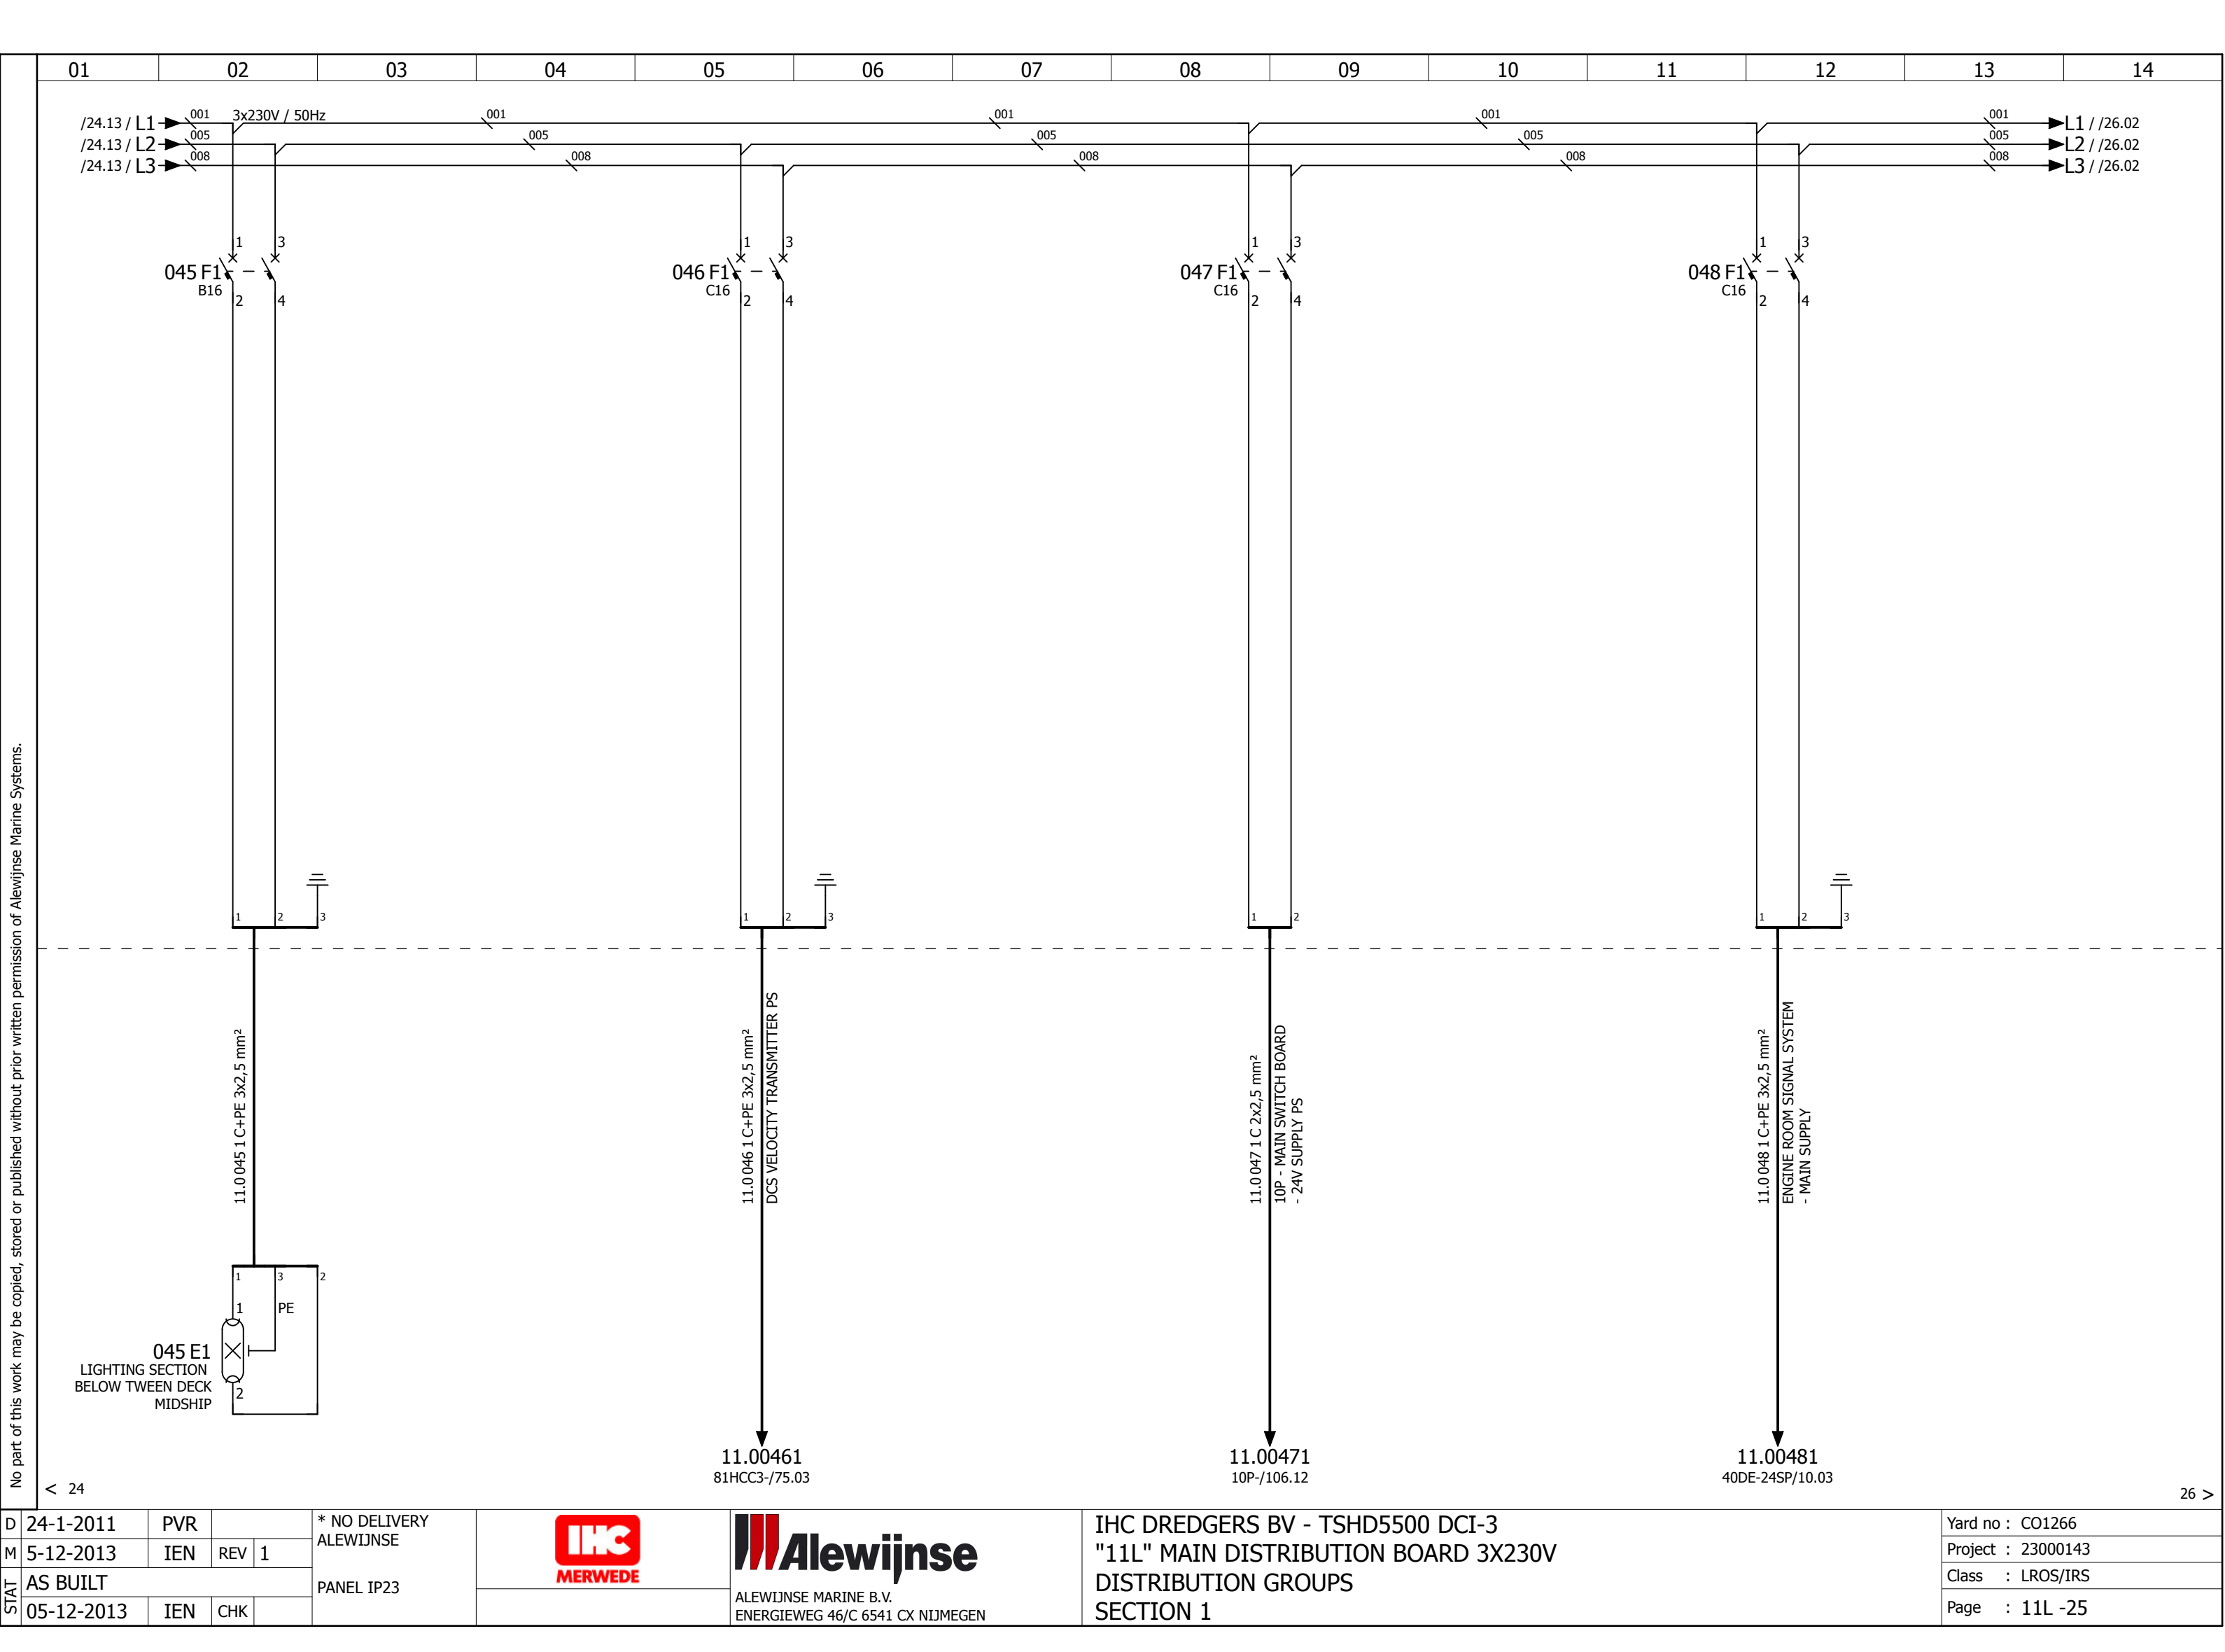


No part of this work may be copied, stored or published without prior written permission of Alewijnse Marine Systems.

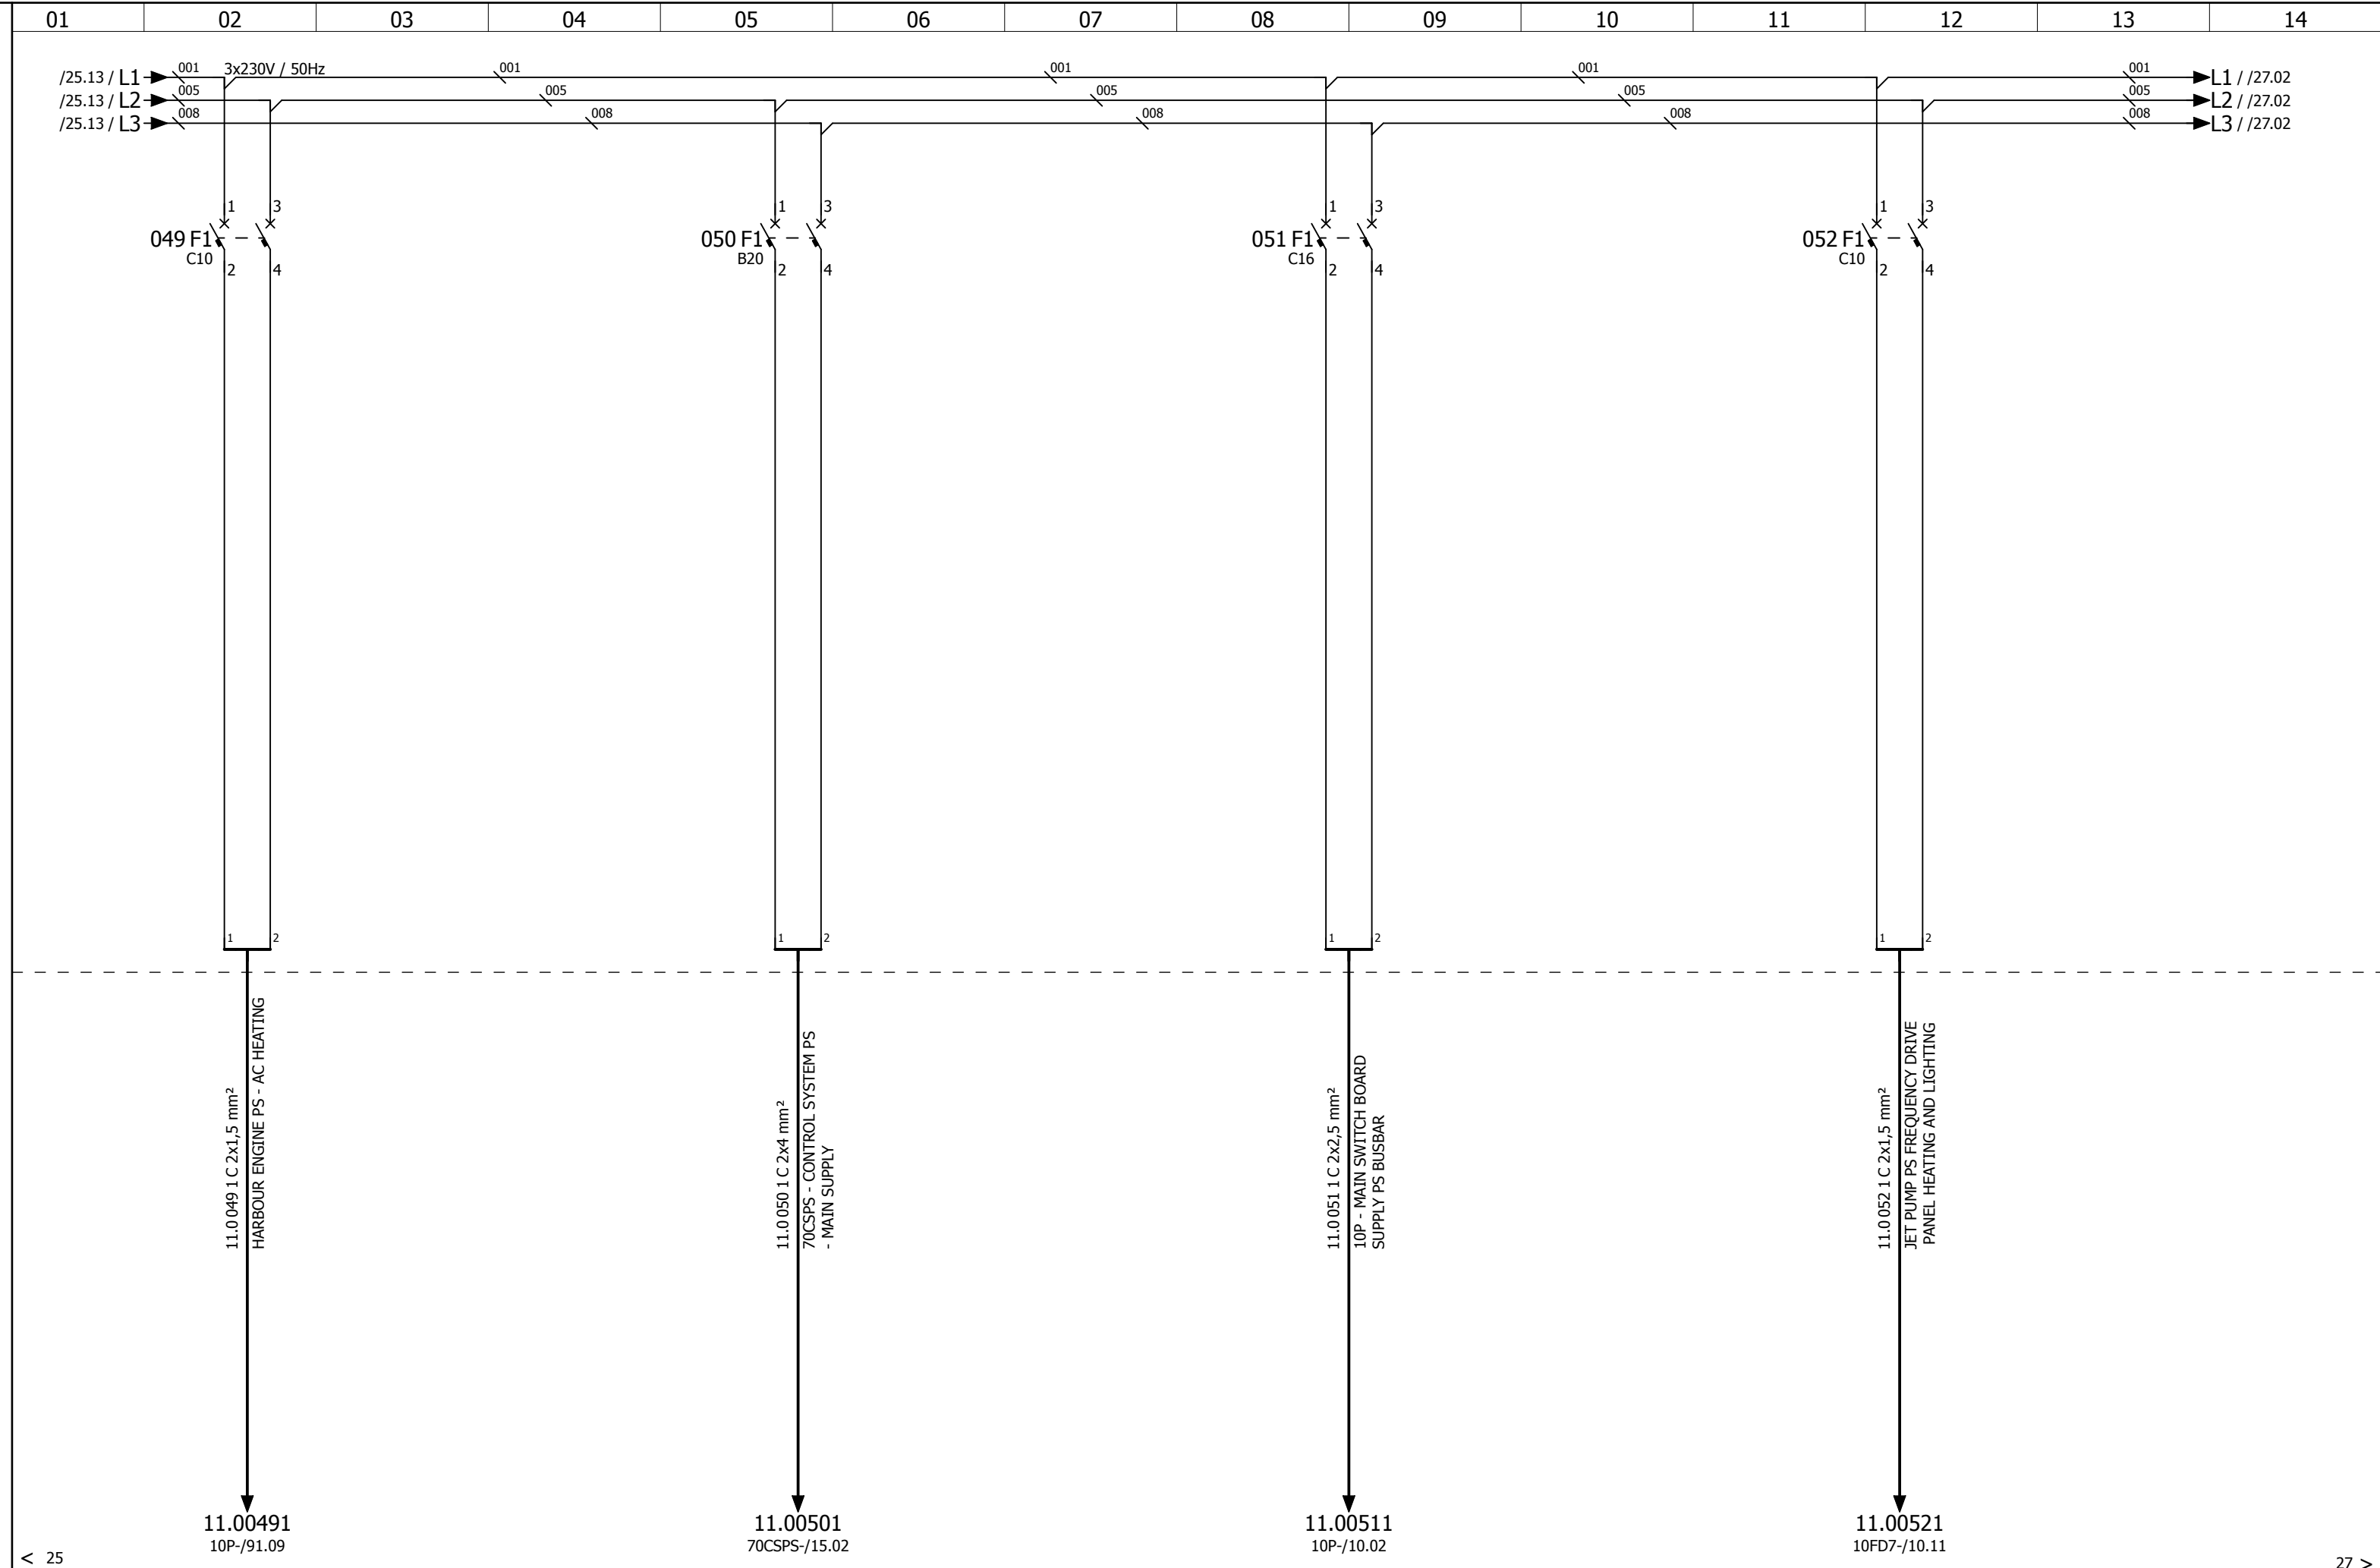



D	24-1-2011	PVR			* NO DELIVERY ALEWIJNSE			ALEWIJNSE MARINE B.V. ENERGIEWEG 46/C 6541 CX NIJMEGEN	IHC DREDGERS BV - TSHD5500 DCI-3 "11L" MAIN DISTRIBUTION BOARD 3X230V DISTRIBUTION GROUPS SECTION 1	Yard no : CO1266			
M	5-12-2013	IEN	REV	1						Project : 23000143			
STAT	AS BUILT									Class : LROS/IRS			
	05-12-2013	IEN	CHK							Page : 11L -26			

No part of this work may be copied, stored or published without prior written permission of Alewijnse Marine Systems.

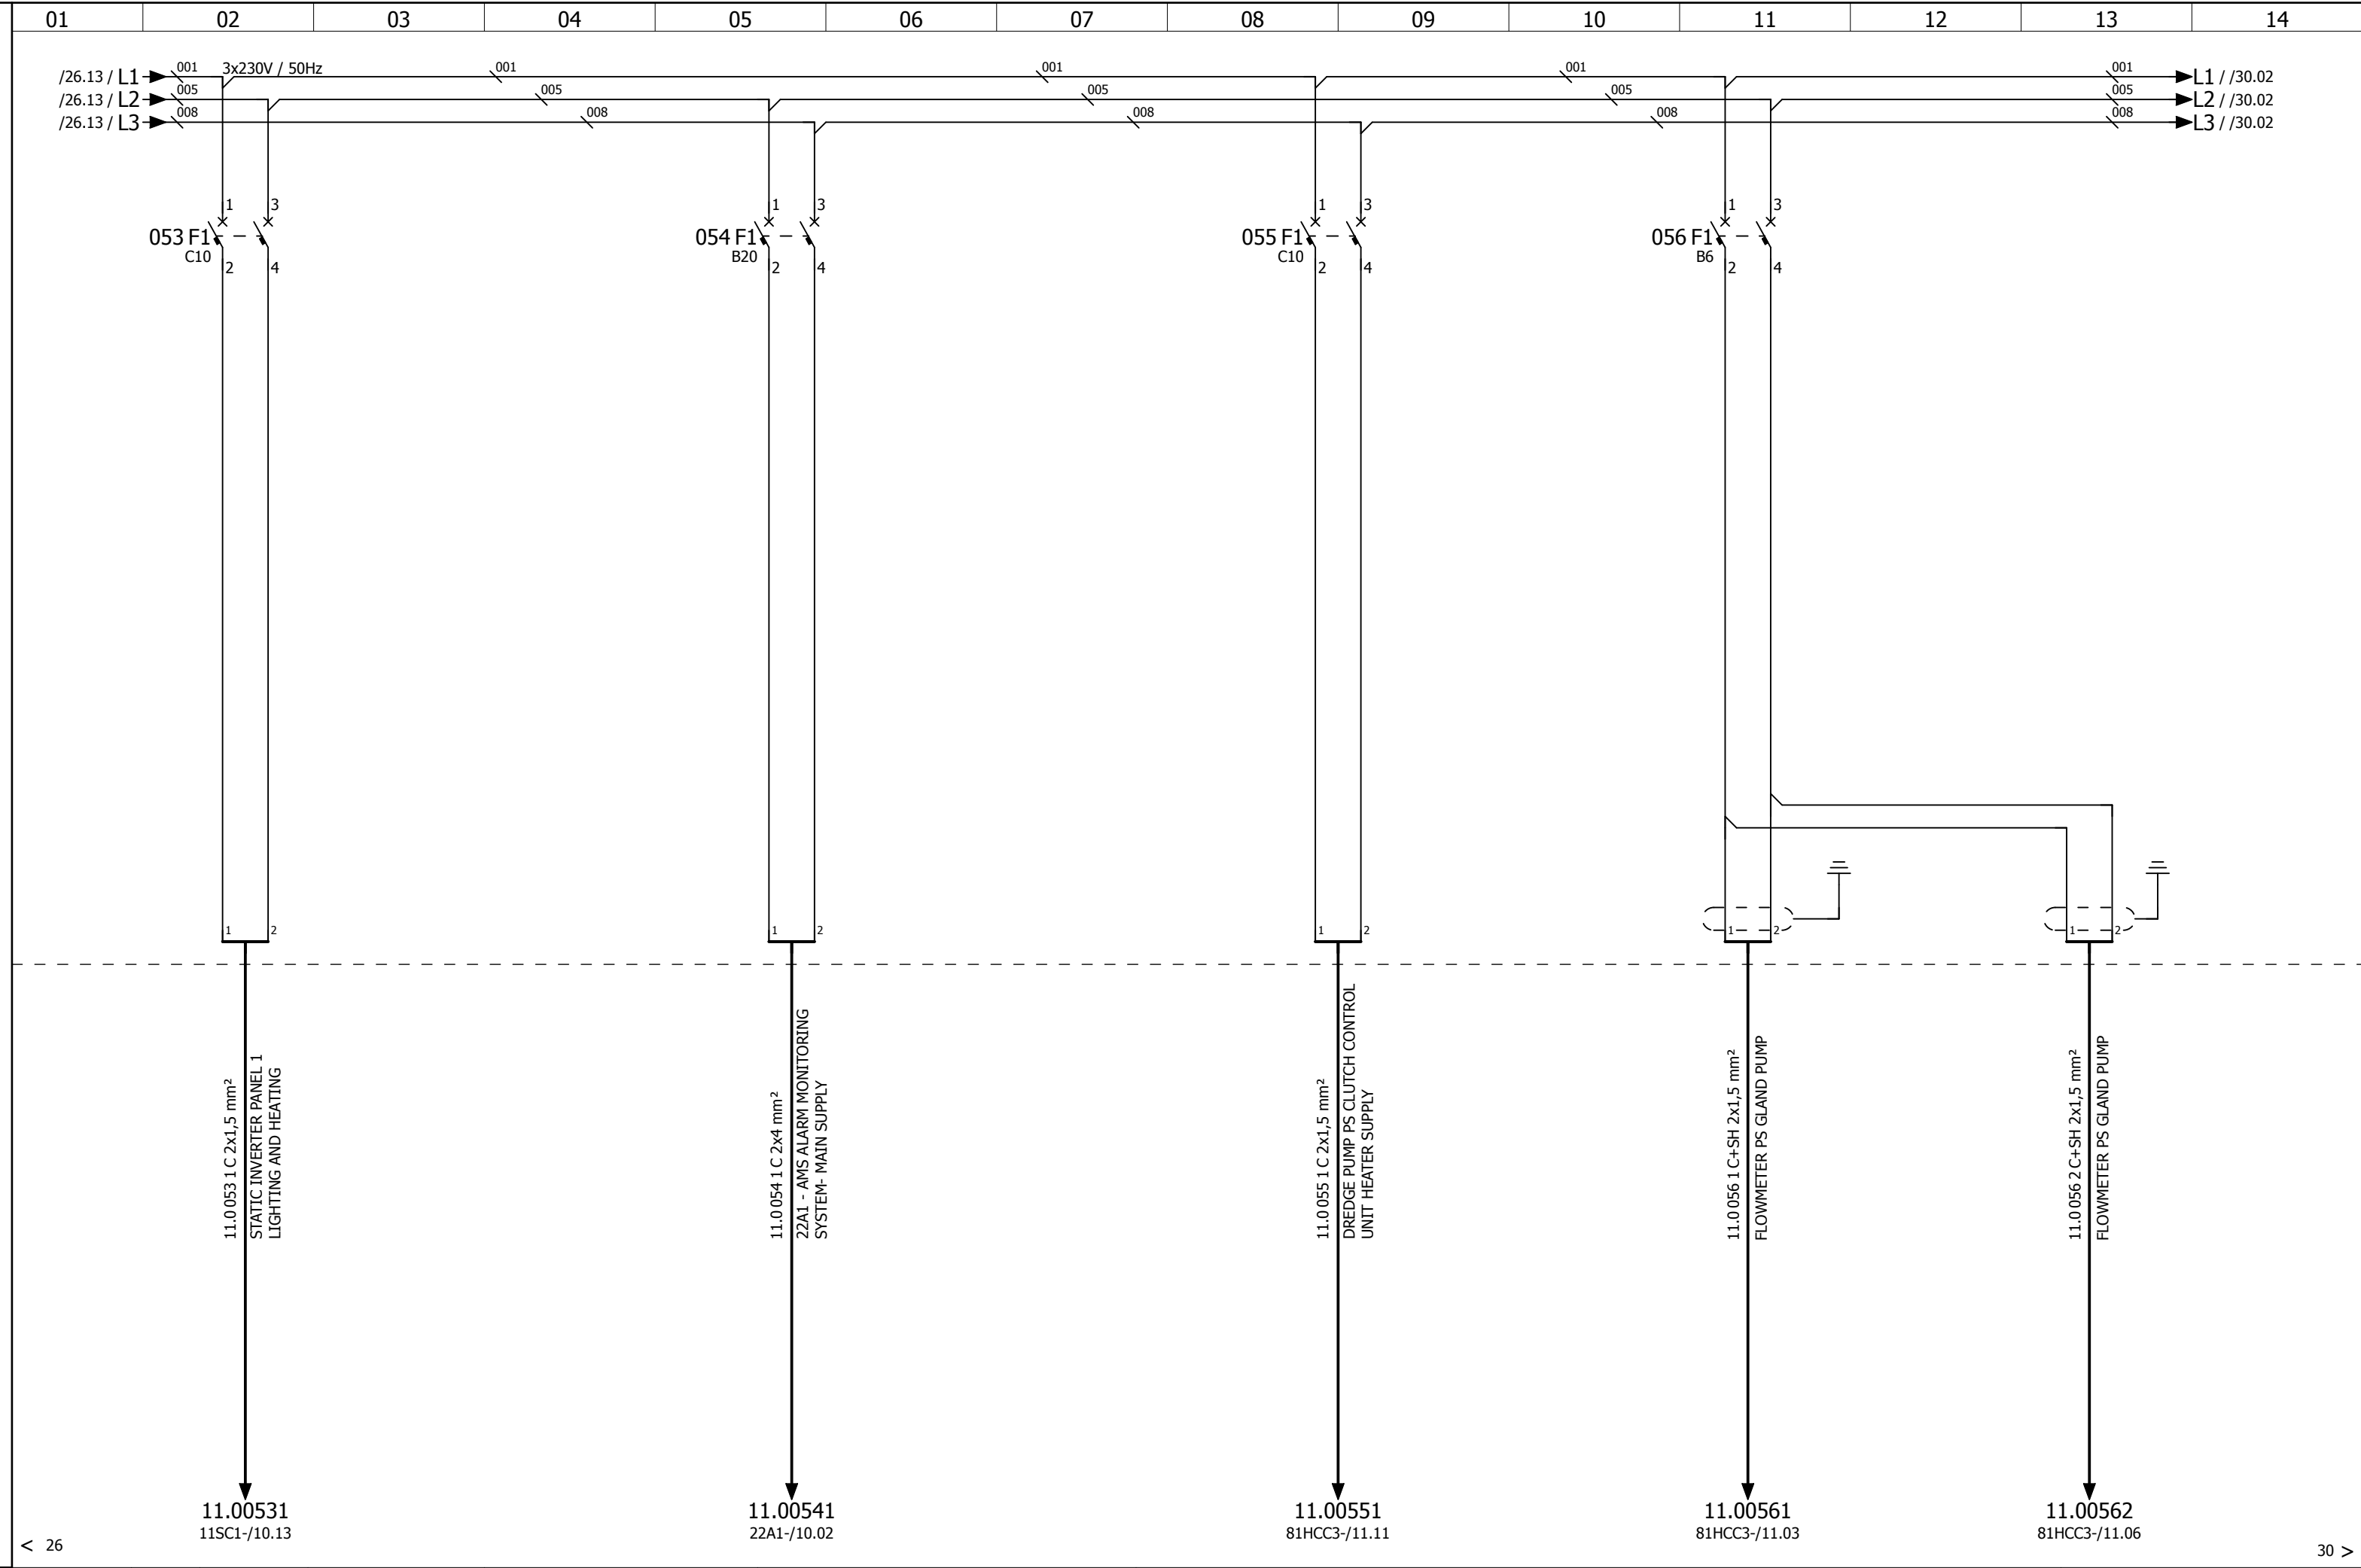


STAT	D	24-1-2011	PVR		* NO DELIVERY ALEWIJNSE			ALEWIJNSE MARINE B.V. ENERGIEWEG 46/C 6541 CX NIJMEGEN	IHC DREDGERS BV - TSHD5500 DCI-3 "11L" MAIN DISTRIBUTION BOARD 3X230V DISTRIBUTION GROUPS SECTION 1	Yard no : CO1266	
	M	5-12-2013	IEN	REV						1	Project : 23000143
	AS BUILT					PANEL IP23				Class : LROS/IRS	
		05-12-2013	IEN	CHK						Page : 11L -27	

 No part of this work may be copied, stored or published without prior written permission of Alewijnse Marine Systems.

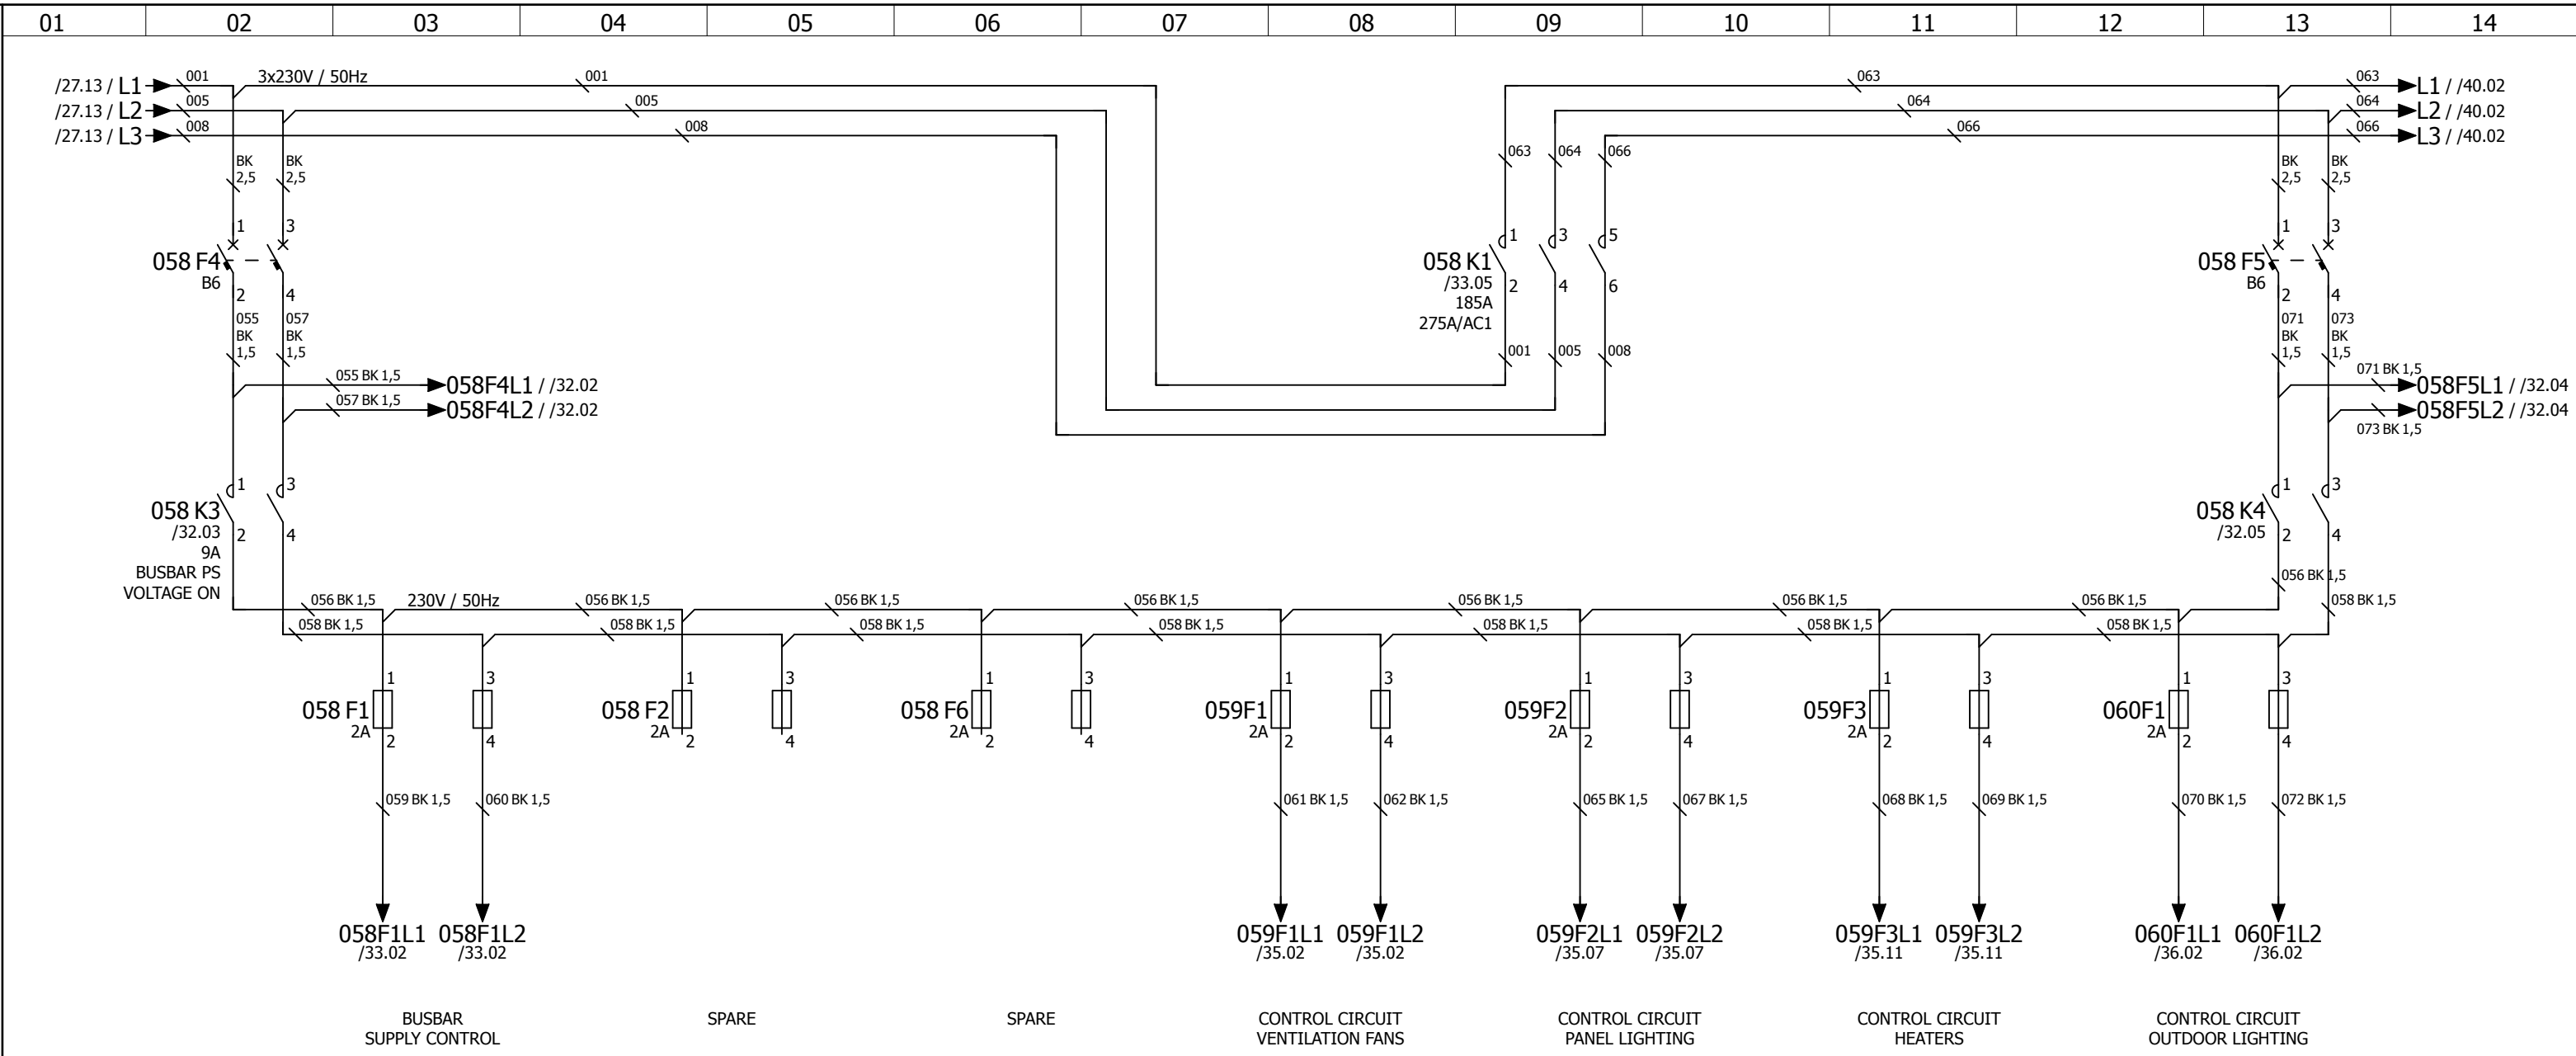


D	24-1-2011	PVR			* NO DELIVERY ALEWIJNSE			ALEWIJNSE MARINE B.V. ENERGIEWEG 46/C 6541 CX NIJMEGEN	IHC DREDGERS BV - TSHD5500 DCI-3 "11L" MAIN DISTRIBUTION BOARD 3X230V BUSTIE MAIN CIRCUIT SECTION 1	Yard no : CO1266
M	5-12-2013	IEN	REV	1						
STAT	AS BUILT				PANEL IP23			Project : 23000143		
	05-12-2013	IEN	CHK					Class : LROS/IRS		
									Page : 11L -30	

No part of this work may be copied, stored or published without prior written permission of Alewijnse Marine Systems.

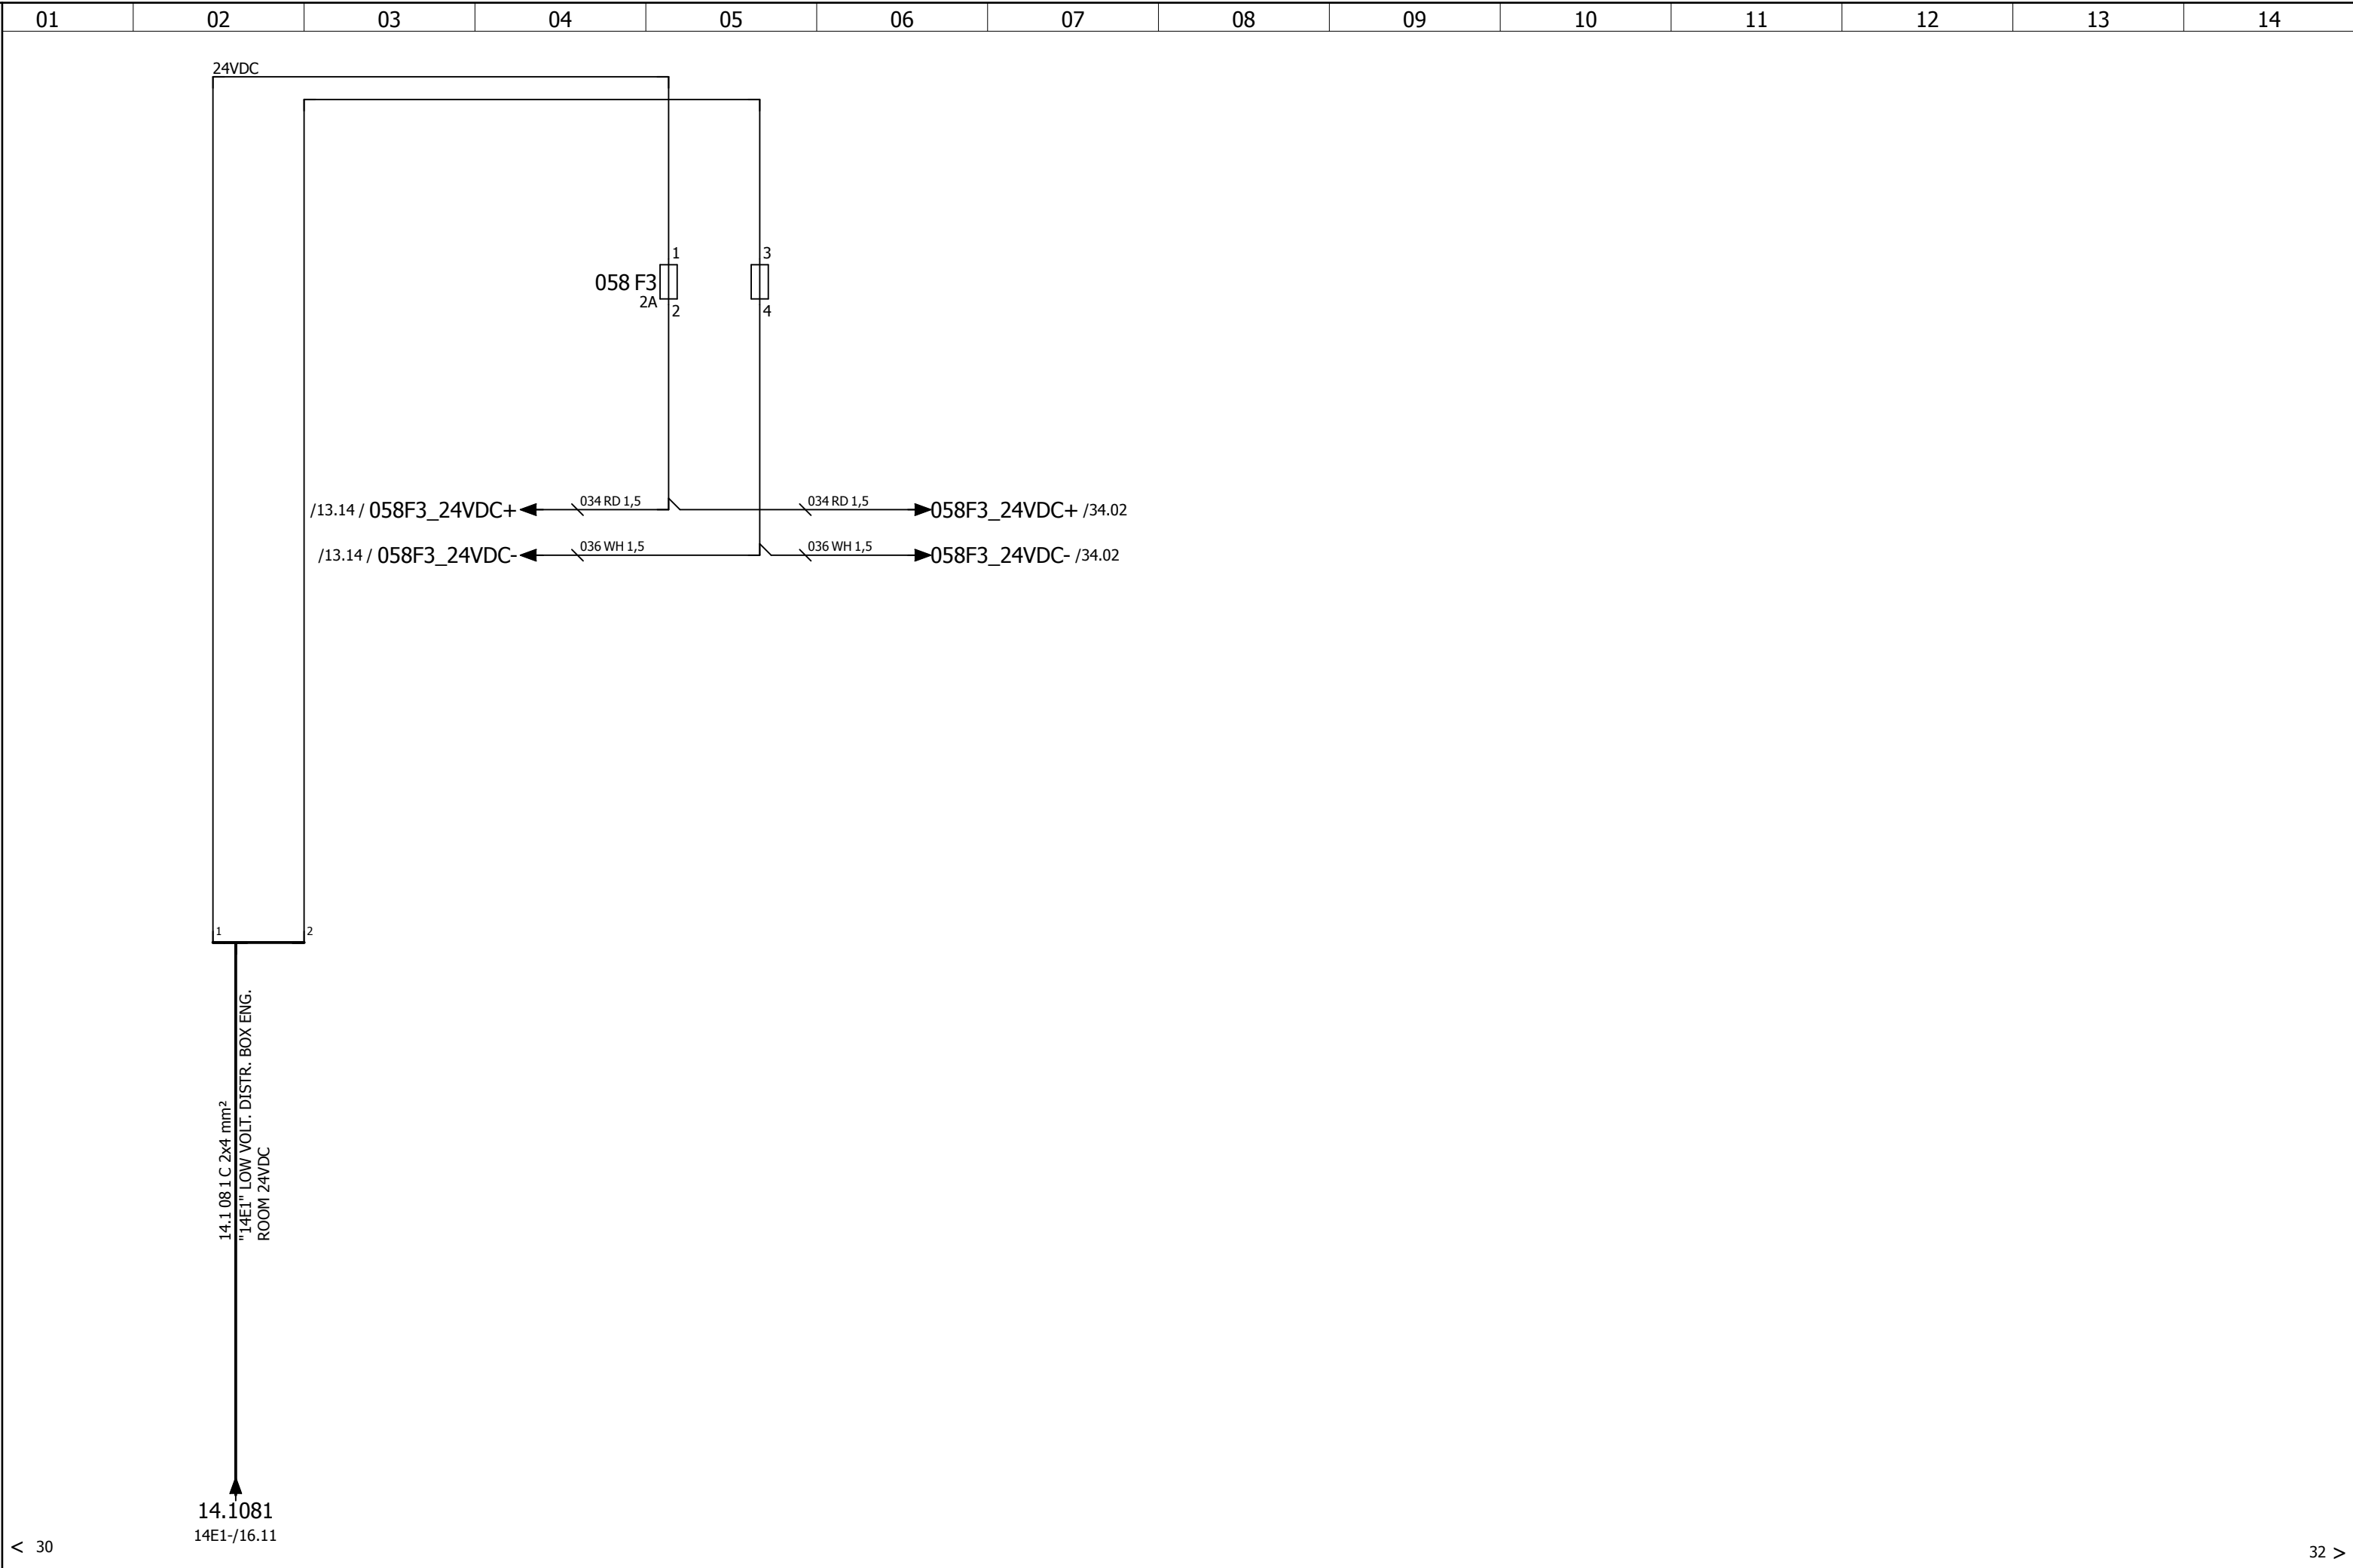


STAT	D	24-1-2011	PVR		* NO DELIVERY ALEWIJNSE			IHC DREDGERS BV - TSHD5500 DCI-3 "11L" MAIN DISTRIBUTION BOARD 3X230V BUSTIE INCOMING 24VDC MAIN CIRCUIT SECTION 1	Yard no : CO1266			
	M	5-12-2013	IEN	REV					1	Project : 23000143		
	AS BUILT					PANEL IP23			ALEWIJNSE MARINE B.V. ENERGIEWEG 46/C 6541 CX NIJMEGEN	Class : LROS/IRS		
		05-12-2013	IEN	CHK						Page : 11L -31		

No part of this work may be copied, stored or published without prior written permission of Alewijnse Marine Systems.

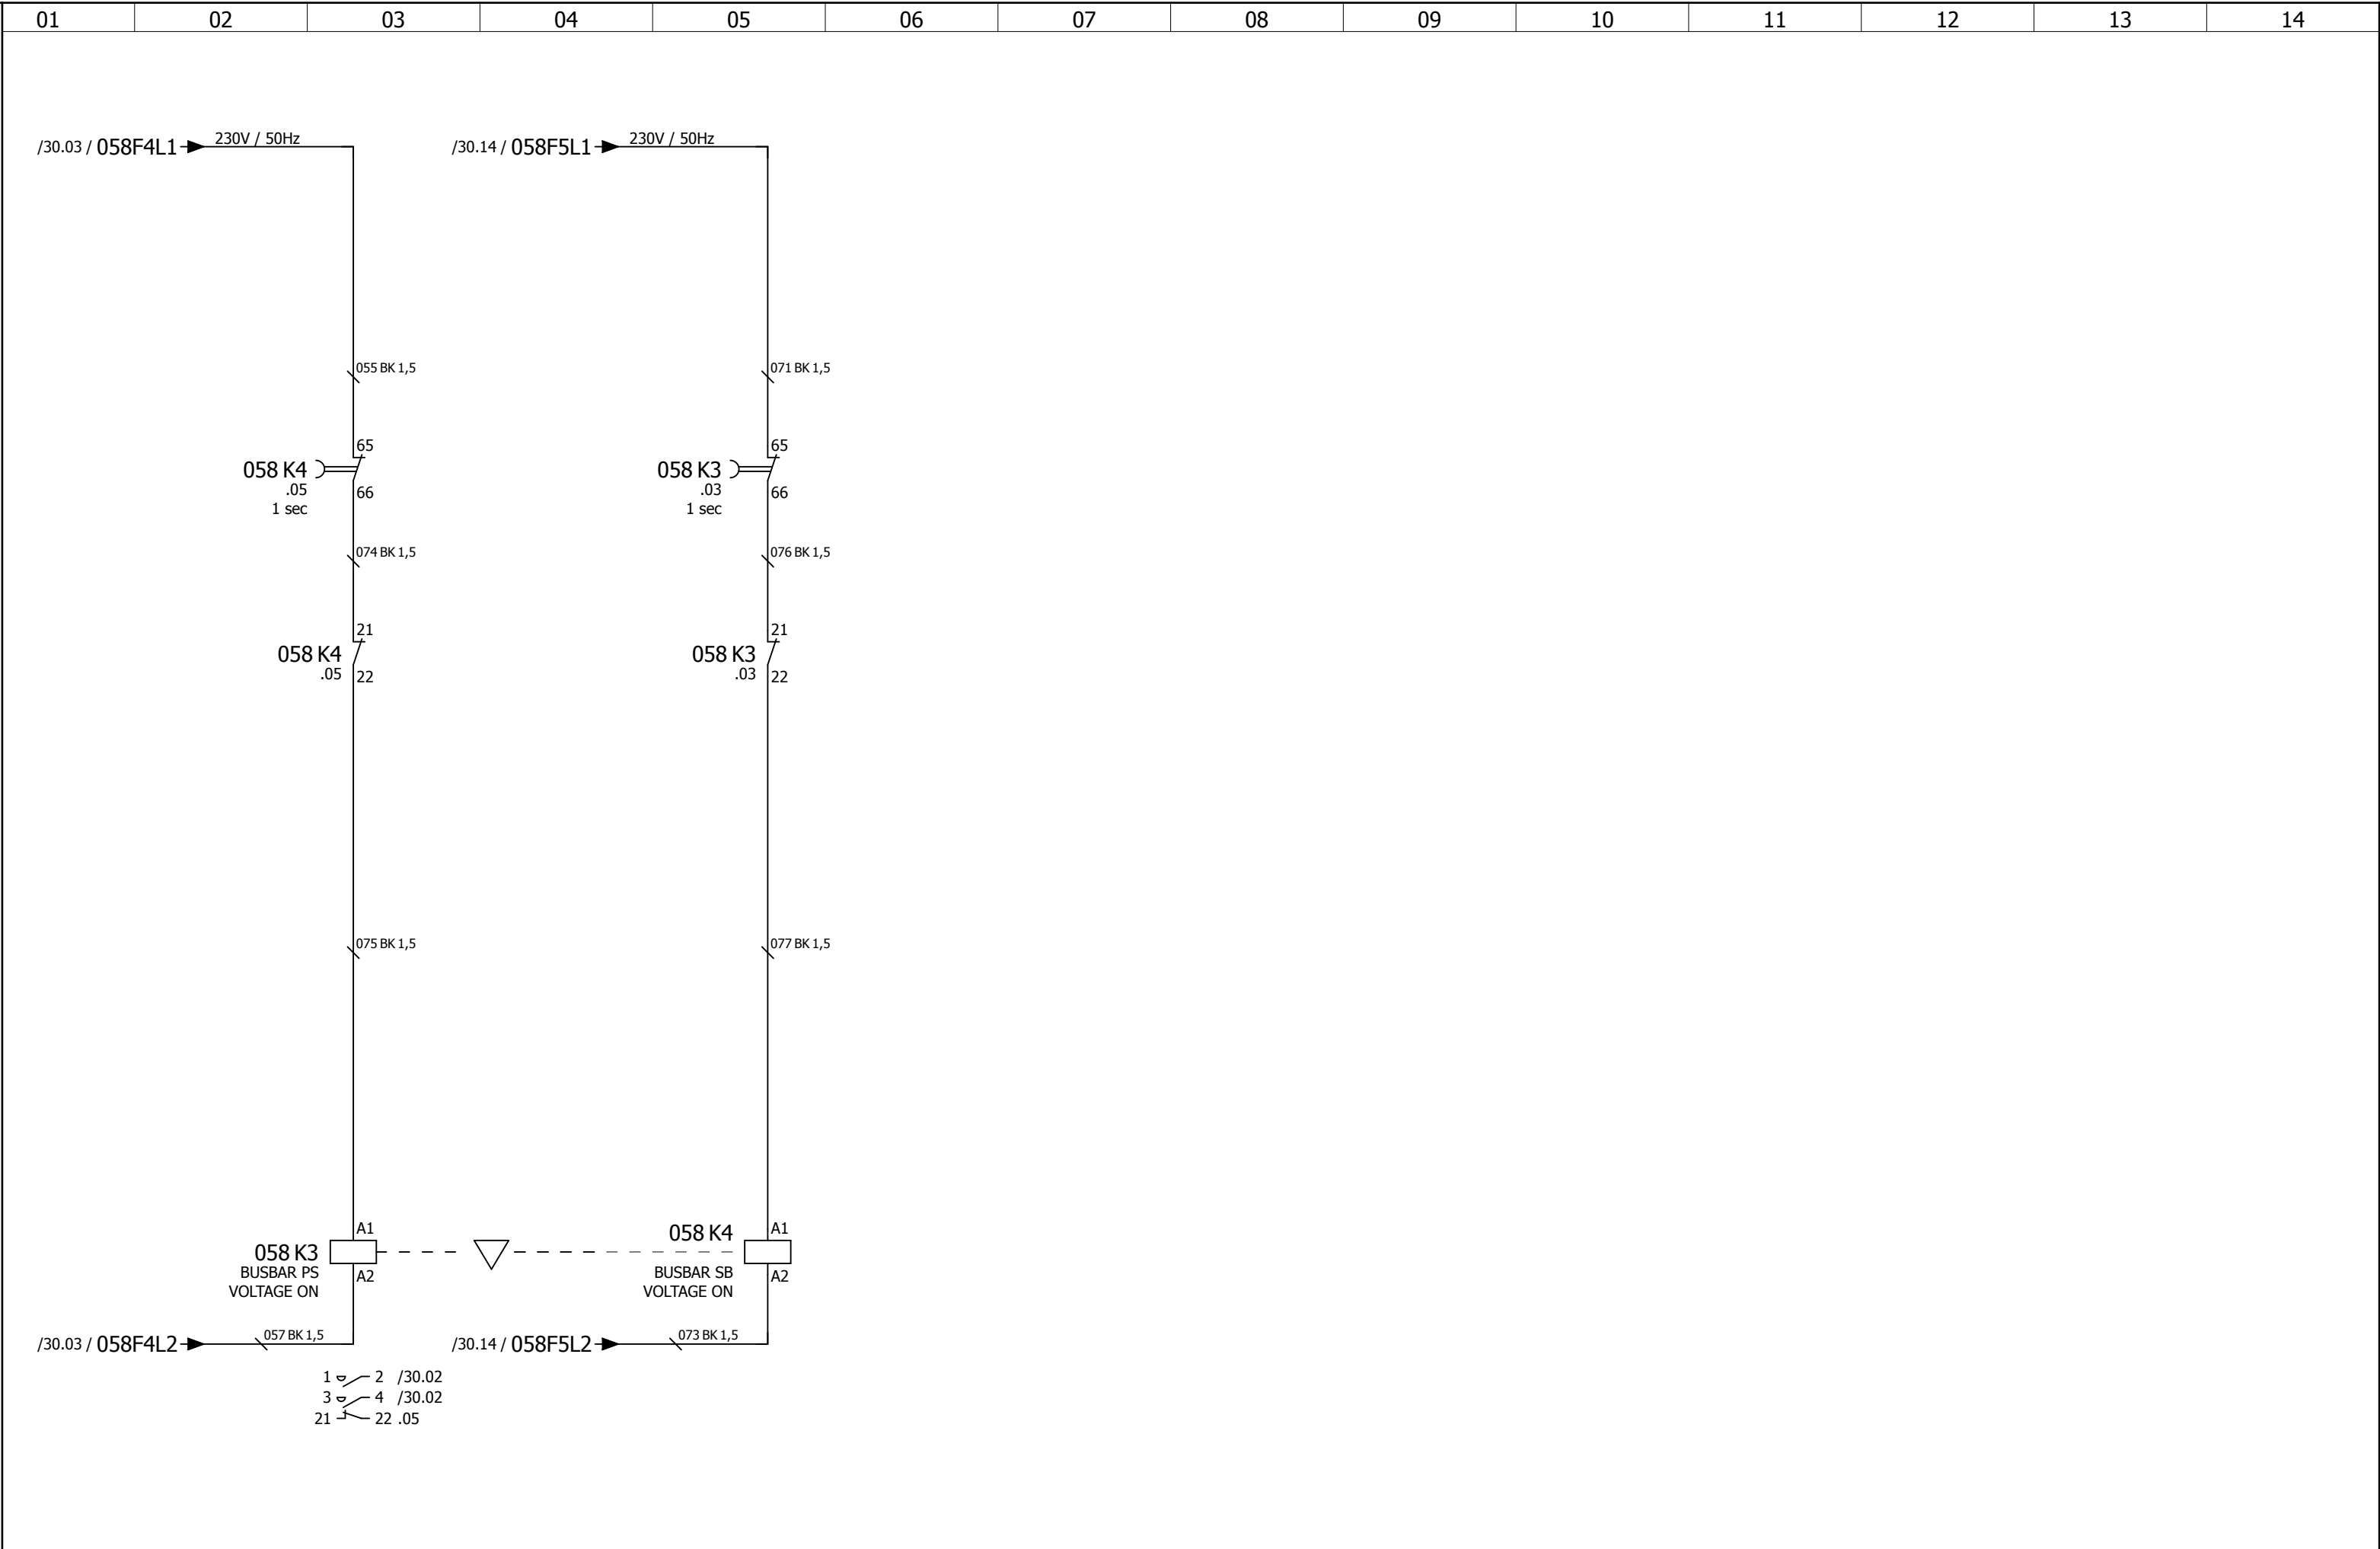


STAT	D	24-1-2011	PVR		* NO DELIVERY ALEWIJNSE			ALEWIJNSE MARINE B.V. ENERGIEWEG 46/C 6541 CX NIJMEGEN	IHC DREDGERS BV - TSHD5500 DCI-3 "11L" MAIN DISTRIBUTION BOARD 3X230V BUSTIE VOLTAGE CONTROL SECTION 1	Yard no : CO1266	
	M	5-12-2013	IEN	REV						1	Project : 23000143
	AS BUILT									Class : LROS/IRS	
		05-12-2013	IEN	CHK							Page : 11L -32
					PANEL IP23						

No part of this work may be copied, stored or published without prior written permission of Alewijnse Marine Systems.

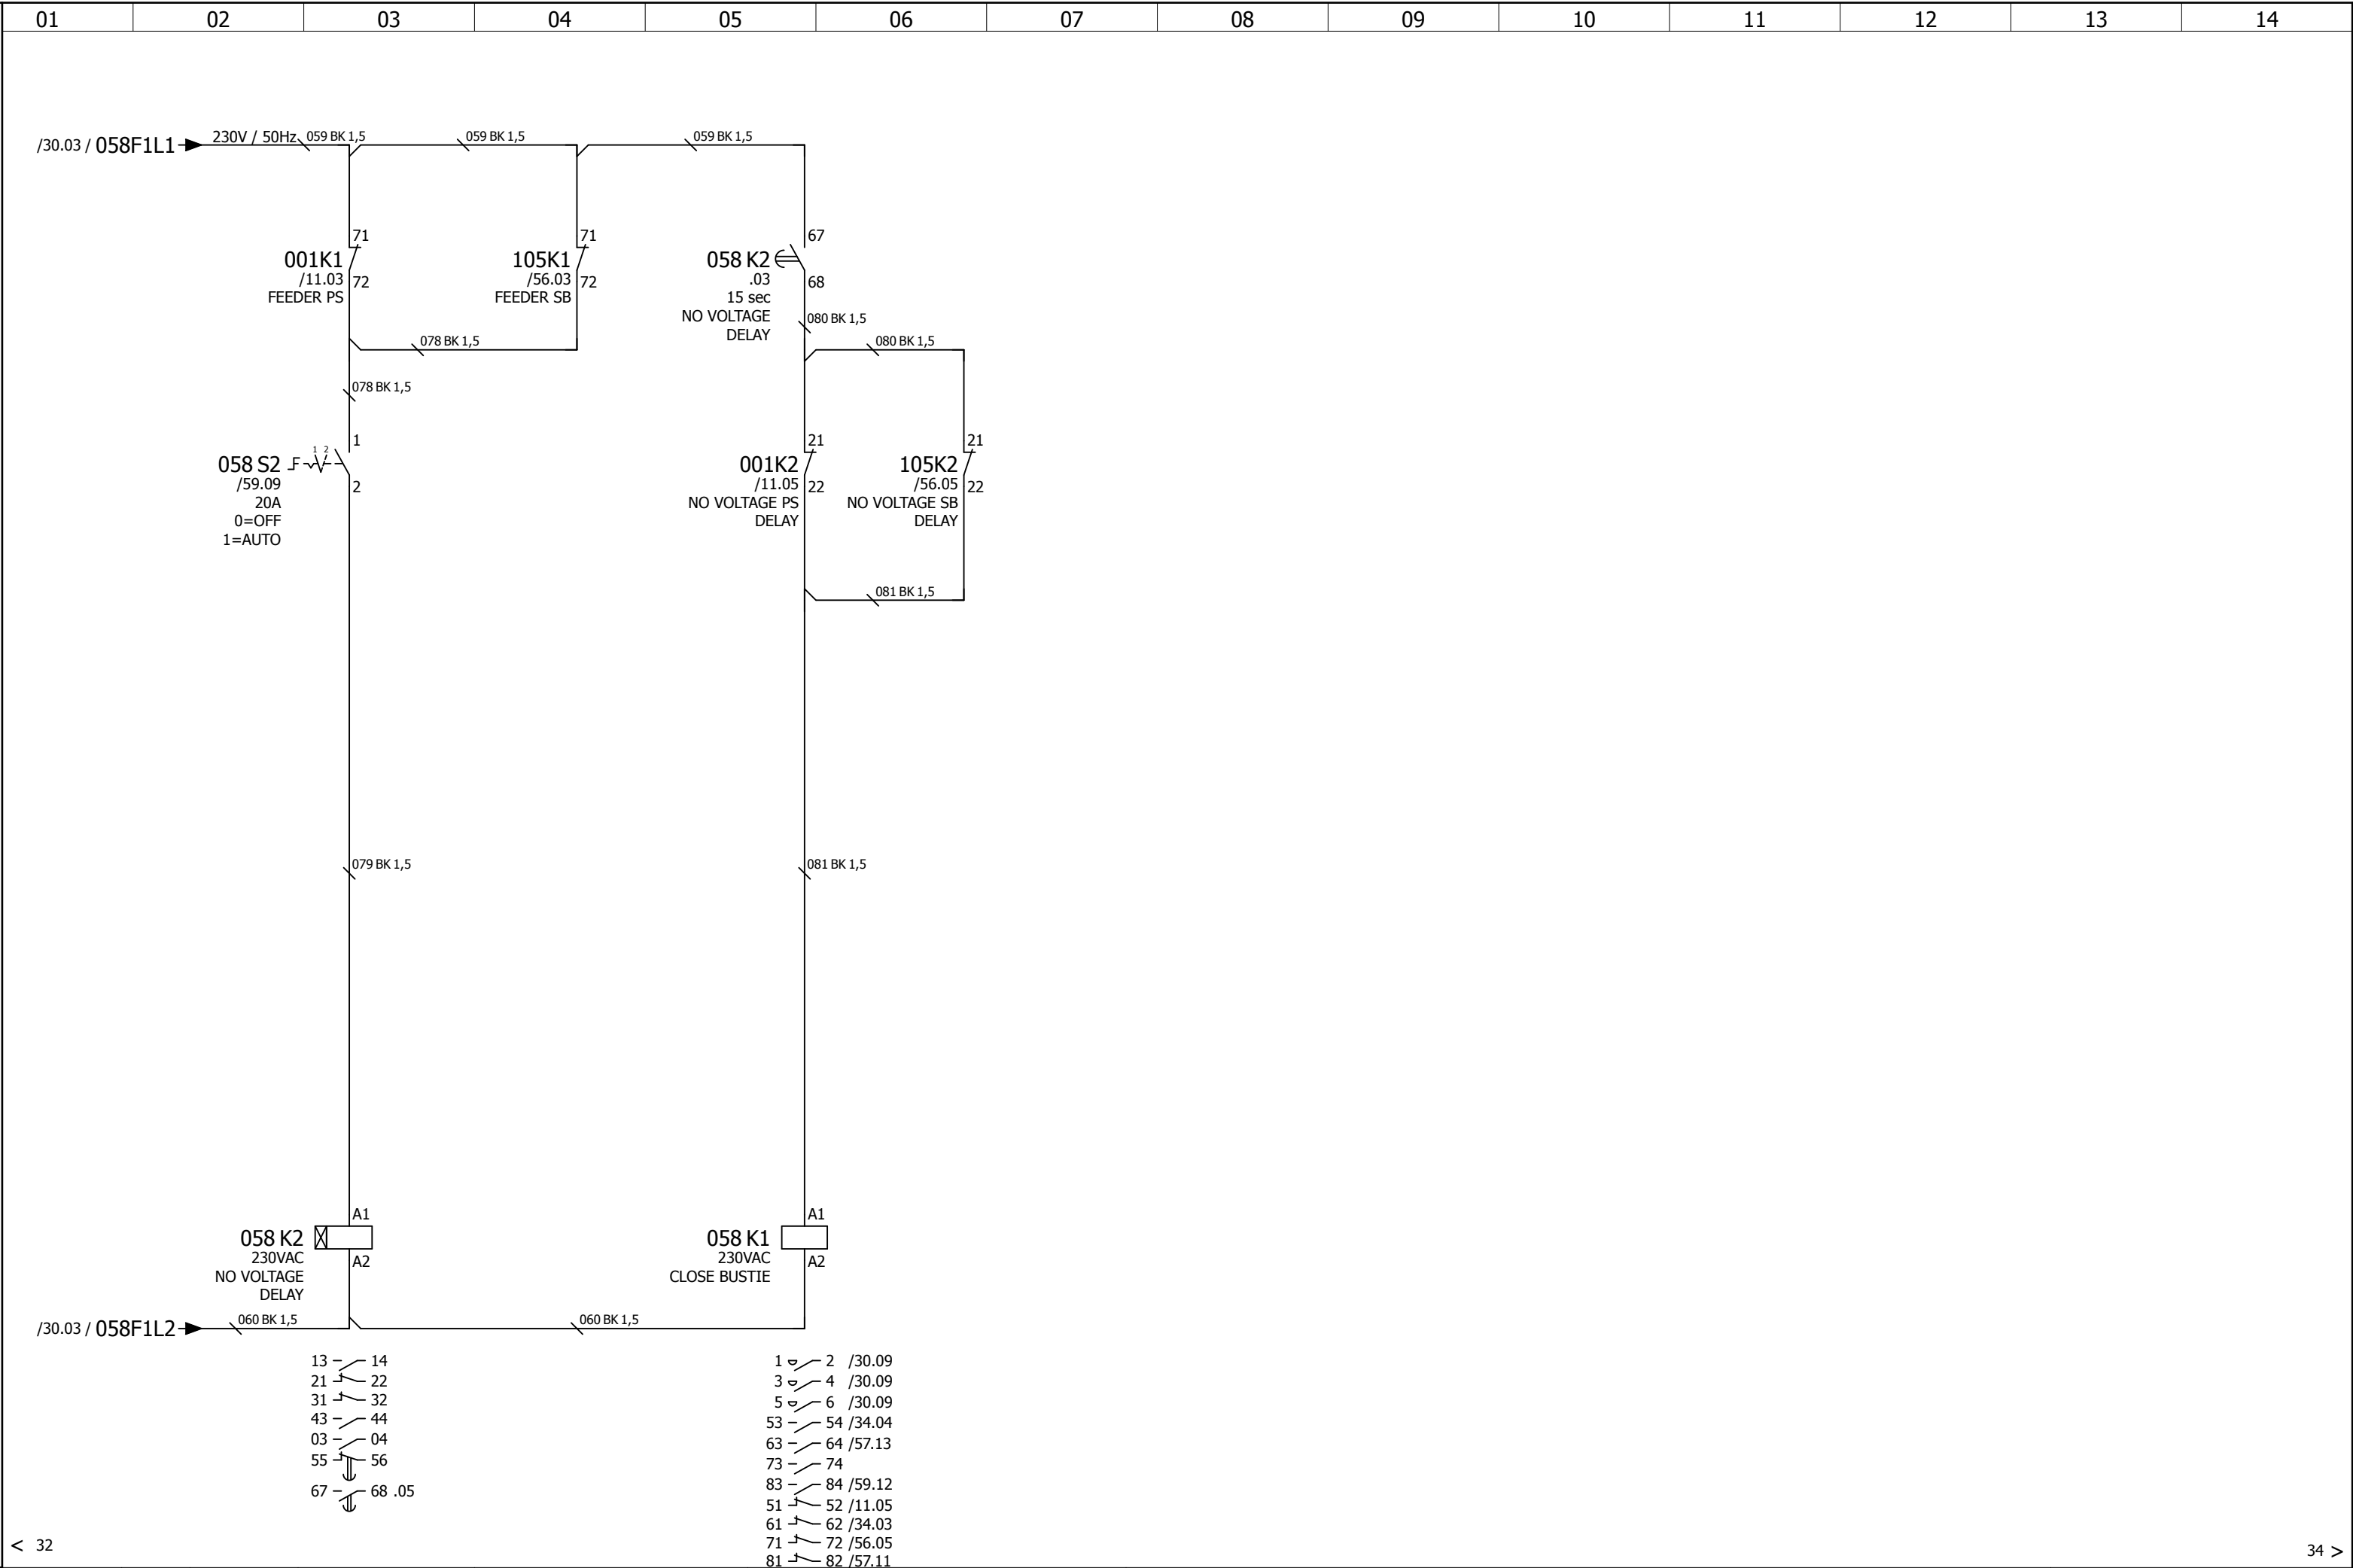


D	24-1-2011	PVR			* NO DELIVERY ALEWIJNSE			ALEWIJNSE MARINE B.V. ENERGIEWEG 46/C 6541 CX NIJMEGEN	IHC DREDGERS BV - TSHD5500 DCI-3 "11L" MAIN DISTRIBUTION BOARD 3X230V BUSTIE CONTROL CIRCUIT SECTION 1	Yard no : CO1266
M	5-12-2013	IEN	REV	1	PANEL IP23					Project : 23000143
STAT	AS BUILT									Class : LROS/IRS
	05-12-2013	IEN	CHK							Page : 11L -33

No part of this work may be copied, stored or published without prior written permission of Alewijnse Marine Systems.

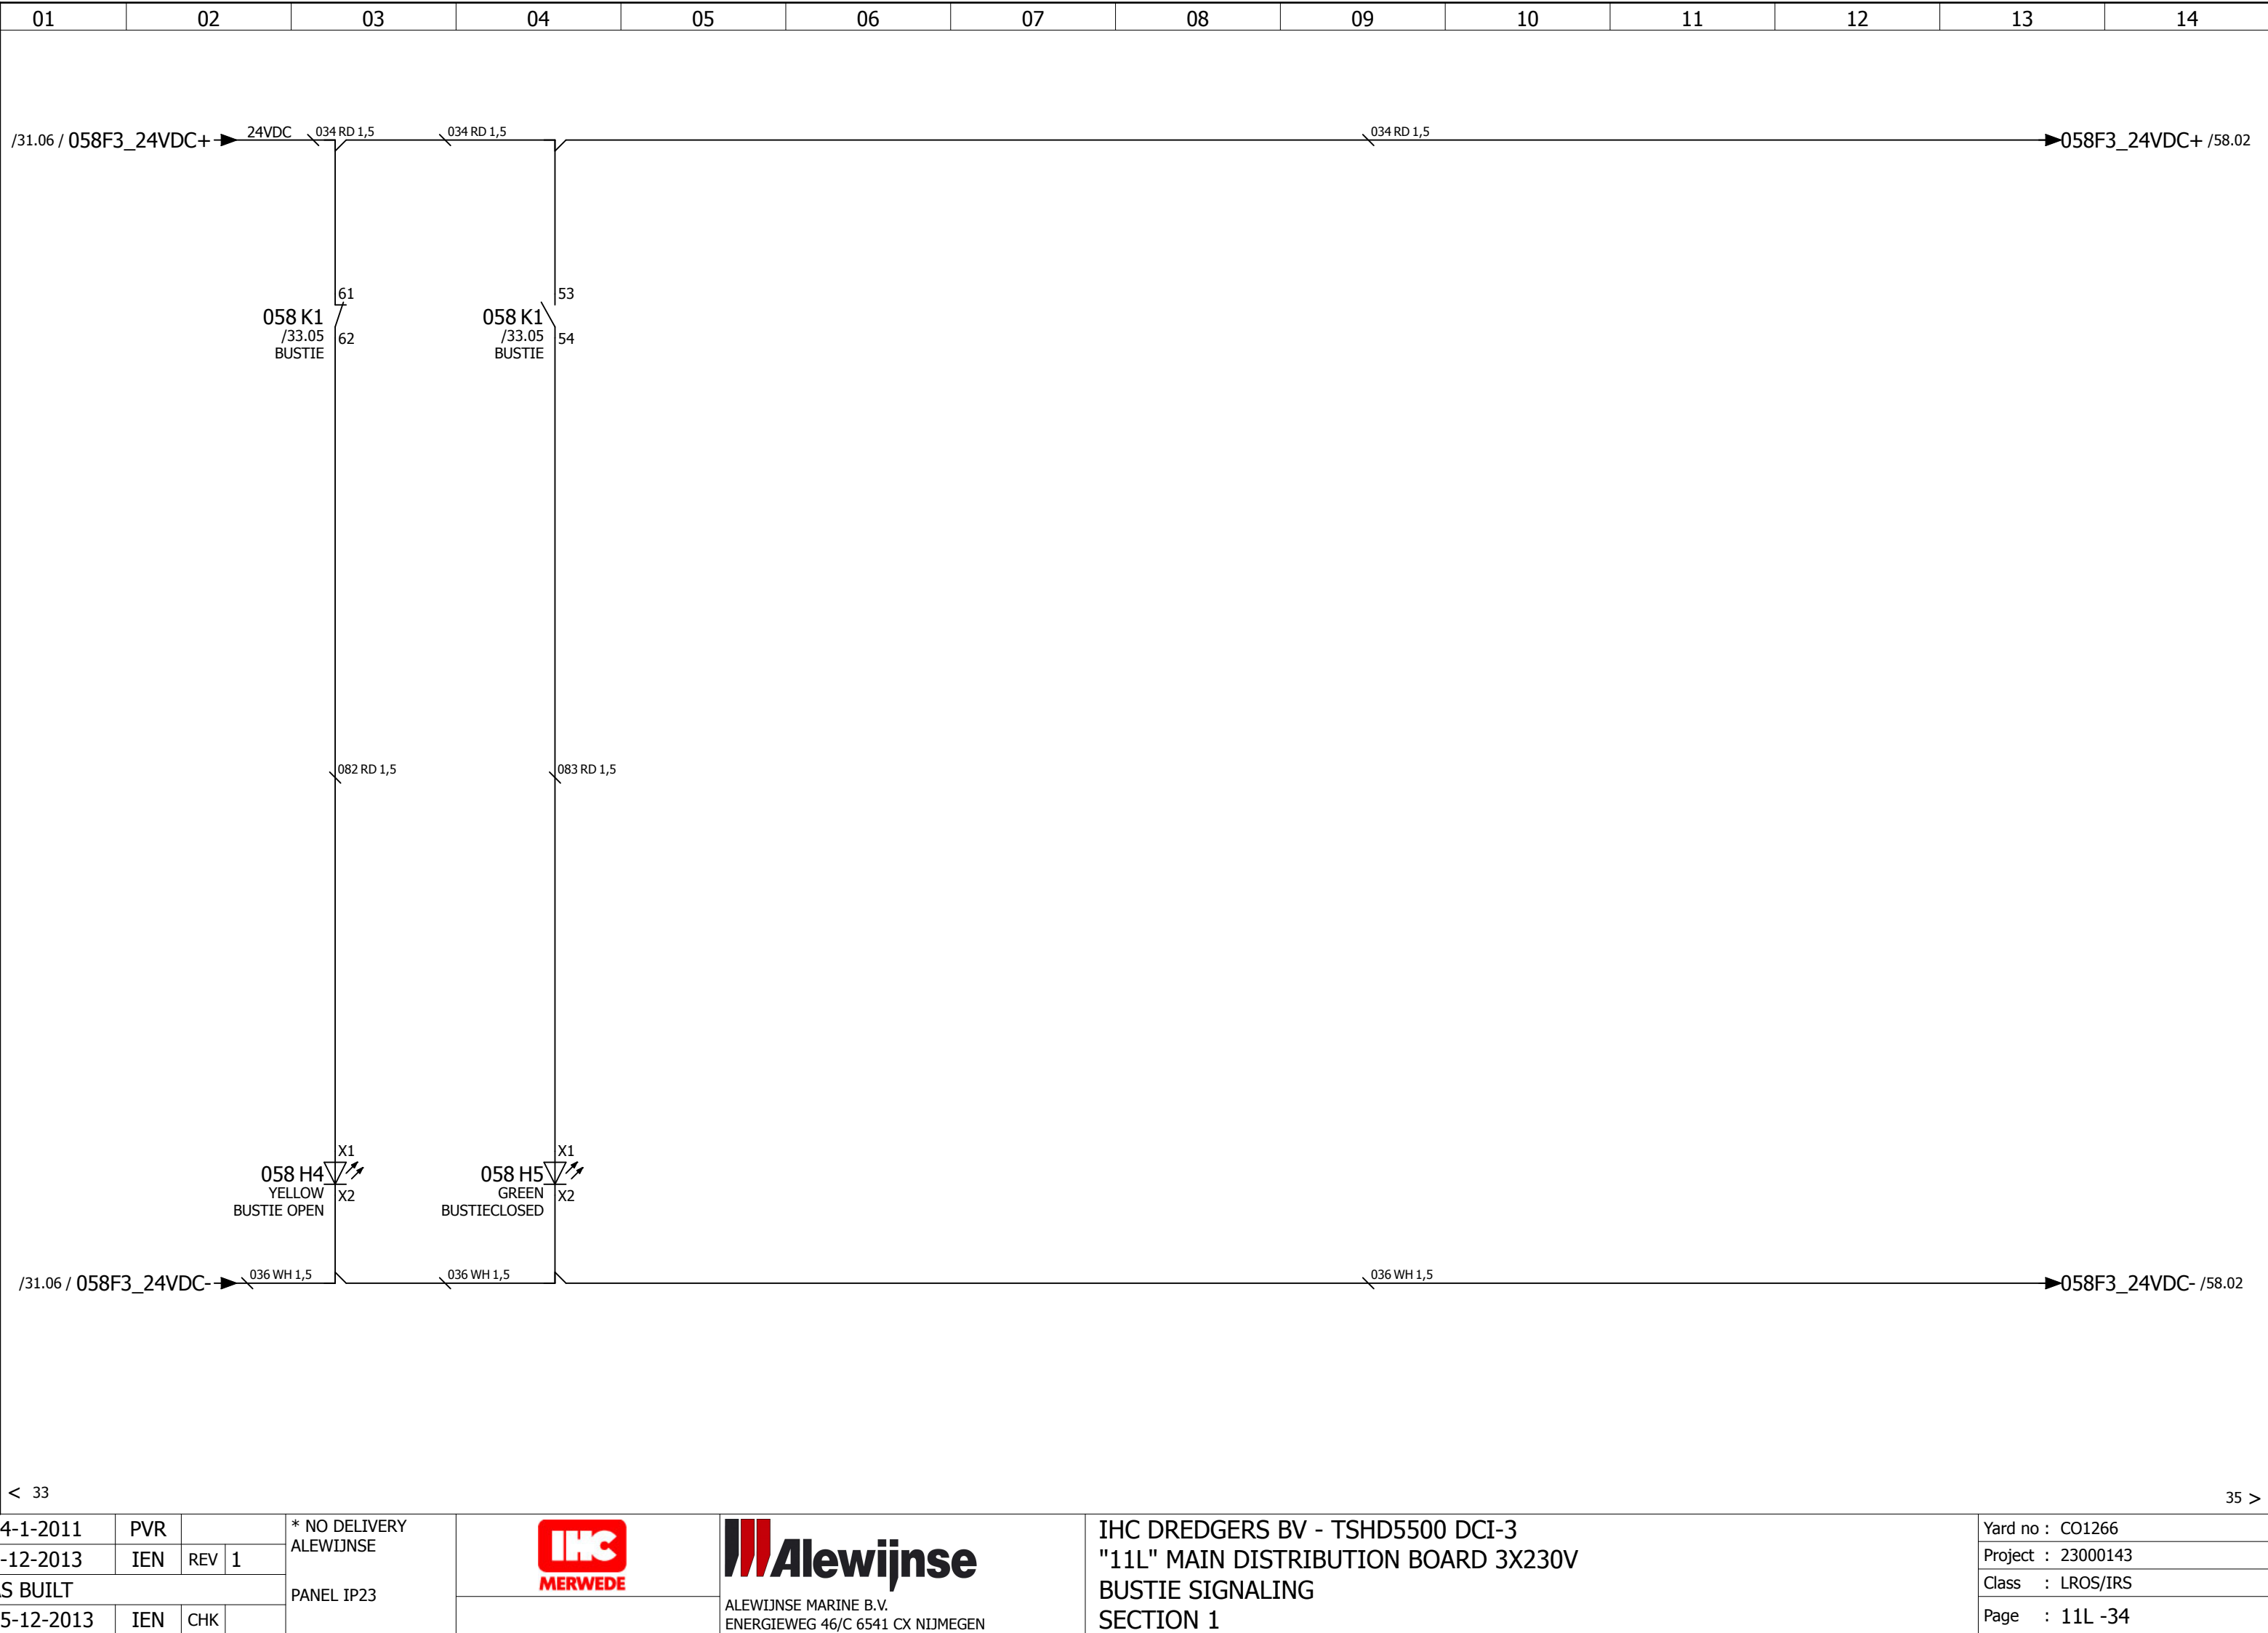


STAT	D	24-1-2011	PVR		* NO DELIVERY ALEWIJNSE			IHC DREDGERS BV - TSHD5500 DCI-3 "11L" MAIN DISTRIBUTION BOARD 3X230V BUSTIE SIGNALING SECTION 1	Yard no : CO1266		
	M	5-12-2013	IEN	REV					1	Project : 23000143	
	AS BUILT					PANEL IP23			Class : LROS/IRS		
		05-12-2013	IEN	CHK					Page : 11L -34		

No part of this work may be copied, stored or published without prior written permission of Alewijnse Marine Systems.

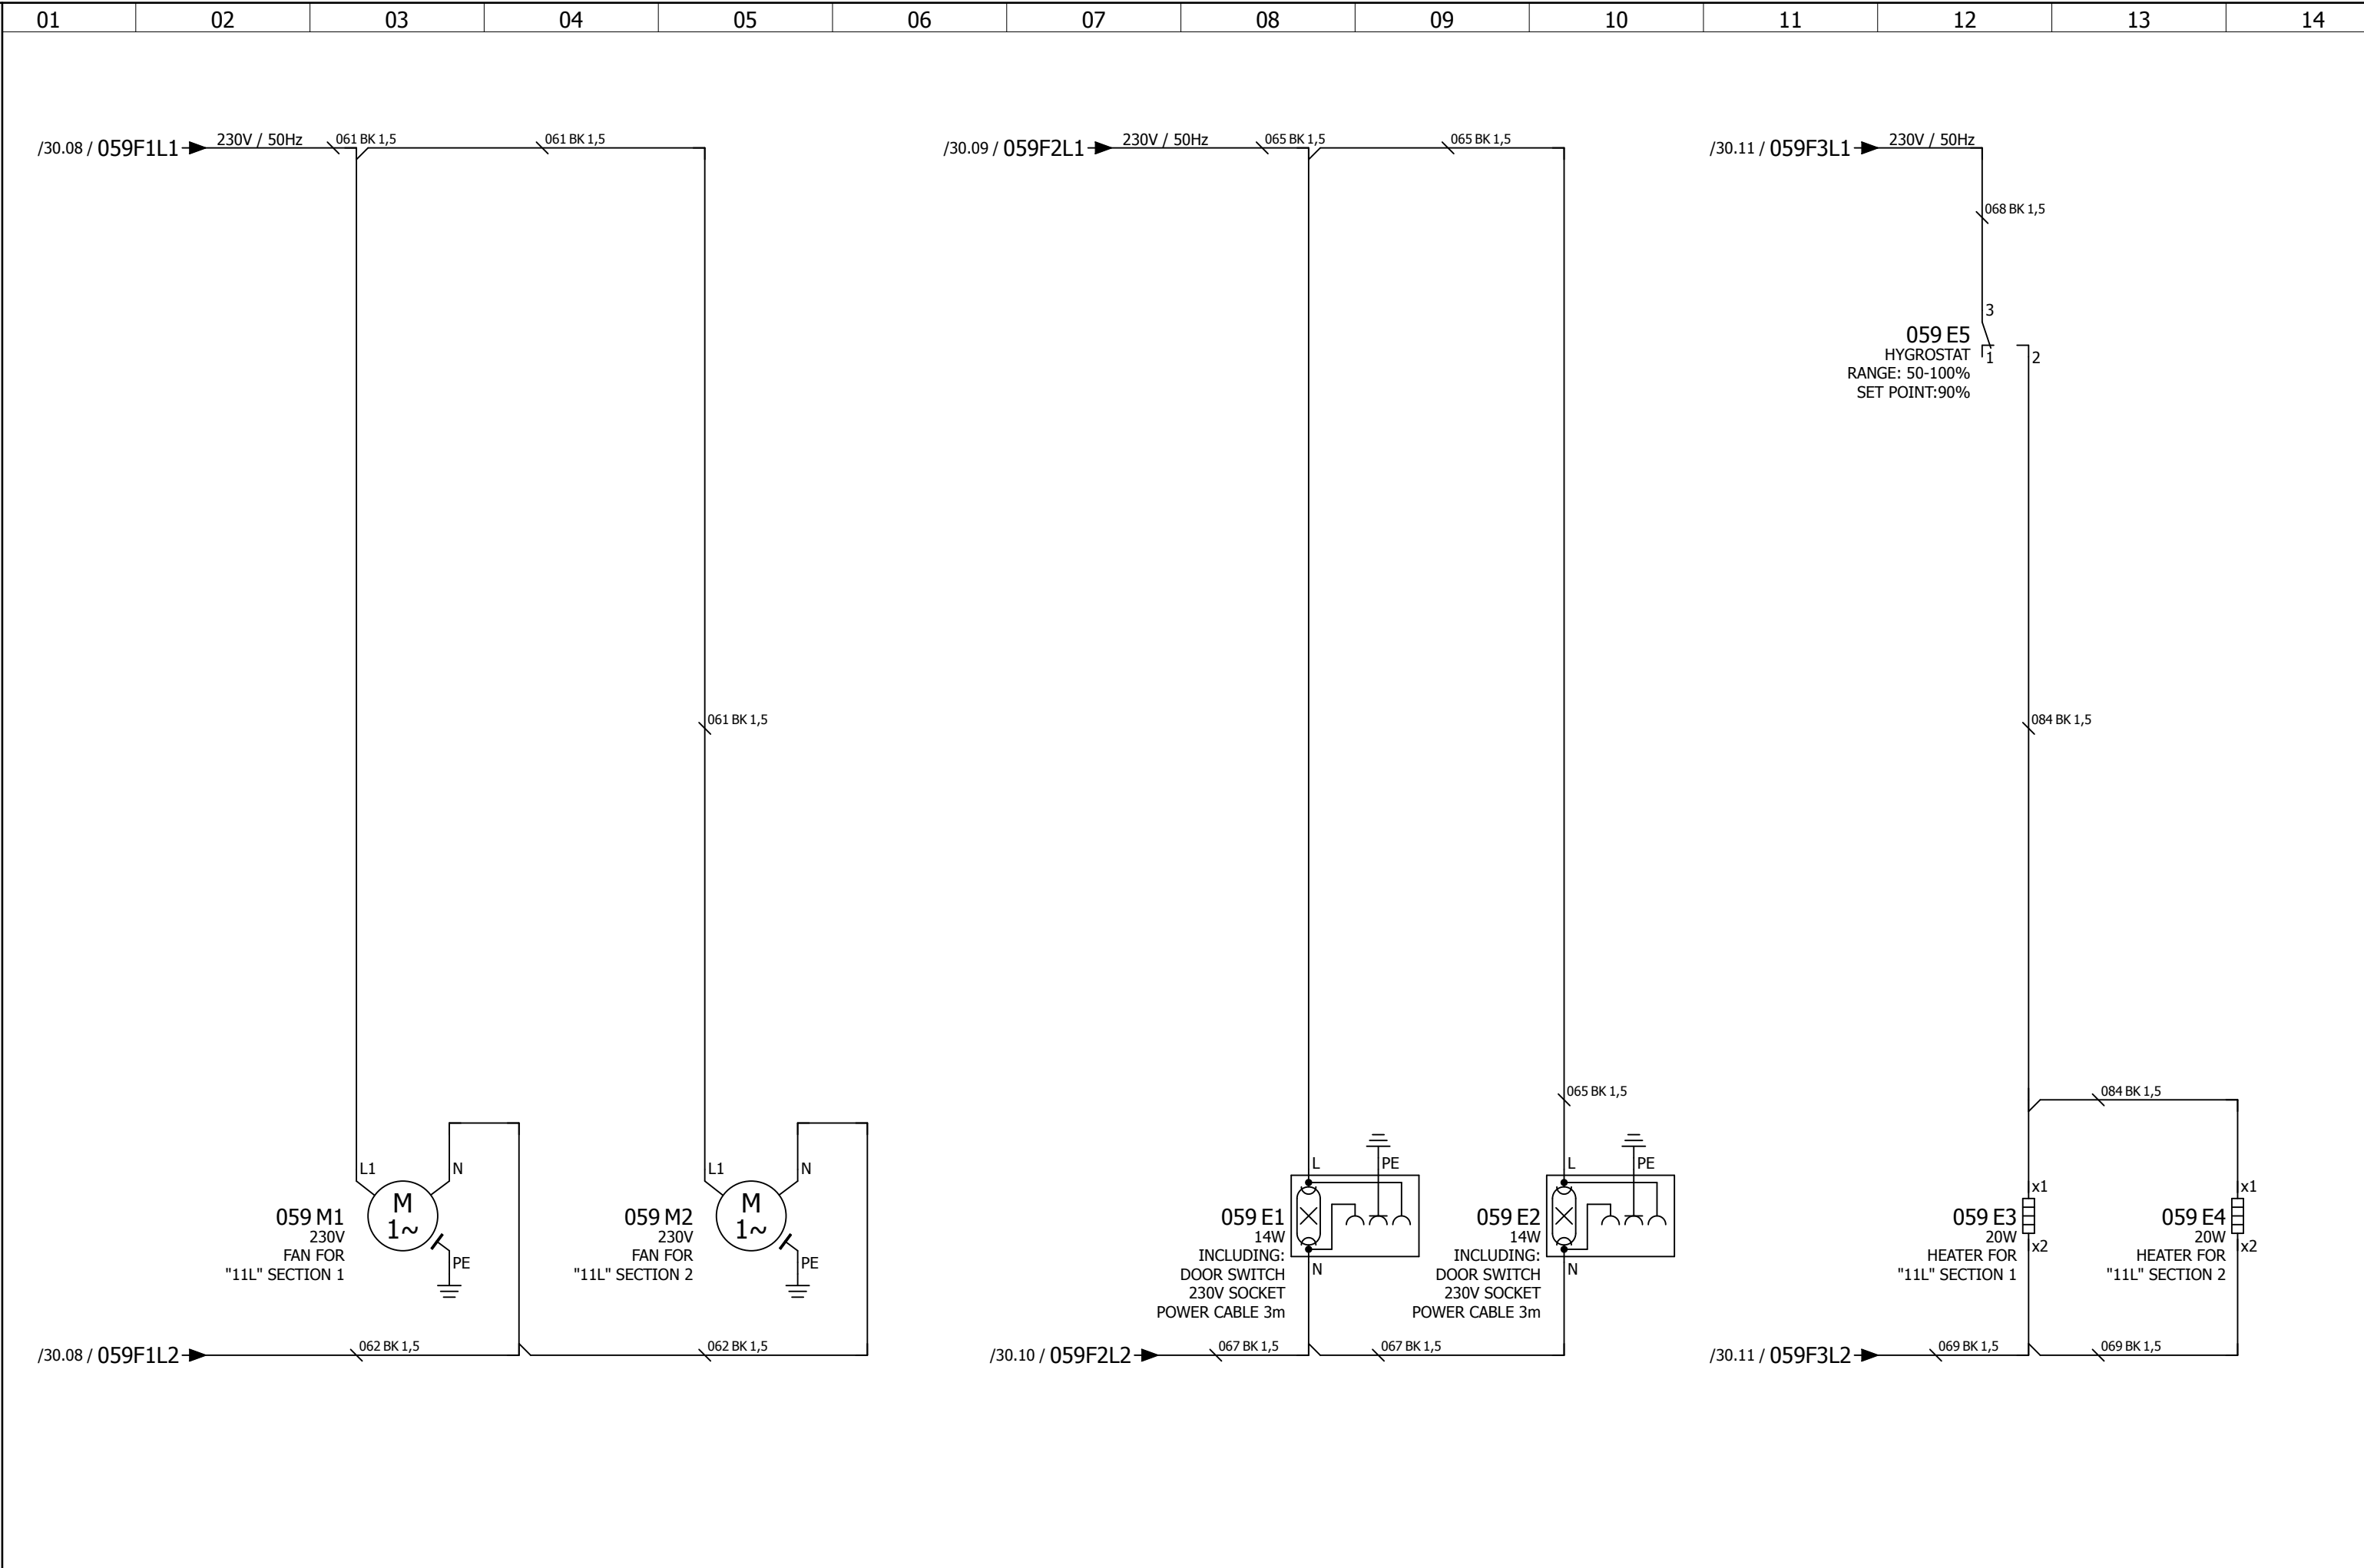


D	24-1-2011	PVR			* NO DELIVERY ALEWIJNSE			ALEWIJNSE MARINE B.V. ENERGIEWEG 46/C 6541 CX NIJMEGEN	IHC DREDGERS BV - TSHD5500 DCI-3 "11L" MAIN DISTRIBUTION BOARD 3X230V VENTILATION / LIGHTING / HEATING SECTION 2	Yard no : CO1266 Project : 23000143 Class : LROS/IRS Page : 11L -35
M	5-12-2013	IEN	REV	1						
STAT	AS BUILT				PANEL IP23					
	05-12-2013	IEN	CHK							

No part of this work may be copied, stored or published without prior written permission of Alewijnse Marine Systems.

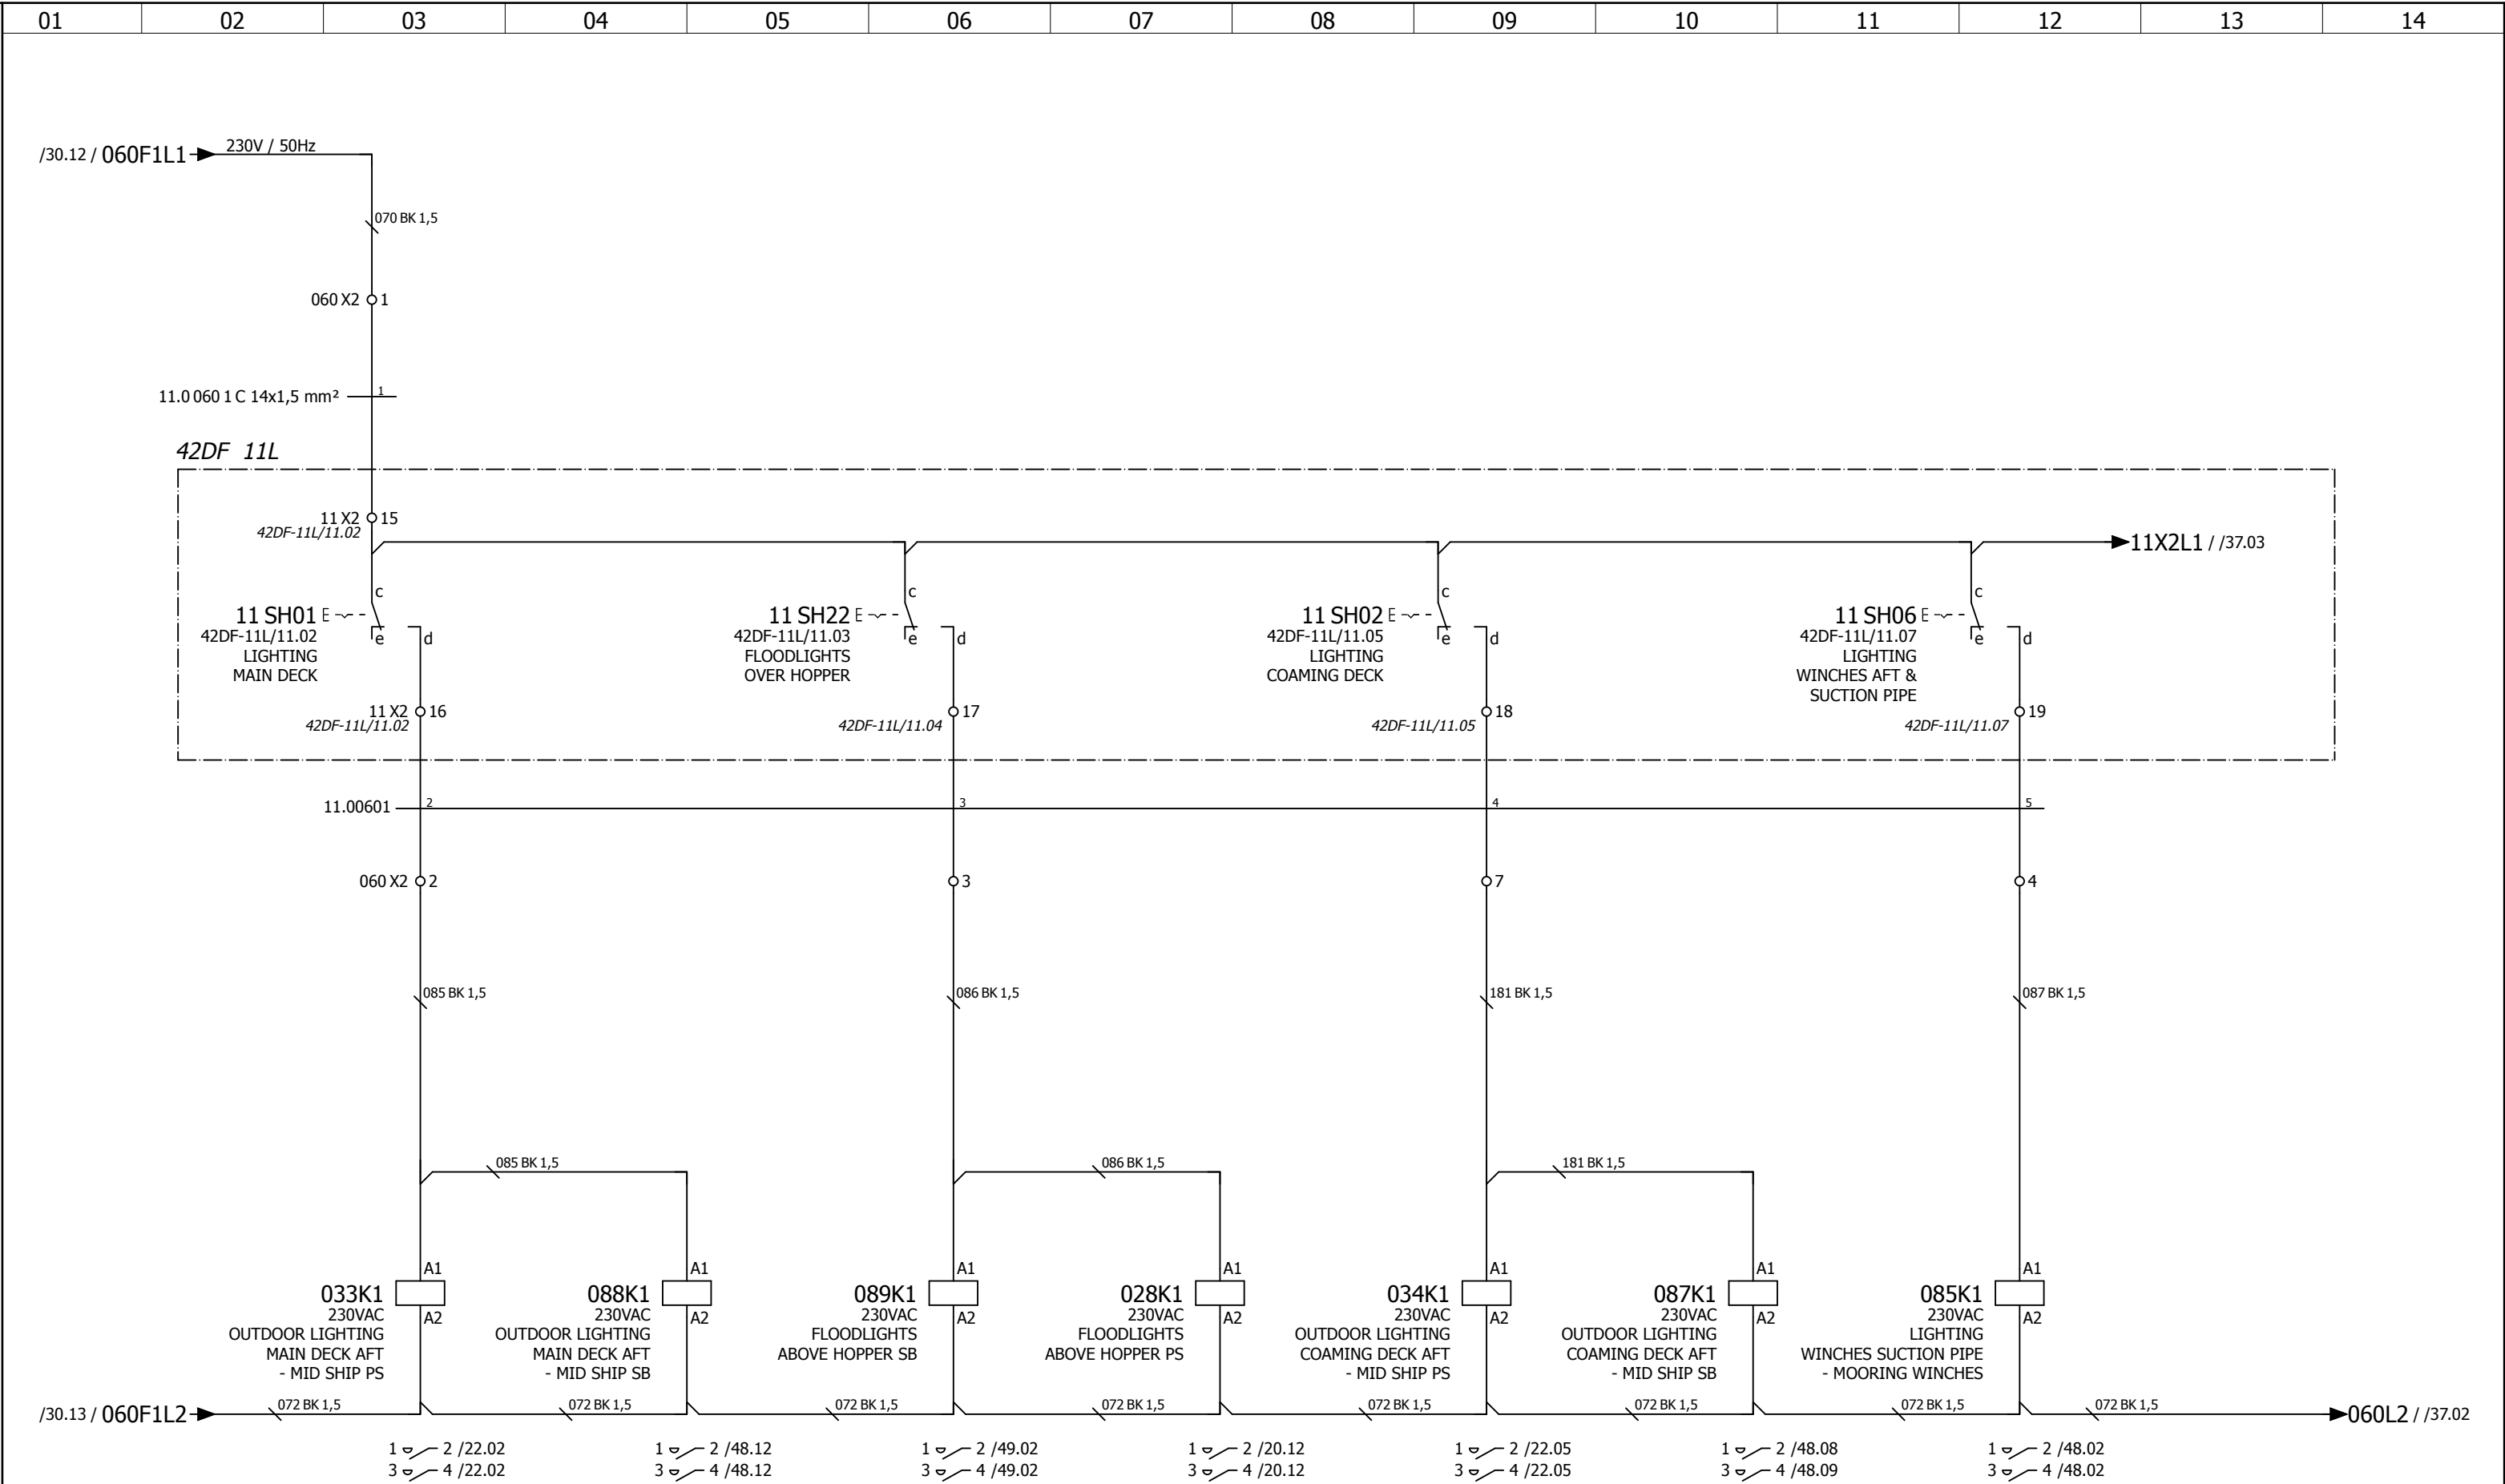


D	24-1-2011	PVR			* NO DELIVERY ALEWIJNSE			ALEWIJNSE MARINE B.V. ENERGIEWEG 46/C 6541 CX NIJMEGEN	IHC DREDGERS BV - TSHD5500 DCI-3 "11L" MAIN DISTRIBUTION BOARD 3X230V OUTDOOR LIGHTING CONTROL CIRCUIT SECTION 2	Yard no : CO1266				
M	5-12-2013	IEN	REV	1						Project : 23000143				
STAT	AS BUILT				PANEL IP23					Class : LROS/IRS				
	05-12-2013	IEN	CHK							Page : 11L -36				

No part of this work may be copied, stored or published without prior written permission of Alewijnse Marine Systems.

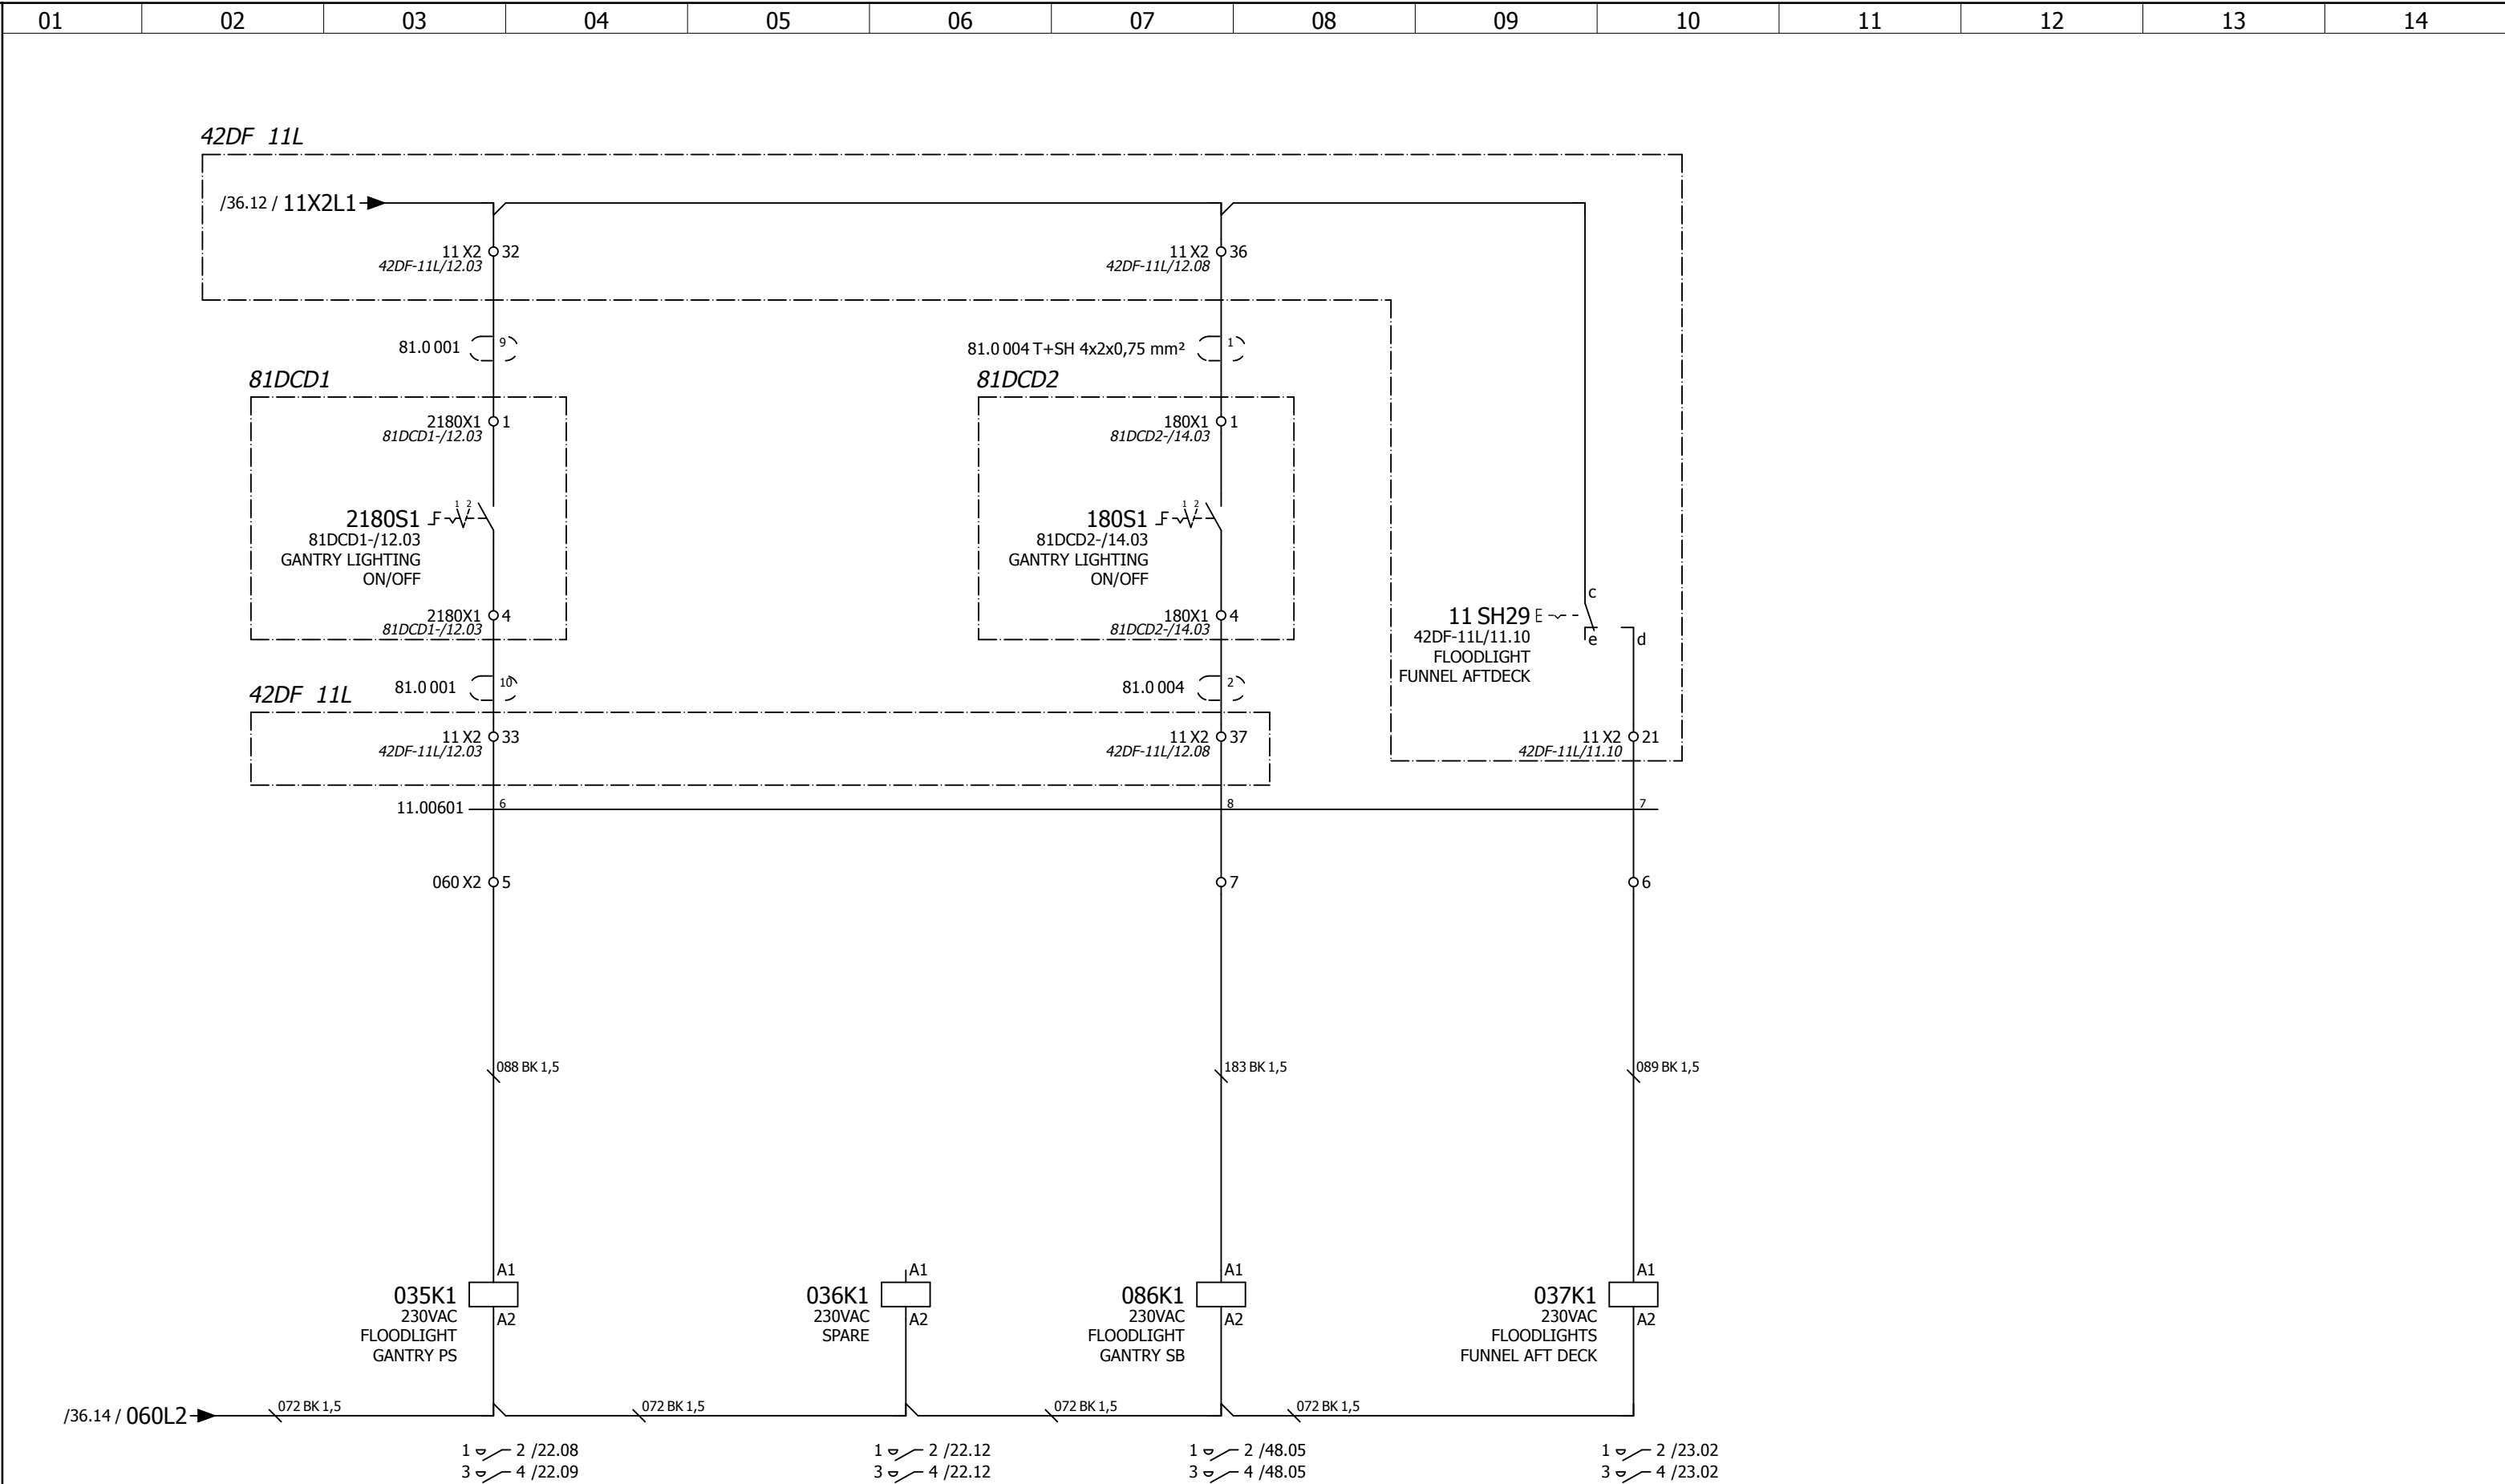

D	24-1-2011	PVR			* NO DELIVERY ALEWIJNSE			ALEWIJNSE MARINE B.V. ENERGIEWEG 46/C 6541 CX NIJMEGEN	IHC DREDGERS BV - TSHD5500 DCI-3 "11L" MAIN DISTRIBUTION BOARD 3X230V OUTDOOR LIGHTING CONTROL CIRCUIT SECTION 2	Yard no : CO1266
M	5-12-2013	IEN	REV	1						Project : 23000143
STAT	AS BUILT				PANEL IP23					Class : LROS/IRS
	05-12-2013	IEN	CHK							Page : 11L -37

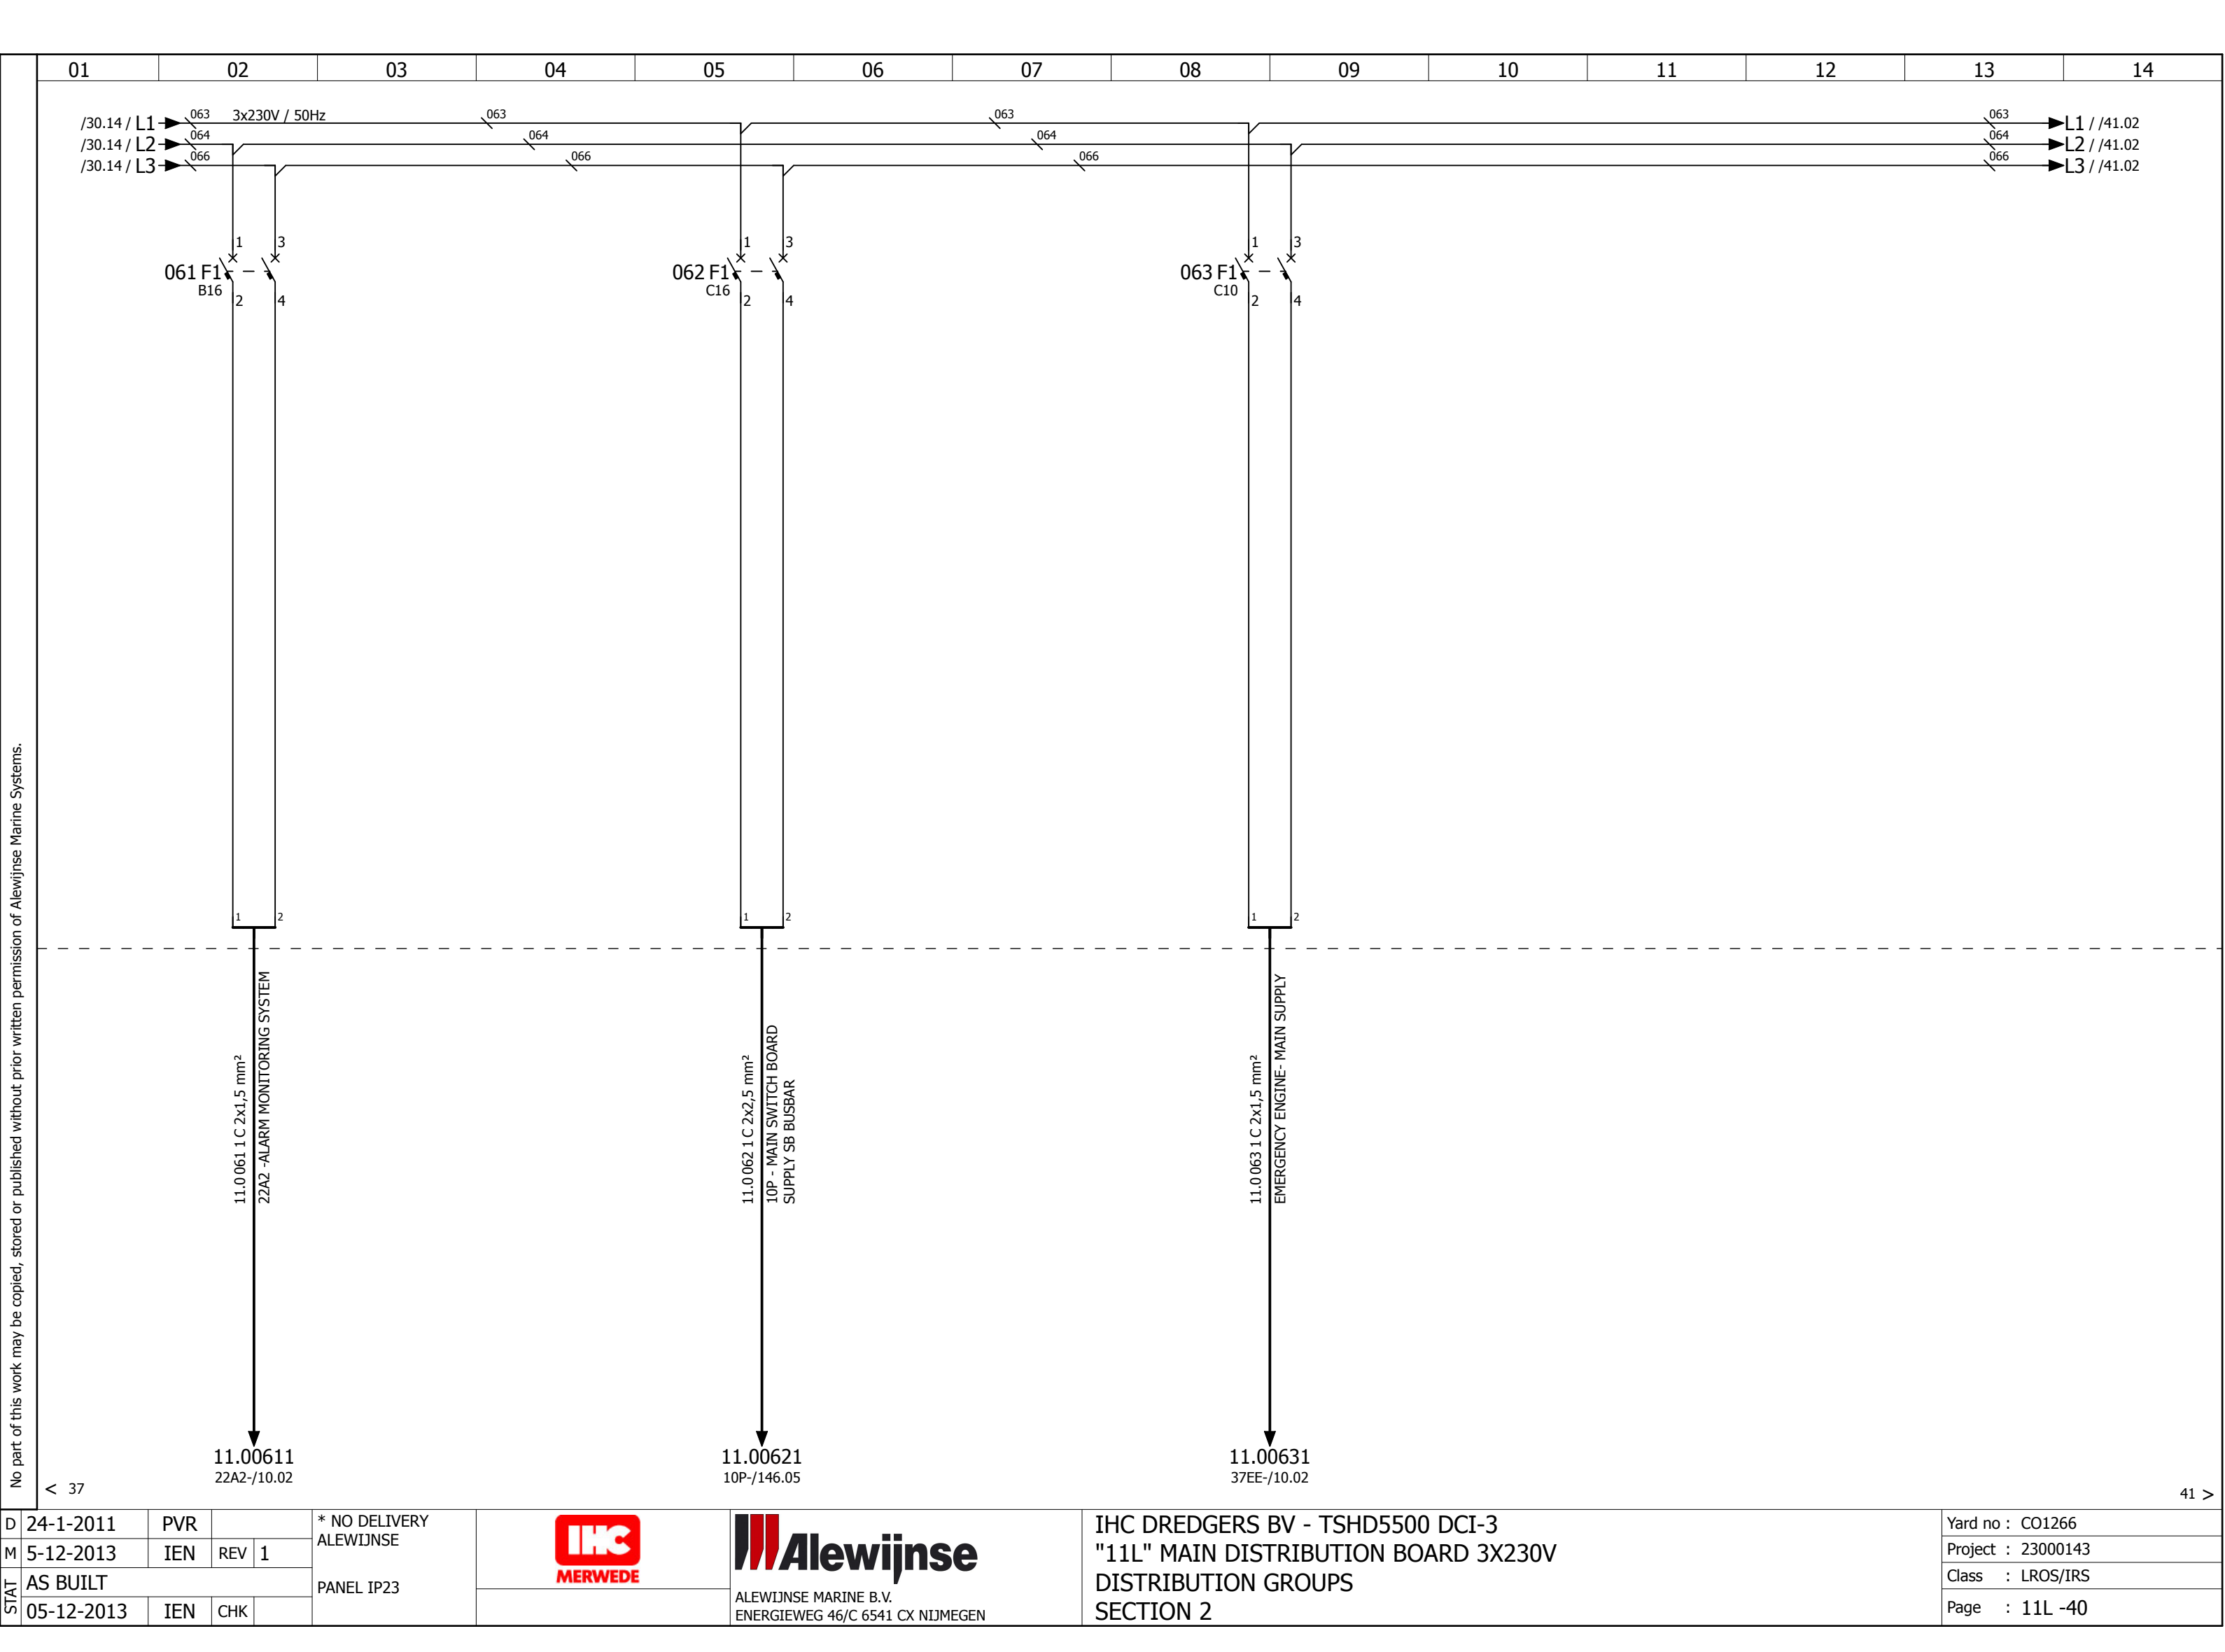


D	24-1-2011	PVR		
M	5-12-2013	IEN	REV	1
STAT	AS BUILT			
	05-12-2013	IEN	CHK	

* NO DELIVERY ALEWIJNSE
PANEL IP23




IHC DREDGERS BV - TSHD5500 DCI-3
"11L" MAIN DISTRIBUTION BOARD 3X230V
DISTRIBUTION GROUPS
SECTION 2

Yard no : CO1266
Project : 23000143
Class : LROS/IRS
Page : 11L -40

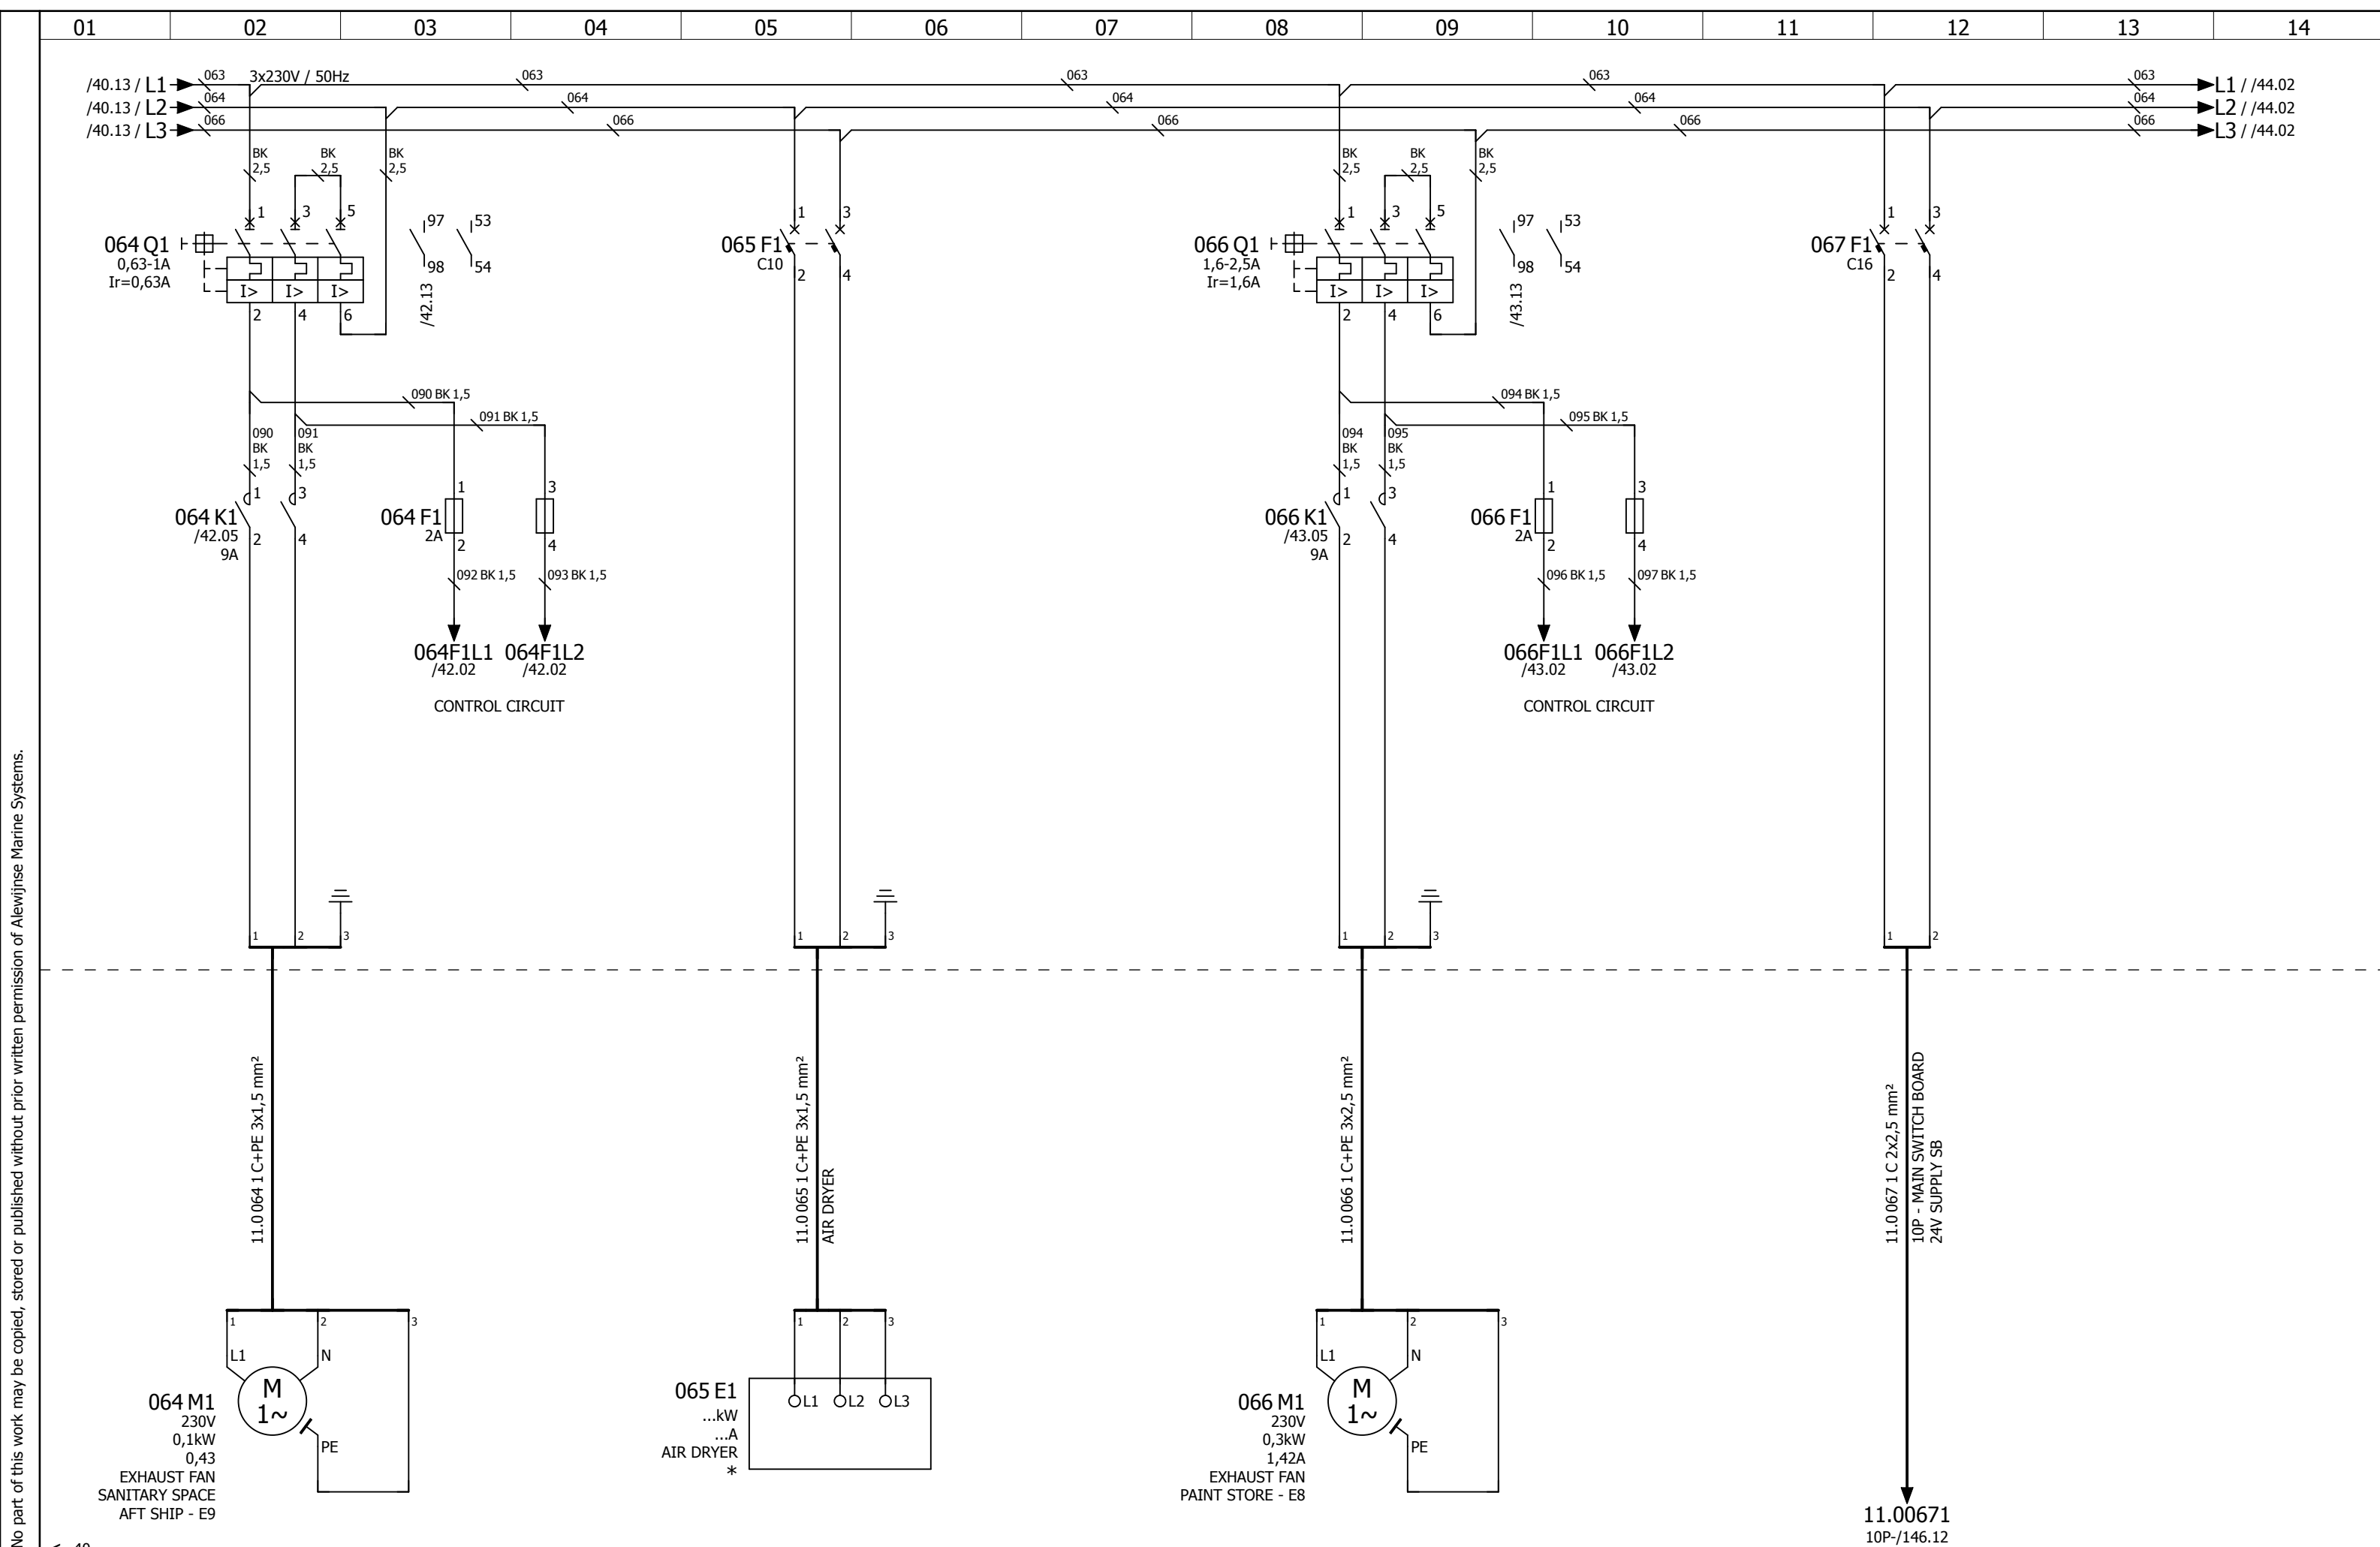




D	24-1-2011	PVR			* NO DELIVERY ALEWIJNSE		 ALEWIJNSE MARINE B.V. ENERGIEWEG 46/C 6541 CX NIJMEGEN	IHC DREDGERS BV - TSHD5500 DCI-3	Yard no : CO1266
M	5-12-2013	IEN	REV	1				"11L" MAIN DISTRIBUTION BOARD 3X230V	Project : 23000143
STAT	AS BUILT					PANEL IP23	EXHAUST FAN SANITARY SPACE AFT SHIP - E9 CONTROL CIRCUIT SECTION 2	Class : LROS/IRS	
	05-12-2013	IEN	CHK					Page : 11L -42	

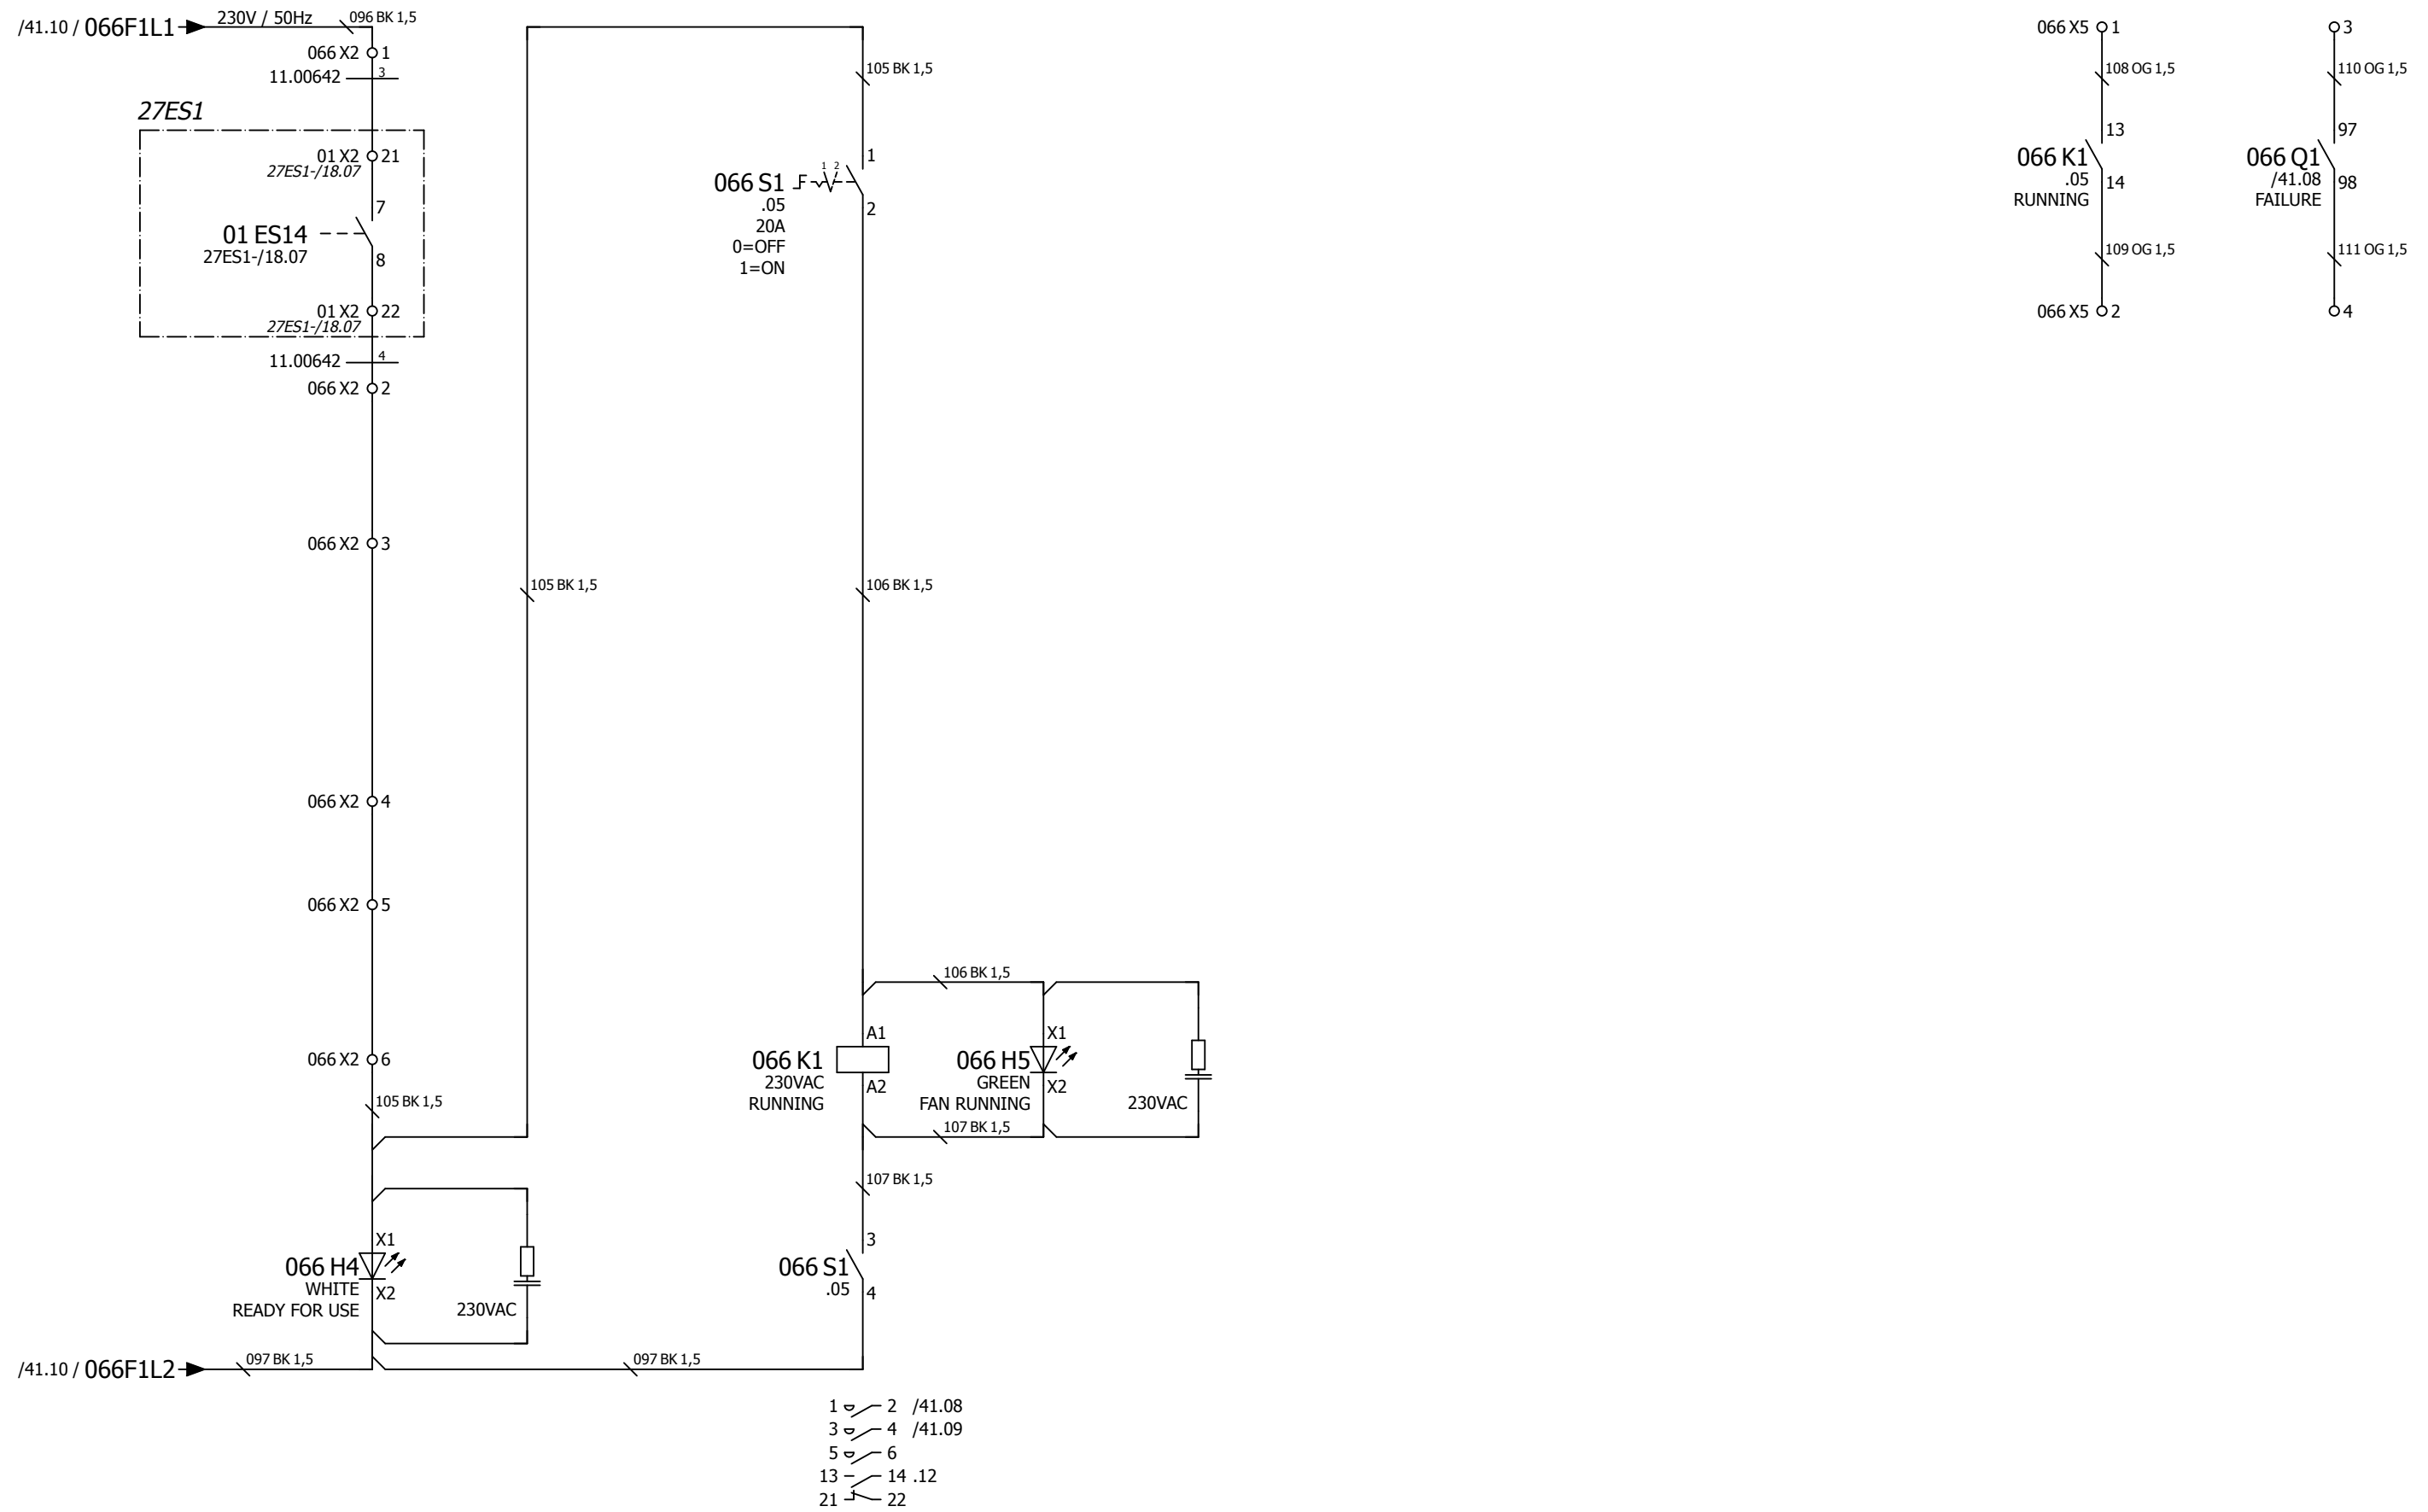


D	24-1-2011	PVR			* NO DELIVERY ALEWIJNSE		 ALEWIJNSE MARINE B.V. ENERGIEWEG 46/C 6541 CX NIJMEGEN	IHC DREDGERS BV - TSHD5500 DCI-3	Yard no : CO1266
M	5-12-2013	IEN	REV	1				Project : 23000143	
STAT	AS BUILT					PANEL IP23		EXHAUST FAN PAINT STORE - E8 CONTROL CIRCUIT	Class : LROS/IRS
	05-12-2013	IEN	CHK					SECTION 2	Page : 11L -43


No part of this work may be copied, stored or published without prior written permission of Alewijnse Marine Systems.

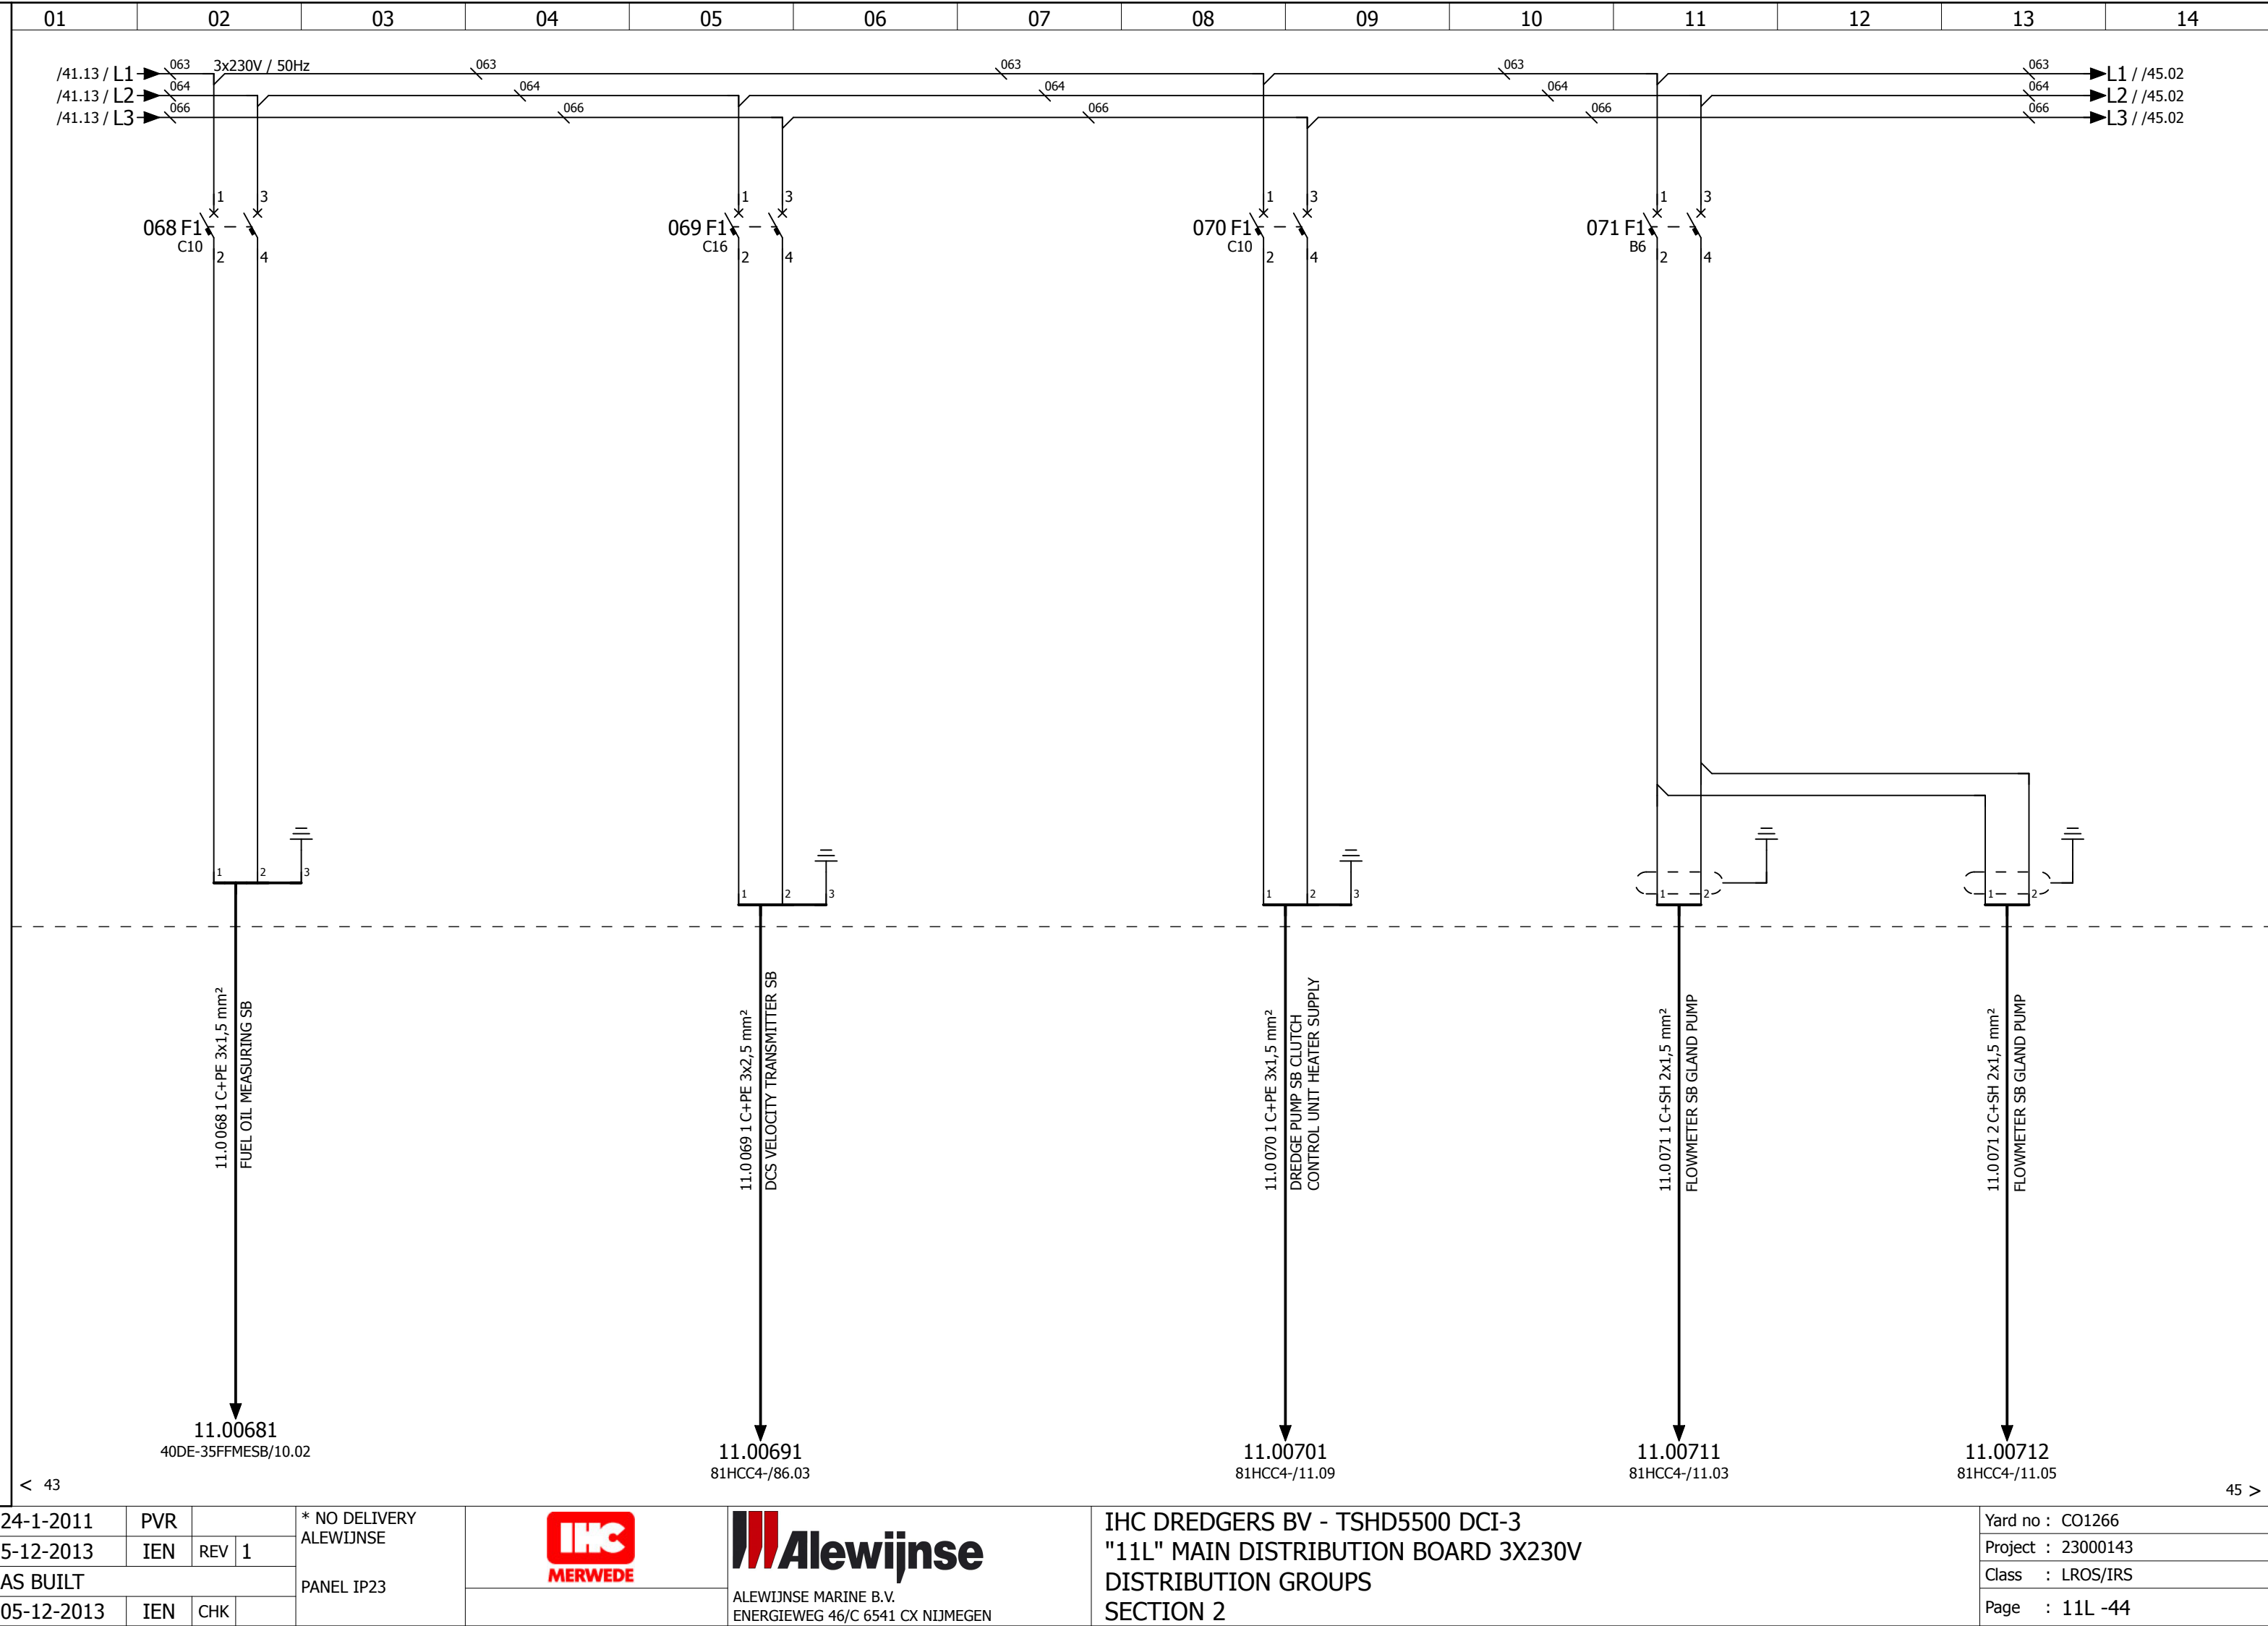

STAT	D	24-1-2011	PVR		* NO DELIVERY ALEWIJNSE			ALEWIJNSE MARINE B.V. ENERGIEWEG 46/C 6541 CX NIJMEGEN	IHC DREDGERS BV - TSHD5500 DCI-3 "11L" MAIN DISTRIBUTION BOARD 3X230V DISTRIBUTION GROUPS SECTION 2	Yard no : CO1266	
	M	5-12-2013	IEN	REV						1	Project : 23000143
	AS BUILT					PANEL IP23				Class : LROS/IRS	
		05-12-2013	IEN	CHK			Page : 11L -44				

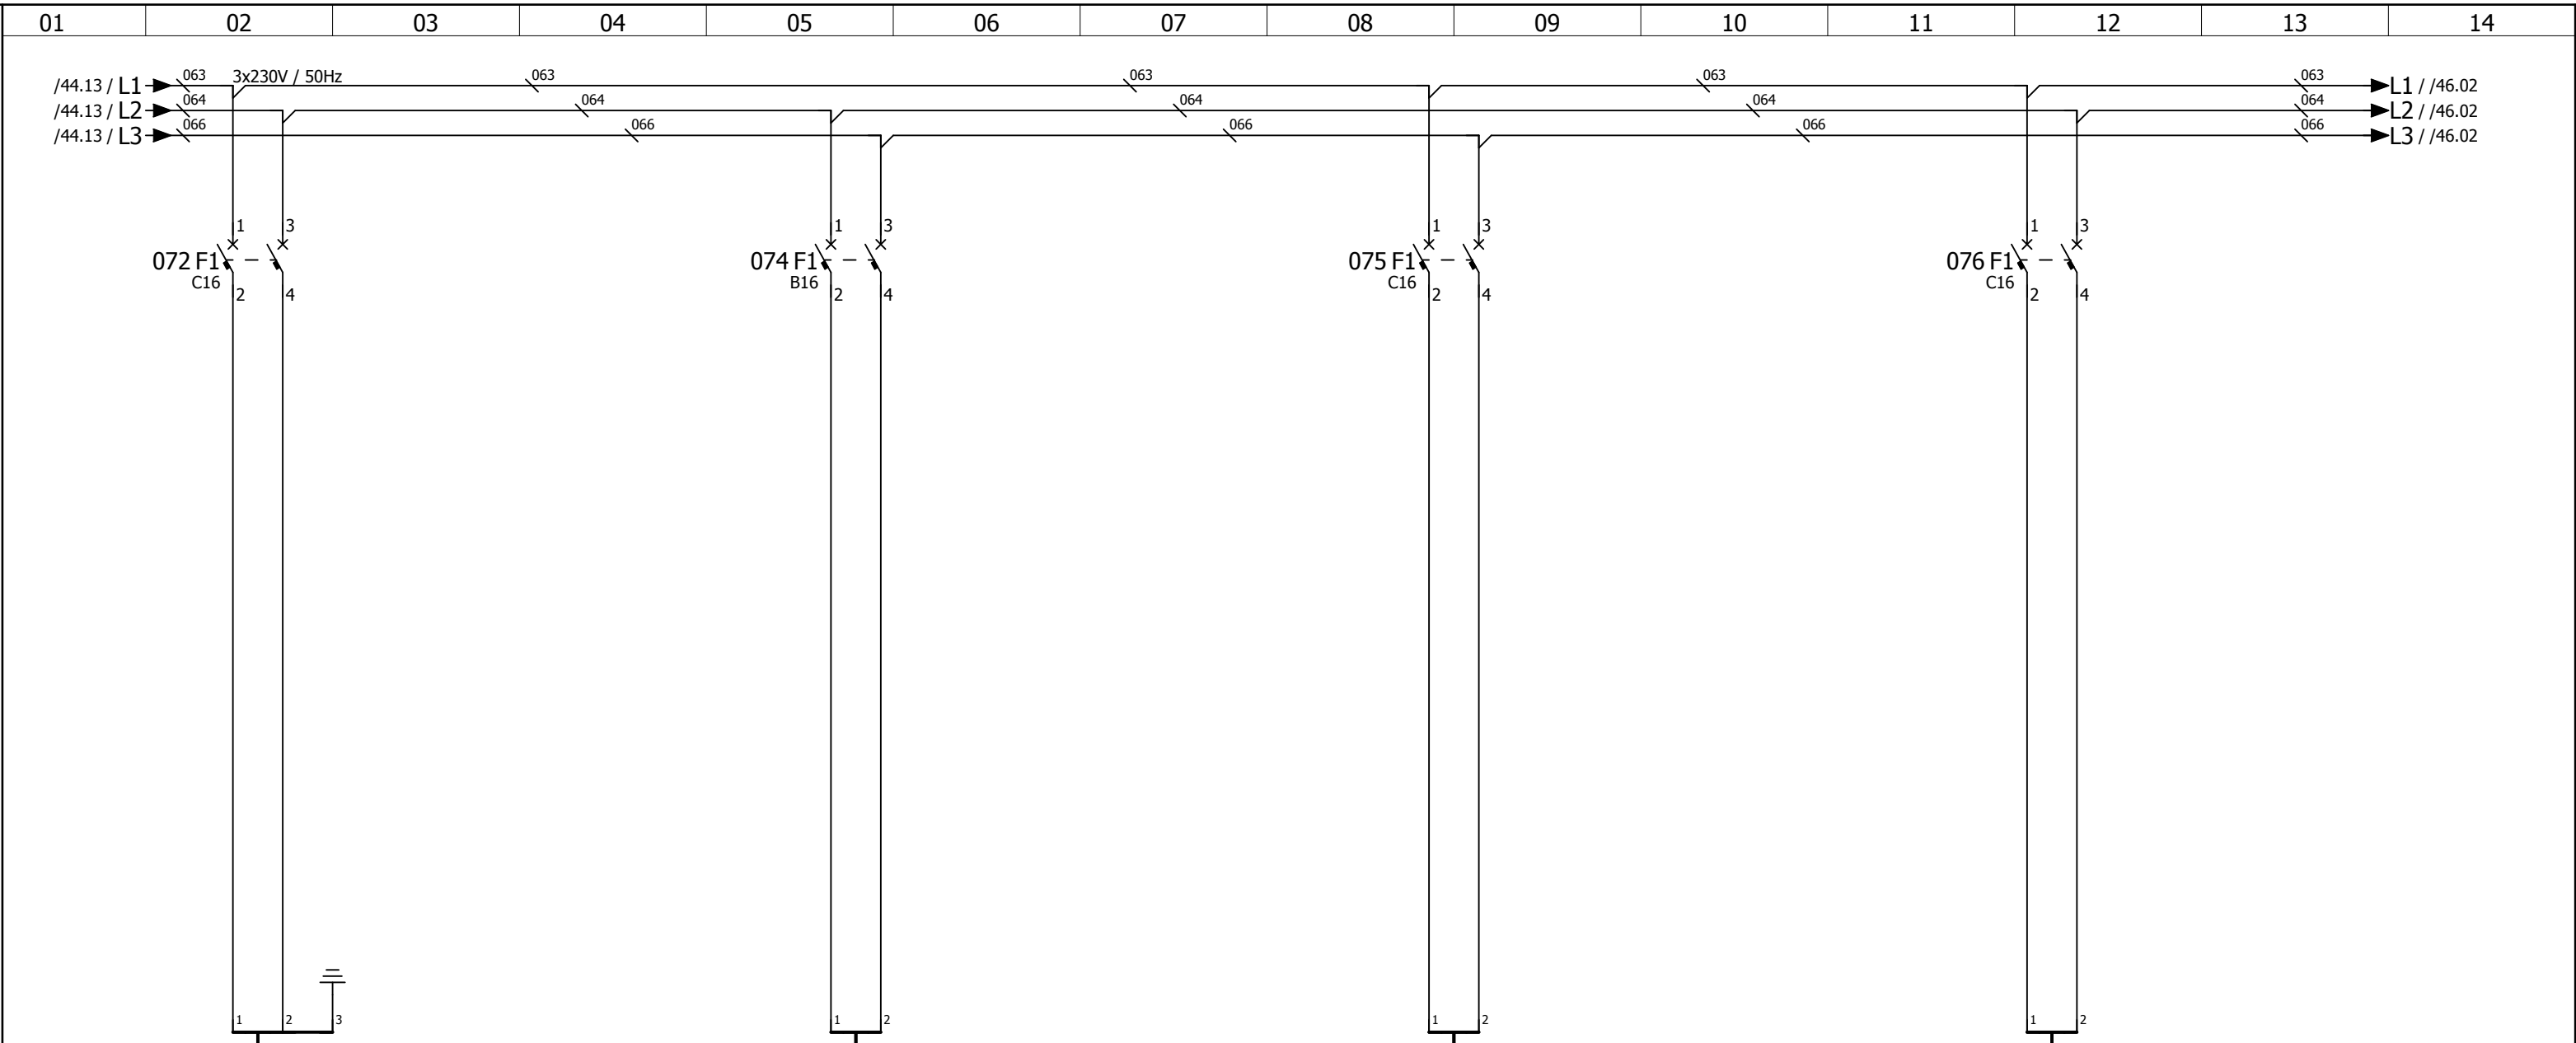



No part of this work may be copied, stored or published without prior written permission of Alewijnse Marine Systems.

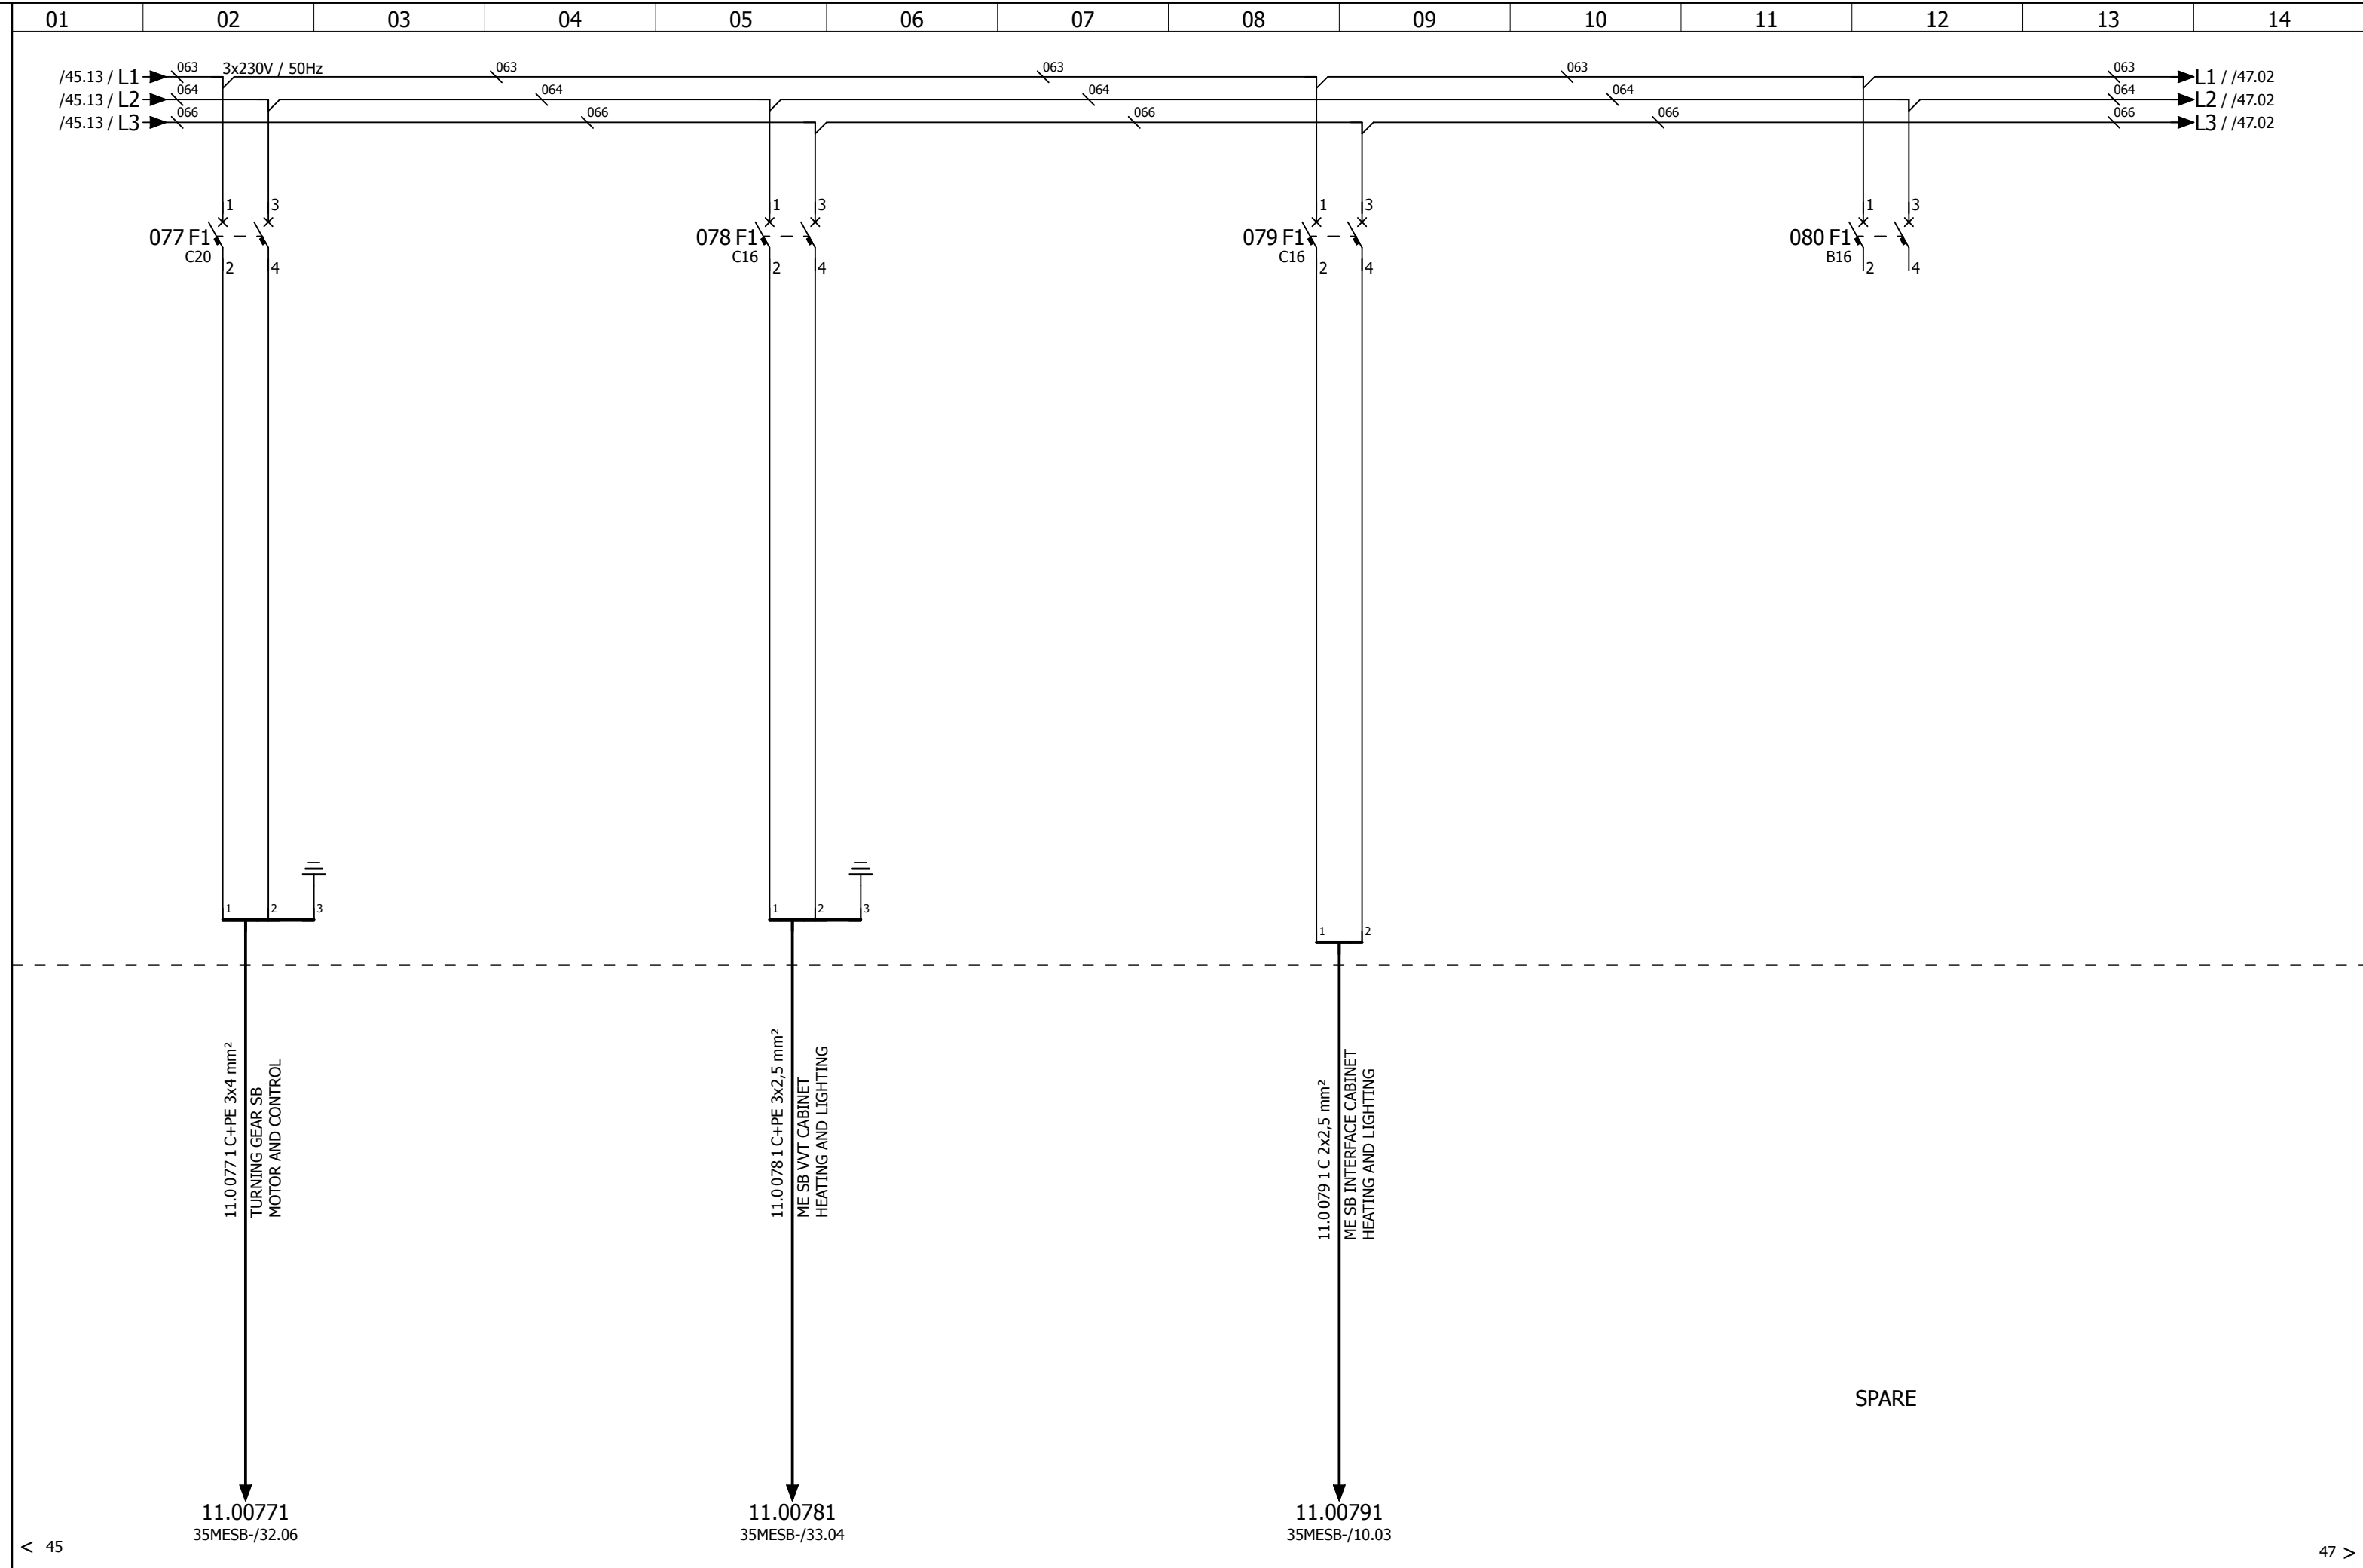

D	24-1-2011	PVR			* NO DELIVERY ALEWIJNSE			ALEWIJNSE MARINE B.V. ENERGIEWEG 46/C 6541 CX NIJMEGEN	IHC DREDGERS BV - TSHD5500 DCI-3 "11L" MAIN DISTRIBUTION BOARD 3X230V DISTRIBUTION GROUPS SECTION 2	Yard no : CO1266
M	5-12-2013	IEN	REV	1	PANEL IP23					Project : 23000143
STAT	AS BUILT									Class : LROS/IRS
	05-12-2013	IEN	CHK							Page : 11L -46


01	02	03	04	05	06	07	08	09	10	11	12	13	14
46.13 / L1 46.13 / L2 46.13 / L3 3x230V / 50Hz 063 064 066 081 F1 C16 082 F1 C10 083 F1 C10 084 F1 B16 1 2 3 4 11.00811 52CPPSB-/11.04 11.00821 10P-/171.09 11.00831 11SC2-/10.13 084 X1 SOCKETS 084 X2 SOCKET OUTSIDE AFT OUTSIDE MAIN DECK AFT COAMING DECK													
4													

No part of this work may be copied, stored or published without prior written permission of Alewijnse Marine Systems.

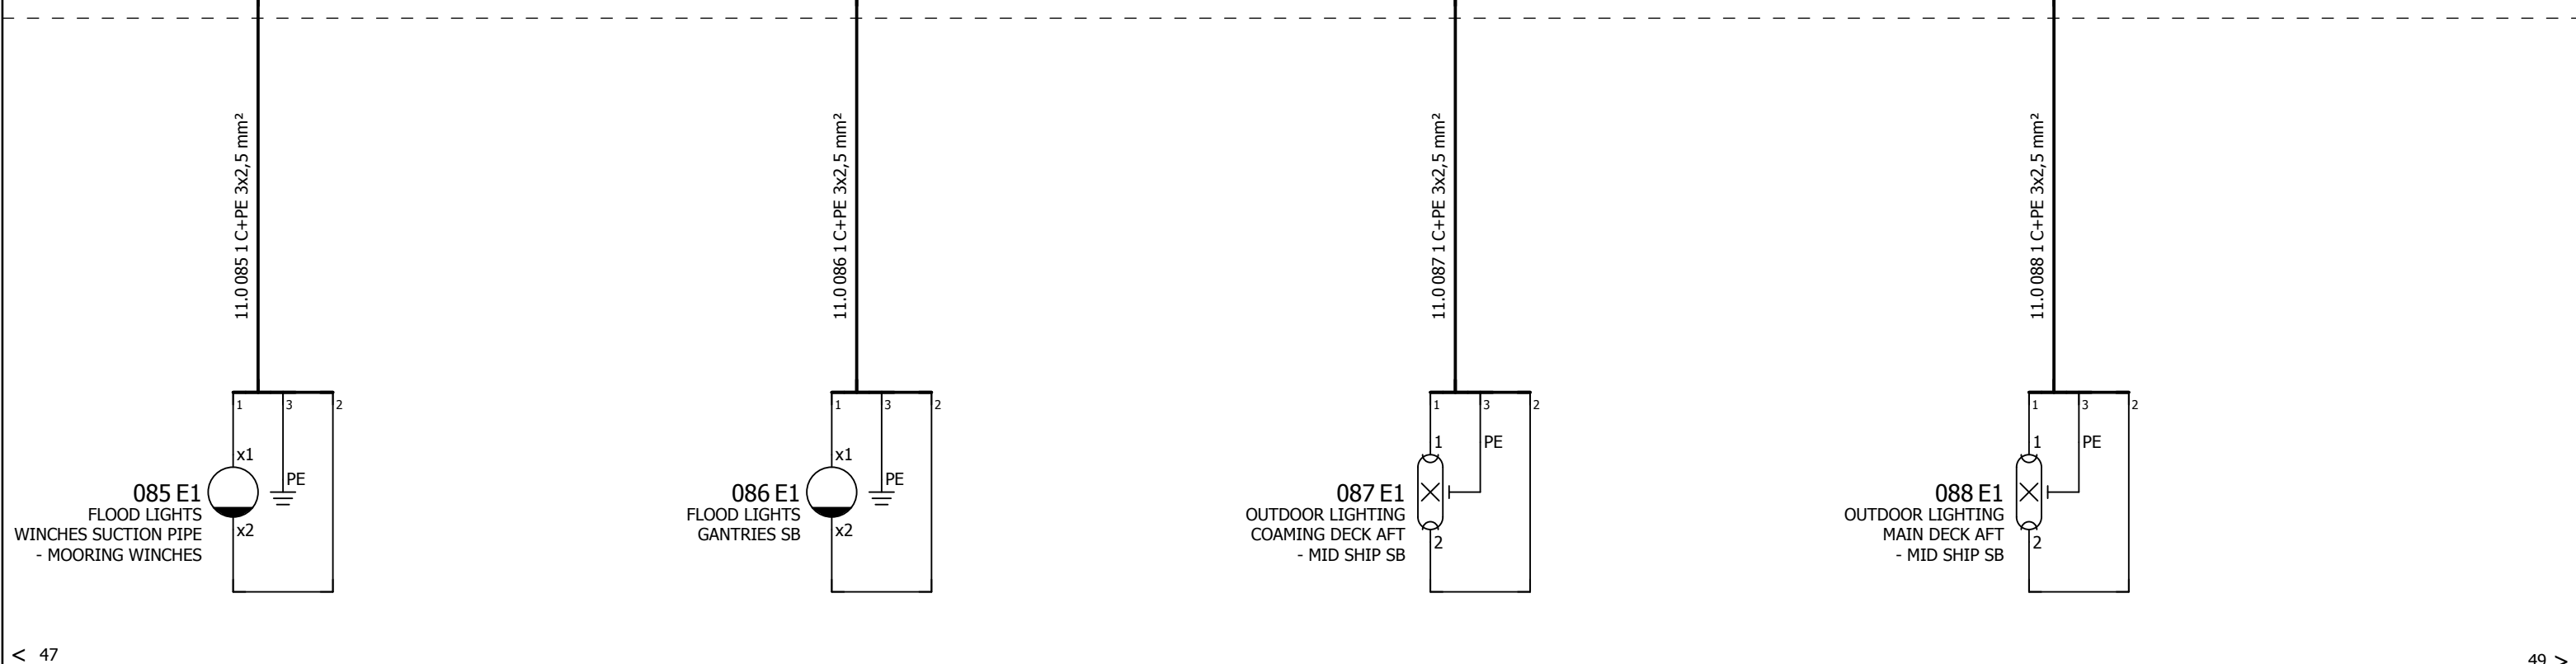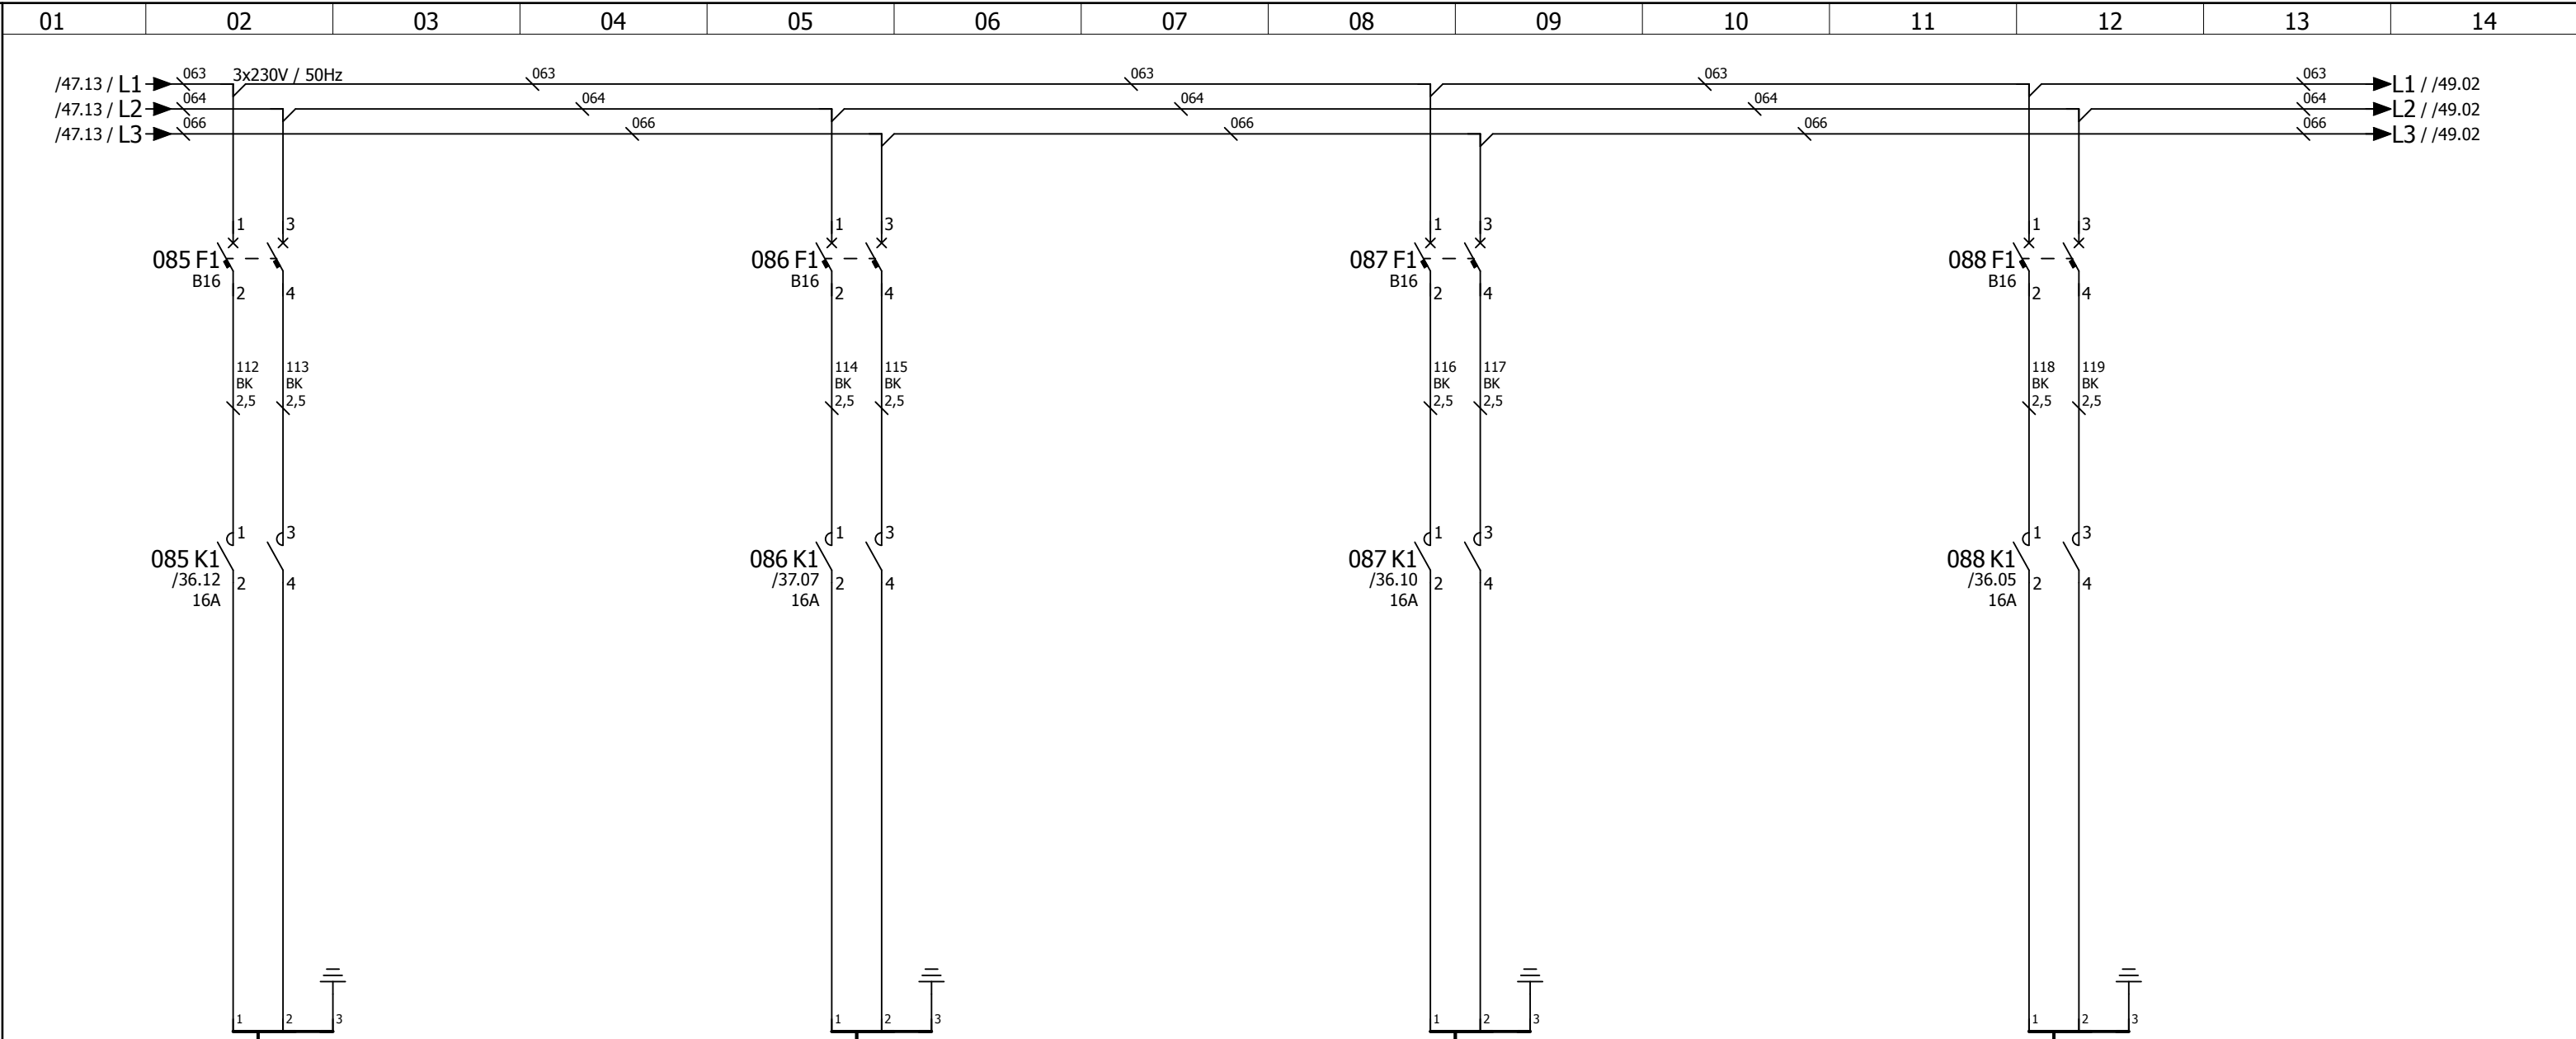


STAT	D	24-1-2011	PVR		* NO DELIVERY ALEWIJNSE			IHC DREDGERS BV - TSHD5500 DCI-3 "11L" MAIN DISTRIBUTION BOARD 3X230V DISTRIBUTION GROUPS SECTION 2	Yard no : CO1266
	M	5-12-2013	IEN	REV					1
		AS BUILT				PANEL IP23			Class : LROS/IRS
		05-12-2013	IEN	CHK					Page : 11L -48

No part of this work may be copied, stored or published without prior written permission of Alewijnse Marine Systems.

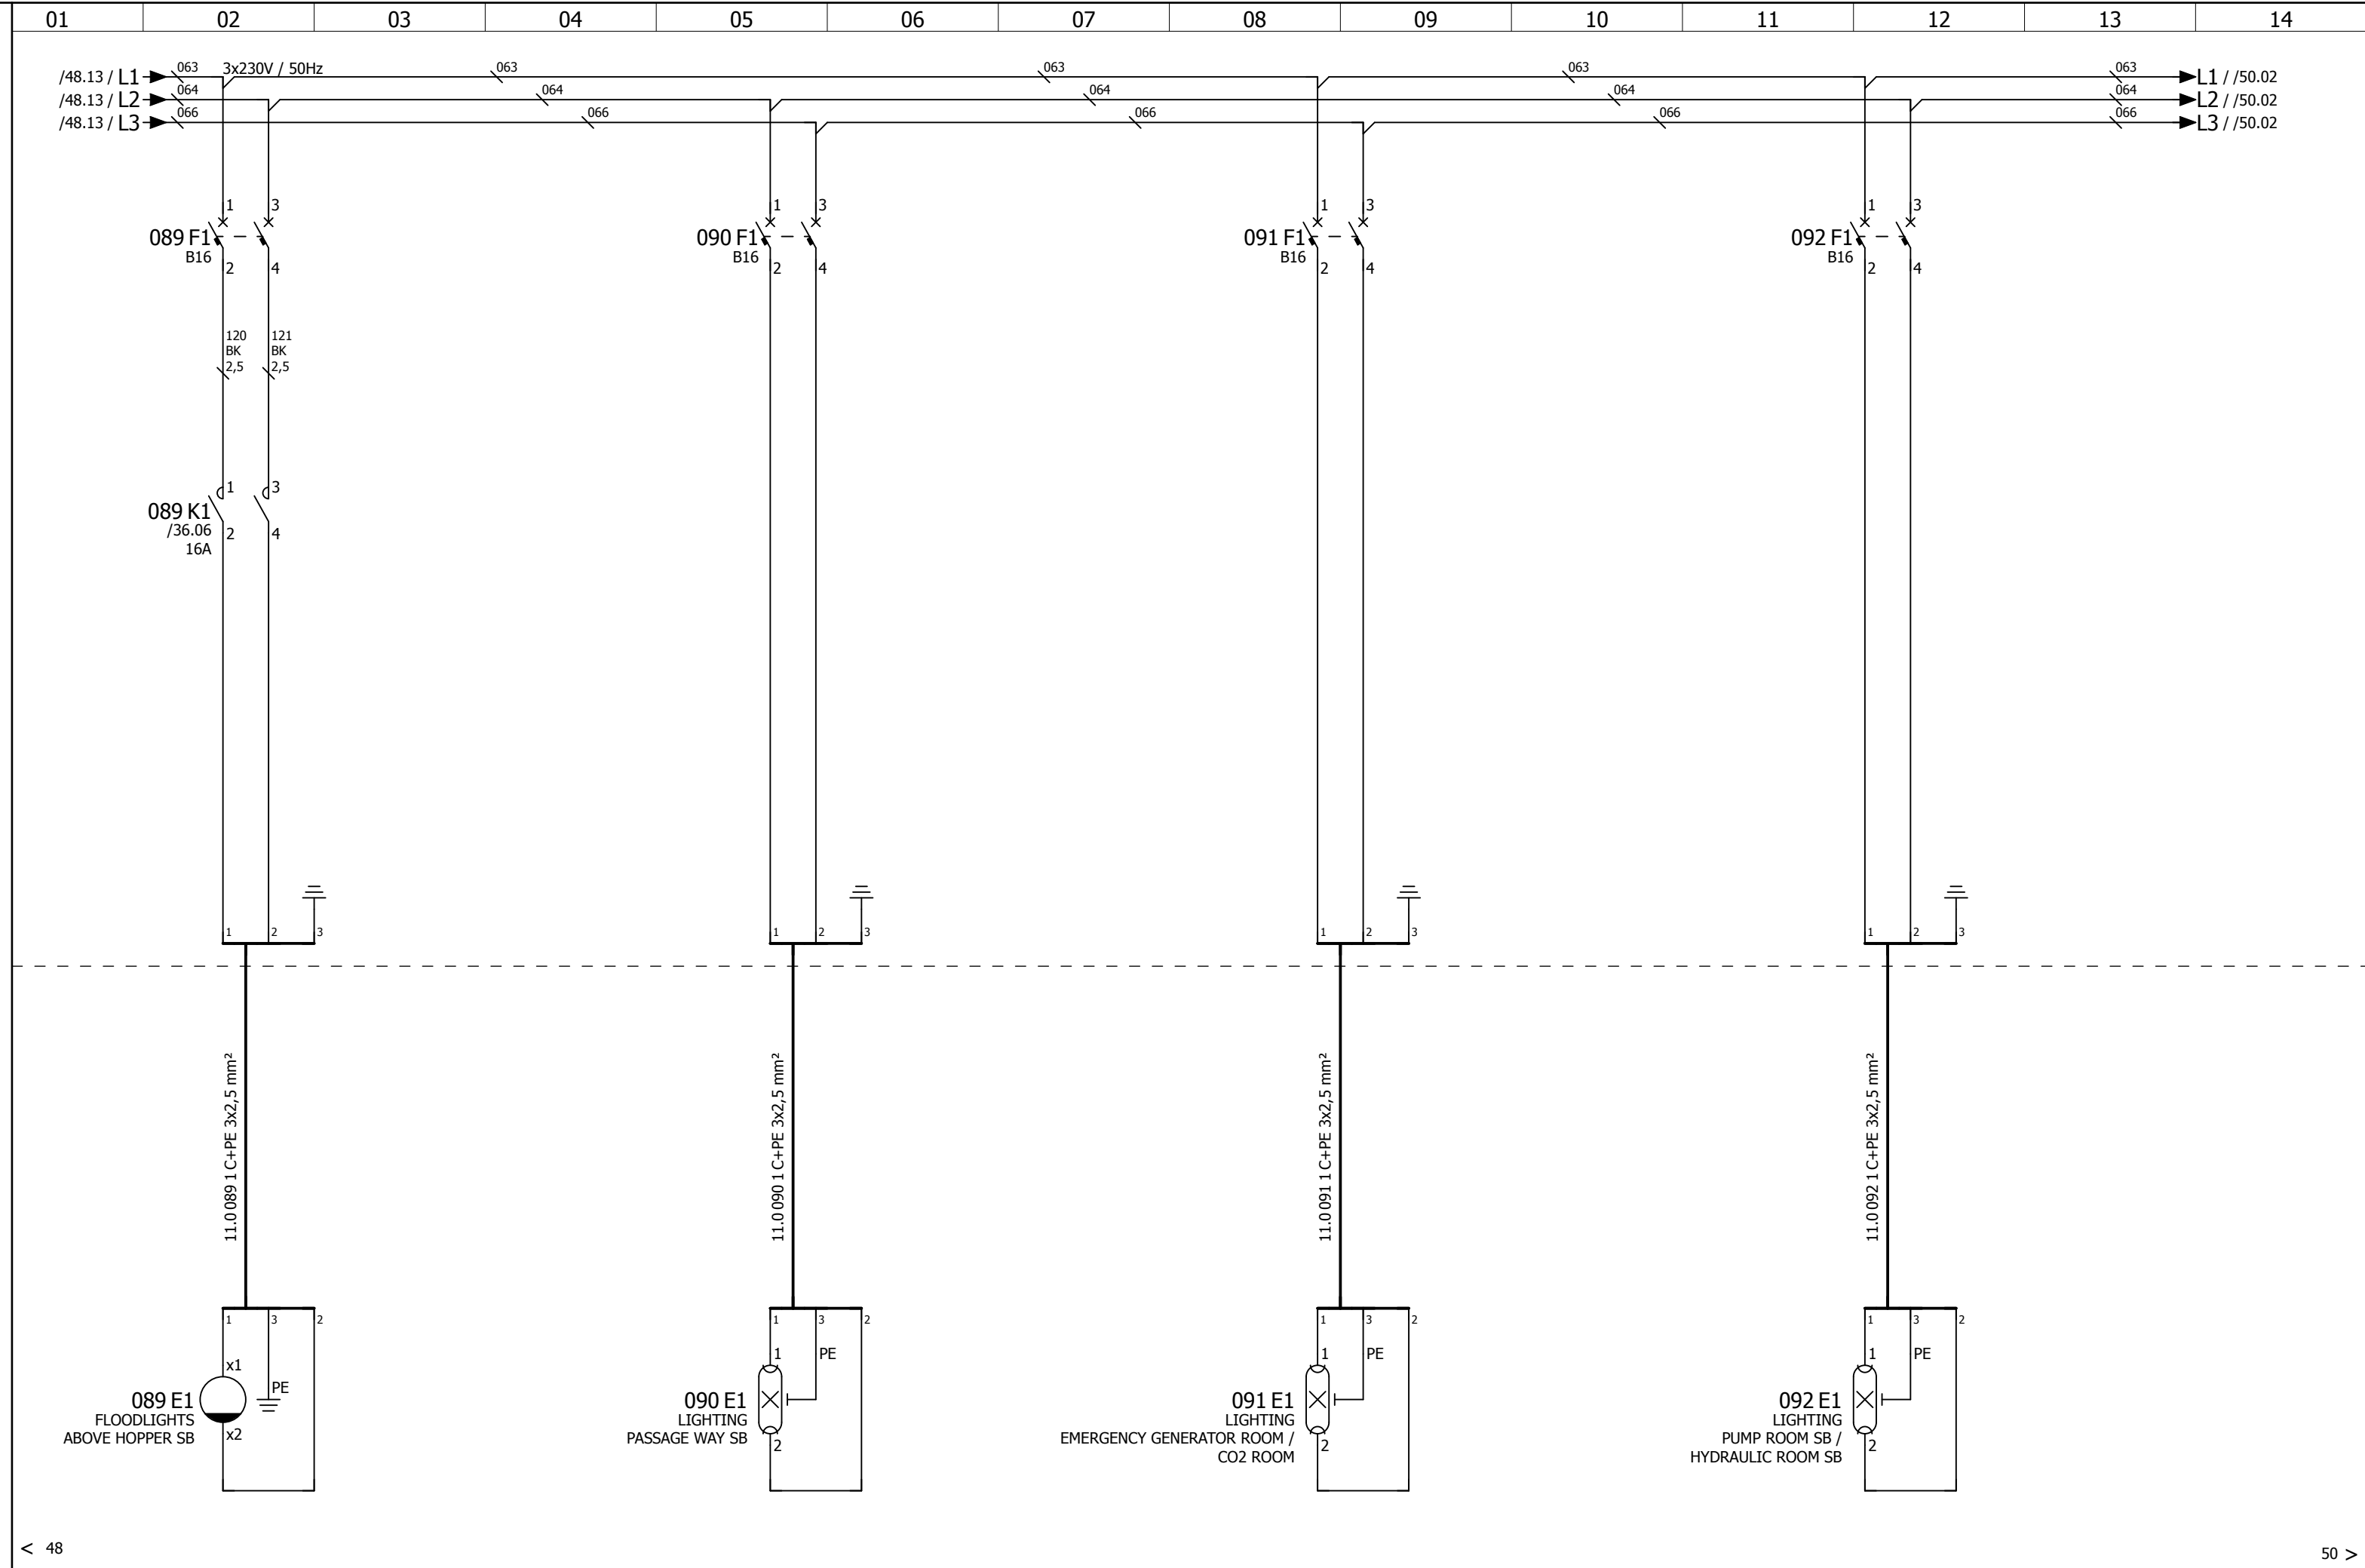


D	24-1-2011	PVR		* NO DELIVERY ALEWIJNSE			ALEWIJNSE MARINE B.V. ENERGIEWEG 46/C 6541 CX NIJMEGEN	IHC DREDGERS BV - TSHD5500 DCI-3 "11L" MAIN DISTRIBUTION BOARD 3X230V DISTRIBUTION GROUPS SECTION 2	Yard no : CO1266	
M	5-12-2013	IEN	REV	1					Project : 23000143	
STAT	AS BUILT				PANEL IP23				Class : LROS/IRS	
	05-12-2013	IEN	CHK						Page : 11L -49	

No part of this work may be copied, stored or published without prior written permission of Alewijnse Marine Systems.

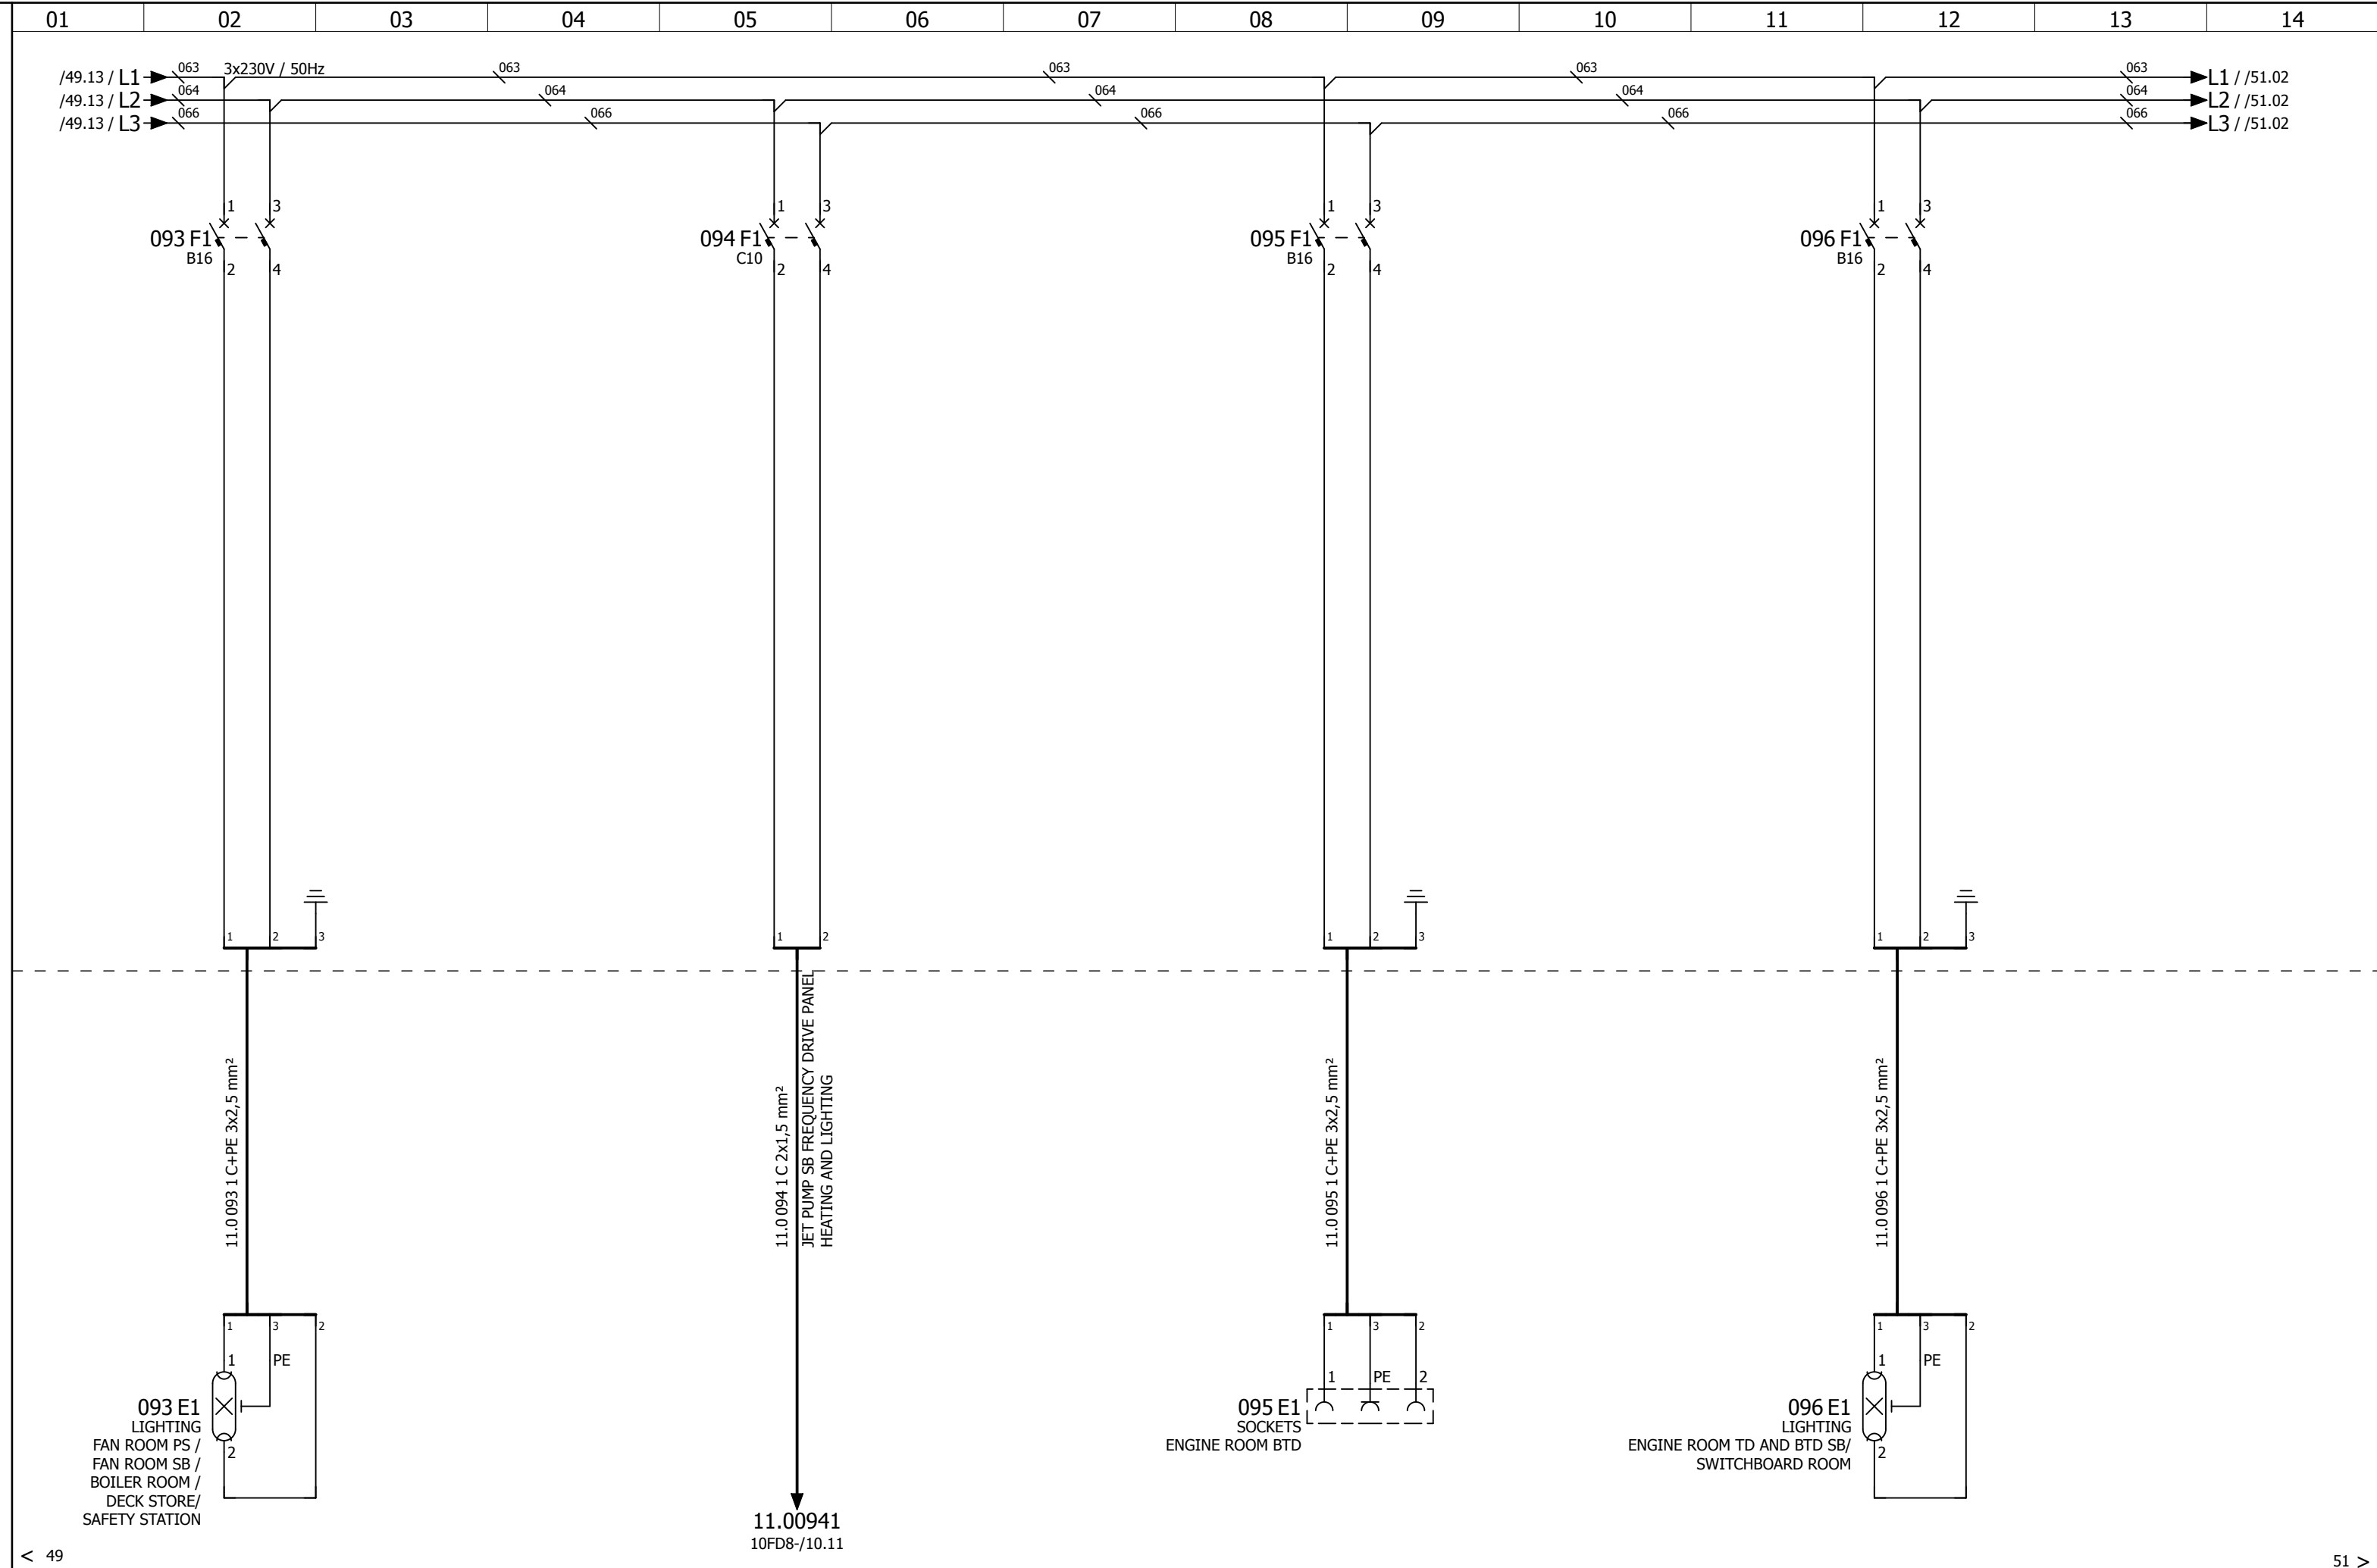

STAT	D	24-1-2011	PVR		* NO DELIVERY ALEWIJNSE			ALEWIJNSE MARINE B.V. ENERGIEWEG 46/C 6541 CX NIJMEGEN	IHC DREDGERS BV - TSHD5500 DCI-3 "11L" MAIN DISTRIBUTION BOARD 3X230V DISTRIBUTION GROUPS SECTION 2	Yard no : CO1266	
	M	5-12-2013	IEN	REV						1	Project : 23000143
	AS BUILT				PANEL IP23	Class : LROS/IRS					
		05-12-2013	IEN	CHK			Page : 11L -50				

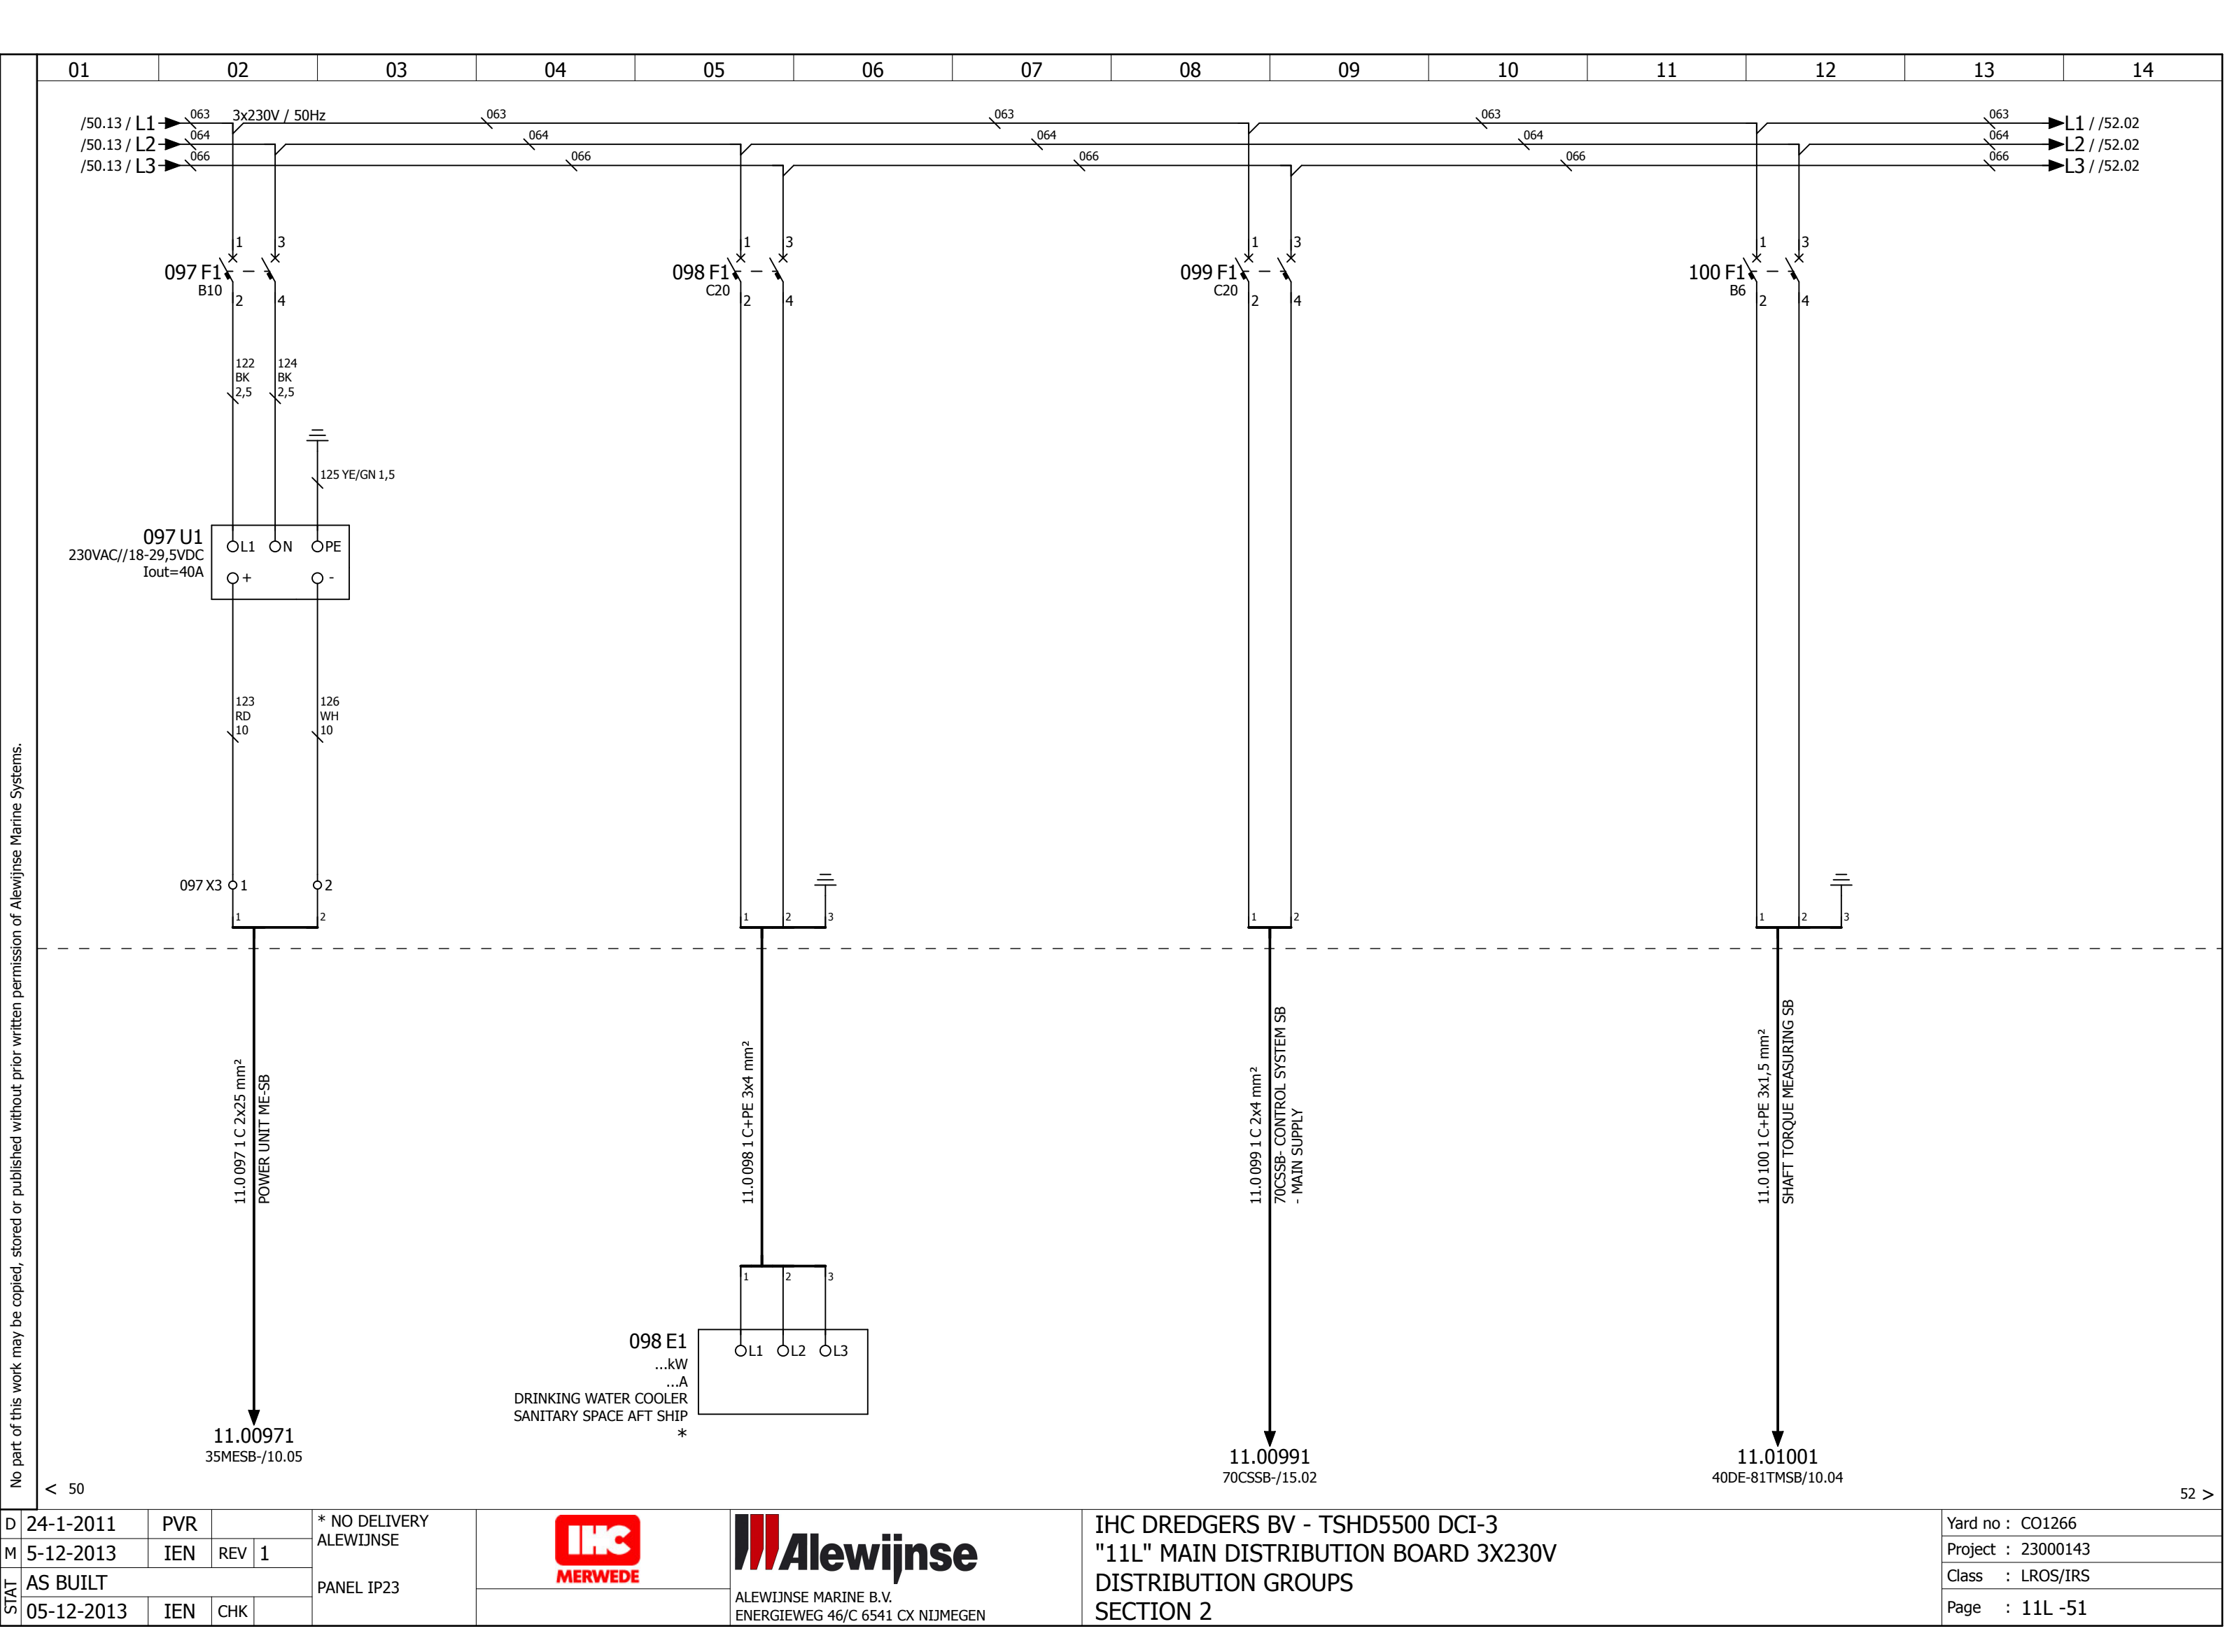

D	24-1-2011	PVR		
M	5-12-2013	IEN	REV	1
STAT	AS BUILT			
	05-12-2013	IEN	CHK	


* NO DELIVERY ALEWIJNSE	
PANEL IP23	




ALEWIJNSE MARINE B.V.
ENERGIEWEG 46/C 6541 CX NIJMEGEN

IHC DREDGERS BV - TSHD5500 DCI-3
"11L" MAIN DISTRIBUTION BOARD 3X230V
DISTRIBUTION GROUPS
SECTION 2

Yard no :	CO1266
Project :	23000143
Class :	LROS/IRS
Page :	11L -51

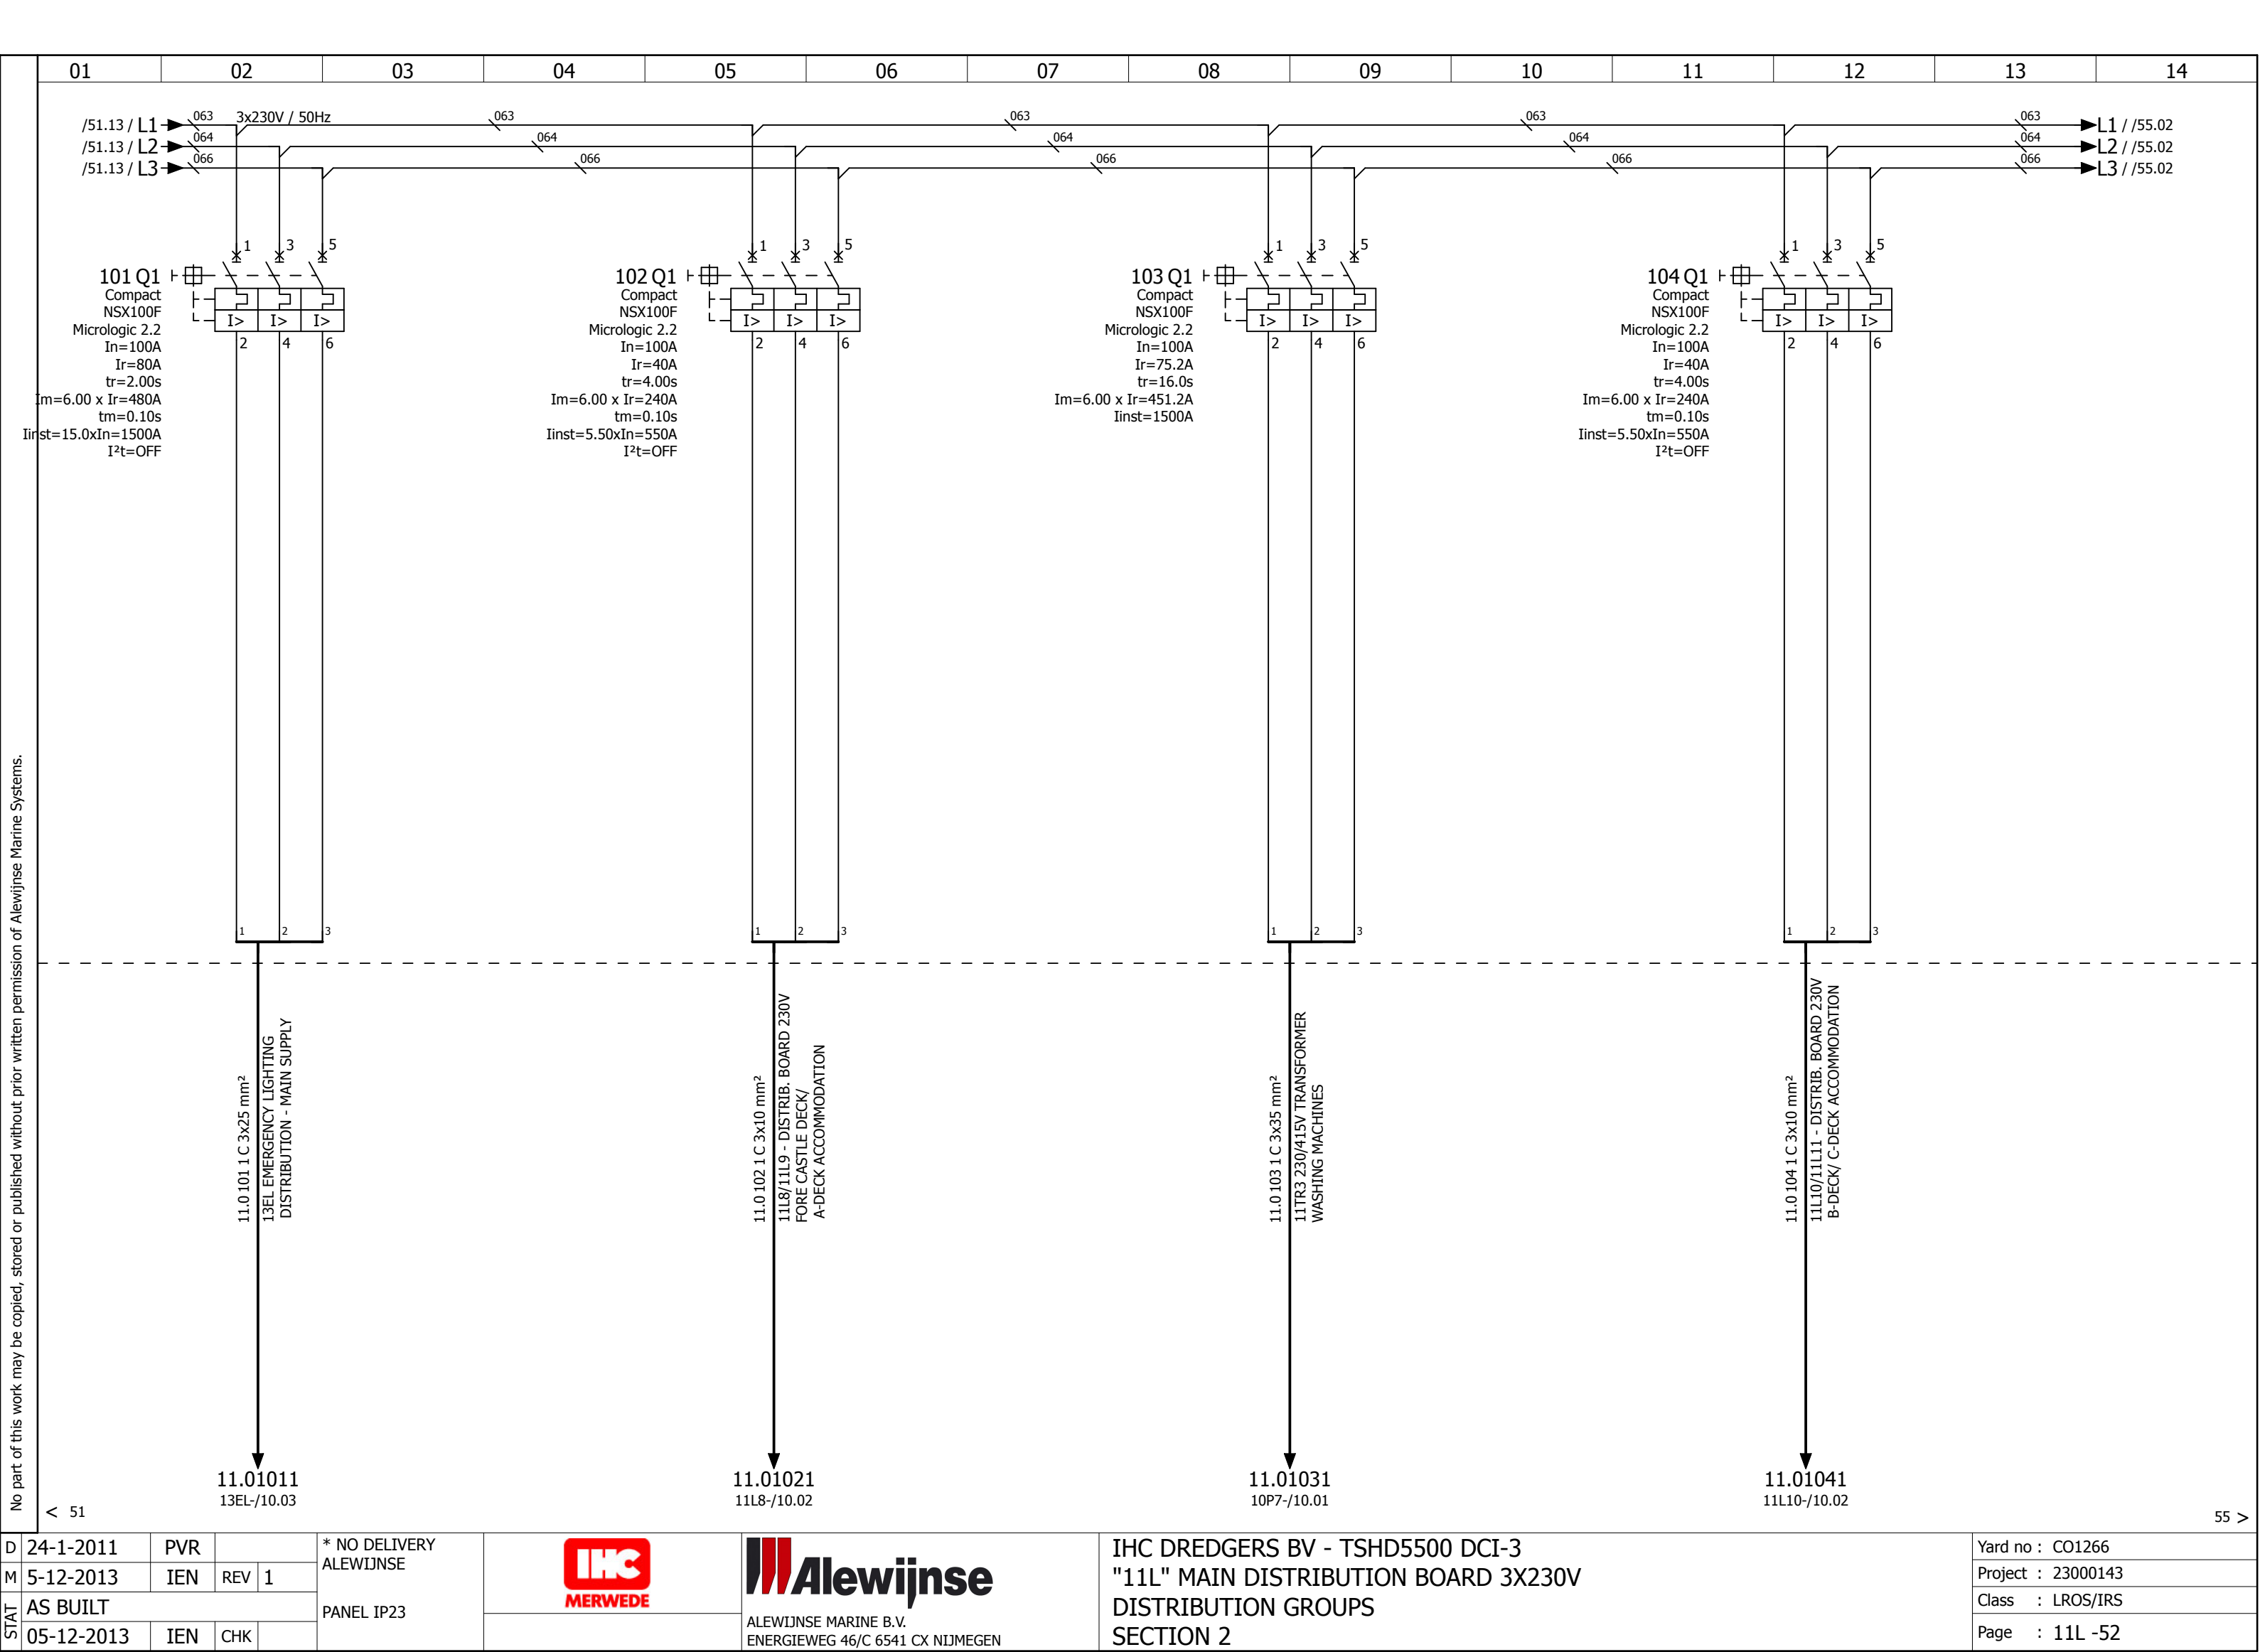


No part of this work may be copied, stored or published without prior written permission of Alewijnse Marine Systems.

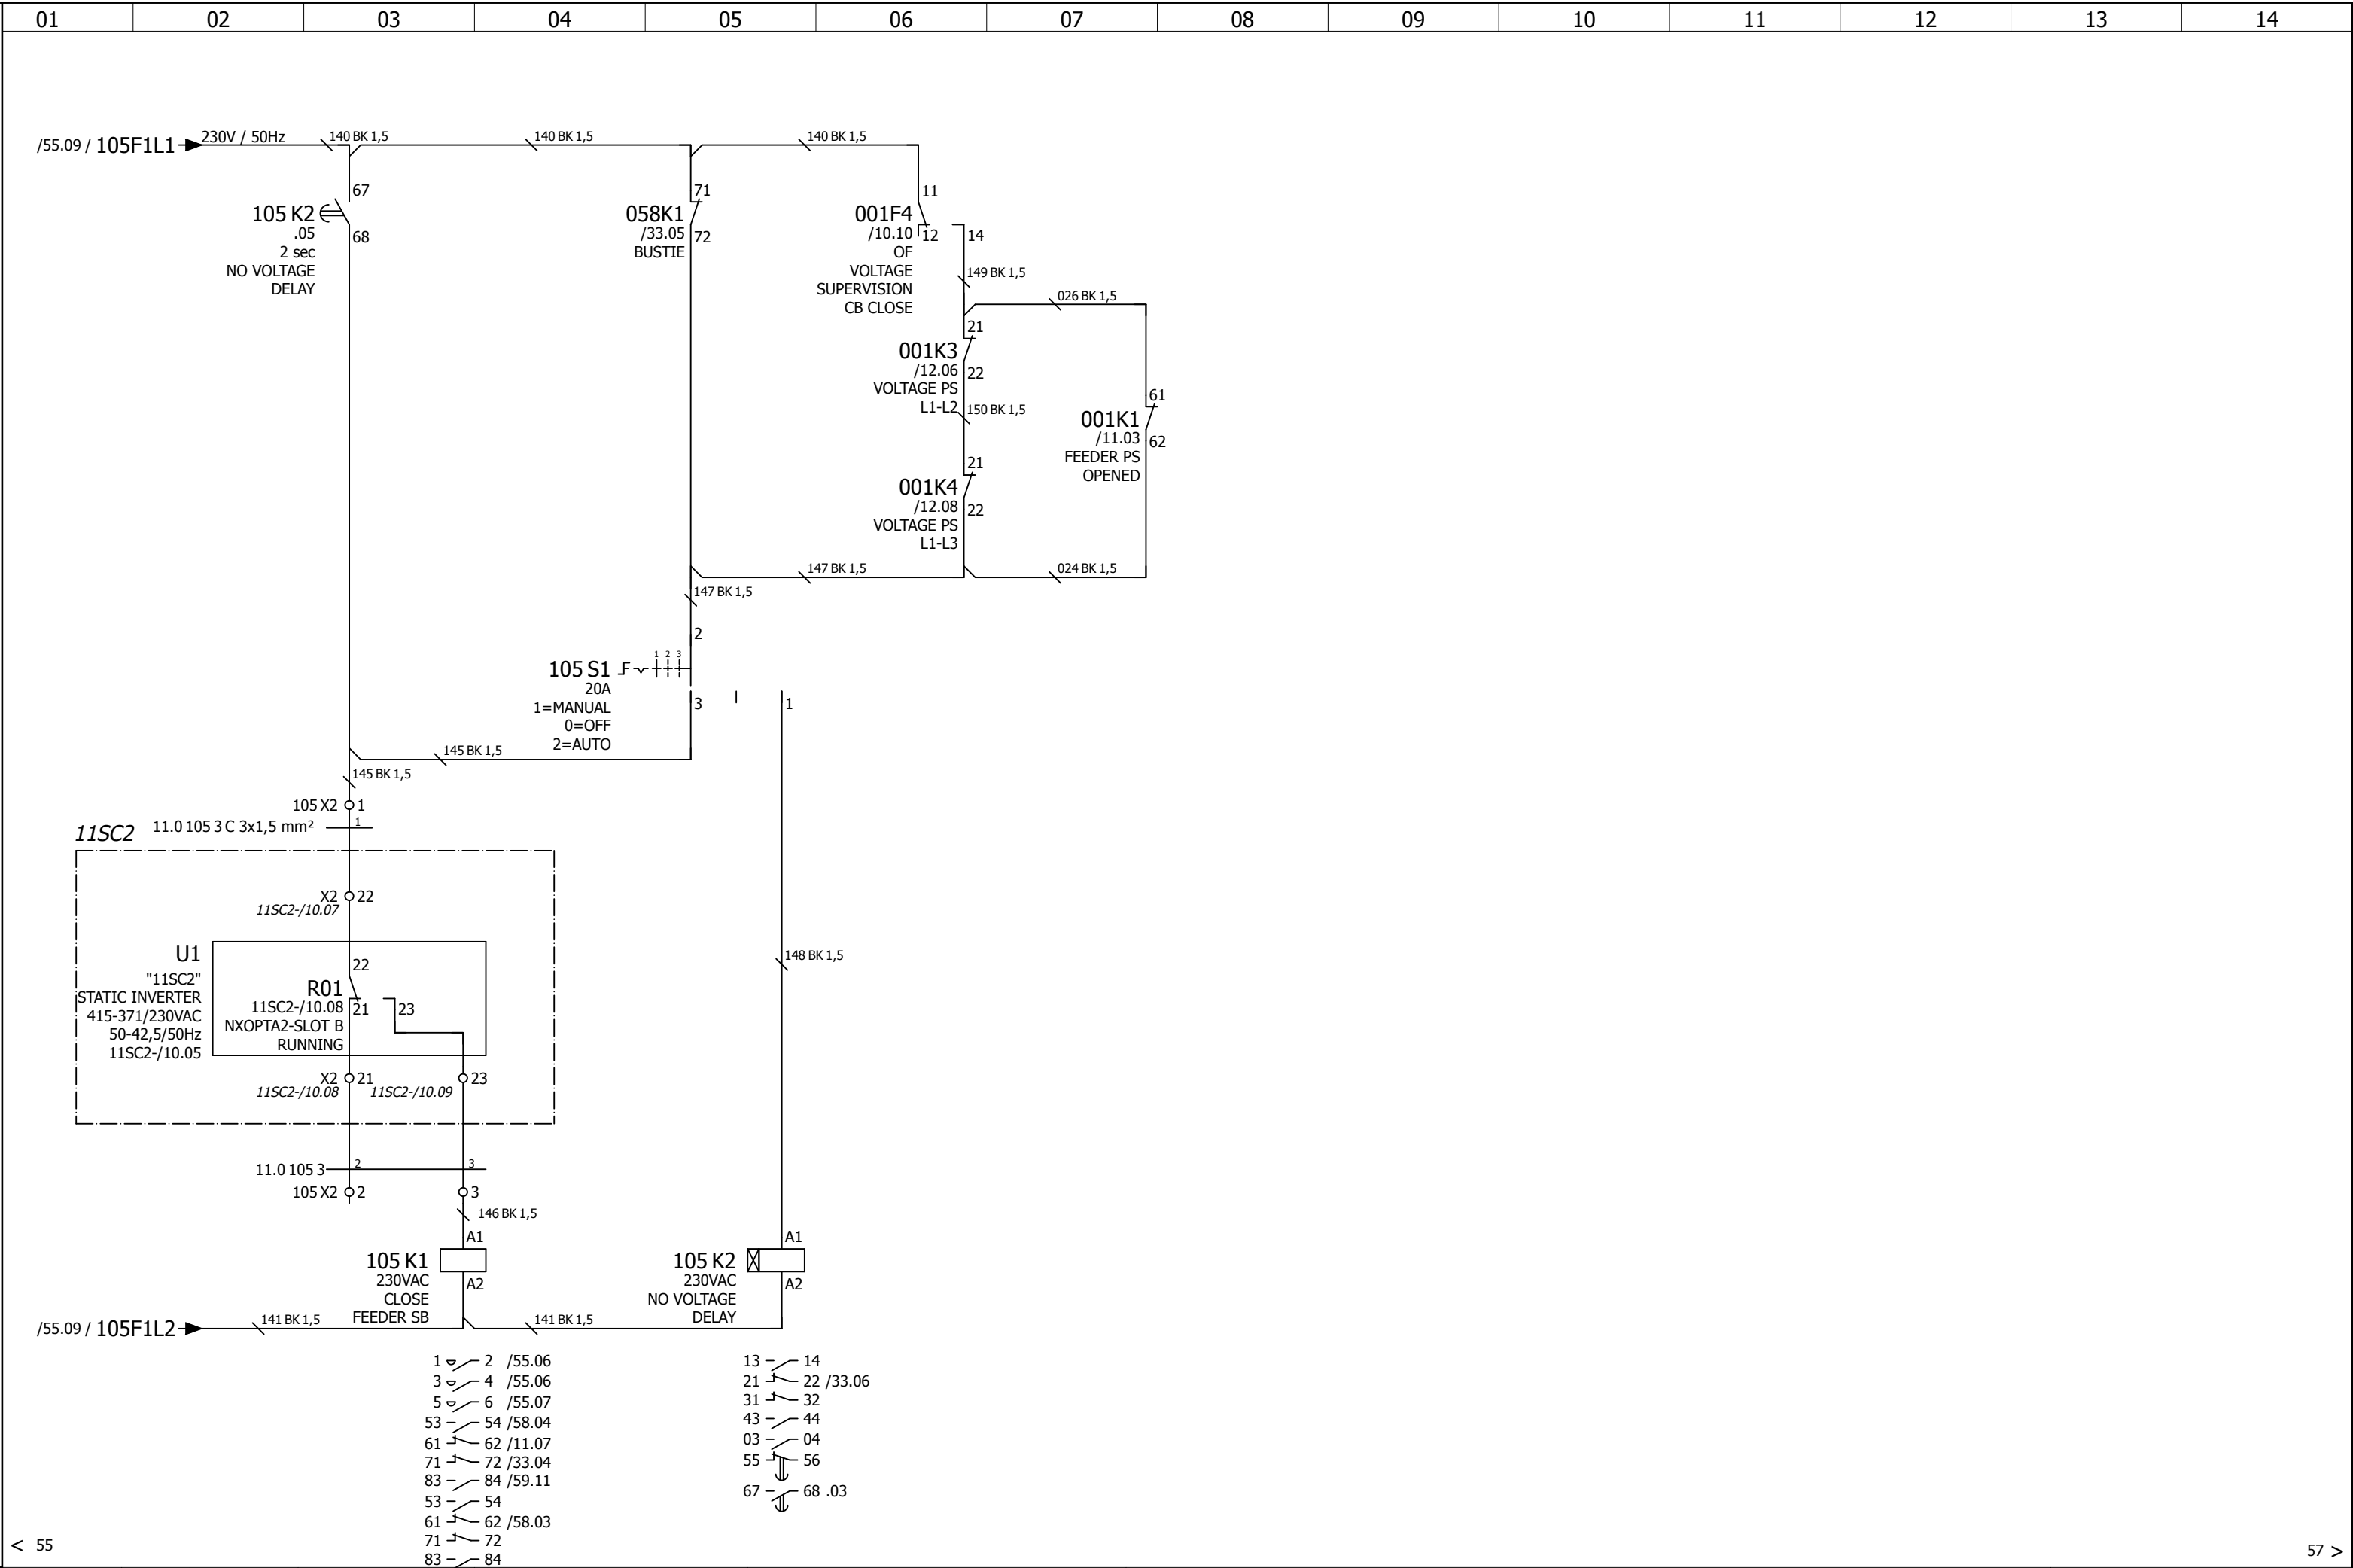

D	24-1-2011	PVR			* NO DELIVERY ALEWIJNSE			ALEWIJNSE MARINE B.V. ENERGIEWEG 46/C 6541 CX NIJMEGEN	IHC DREDGERS BV - TSHD5500 DCI-3 "11L" MAIN DISTRIBUTION BOARD 3X230V INCOMING FEEDER SB CONTROL CIRCUIT SECTION 1	Yard no : CO1266
M	5-12-2013	IEN	REV	1	PANEL IP23					Project : 23000143
STAT	AS BUILT									Class : LROS/IRS
	05-12-2013	IEN	CHK							Page : 11L -56


No part of this work may be copied, stored or published without prior written permission of Alewijnse Marine Systems.

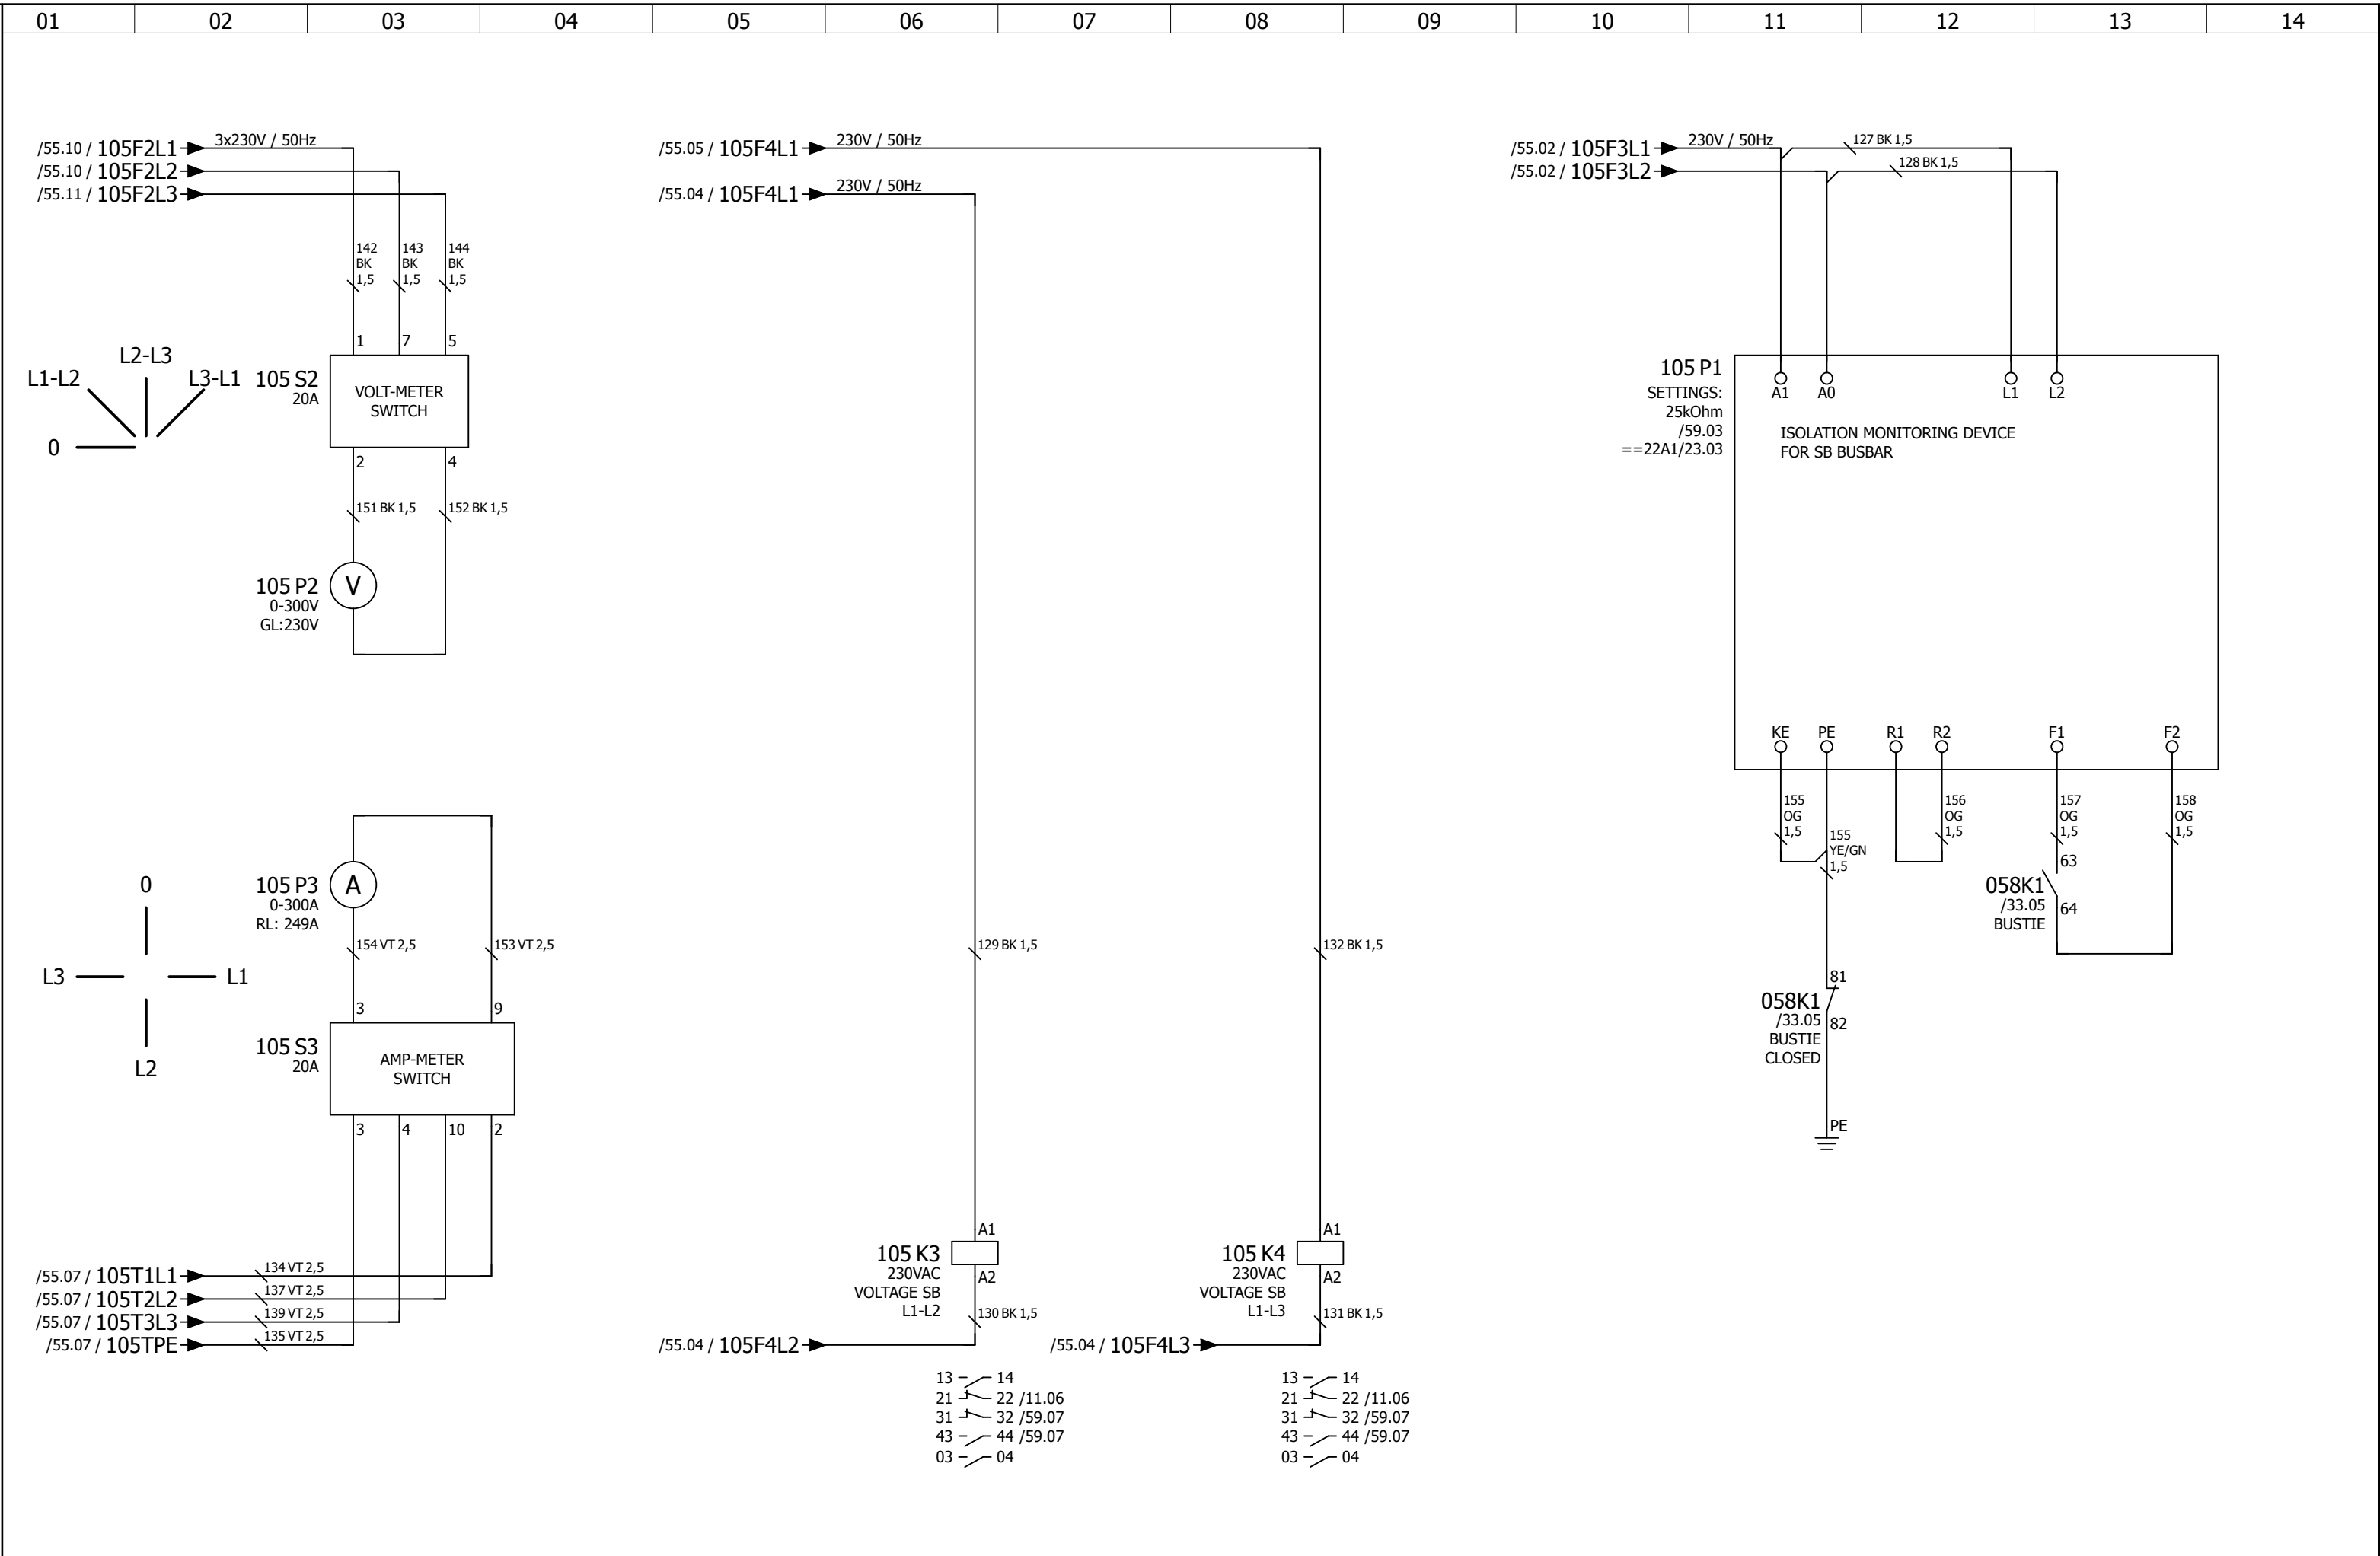

D	24-1-2011	PVR			* NO DELIVERY ALEWIJNSE			ALEWIJNSE MARINE B.V. ENERGIEWEG 46/C 6541 CX NIJMEGEN	IHC DREDGERS BV - TSHD5500 DCI-3 "11L" MAIN DISTRIBUTION BOARD 3X230V INCOMING FEEDER SB MEASURING AND PROTECTION SECTION 1	Yard no : CO1266	
M	5-12-2013	IEN	REV	1						Project : 23000143	
STAT	AS BUILT				PANEL IP23					Class : LROS/IRS	
	05-12-2013	IEN	CHK							Page : 11L -57	



No part of this work may be copied, stored or published without prior written permission of Alewijnse Marine Systems.

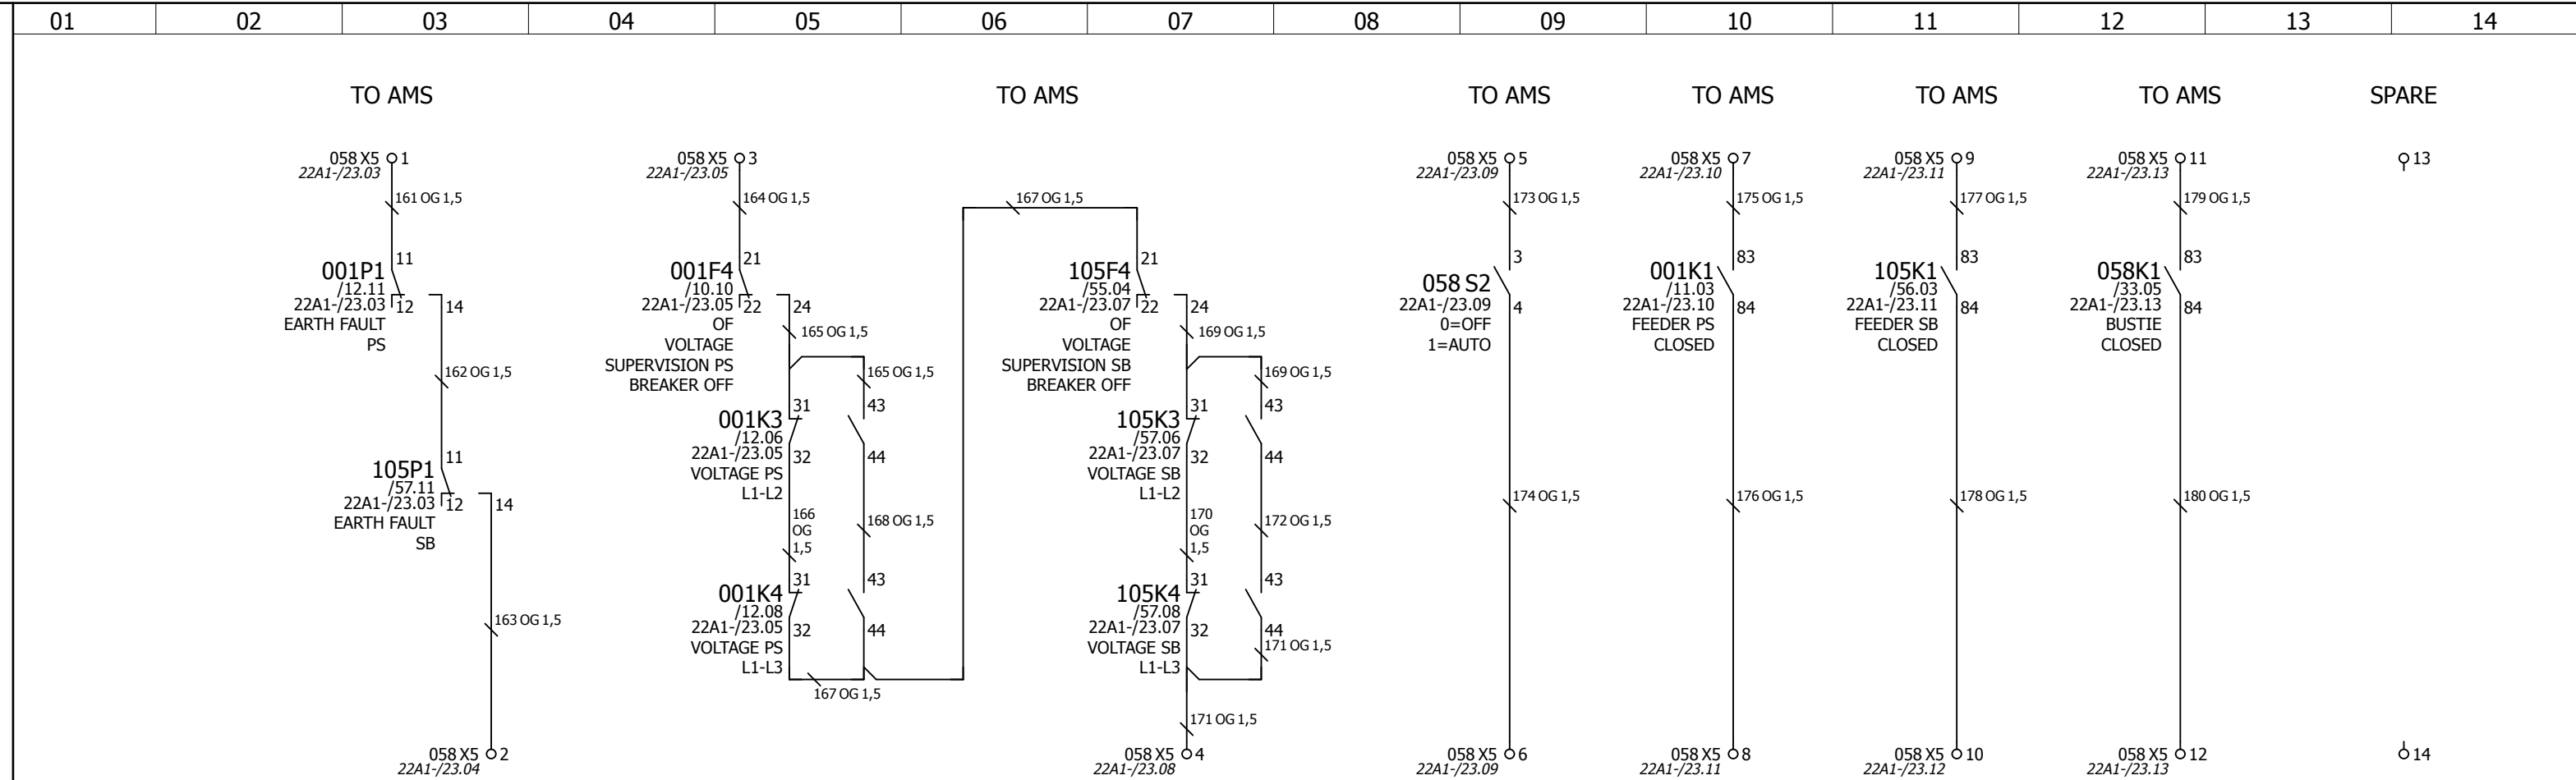

LAST WIRE NUMBER USED FOR 11L PANEL IS: 183

No part of this work may be copied, stored or published without prior written permission of Alewijnse Marine Systems.

No part of this work may be copied, stored or published without prior written permission of Alewijnse Marine Systems.

01		02		03		04		05		06		07		08		09		10		11		12		13		14						
PARTS LIST11L																																
DEVICE			QTY	DESCRIPTION										NAV. NUMBER		MANUFACTURER			PART NUMBER			TYPE NUMBER			PAGE							
-015F1.			1	CIRC. BREAKER 2P 10A C 10kA/230V Im=10xIn										40964		Schneider Electric BV			MERL.C60N-2P-C10			24268 // C60 N			-17/08							
-016F1.			1	CIRC. BREAKER 2P 16A C 10kA/230V Im=10xIn										40965		Schneider Electric BV			MERL.C60N-2P-C16			24270 // C60 N			-17/12							
-017F1.			1	CIRC. BREAKER 2P 16A C 10kA/230V Im=10xIn										40965		Schneider Electric BV			MERL.C60N-2P-C16			24270 // C60 N			-18/02							
-018F1.			1	CIRC. BREAKER 2P 16A B 10kA/230V Im=5xIn										40806		Schneider Electric BV			MERL.C60N-2P-B16			24077 // C60 N			-18/05							
-019F1.			1	CIRC. BREAKER 2P 06A B 10kA/230V Im=5xIn										40804		Schneider Electric BV			MERL.C60N-2P-B6			24075 // C60 N			-18/08							
-020F1.			1	CIRC. BREAKER 2P 16A B 10kA/230V Im=5xIn										40806		Schneider Electric BV			MERL.C60N-2P-B16			24077 // C60 N			-18/12							
-021F1.			1	CIRC. BREAKER 2P 16A B 10kA/230V Im=5xIn										40806		Schneider Electric BV			MERL.C60N-2P-B16			24077 // C60 N			-19/02							
-022F1.			1	CIRC. BREAKER 2P 16A C 10kA/230V Im=10xIn										40965		Schneider Electric BV			MERL.C60N-2P-C16			24270 // C60 N			-19/05							
-023F1.			1	CIRC. BREAKER 2P 16A C 10kA/230V Im=10xIn										40965		Schneider Electric BV			MERL.C60N-2P-C16			24270 // C60 N			-19/08							
-024F1.			1	CIRC. BREAKER 2P 16A C 10kA/230V Im=10xIn										40965		Schneider Electric BV			MERL.C60N-2P-C16			24270 // C60 N			-19/12							
-025F1.			1	CIRC. BREAKER 2P 16A B 10kA/230V Im=5xIn										40806		Schneider Electric BV			MERL.C60N-2P-B16			24077 // C60 N			-20/02							
-026F1.			1	CIRC. BREAKER 2P 16A B 10kA/230V Im=5xIn										40806		Schneider Electric BV			MERL.C60N-2P-B16			24077 // C60 N			-20/05							
-027F1.			1	CIRC. BREAKER 2P 16A B 10kA/230V Im=5xIn										40806		Schneider Electric BV			MERL.C60N-2P-B16			24077 // C60 N			-20/08							
-028F1.			1	CIRC. BREAKER 2P 16A B 10kA/230V Im=5xIn										40806		Schneider Electric BV			MERL.C60N-2P-B16			24077 // C60 N			-20/12							
-028K1.			1	CONTACTOR 2P 2NO+0NC 16A 230VAC										76737		Schneider Electric BV			MERL.CT20-16A/230VAC			15957			-36/07							
-029F1.			1	CIRC. BREAKER 2P 16A B 10kA/230V Im=5xIn										40806		Schneider Electric BV			MERL.C60N-2P-B16			24077 // C60 N			-21/02							
-030F1.			1	CIRC. BREAKER 2P 16A B 10kA/230V Im=5xIn										40806		Schneider Electric BV			MERL.C60N-2P-B16			24077 // C60 N			-21/05							
-031F1.			1	CIRC. BREAKER 2P 16A B 10kA/230V Im=5xIn										40806		Schneider Electric BV			MERL.C60N-2P-B16			24077 // C60 N			-21/08							
-032F1.			1	CIRC. BREAKER 2P 16A B 10kA/230V Im=5xIn										40806		Schneider Electric BV			MERL.C60N-2P-B16			24077 // C60 N			-21/12							
-033F1.			1	CIRC. BREAKER 2P 16A B 10kA/230V Im=5xIn										40806		Schneider Electric BV			MERL.C60N-2P-B16			24077 // C60 N			-22/02							
-033K1.			1	CONTACTOR 2P 2NO+0NC 16A 230VAC										76737		Schneider Electric BV			MERL.CT20-16A/230VAC			15957			-36/03							
-034F1.			1	CIRC. BREAKER 2P 16A B 10kA/230V Im=5xIn										40806		Schneider Electric BV			MERL.C60N-2P-B16			24077 // C60 N			-22/05							
-034K1.			1	CONTACTOR 2P 2NO+0NC 16A 230VAC										76737		Schneider Electric BV			MERL.CT20-16A/230VAC			15957			-36/09							
-035F1.			1	CIRC. BREAKER 2P 16A B 10kA/230V Im=5xIn										40806		Schneider Electric BV			MERL.C60N-2P-B16			24077 // C60 N			-22/08							
-035K1.			1	CONTACTOR 2P 2NO+0NC 16A 230VAC										76737		Schneider Electric BV			MERL.CT20-16A/230VAC			15957			-37/03							
-036F1.			1	CIRC. BREAKER 2P 16A B 10kA/230V Im=5xIn										40806		Schneider Electric BV			MERL.C60N-2P-B16			24077 // C60 N			-22/12							
-036K1.			1	CONTACTOR 2P 2NO+0NC 16A 230VAC										76737		Schneider Electric BV			MERL.CT20-16A/230VAC			15957			-37/06							
-037F1.			1	CIRC. BREAKER 2P 16A B 10kA/230V Im=5xIn										40806		Schneider Electric BV			MERL.C60N-2P-B16			24077 // C60 N			-23/02							
-037K1.			1	CONTACTOR 2P 2NO+0NC 16A 230VAC										76737		Schneider Electric BV			MERL.CT20-16A/230VAC			15957			-37/10							
-038F1.			1	CIRC. BREAKER 2P 16A B 10kA/230V Im=5xIn										40806		Schneider Electric BV			MERL.C60N-2P-B16			24077 // C60 N			-23/05							
-039F1.			1	CIRC. BREAKER 2P 16A B 10kA/230V Im=5xIn										40806		Schneider Electric BV			MERL.C60N-2P-B16			24077 // C60 N			-23/08							
-040F1.			1	CIRC. BREAKER 2P 10A B 10kA/230V Im=5xIn										40805		Schneider Electric BV			MERL.C60N-2P-B10			24076 // C60 N			-23/12							
-040U1.			1	POWER SUPPLY 230VAC//18-29,5VDC-40A+1NO+SFB										38413		Phoenix Contact			PHOE.QUINT/1AC/24DC/40			QUINT/1AC/24DC/40			-23/11							
-040X3.			2	TERMINAL 16,00mm2 UT16 Screw Grey NS35/7,5/15										89303		Phoenix Contact			PHOE.UT16			UT16			-23/11							
-040X3.			1	END PART. for UT16 D-UT 16										89803		Phoenix Contact			PHOE.D-UT16			D-UT16			-23/11							
-040X3.			2	END-BRACKET FAST FIT CLIPFIX 35-5										89820		Phoenix Contact			PHOE.CLIPFIX35-5			CLIPFIX35-5			-23/11							
-041F1.			1	CIRC. BREAKER 2P 25A D 10kA/230V Im=14xIn										42230		Schneider Electric BV			MERL.C60N-2P-D25			24589 // C60 N			-24/02							
-042F1.			1	CIRC. BREAKER 2P 20A C 10kA/230V Im=10xIn										40966		Schneider Electric BV			MERL.C60N-2P-C20			24271 // C60 N			-24/05							
-043F1.			1	CIRC. BREAKER 2P 16A C 10kA/230V Im=10xIn										40965		Schneider Electric BV			MERL.C60N-2P-C16			24270 // C60 N			-24/08							
-044F1.			1	CIRC. BREAKER 2P 06A B 10kA/230V Im=5xIn										40804		Schneider Electric BV			MERL.C60N-2P-B6			24075 // C60 N			-24/12							
< 80008000.b >																																
D	24-1-2011		PVR								IHC DREDGERS BV - TSHD5500 DCI-3 "11L" MAIN DISTRIBUTION BOARD 3X230V PARTS LIST																Yard no : CO1266					
M	5-12-2013		IEN		REV 1																						Project : 23000143					
STAT	AS BUILT																										Class : LROS/IRS					
	05-12-2013		IEN		CHK																						Page : 11L -8000.a					

No part of this work may be copied, stored or published without prior written permission of Alewijnse Marine Systems.

01	02	03	04	05	06	07	08	09	10	11	12	13	14
PARTS LIST 11L													
DEVICE	QTY	DESCRIPTION				NAV. NUMBER	MANUFACTURER	PART NUMBER		TYPE NUMBER		PAGE	
-045F1.	1	CIRC. BREAKER 2P 16A B 10kA/230V Im=5xIn				40806	Schneider Electric BV	MERL.C60N-2P-B16		24077 // C60 N		-25/02	
-046F1.	1	CIRC. BREAKER 2P 16A C 10kA/230V Im=10xIn				40965	Schneider Electric BV	MERL.C60N-2P-C16		24270 // C60 N		-25/05	
-047F1.	1	CIRC. BREAKER 2P 16A C 10kA/230V Im=10xIn				40965	Schneider Electric BV	MERL.C60N-2P-C16		24270 // C60 N		-25/08	
-048F1.	1	CIRC. BREAKER 2P 16A C 10kA/230V Im=10xIn				40965	Schneider Electric BV	MERL.C60N-2P-C16		24270 // C60 N		-25/12	
-049F1.	1	CIRC. BREAKER 2P 10A C 10kA/230V Im=10xIn				40964	Schneider Electric BV	MERL.C60N-2P-C10		24268 // C60 N		-26/02	
-050F1.	1	CIRC. BREAKER 2P 20A B 10kA/230V Im=5xIn				40807	Schneider Electric BV	MERL.C60N-2P-B20		24078 // C60 N		-26/05	
-051F1.	1	CIRC. BREAKER 2P 16A C 10kA/230V Im=10xIn				40965	Schneider Electric BV	MERL.C60N-2P-C16		24270 // C60 N		-26/08	
-052F1.	1	CIRC. BREAKER 2P 10A C 10kA/230V Im=10xIn				40964	Schneider Electric BV	MERL.C60N-2P-C10		24268 // C60 N		-26/12	
-053F1.	1	CIRC. BREAKER 2P 10A C 10kA/230V Im=10xIn				40964	Schneider Electric BV	MERL.C60N-2P-C10		24268 // C60 N		-27/02	
-054F1.	1	CIRC. BREAKER 2P 20A B 10kA/230V Im=5xIn				40807	Schneider Electric BV	MERL.C60N-2P-B20		24078 // C60 N		-27/05	
-055F1.	1	CIRC. BREAKER 2P 10A C 10kA/230V Im=10xIn				40964	Schneider Electric BV	MERL.C60N-2P-C10		24268 // C60 N		-27/08	
-056F1.	1	CIRC. BREAKER 2P 06A B 10kA/230V Im=5xIn				40804	Schneider Electric BV	MERL.C60N-2P-B6		24075 // C60 N		-27/11	
-058F1.	2	GLASS FUSE 05x20mm 02,00A FAST VE10				40170	Technische Unie BV	ESKA.05X20\F2,00A		20.64.00.580		-30/03	
-058F1.	2	TERMINAL 4,00mm2 FUSE UT4-HESI (5x20) 6A Black				89264	Phoenix Contact	PHOE.UT4-HESI(5X20)		UT4-HESI(5X20)		-30/03	
-058F2.	2	GLASS FUSE 05x20mm 02,00A FAST VE10				40170	Technische Unie BV	ESKA.05X20\F2,00A		20.64.00.580		-30/04	
-058F2.	2	TERMINAL 4,00mm2 FUSE UT4-HESI (5x20) 6A Black				89264	Phoenix Contact	PHOE.UT4-HESI(5X20)		UT4-HESI(5X20)		-30/04	
-058F3.	2	GLASS FUSE 05x20mm 02,00A FAST VE10				40170	Technische Unie BV	ESKA.05X20\F2,00A		20.64.00.580		-31/05	
-058F3.	2	TERMINAL 4,00mm2 FUSE UT4-HESI (5x20) 6A Black				89264	Phoenix Contact	PHOE.UT4-HESI(5X20)		UT4-HESI(5X20)		-31/05	
-058F4.	1	CIRC. BREAKER 2P 06A B 10kA/230V Im=5xIn				40804	Schneider Electric BV	MERL.C60N-2P-B6		24075 // C60 N		-30/02	
-058F5.	1	CIRC. BREAKER 2P 06A B 10kA/230V Im=5xIn				40804	Schneider Electric BV	MERL.C60N-2P-B6		24075 // C60 N		-30/13	
-058F6.	2	GLASS FUSE 05x20mm 02,00A FAST VE10				40170	Technische Unie BV	ESKA.05X20\F2,00A		20.64.00.580		-30/06	
-058F6.	2	TERMINAL 4,00mm2 FUSE UT4-HESI (5x20) 6A Black				89264	Phoenix Contact	PHOE.UT4-HESI(5X20)		UT4-HESI(5X20)		-30/06	
-058H4.	1	PILOT LIGHT P-LED YELLOW 24VAC/DC HARMONY				75004	Schneider Electric BV	TELE.XB4BVB5		XB4BVB5		-34/03	
-058H5.	1	PILOT LIGHT P-LED GREEN 24VAC/DC HARMONY				75005	Schneider Electric BV	TELE.XB4BVB3		XB4BVB3		-34/04	
-058K1.	1	COIL for LC1-F185/225 230VAC				34343	Schneider Electric BV	TELE.LX1FG220		LX1FG220		-33/05	
-058K1.	1	CONTACTOR 3P 185A AC3 EXCL. COIL				28009	Schneider Electric BV	TELE.LC1F185		LC1F185		-33/05	
-058K1.	1	AUX. CONTACT 4NO+0NC for LC1-D TESYS				28381	Schneider Electric BV	TELE.LADN40		LADN40		-33/05	
-058K1.	1	AUX. CONTACT 0NO+4NC for LC1-D TESYS				28382	Schneider Electric BV	TELE.LADN04		LADN04		-33/05	
-058K2.	1	AUX. RELAY 3NO+2NC 230VAC 10A TESYS				28294	Schneider Electric BV	TELE.CAD32P7		CAD32P7		-33/03	
-058K2.	1	AUX. CONTACT TIME 1NO+1NC ON DELAY 3SEC.				28386	Schneider Electric BV	TELE.LADT0		LADT0		-33/03	
-058K3.	1	CONTACTOR 3P 009A AC3 1NO+1NC REV.CONTACTOR 230V				28020	Schneider Electric BV	TELE.LC2D09P7		LC2D09P7		-32/03	
-058K3.	1	AUX. CONTACT TIME 1NO+1NC OFF DELAY 3SEC.				28390	Schneider Electric BV	TELE.LADR0		LADR0		-32/03	
-058K4.	1	AUX. CONTACT TIME 1NO+1NC OFF DELAY 3SEC.				28390	Schneider Electric BV	TELE.LADR0		LADR0		-32/05	
-058S2.	1	SELECTOR SWITCH 2P 20A 0-1 CH10 A291 FT2-V				19562	Kraus & Naimer	KRAU.CH10-A291FT2-V		CH10-A291FT2-V		-33/03	
-058X5.	14	TERMINAL 2,50mm2 UT2,5 Screw Grey NS35/7,5/15				89200	Phoenix Contact	PHOE.UT2,5		UT2,5		-59/02	
-058X5.	1	END PART. for UT2,5-UT10 D-UT 2,5/10				89706	Phoenix Contact	PHOE.D-UT2,5/10		D-UT2,5/10		-59/02	
-058X5.	1	END-BRACKET FAST FIT CLIPFIX 35-5				89820	Phoenix Contact	PHOE.CLIPFIX35-5		CLIPFIX35-5		-59/02	
-059E1.	1	CABINET LIGHTING/SOCKET 230V/50Hz 14W L=452mm + DOORSWITCH				45520	Rittal	RITT.SZ4138.150		SZ4138.150		-35/08	
-059E1.	1	CONNECTION CABLE for PS/ES/DK SERIES WITHOUT CONNECTOR ORANGE L=3000MM				45510	Rittal	RITT.SZ4315.100		SZ4315.100		-35/08	
-059E2.	1	CABINET LIGHTING/SOCKET 230V/50Hz 14W L=452mm + DOORSWITCH				45520	Rittal	RITT.SZ4138.150		SZ4138.150		-35/10	
< 8000.a8000.c >													
4-1-2011	PVR			  ALEWIJNSE MARINE B.V. ENERGIEWEG 46/C 6541 CX NIJMEGEN	IHC DREDGERS BV - TSHD5500 DCI-3 "11L" MAIN DISTRIBUTION BOARD 3X230V PARTS LIST							Yard no : CO1266	
-12-2013	IEN	REV	1									Project : 23000143	
S BUILT												Class : LROS/IRS	
5-12-2013	IEN	CHK										Page : 11L -8000.b	

No part of this work may be copied, stored or published without prior written permission of Alewijnse Marine Systems.

01	02	03	04	05	06	07	08	09	10	11	12	13	14	
PARTS LIST 11L														
DEVICE		QTY	DESCRIPTION				NAV. NUMBER	MANUFACTURER	PART NUMBER		TYPE NUMBER		PAGE	
-059E2.		1	CONNECTION CABLE for PS/ES/DK SERIES WITHOUT CONNECTOR ORANGE L=3000MM				45510	Rittal	RITT.SZ4315.100		SZ4315.100		-35/10	
-059E3.		1	CABINET HEATER 20W/110-240V/50-60Hz				50454	Rittal	RITT.SK3105.320		SK3105.320		-35/12	
-059E4.		1	CABINET HEATER 20W/110-240V/50-60Hz				50454	Rittal	RITT.SK3105.320		SK3105.320		-35/14	
-059E5.		1	HYGRO CONTROL 50-100% R.V.				45051	Rittal	RITT.SK3118.000		SK3118.000		-35/12	
-059F1.		2	GLASS FUSE 05x20mm 02,00A FAST VE10				40170	Technische Unie BV	ESKA.05X20\F2,00A		20.64.00.580		-30/08	
-059F1.		2	TERMINAL 4,00mm2 FUSE UT4-HESI (5x20) 6A Black				89264	Phoenix Contact	PHOE.UT4-HESI(5X20)		UT4-HESI(5X20)		-30/08	
-059F2.		2	GLASS FUSE 05x20mm 02,00A FAST VE10				40170	Technische Unie BV	ESKA.05X20\F2,00A		20.64.00.580		-30/09	
-059F2.		2	TERMINAL 4,00mm2 FUSE UT4-HESI (5x20) 6A Black				89264	Phoenix Contact	PHOE.UT4-HESI(5X20)		UT4-HESI(5X20)		-30/09	
-059F3.		2	GLASS FUSE 05x20mm 02,00A FAST VE10				40170	Technische Unie BV	ESKA.05X20\F2,00A		20.64.00.580		-30/11	
-059F3.		2	TERMINAL 4,00mm2 FUSE UT4-HESI (5x20) 6A Black				89264	Phoenix Contact	PHOE.UT4-HESI(5X20)		UT4-HESI(5X20)		-30/11	
-059M1.		1	FAN 230VAC 180-205m3/h 255x255mm				50363	Rittal	RITT.SK3240.100		SK3240.100		-35/03	
-059M2.		1	FAN 230VAC 180-205m3/h 255x255mm				50363	Rittal	RITT.SK3240.100		SK3240.100		-35/05	
-060F1.		2	GLASS FUSE 05x20mm 02,00A FAST VE10				40170	Technische Unie BV	ESKA.05X20\F2,00A		20.64.00.580		-30/12	
-060F1.		2	TERMINAL 4,00mm2 FUSE UT4-HESI (5x20) 6A Black				89264	Phoenix Contact	PHOE.UT4-HESI(5X20)		UT4-HESI(5X20)		-30/12	
-060X2.		7	TERMINAL 2,50mm2 UT2,5 Screw Grey NS35/7,5/15				89200	Phoenix Contact	PHOE.UT2,5		UT2,5		-36/03	
-060X2.		1	END PART. for UT2,5-UT10 D-UT 2,5/10				89706	Phoenix Contact	PHOE.D-UT2,5/10		D-UT2,5/10		-36/03	
-060X2.		2	END-BRACKET FAST FIT CLIPFIX 35-5				89820	Phoenix Contact	PHOE.CLIPFIX35-5		CLIPFIX35-5		-36/03	
-061F1.		1	CIRC. BREAKER 2P 16A B 10kA/230V Im=5xIn				40806	Schneider Electric BV	MERL.C60N-2P-B16		24077 // C60 N		-40/02	
-062F1.		1	CIRC. BREAKER 2P 16A C 10kA/230V Im=10xIn				40965	Schneider Electric BV	MERL.C60N-2P-C16		24270 // C60 N		-40/05	
-063F1.		1	CIRC. BREAKER 2P 10A C 10kA/230V Im=10xIn				40964	Schneider Electric BV	MERL.C60N-2P-C10		24268 // C60 N		-40/08	
-064F1.		2	GLASS FUSE 05x20mm 02,00A FAST VE10				40170	Technische Unie BV	ESKA.05X20\F2,00A		20.64.00.580		-41/03	
-064F1.		2	TERMINAL 4,00mm2 FUSE UT4-HESI (5x20) 6A Black				89264	Phoenix Contact	PHOE.UT4-HESI(5X20)		UT4-HESI(5X20)		-41/03	
-064H4.		1	PILOT LIGHT P-LED WHITE 230VAC HARMONY				75019	Schneider Electric BV	TELE.XB4BVM1		XB4BVM1		-42/03	
-064H4.		1	OVER VOLTAGE ELEMENT 230VAC HARMONY				75010	Schneider Electric BV	TELE.ZBZ-VM		ZBZ-VM		-42/03	
-064H5.		1	PILOT LIGHT P-LED GREEN 230VAC HARMONY				75015	Schneider Electric BV	TELE.XB4BVM3		XB4BVM3		-42/06	
-064H5.		1	OVER VOLTAGE ELEMENT 230VAC HARMONY				75010	Schneider Electric BV	TELE.ZBZ-VM		ZBZ-VM		-42/06	
-064K1.		1	CONTACTOR 3P 009A AC3 1NO+1NC 230VAC LC1-D09 TESY				28353	Schneider Electric BV	TELE.LC1D09P7		LC1D09P7		-42/05	
-064Q1.		1	MOTOR PROT. THER. MAGN 0,63-1A ROTARY				28735	Schneider Electric BV	TELE.GV2P05		GV2P05		-41/02	
-064Q1.		1	AUX. CONTACT 1NO+1NO (fault) SIDE CONN. for GV2 TESYS				28159	Schneider Electric BV	TELE.GVAD1010		GVAD1010		-41/02	
-064S1.		1	SELECTOR SWITCH 2P 20A 0-1 CH10 A291 FT2-V				19562	Kraus & Naimer	KRAU.CH10-A291FT2-V		CH10-A291FT2-V		-42/05	
-064X2.		6	TERMINAL 2,50mm2 UT2,5 Screw Grey NS35/7,5/15				89200	Phoenix Contact	PHOE.UT2,5		UT2,5		-42/03	
-064X2.		1	END PART. for UT2,5-UT10 D-UT 2,5/10				89706	Phoenix Contact	PHOE.D-UT2,5/10		D-UT2,5/10		-42/03	
-064X2.		2	END-BRACKET FAST FIT CLIPFIX 35-5				89820	Phoenix Contact	PHOE.CLIPFIX35-5		CLIPFIX35-5		-42/03	
-064X5.		4	TERMINAL 2,50mm2 UT2,5 Screw Grey NS35/7,5/15				89200	Phoenix Contact	PHOE.UT2,5		UT2,5		-42/11	
-064X5.		1	END PART. for UT2,5-UT10 D-UT 2,5/10				89706	Phoenix Contact	PHOE.D-UT2,5/10		D-UT2,5/10		-42/11	
-064X5.		1	END-BRACKET FAST FIT CLIPFIX 35-5				89820	Phoenix Contact	PHOE.CLIPFIX35-5		CLIPFIX35-5		-42/11	
-065F1.		1	CIRC. BREAKER 2P 10A C 10kA/230V Im=10xIn				40964	Schneider Electric BV	MERL.C60N-2P-C10		24268 // C60 N		-41/05	
-066F1.		2	GLASS FUSE 05x20mm 02,00A FAST VE10				40170	Technische Unie BV	ESKA.05X20\F2,00A		20.64.00.580		-41/10	
-066F1.		2	TERMINAL 4,00mm2 FUSE UT4-HESI (5x20) 6A Black				89264	Phoenix Contact	PHOE.UT4-HESI(5X20)		UT4-HESI(5X20)		-41/10	
-066H4.		1	PILOT LIGHT P-LED WHITE 230VAC HARMONY				75019	Schneider Electric BV	TELE.XB4BVM1		XB4BVM1		-43/03	
< 8000.b 8000.d >														
4-1-2011	PVR			  ALEWIJNSE MARINE B.V. ENERGIEWEG 46/C 6541 CX NIJMEGEN	IHC DREDGERS BV - TSHD5500 DCI-3 "11L" MAIN DISTRIBUTION BOARD 3X230V PARTS LIST							Yard no : CO1266		
-12-2013	IEN	REV	1									Project : 23000143		
S BUILT												Class : LROS/IRS		
5-12-2013	IEN	CHK										Page : 11L -8000.c		

No part of this work may be copied, stored or published without prior written permission of Alewijnse Marine Systems.

01	02	03	04	05	06	07	08	09	10	11	12	13	14	
PARTS LIST 11L														
DEVICE	QTY	DESCRIPTION				NAV. NUMBER	MANUFACTURER	PART NUMBER		TYPE NUMBER		PAGE		
-066H4.	1	OVER VOLTAGE ELEMENT 230VAC HARMONY				75010	Schneider Electric BV	TELE.ZBZ-VM		ZBZ-VM		-43/03		
-066H5.	1	PILOT LIGHT P-LED GREEN 230VAC HARMONY				75015	Schneider Electric BV	TELE.XB4BVM3		XB4BVM3		-43/06		
-066H5.	1	OVER VOLTAGE ELEMENT 230VAC HARMONY				75010	Schneider Electric BV	TELE.ZBZ-VM		ZBZ-VM		-43/06		
-066K1.	1	CONTACTOR 3P 009A AC3 1NO+1NC 230VAC LC1-D09 TESY				28353	Schneider Electric BV	TELE.LC1D09P7		LC1D09P7		-43/05		
-066Q1.	1	MOTOR PROT. THER. MAGN 1,6-2,5A ROTARY				28738	Schneider Electric BV	TELE.GV2P07		GV2P07		-41/08		
-066Q1.	1	AUX. CONTACT 1NO+1NO (fault) SIDE CONN. for GV2 TESYS				28159	Schneider Electric BV	TELE.GVAD1010		GVAD1010		-41/08		
-066S1.	1	SELECTOR SWITCH 2P 20A 0-1 CH10 A291 FT2-V				19562	Kraus & Naimer	KRAU.CH10-A291FT2-V		CH10-A291FT2-V		-43/05		
-066X2.	6	TERMINAL 2,50mm2 UT2,5 Screw Grey NS35/7,5/15				89200	Phoenix Contact	PHOE.UT2,5		UT2,5		-43/03		
-066X2.	1	END PART. for UT2,5-UT10 D-UT 2,5/10				89706	Phoenix Contact	PHOE.D-UT2,5/10		D-UT2,5/10		-43/03		
-066X2.	2	END-BRACKET FAST FIT CLIPFIX 35-5				89820	Phoenix Contact	PHOE.CLIPFIX35-5		CLIPFIX35-5		-43/03		
-066X5.	6	TERMINAL 2,50mm2 UT2,5 Screw Grey NS35/7,5/15				89200	Phoenix Contact	PHOE.UT2,5		UT2,5		-43/11		
-066X5.	1	END PART. for UT2,5-UT10 D-UT 2,5/10				89706	Phoenix Contact	PHOE.D-UT2,5/10		D-UT2,5/10		-43/11		
-066X5.	2	END-BRACKET FAST FIT CLIPFIX 35-5				89820	Phoenix Contact	PHOE.CLIPFIX35-5		CLIPFIX35-5		-43/11		
-067F1.	1	CIRC. BREAKER 2P 16A C 10kA/230V Im=10xIn				40965	Schneider Electric BV	MERL.C60N-2P-C16		24270 // C60 N		-41/12		
-068F1.	1	CIRC. BREAKER 2P 10A C 10kA/230V Im=10xIn				40964	Schneider Electric BV	MERL.C60N-2P-C10		24268 // C60 N		-44/02		
-069F1.	1	CIRC. BREAKER 2P 16A C 10kA/230V Im=10xIn				40965	Schneider Electric BV	MERL.C60N-2P-C16		24270 // C60 N		-44/05		
-070F1.	1	CIRC. BREAKER 2P 10A C 10kA/230V Im=10xIn				40964	Schneider Electric BV	MERL.C60N-2P-C10		24268 // C60 N		-44/08		
-071F1.	1	CIRC. BREAKER 2P 06A B 10kA/230V Im=5xIn				40804	Schneider Electric BV	MERL.C60N-2P-B6		24075 // C60 N		-44/11		
-072F1.	1	CIRC. BREAKER 2P 16A C 10kA/230V Im=10xIn				40965	Schneider Electric BV	MERL.C60N-2P-C16		24270 // C60 N		-45/02		
-074F1.	1	CIRC. BREAKER 2P 16A B 10kA/230V Im=5xIn				40806	Schneider Electric BV	MERL.C60N-2P-B16		24077 // C60 N		-45/05		
-075F1.	1	CIRC. BREAKER 2P 16A C 10kA/230V Im=10xIn				40965	Schneider Electric BV	MERL.C60N-2P-C16		24270 // C60 N		-45/08		
-076F1.	1	CIRC. BREAKER 2P 16A C 10kA/230V Im=10xIn				40965	Schneider Electric BV	MERL.C60N-2P-C16		24270 // C60 N		-45/12		
-077F1.	1	CIRC. BREAKER 2P 20A C 10kA/230V Im=10xIn				40966	Schneider Electric BV	MERL.C60N-2P-C20		24271 // C60 N		-46/02		
-078F1.	1	CIRC. BREAKER 2P 16A C 10kA/230V Im=10xIn				40965	Schneider Electric BV	MERL.C60N-2P-C16		24270 // C60 N		-46/05		
-079F1.	1	CIRC. BREAKER 2P 16A C 10kA/230V Im=10xIn				40965	Schneider Electric BV	MERL.C60N-2P-C16		24270 // C60 N		-46/08		
-080F1.	1	CIRC. BREAKER 2P 16A B 10kA/230V Im=5xIn				40806	Schneider Electric BV	MERL.C60N-2P-B16		24077 // C60 N		-46/12		
-081F1.	1	CIRC. BREAKER 2P 16A C 10kA/230V Im=10xIn				40965	Schneider Electric BV	MERL.C60N-2P-C16		24270 // C60 N		-47/02		
-082F1.	1	CIRC. BREAKER 2P 10A C 10kA/230V Im=10xIn				40964	Schneider Electric BV	MERL.C60N-2P-C10		24268 // C60 N		-47/05		
-083F1.	1	CIRC. BREAKER 2P 10A C 10kA/230V Im=10xIn				40964	Schneider Electric BV	MERL.C60N-2P-C10		24268 // C60 N		-47/08		
-084F1.	1	CIRC. BREAKER 2P 16A B 10kA/230V Im=5xIn				40806	Schneider Electric BV	MERL.C60N-2P-B16		24077 // C60 N		-47/11		
-085F1.	1	CIRC. BREAKER 2P 16A B 10kA/230V Im=5xIn				40806	Schneider Electric BV	MERL.C60N-2P-B16		24077 // C60 N		-48/02		
-085K1.	1	CONTACTOR 2P 2NO+0NC 16A 230VAC				76737	Schneider Electric BV	MERL.CT20-16A/230VAC		15957		-36/12		
-086F1.	1	CIRC. BREAKER 2P 16A B 10kA/230V Im=5xIn				40806	Schneider Electric BV	MERL.C60N-2P-B16		24077 // C60 N		-48/05		
-086K1.	1	CONTACTOR 2P 2NO+0NC 16A 230VAC				76737	Schneider Electric BV	MERL.CT20-16A/230VAC		15957		-37/07		
-087F1.	1	CIRC. BREAKER 2P 16A B 10kA/230V Im=5xIn				40806	Schneider Electric BV	MERL.C60N-2P-B16		24077 // C60 N		-48/08		
-087K1.	1	CONTACTOR 2P 2NO+0NC 16A 230VAC				76737	Schneider Electric BV	MERL.CT20-16A/230VAC		15957		-36/10		
-088F1.	1	CIRC. BREAKER 2P 16A B 10kA/230V Im=5xIn				40806	Schneider Electric BV	MERL.C60N-2P-B16		24077 // C60 N		-48/12		
-088K1.	1	CONTACTOR 2P 2NO+0NC 16A 230VAC				76737	Schneider Electric BV	MERL.CT20-16A/230VAC		15957		-36/05		
-089F1.	1	CIRC. BREAKER 2P 16A B 10kA/230V Im=5xIn				40806	Schneider Electric BV	MERL.C60N-2P-B16		24077 // C60 N		-49/02		
-089K1.	1	CONTACTOR 2P 2NO+0NC 16A 230VAC				76737	Schneider Electric BV	MERL.CT20-16A/230VAC		15957		-36/06		
< 8000.c8000.e >														
4-1-2011	PVR					IHC DREDGERS BV - TSHD5500 DCI-3 "11L" MAIN DISTRIBUTION BOARD 3X230V PARTS LIST							Yard no : CO1266	
-12-2013	IEN	REV	1										Project : 23000143	
S BUILT													Class : LROS/IRS	
5-12-2013	IEN	CHK											Page : 11L -8000.d	

No part of this work may be copied, stored or published without prior written permission of Alewijnse Marine Systems.	01	02	03	04	05	06	07	08	09	10	11	12	13	14
	PARTS LIST 11L													
	DEVICE	QTY	DESCRIPTION				NAV. NUMBER	MANUFACTURER	PART NUMBER		TYPE NUMBER		PAGE	
	-090F1.	1	CIRC. BREAKER 2P 16A B 10kA/230V Im=5xIn				40806	Schneider Electric BV	MERL.C60N-2P-B16		24077 // C60 N		-49/05	
	-091F1.	1	CIRC. BREAKER 2P 16A B 10kA/230V Im=5xIn				40806	Schneider Electric BV	MERL.C60N-2P-B16		24077 // C60 N		-49/08	
	-092F1.	1	CIRC. BREAKER 2P 16A B 10kA/230V Im=5xIn				40806	Schneider Electric BV	MERL.C60N-2P-B16		24077 // C60 N		-49/12	
	-093F1.	1	CIRC. BREAKER 2P 16A B 10kA/230V Im=5xIn				40806	Schneider Electric BV	MERL.C60N-2P-B16		24077 // C60 N		-50/02	
	-094F1.	1	CIRC. BREAKER 2P 10A C 10kA/230V Im=10xIn				40964	Schneider Electric BV	MERL.C60N-2P-C10		24268 // C60 N		-50/05	
	-095F1.	1	CIRC. BREAKER 2P 16A B 10kA/230V Im=5xIn				40806	Schneider Electric BV	MERL.C60N-2P-B16		24077 // C60 N		-50/08	
	-096F1.	1	CIRC. BREAKER 2P 16A B 10kA/230V Im=5xIn				40806	Schneider Electric BV	MERL.C60N-2P-B16		24077 // C60 N		-50/12	
	-097F1.	1	CIRC. BREAKER 2P 10A B 10kA/230V Im=5xIn				40805	Schneider Electric BV	MERL.C60N-2P-B10		24076 // C60 N		-51/02	
	-097U1.	1	POWER SUPPLY 230VAC//18-29,5VDC-40A+1NO+SFB				38413	Phoenix Contact	PHOE.QUINT/1AC/24DC/40		QUINT/1AC/24DC/40		-51/02	
	-097X3.	2	TERMINAL 16,00mm2 UT16 Screw Grey NS35/7,5/15				89303	Phoenix Contact	PHOE.UT16		UT16		-51/03	
	-097X3.	1	END PART. for UT16 D-UT 16				89803	Phoenix Contact	PHOE.D-UT16		D-UT16		-51/03	
	-097X3.	2	END-BRACKET FAST FIT CLIPFIX 35-5				89820	Phoenix Contact	PHOE.CLIPFIX35-5		CLIPFIX35-5		-51/03	
	-098F1.	1	CIRC. BREAKER 2P 20A C 10kA/230V Im=10xIn				40966	Schneider Electric BV	MERL.C60N-2P-C20		24271 // C60 N		-51/05	
	-099F1.	1	CIRC. BREAKER 2P 20A C 10kA/230V Im=10xIn				40966	Schneider Electric BV	MERL.C60N-2P-C20		24271 // C60 N		-51/08	
	-100F1.	1	CIRC. BREAKER 2P 06A B 10kA/230V Im=5xIn				40804	Schneider Electric BV	MERL.C60N-2P-B6		24075 // C60 N		-51/12	
	-101Q1.	1	COMPACT CB NSX100F FRAME 3P 36kA 400VAC				98730	Schneider Electric BV	MERL.NSX100F-3P		LV429003		-52/02	
	-101Q1.	1	COMPACT CB NSX100-250 PROT. 3P 036-100A MICROLOGIC 2.2				98754	Schneider Electric BV	MERL.NSX100-250/M2.2/100A/3P		LV429070		-52/02	
	-102Q1.	1	COMPACT CB NSX100F FRAME 3P 36kA 400VAC				98730	Schneider Electric BV	MERL.NSX100F-3P		LV429003		-52/05	
	-102Q1.	1	COMPACT CB NSX100-250 PROT. 3P 036-100A MICROLOGIC 2.2				98754	Schneider Electric BV	MERL.NSX100-250/M2.2/100A/3P		LV429070		-52/05	
	-103Q1.	1	COMPACT CB NSX100F FRAME 3P 36kA 400VAC				98730	Schneider Electric BV	MERL.NSX100F-3P		LV429003		-52/08	
	-103Q1.	1	COMPACT CB NSX100-250 PROT. 3P 036-100A MICROLOGIC 2.2				98754	Schneider Electric BV	MERL.NSX100-250/M2.2/100A/3P		LV429070		-52/08	
	-104Q1.	1	COMPACT CB NSX100F FRAME 3P 36kA 400VAC				98730	Schneider Electric BV	MERL.NSX100F-3P		LV429003		-52/12	
	-104Q1.	1	COMPACT CB NSX100-250 PROT. 3P 036-100A MICROLOGIC 2.2				98754	Schneider Electric BV	MERL.NSX100-250/M2.2/100A/3P		LV429070		-52/12	
	-105F1.	1	CIRC. BREAKER 2P 02A C 10kA/230V Im=10xIn				40961	Schneider Electric BV	MERL.C60N-2P-C2		24264 // C60 N		-55/09	
	-105F2.	1	CIRC. BREAKER 3P 02A C 10kA/400V Im=10xIn				40782	Schneider Electric BV	MERL.C60N-3P-C2		24278 // C60 N		-55/10	
	-105F3.	1	CIRC. BREAKER 2P 02A C 10kA/230V Im=10xIn				40961	Schneider Electric BV	MERL.C60N-2P-C2		24264 // C60 N		-55/02	
	-105F4.	1							MERL.C60N-4P-C2				-55/04	
-105F4.	1	AUX. CONTACT FOR C60H 1xAUX + 1xAUX/TRIP				40952	Schneider Electric BV	MERL.C60-OF+SD/OF		26929		-55/04		
-105H4.	1	PILOT LIGHT P-LED YELLOW 24VAC/DC HARMONY				75004	Schneider Electric BV	TELE.XB4BVB5		XB4BVB5		-58/03		
-105H5.	1	PILOT LIGHT P-LED GREEN 24VAC/DC HARMONY				75005	Schneider Electric BV	TELE.XB4BVB3		XB4BVB3		-58/04		
-105K1.	1	COIL for LC1-F185/225 230VAC				34343	Schneider Electric BV	TELE.LX1FG220		LX1FG220		-56/03		
-105K1.	1	CONTACTOR 3P 185A AC3 EXCL. COIL				28009	Schneider Electric BV	TELE.LC1F185		LC1F185		-56/03		
-105K1.	2	AUX. CONTACT 2NO+2NC for LC1-D TESYS				28393	Schneider Electric BV	TELE.LADN22		LADN-22		-56/03		
-105K2.	1	AUX. RELAY 3NO+2NC 230VAC 10A TESYS				28294	Schneider Electric BV	TELE.CAD32P7		CAD32P7		-56/05		
-105K2.	1	AUX. CONTACT TIME 1NO+1NC ON DELAY 3SEC.				28386	Schneider Electric BV	TELE.LADT0		LADT0		-56/05		
-105K3.	1	AUX. RELAY 3NO+2NC 230VAC 10A TESYS				28294	Schneider Electric BV	TELE.CAD32P7		CAD32P7		-57/06		
-105K4.	1	AUX. RELAY 3NO+2NC 230VAC 10A TESYS				28294	Schneider Electric BV	TELE.CAD32P7		CAD32P7		-57/08		
-105P1.	1							BENDER.IRDH375-435/B91065000 (SPECIAL ORDER AISP)				-57/11		
-105P2.	1							DEIF.EQ96-X 0-300V AC				-57/03		
-105P3.	1							DEIF.EQ96-X 0-300A				-57/03		
< 8000.d														

D	24-1-2011	PVR					IHC DREDGERS BV - TSHD5500 DCI-3 "11L" MAIN DISTRIBUTION BOARD 3X230V PARTS LIST	Yard no : CO1266 Project : 23000143 Class : LROS/IRS	
M	5-12-2013	IEN	REV	1					
STAT	AS BUILT								
	05-12-2013	IEN	CHK						
ALEWIJNSE MARINE B.V. ENERGIEWEG 46/C 6541 CX NIJMEGEN									Page : 11L -8000.e

No part of this work may be copied, stored or published without prior written permission of Alewijnse Marine Systems.

< 8000.e

==11L5/01 >

01	02	03	04	05	06	07	08	09	10	11	12	13	14
PARTS LIST11L													
DEVICE	QTY	DESCRIPTION				NAV. NUMBER	MANUFACTURER	PART NUMBER		TYPE NUMBER		PAGE	
-105S1.	1	SELECTOR SWITCH 1P 20A 1-0-2 CH10 A210 FT2-V				19580	Kraus & Naimer	KRAU.CH10-A210FT2-V		CH10-A210FT2-V		-56/05	
-105S2.	1	SELECTOR SWITCH VOLT INDICATOR 4 CG8 A004-624FT2-V				19531	Kraus & Naimer	KRAU.CH10-A004624FT2-V		CH10-A004624FT2-V		-57/03	
-105S3.	1	SELECTOR SWITCH AMP meter CG8 CG8 3xCT				19532	Kraus & Naimer	KRAU.CH10-A048FT2-V		CH10-A048FT2-V		-57/03	
-105T1.	1	CURRENT TRAFO for RAIL 300/5 5VA KL1				38613	ELEQ BV	FAGE.RM60N-E3A-300/5		RM60N-E3A-300/5		-55/06	
-105T2.	1	CURRENT TRAFO for RAIL 300/5 5VA KL1				38613	ELEQ BV	FAGE.RM60N-E3A-300/5		RM60N-E3A-300/5		-55/06	
-105T3.	1	CURRENT TRAFO for RAIL 300/5 5VA KL1				38613	ELEQ BV	FAGE.RM60N-E3A-300/5		RM60N-E3A-300/5		-55/07	
-105X2.	3	TERMINAL 2,50mm2 UT2,5 Screw Grey NS35/7,5/15				89200	Phoenix Contact	PHOE.UT2,5		UT2,5		-56/03	
-105X2.	1	END PART. for UT2,5-UT10 D-UT 2,5/10				89706	Phoenix Contact	PHOE.D-UT2,5/10		D-UT2,5/10		-56/03	
-105X2.	2	END-BRACKET FAST FIT CLIPFIX 35-5				89820	Phoenix Contact	PHOE.CLIPFIX35-5		CLIPFIX35-5		-56/03	