

IHC DREDGERS BV - TSHD5500 DCI-3

CO1266

TSHD5500 DCI-3

ELECTRIC INSTALLATION

"12EP" EMERGENCY DISTRIBUTION BOARD 3X415V

 **Alewijnse Marine Systems**

ENERGIEWEG 46/c 6541 CX NIJMEGEN
P.O. BOX 6973 6503 GL NIJMEGEN
THE NETHERLANDS

TEL : +31 243716311
FAX : +31 243716310
EMAIL : am@alewijnse.nl


CUSTOMER SUPPORT

TEL : +31 243716342
EMAIL : service.amn@alewijnse.nl

No part of this work may be copied, stored or published without prior written permission of Alewijnse Marine Systems.


0102030405060708091011121314														
TABLE OF CONTENTS														
PAGE		SYSTEM				DESCRIPTION				STATUS		REV.	REV. DATE	
12EP -0		"12EP" EMERGENCY DISTRIBUTION BOARD 3X415V				FRONTPAGE				AS BUILT		1	5-12-2013	
12EP -1		"12EP" EMERGENCY DISTRIBUTION BOARD 3X415V				TABLE OF CONTENTS				AS BUILT		1	5-12-2013	
12EP -1.a		"12EP" EMERGENCY DISTRIBUTION BOARD 3X415V				TABLE OF CONTENTS				AS BUILT		1	5-12-2013	
12EP -10		"12EP" EMERGENCY DISTRIBUTION BOARD 3X415V				EMERGENCY GENERATOR MAIN CIRCUIT				AS BUILT		1	5-12-2013	
12EP -11		"12EP" EMERGENCY DISTRIBUTION BOARD 3X415V				EMERGENCY GENERATOR MAIN CIRCUIT				AS BUILT		1	5-12-2013	
12EP -12		"12EP" EMERGENCY DISTRIBUTION BOARD 3X415V				DISTRIBUTION 230VAC MAIN CIRCUIT				AS BUILT		1	5-12-2013	
12EP -13		"12EP" EMERGENCY DISTRIBUTION BOARD 3X415V				DISTRIBUTION 24VDC MAIN CIRCUIT				AS BUILT		1	5-12-2013	
12EP -14		"12EP" EMERGENCY DISTRIBUTION BOARD 3X415V				EMERGENCY GENERATOR CONTROL CIRCUIT BREAKER				AS BUILT		1	5-12-2013	
12EP -15		"12EP" EMERGENCY DISTRIBUTION BOARD 3X415V				EMERGENCY GENERATOR CONTROL CIRCUIT HEATER				AS BUILT		1	5-12-2013	
12EP -16		"12EP" EMERGENCY DISTRIBUTION BOARD 3X415V				EMERGENCY GENERATOR CONTROL CIRCUIT				AS BUILT		1	5-12-2013	
12EP -17		"12EP" EMERGENCY DISTRIBUTION BOARD 3X415V				EMERGENCY GENERATOR CONTROL CIRCUIT				AS BUILT		1	5-12-2013	
12EP -18		"12EP" EMERGENCY DISTRIBUTION BOARD 3X415V				EMERGENCY GENERATOR SIGNALING				AS BUILT		1	5-12-2013	
12EP -26		"12EP" EMERGENCY DISTRIBUTION BOARD 3X415V				DISTRIBUTION 24VDC MAIN CIRCUIT				AS BUILT		1	5-12-2013	
12EP -27		"12EP" EMERGENCY DISTRIBUTION BOARD 3X415V				INCOMING FEEDER MSB CONTROL CIRCUIT BREAKER				AS BUILT		1	5-12-2013	
12EP -28		"12EP" EMERGENCY DISTRIBUTION BOARD 3X415V				INCOMING FEEDER MSB CONTROL CIRCUIT				AS BUILT		1	5-12-2013	
12EP -29		"12EP" EMERGENCY DISTRIBUTION BOARD 3X415V				INCOMING FEEDER MSB SIGNALING & MEASURING				AS BUILT		1	5-12-2013	
12EP -35		"12EP" EMERGENCY DISTRIBUTION BOARD 3X415V				LIGHTING / VENTILATION / HEATING MAIN CIRCUIT				AS BUILT		1	5-12-2013	
12EP -36		"12EP" EMERGENCY DISTRIBUTION BOARD 3X415V				PANEL -LIGHTING / VENTILATION CONTROL CIRCUIT				AS BUILT		1	5-12-2013	
12EP -37		"12EP" EMERGENCY DISTRIBUTION BOARD 3X415V				PANEL - HEATING CONTROL CIRCUIT				AS BUILT		1	5-12-2013	
12EP -40		"12EP" EMERGENCY DISTRIBUTION BOARD 3X415V				STARTERS / DISTRIBUTION MAIN CIRCUIT				AS BUILT		1	5-12-2013	
12EP -41		"12EP" EMERGENCY DISTRIBUTION BOARD 3X415V				S10 - EMERGENCY GENERATOR ROOM SUPPLY FAN CONTROL CIRCUIT				AS BUILT		1	5-12-2013	
12EP -42		"12EP" EMERGENCY DISTRIBUTION BOARD 3X415V				S2 - ENGINE ROOM SUPPLY FAN PS CONTROL CIRCUIT				AS BUILT		1	5-12-2013	
12EP -43		"12EP" EMERGENCY DISTRIBUTION BOARD 3X415V				S2 - ENGINE ROOM SUPPLY FAN PS CONTROL CIRCUIT				AS BUILT		1	5-12-2013	
12EP -50		"12EP" EMERGENCY DISTRIBUTION BOARD 3X415V				STARTERS / DISTRIBUTION MAIN CIRCUIT				AS BUILT		1	5-12-2013	
12EP -51		"12EP" EMERGENCY DISTRIBUTION BOARD 3X415V				S4 - ENGINE ROOM SUPPLY FAN SB REVERSIBLE CONTROL CIRCUIT				AS BUILT		1	5-12-2013	
12EP -52		"12EP" EMERGENCY DISTRIBUTION BOARD 3X415V				S4 - ENGINE ROOM SUPPLY FAN SB REVERSIBLE CONTROL CIRCUIT				AS BUILT		1	5-12-2013	
12EP -60		"12EP" EMERGENCY DISTRIBUTION BOARD 3X415V				STARTERS / DISTRIBUTION MAIN CIRCUIT				AS BUILT		1	5-12-2013	
12EP -65		"12EP" EMERGENCY DISTRIBUTION BOARD 3X415V				STARTERS / DISTRIBUTION MAIN CIRCUIT				AS BUILT		1	5-12-2013	
12EP -70		"12EP" EMERGENCY DISTRIBUTION BOARD 3X415V				STARTERS / DISTRIBUTION MAIN CIRCUIT				AS BUILT		1	5-12-2013	
12EP -71		"12EP" EMERGENCY DISTRIBUTION BOARD 3X415V				FIFI/ BALLAST/ EMERGENCY BILGE PUMP CONTROL CIRCUIT				AS BUILT		1	5-12-2013	
12EP -72		"12EP" EMERGENCY DISTRIBUTION BOARD 3X415V				FIFI/ BALLAST/ EMERGENCY BILGE PUMP CONTROL CIRCUIT				AS BUILT		1	5-12-2013	
12EP -73		"12EP" EMERGENCY DISTRIBUTION BOARD 3X415V				FIFI/ BALLAST/ EMERGENCY BILGE PUMP CONTROL CIRCUIT				AS BUILT		1	5-12-2013	
< 01.a >														
D	24-1-2011	PVR					IHC DREDGERS BV - TSHD5500 DCI-3 "12EP" EMERGENCY DISTRIBUTION BOARD 3X415V TABLE OF CONTENTS						Yard no : CO1266	
M	5-12-2013	IEN	REV	1									Project : 23000143	
STAT	AS BUILT												Class : LROS/IRS	
	05-12-2013	IEN	CHK										Page : 12EP -1	

No part of this work may be copied, stored or published without prior written permission of Alewijnse Marine Systems.

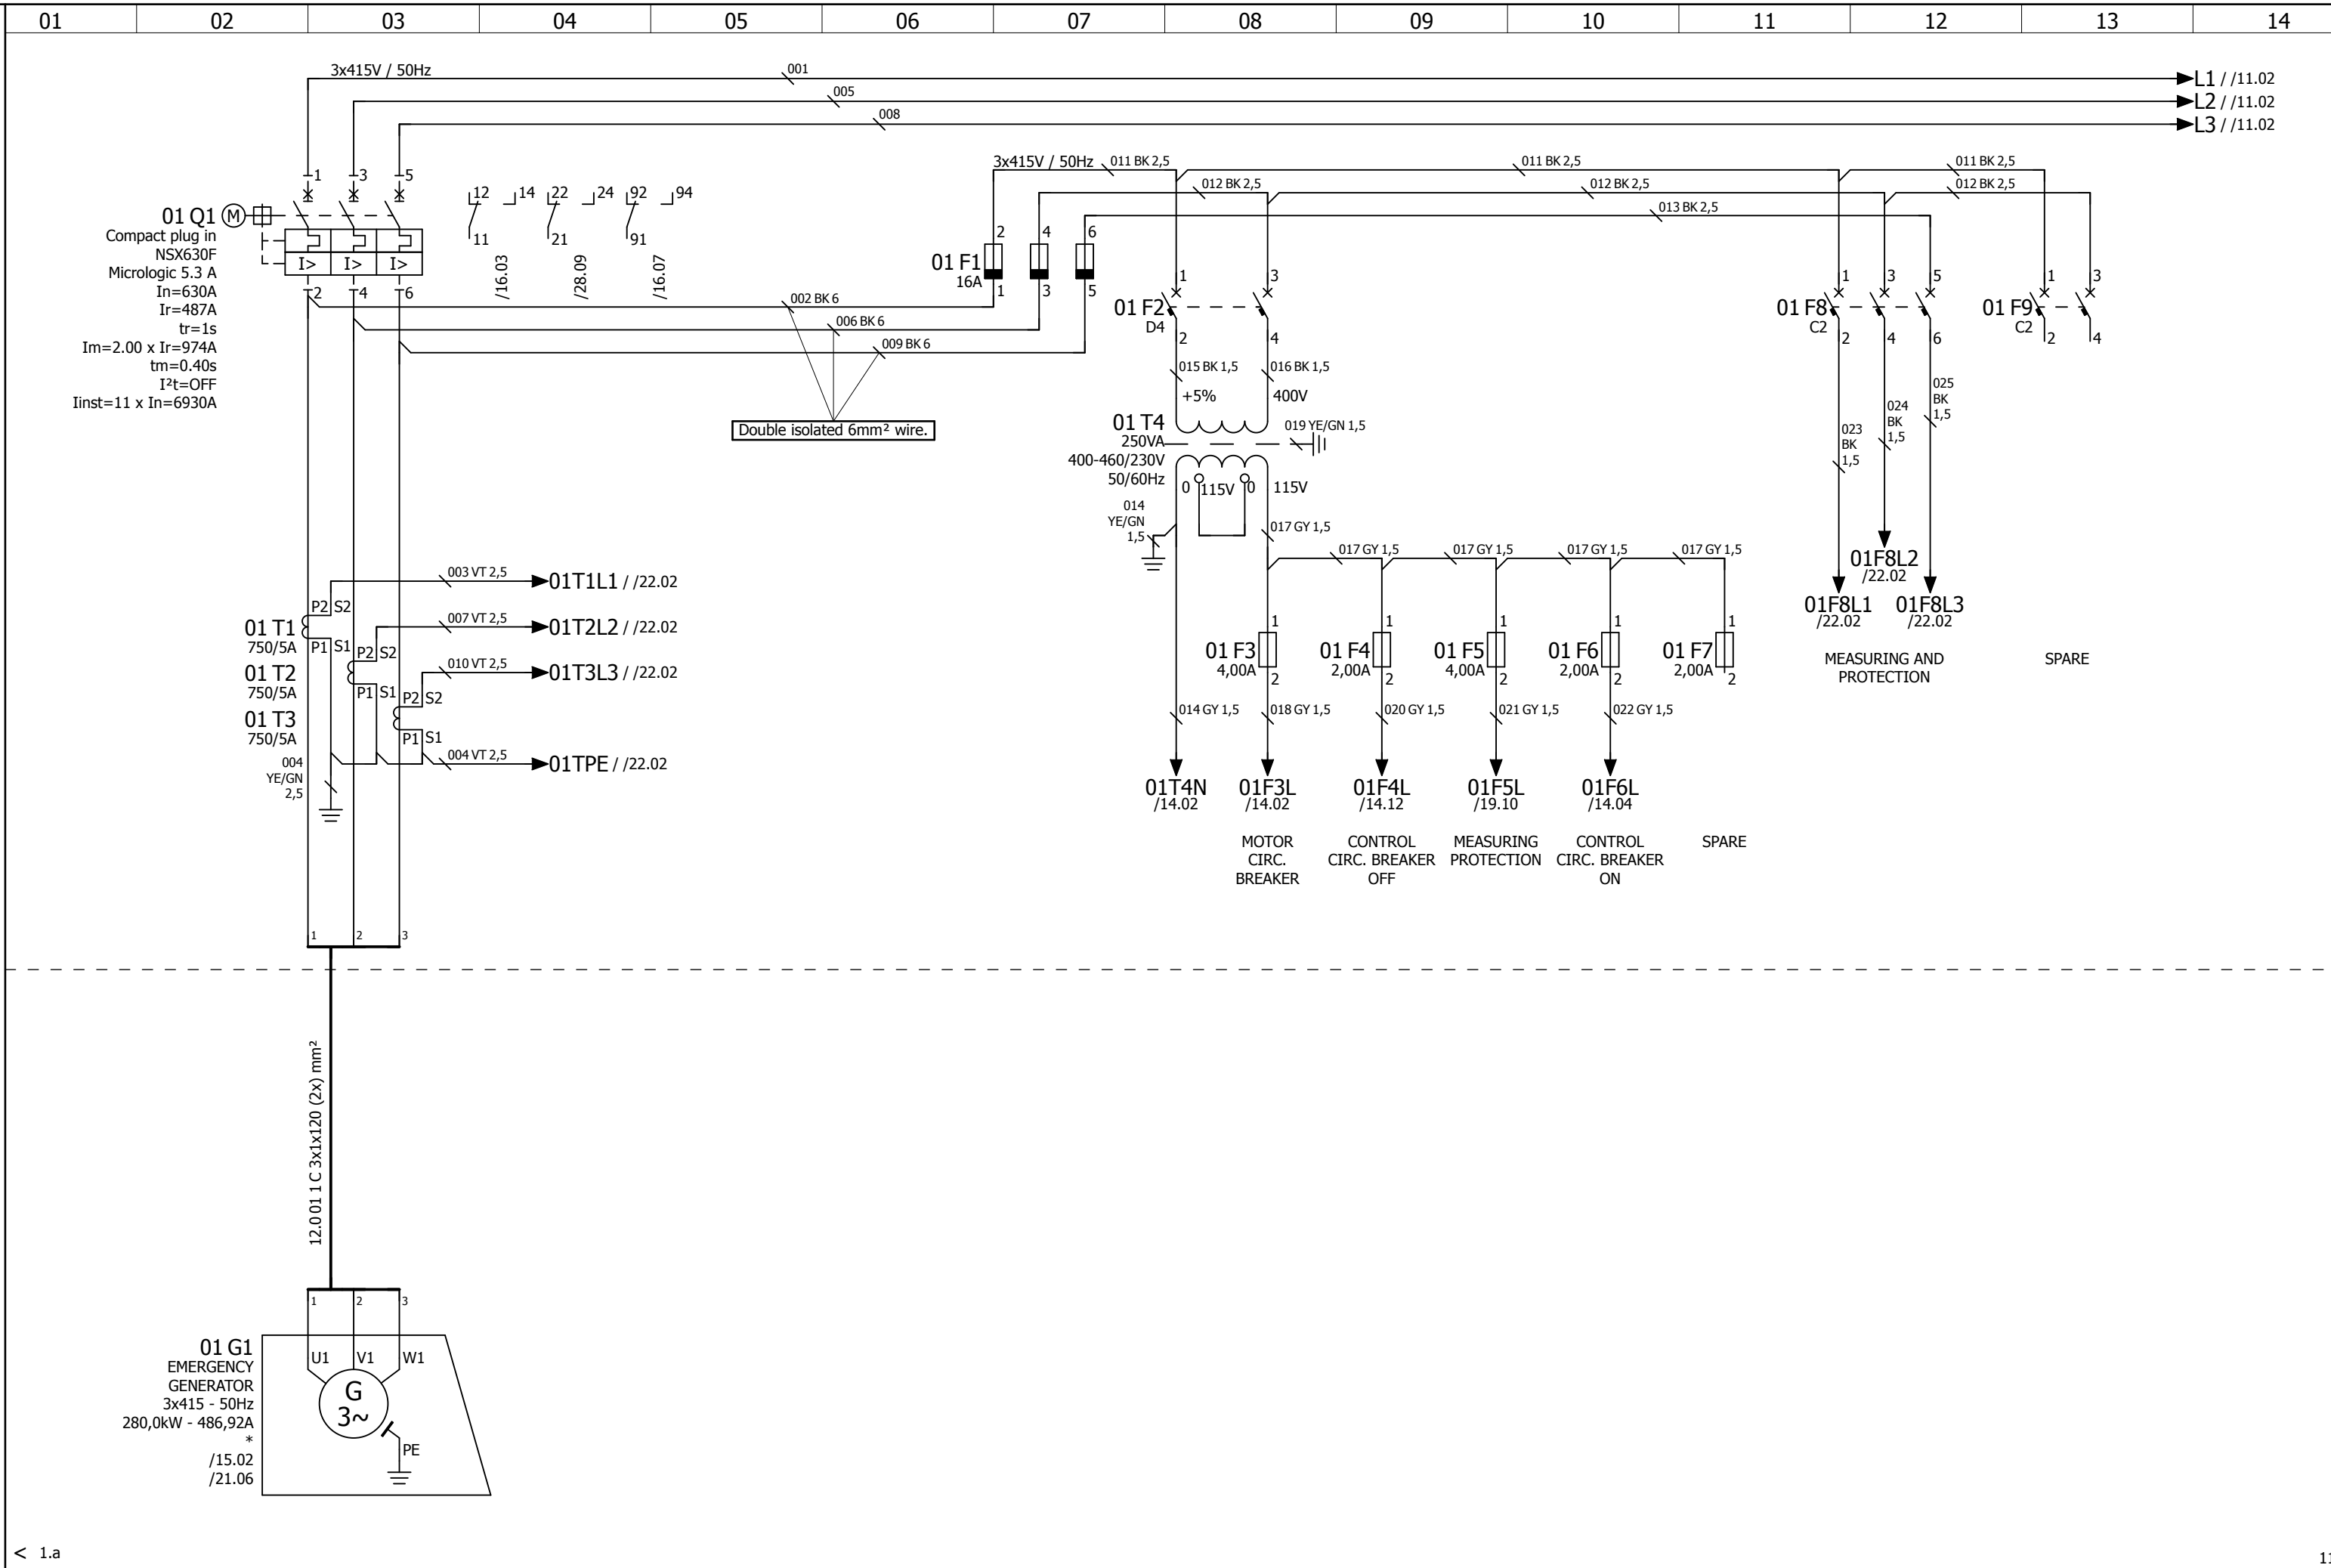

D	24-1-2011	PVR			* NO DELIVERY ALEWIJNSE			ALEWIJNSE MARINE B.V. ENERGIEWEG 46/C 6541 CX NIJMEGEN	IHC DREDGERS BV - TSHD5500 DCI-3 "12EP" EMERGENCY DISTRIBUTION BOARD 3X415V EMERGENCY GENERATOR MAIN CIRCUIT SECTION 1	Yard no : CO1266
M	5-12-2013	IEN	REV	1						Project : 23000143
STAT	AS BUILT									PANEL IP23
	05-12-2013	IEN	CHK							Page : 12EP -10

No part of this work may be copied, stored or published without prior written permission of Alewijnse Marine Systems.

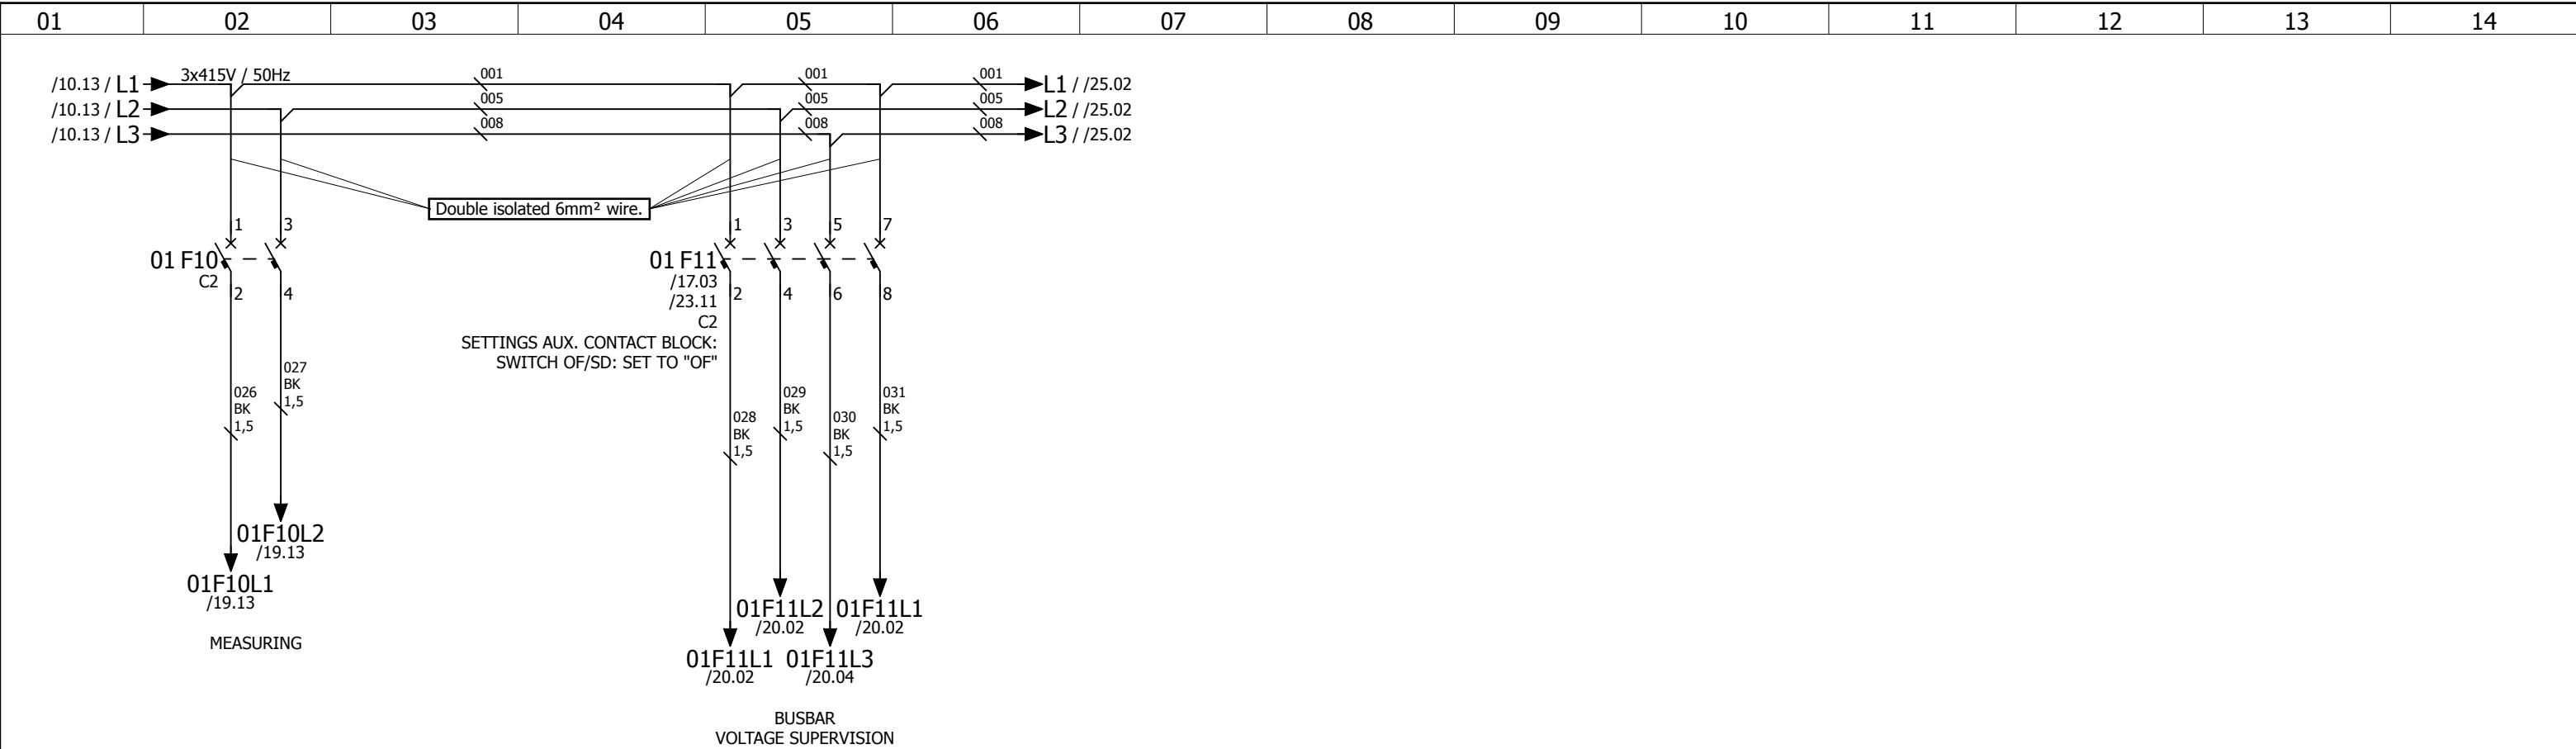

D	24-1-2011	PVR		* NO DELIVERY ALEWIJNSE PANEL IP23			ALEWIJNSE MARINE B.V. ENERGIEWEG 46/C 6541 CX NIJMEGEN	IHC DREDGERS BV - TSHD5500 DCI-3 "12EP" EMERGENCY DISTRIBUTION BOARD 3X415V EMERGENCY GENERATOR MAIN CIRCUIT SECTION 1	Yard no : CO1266	
M	5-12-2013	IEN	REV	1					Project : 23000143	
STAT	AS BUILT								Class : LROS/IRS	
	05-12-2013	IEN	CHK						Page : 12EP -11	

230V / 50Hz

01 F12 10A

07 F2 2,00A

08 F2 2,00A

22 F2 2,00A

26 F2 4,00A

28 F2 2,00A

30 F2 2,00A

01 X2 1 2

01F12L1 /15.02

01F12L2 /15.02

07F2L1 /43.02

07F2L2 /43.02

08F2L1 /52.02

08F2L2 /52.02

22F2L1 /73.02

22F2L2 /73.02

26F2L1 /43.09

26F2L2 /43.09

28F2L1 /87.02

28F2L2 /87.02

HEATER EMERGENCY GENERATOR

HEATER S2 - ENGINE ROOM SUPPLY FAN PS

HEATER S4 - ENGINE ROOM SUPPLY FAN SB REVERSIBLE

HEATER FIF1/ BALLAST/ EMERGENCY BILGE PUMP

FIRE DAMPERS S2 & S4 ENGINE ROOM

HEATER FRESH WATER PUMP - CCWS LT 3 - STANDBY

SPARE

The diagram illustrates the 24VDC power supply system for the emergency generator. It shows the distribution of 24VDC power from a main source to various components, including a transformer, diodes, fuses, and terminal blocks. The system is divided into two main sections: a power distribution section on the left and a component connection section on the right.

Power Distribution Section (Left):

- 24VDC Input:** The main power source at the top.
- 01 U1 /23.09 ==22A2/12.09 230VAC//18-29,5VDC 10A:** A transformer with a primary winding connected to the 24VDC input and a secondary winding connected to the 24VDC output.
- 01 D3, 01 D4:** Diodes connected to the transformer's secondary winding.
- 01 K1 24VDC 24VDC ON:** A diode bridge rectifier.
- 01 X2, 01 X3:** Terminal blocks for the power distribution.

Component Connection Section (Right):


- 01 D1, 01 D2:** Diodes connected to the 24VDC input.
- 01 F13, 01 F14, 01 F15, 01 F16:** Fuses connected to the 24VDC input.
- EMERGENCY GENERATOR CONTROL, EMERGENCY GENERATOR SIGNALING, EMERGENCY GENERATOR PROTECTION, EMERGENCY GENERATOR MEASURING:** The components receiving power from the fuses.

The diagram includes numerous component labels, wire numbers, and terminal connections, providing a detailed view of the power supply system's wiring and component placement.

37.0 010 C 2x2,5 mm²
EMERGENCY ENGINE POWER SUPPLY
24V PANEL


14 7
12 7 11 /23.09
24 7
22 7 21
34 7
32 7 31
44 7
42 7 41

No part of this work may be copied, stored or published without prior written permission of Alewijnse Marine Systems.

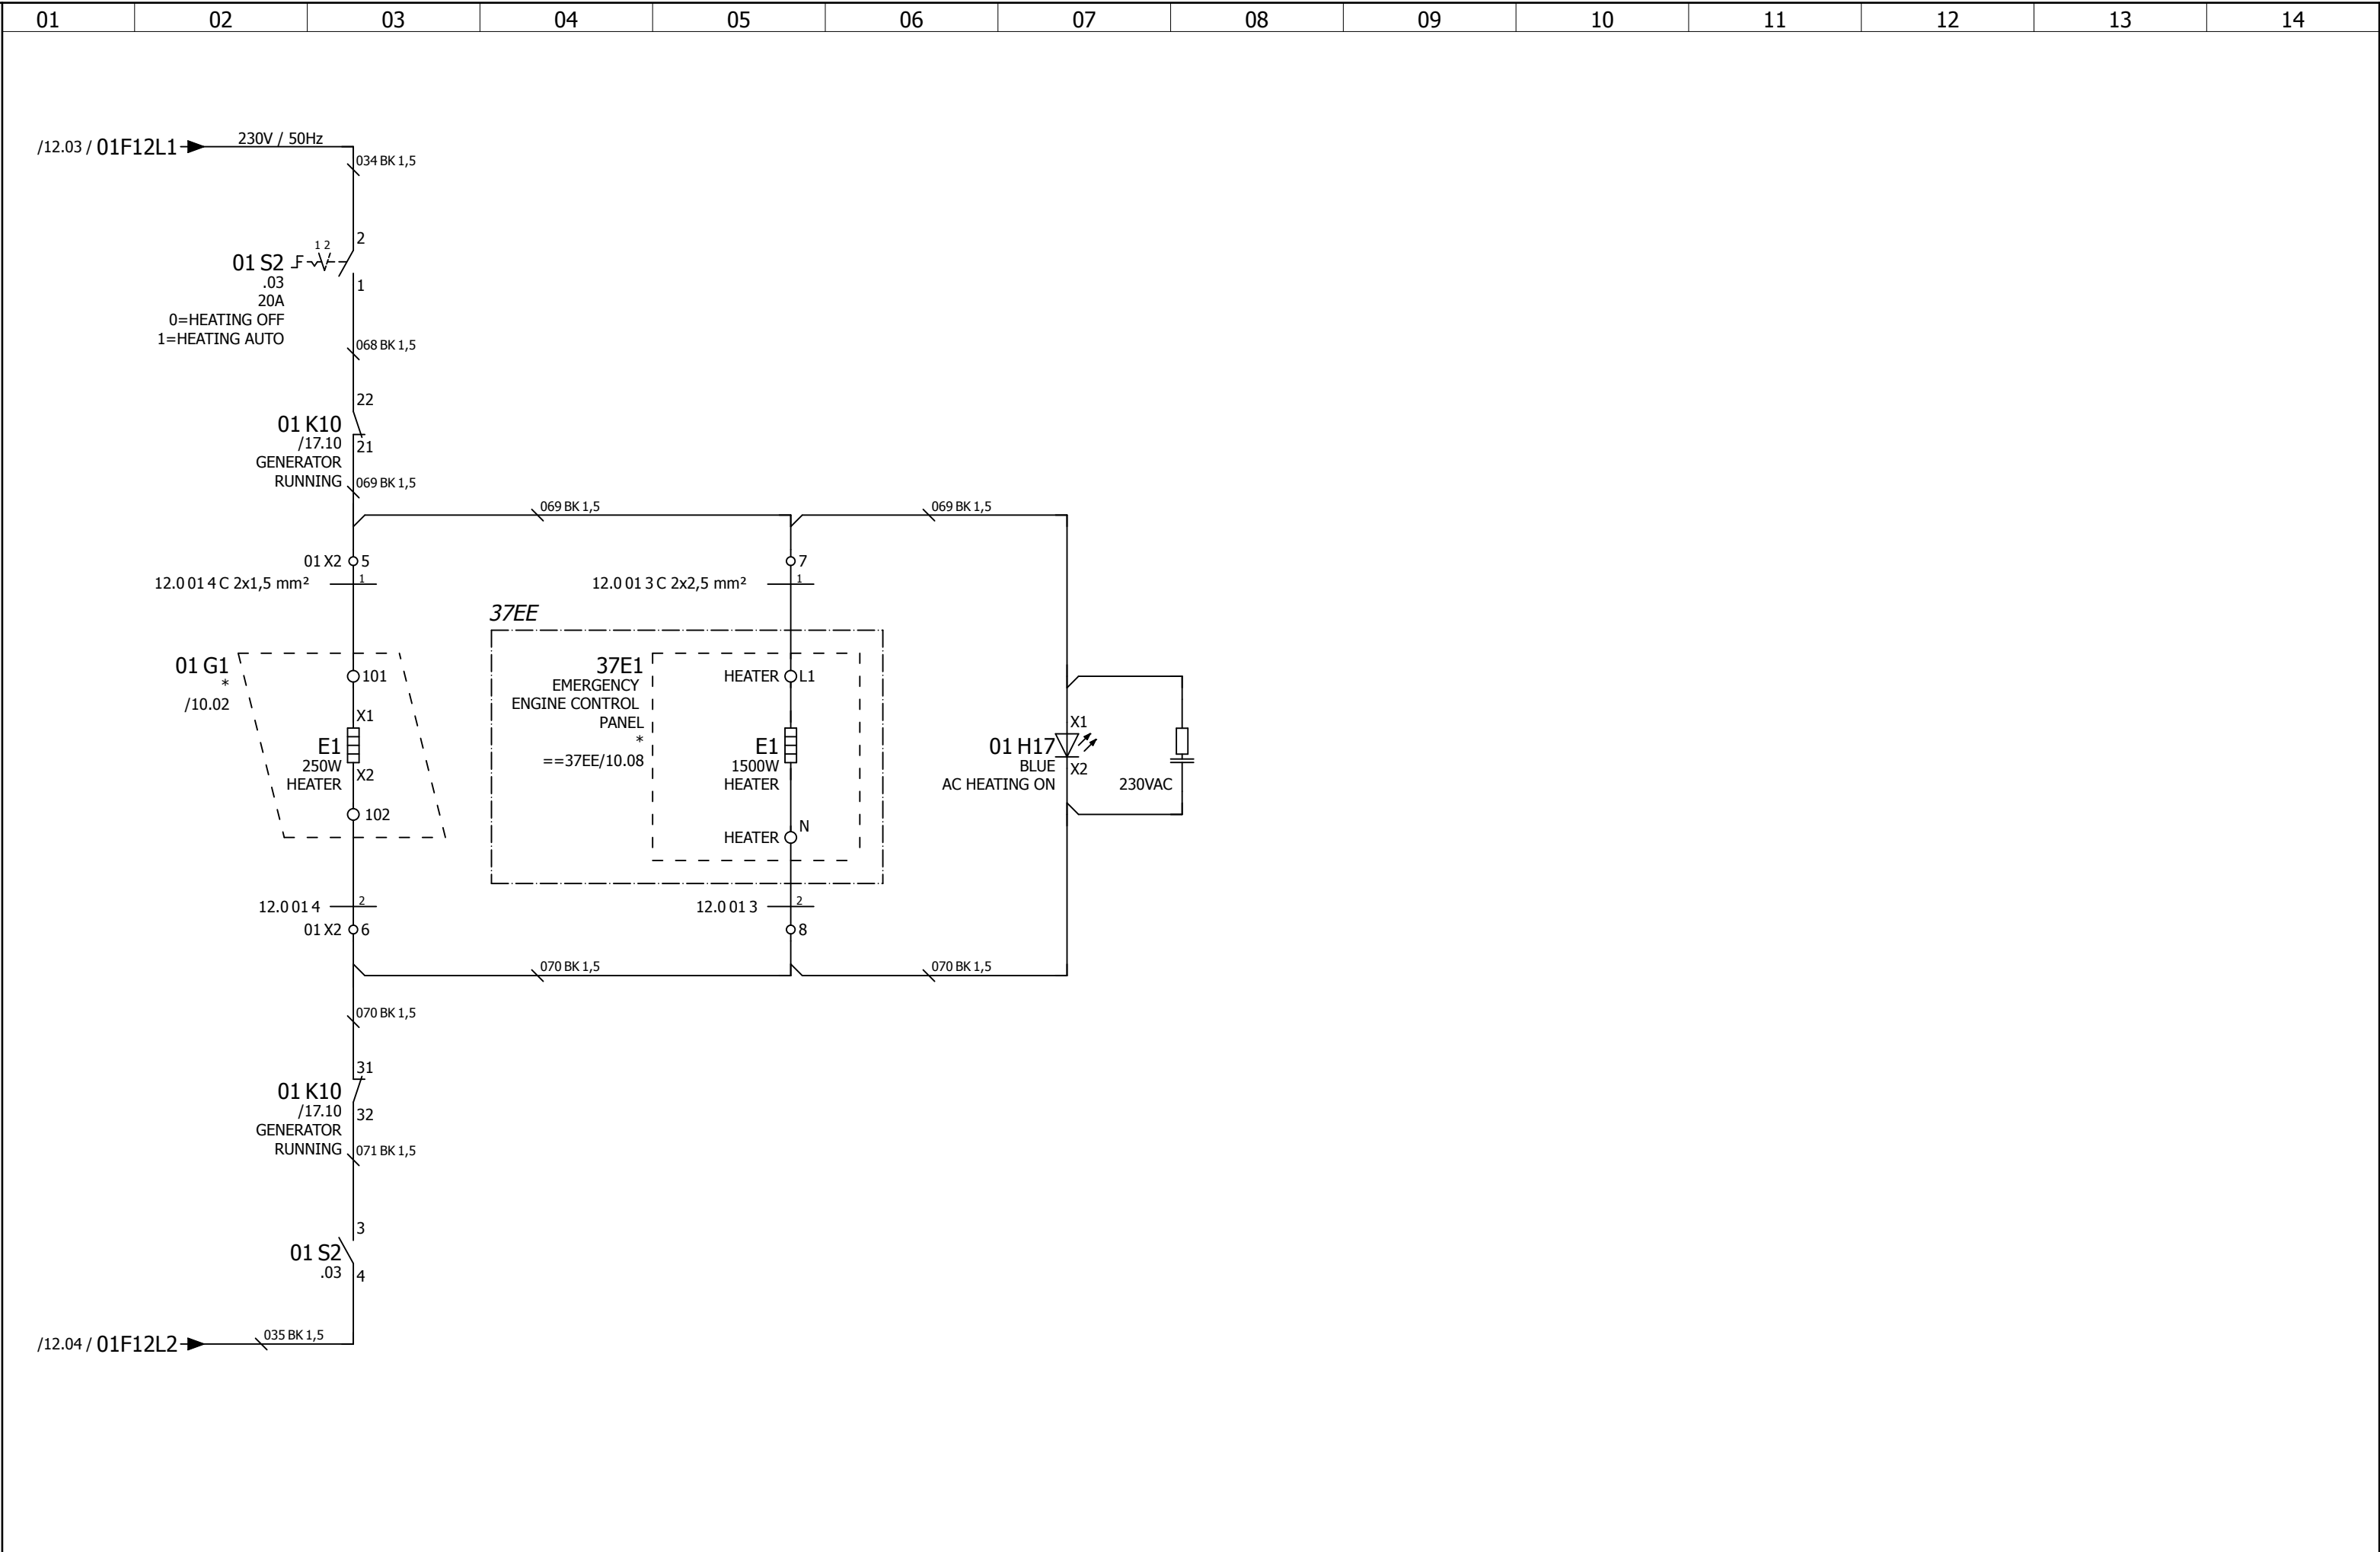


D	24-1-2011	PVR			* NO DELIVERY ALEWIJNSE			ALEWIJNSE MARINE B.V. ENERGIEWEG 46/C 6541 CX NIJMEGEN	IHC DREDGERS BV - TSHD5500 DCI-3 "12EP" EMERGENCY DISTRIBUTION BOARD 3X415V EMERGENCY GENERATOR CONTROL CIRCUIT HEATER SECTION 1	Yard no : CO1266	
M	5-12-2013	IEN	REV	1						Project : 23000143	
STAT	AS BUILT				PANEL IP23					Class : LROS/IRS	
	05-12-2013	IEN	CHK							Page : 12EP -15	

No part of this work may be copied, stored or published without prior written permission of Alewijnse Marine Systems.

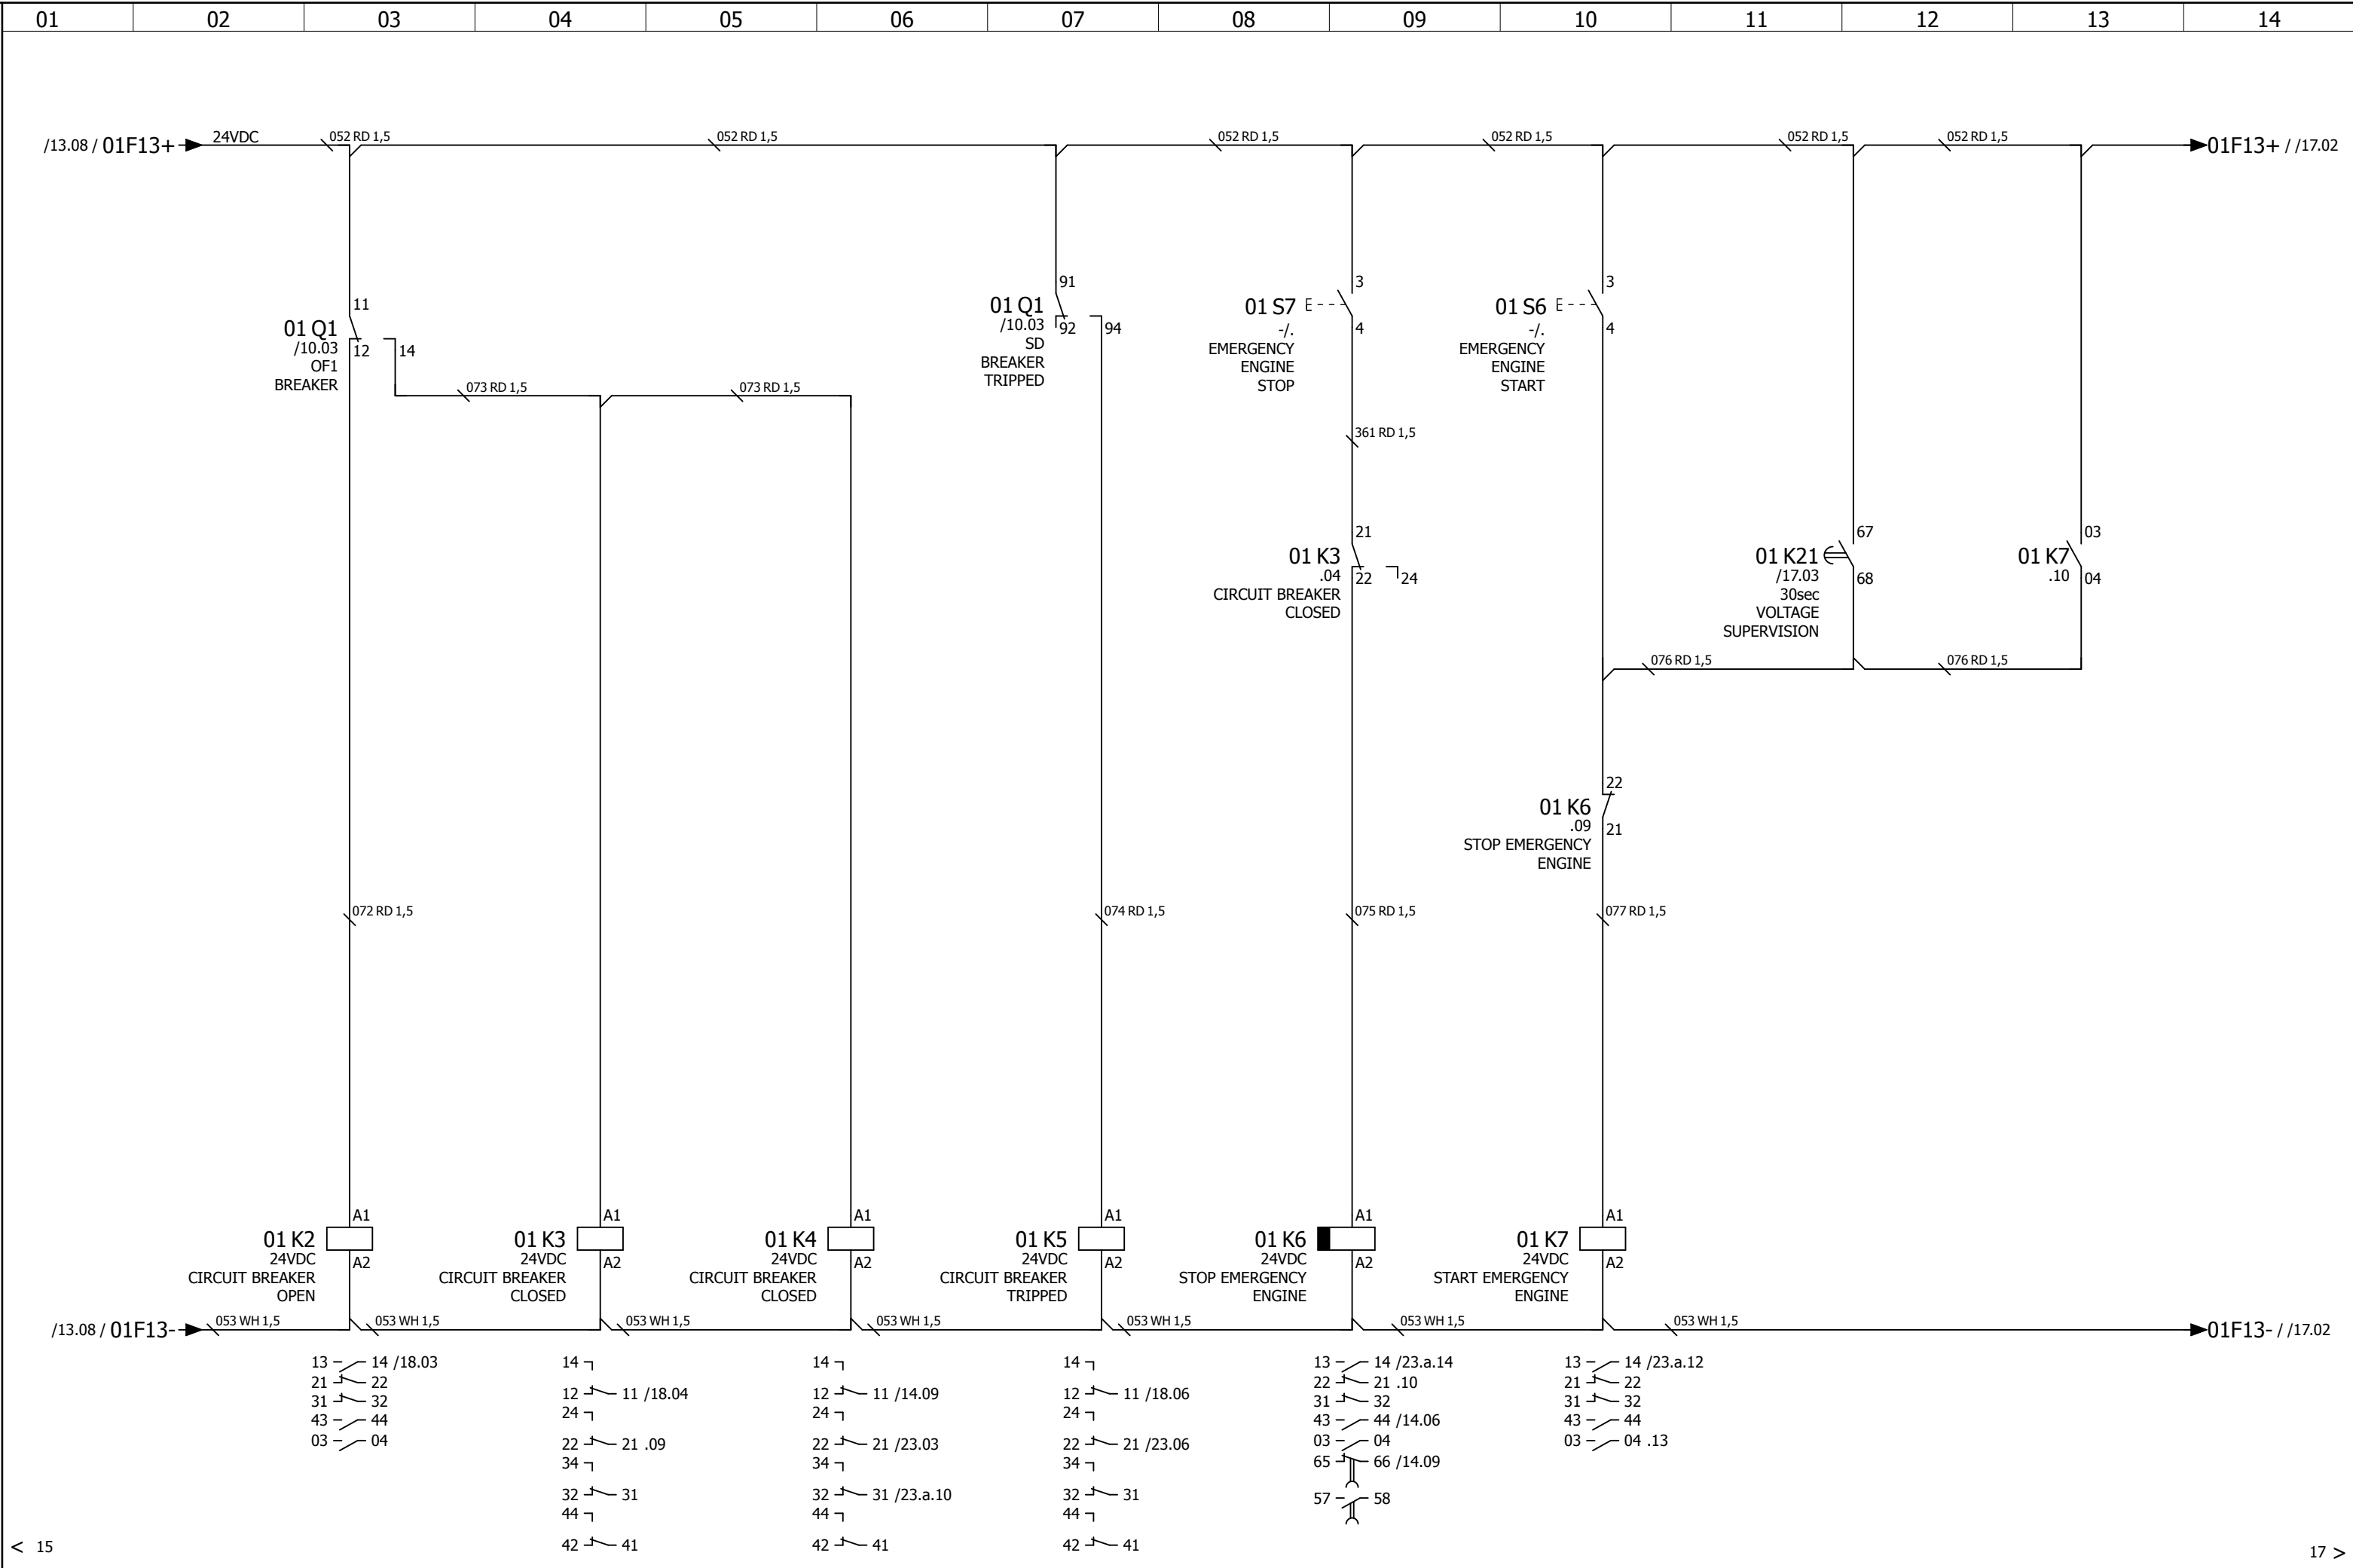


D	24-1-2011	PVR			* NO DELIVERY ALEWIJNSE			ALEWIJNSE MARINE B.V. ENERGIEWEG 46/C 6541 CX NIJMEGEN	IHC DREDGERS BV - TSHD5500 DCI-3 "12EP" EMERGENCY DISTRIBUTION BOARD 3X415V EMERGENCY GENERATOR CONTROL CIRCUIT SECTION 1	Yard no : CO1266	
M	5-12-2013	IEN	REV	1						Project : 23000143	
STAT	AS BUILT				PANEL IP23					Class : LROS/IRS	
	05-12-2013	IEN	CHK							Page : 12EP -16	


No part of this work may be copied, stored or published without prior written permission of Alewijnse Marine Systems.

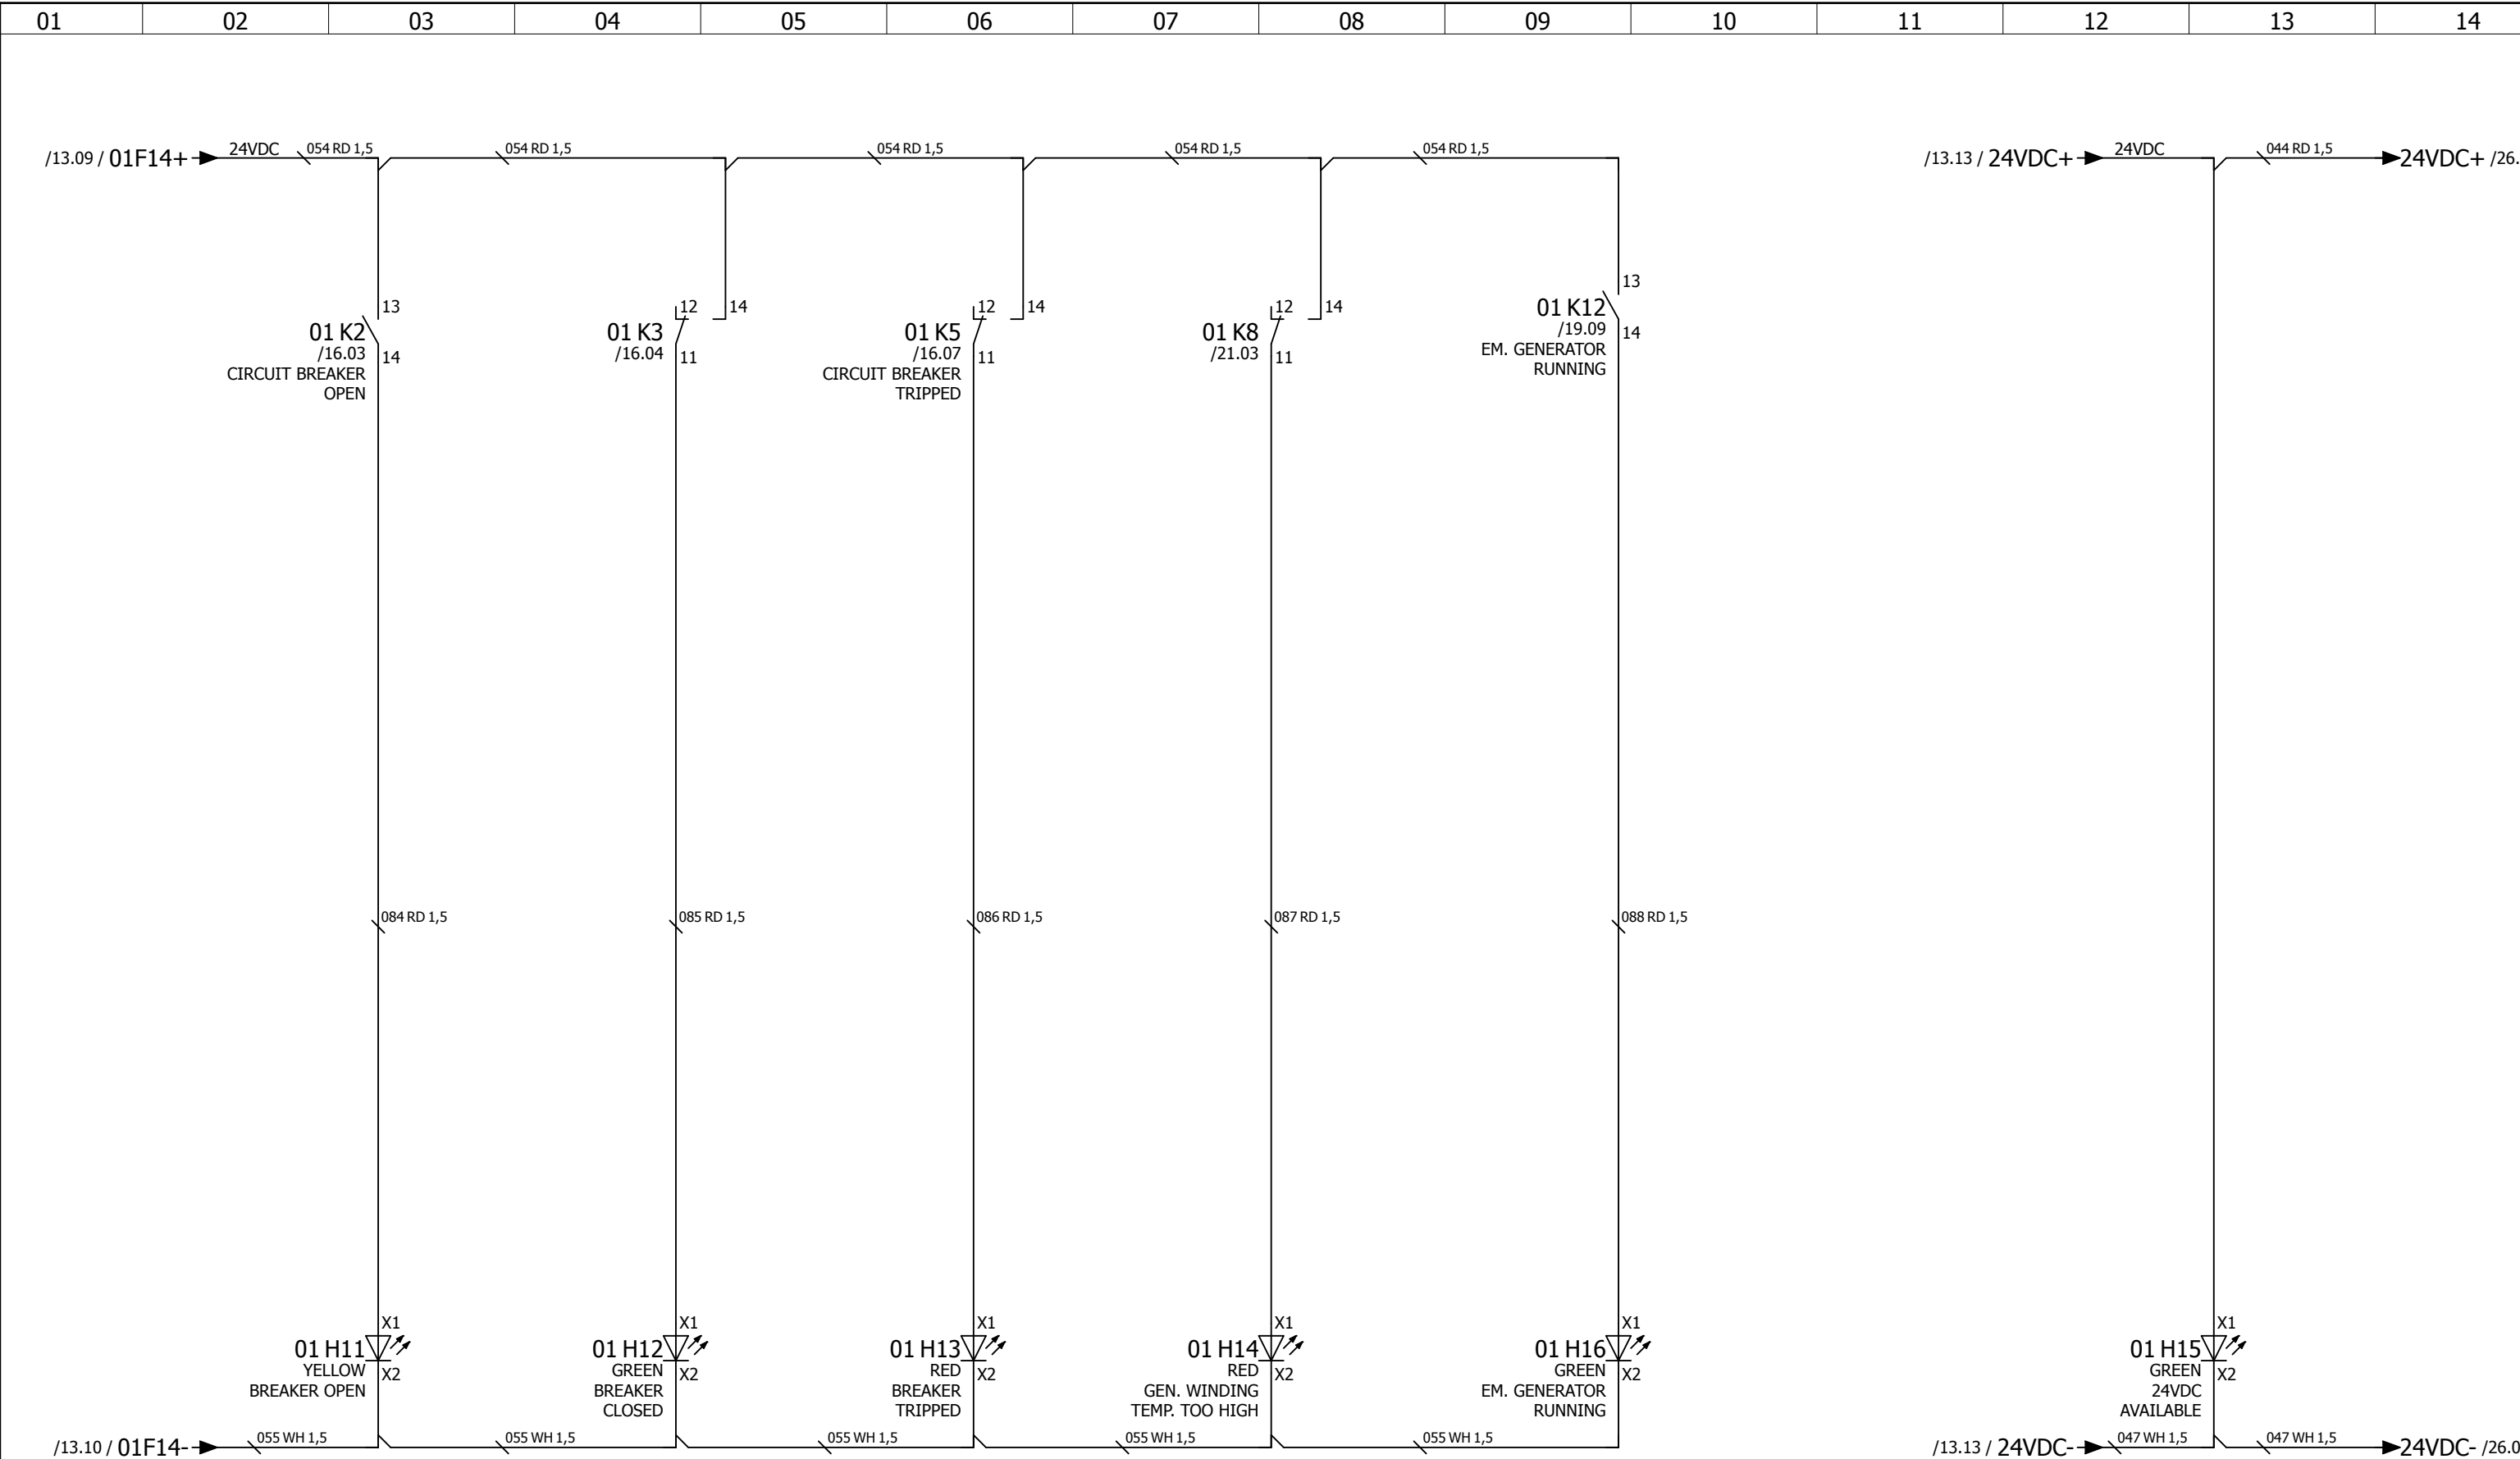

D	24-1-2011	PVR			* NO DELIVERY ALEWIJNSE			ALEWIJNSE MARINE B.V. ENERGIEWEG 46/C 6541 CX NIJMEGEN	IHC DREDGERS BV - TSHD5500 DCI-3 "12EP" EMERGENCY DISTRIBUTION BOARD 3X415V EMERGENCY GENERATOR SIGNALING SECTION 1	Yard no : CO1266				
M	5-12-2013	IEN	REV	1						Project : 23000143				
STAT	AS BUILT				PANEL IP23					Class : LROS/IRS				
	05-12-2013	IEN	CHK							Page : 12EP -18				

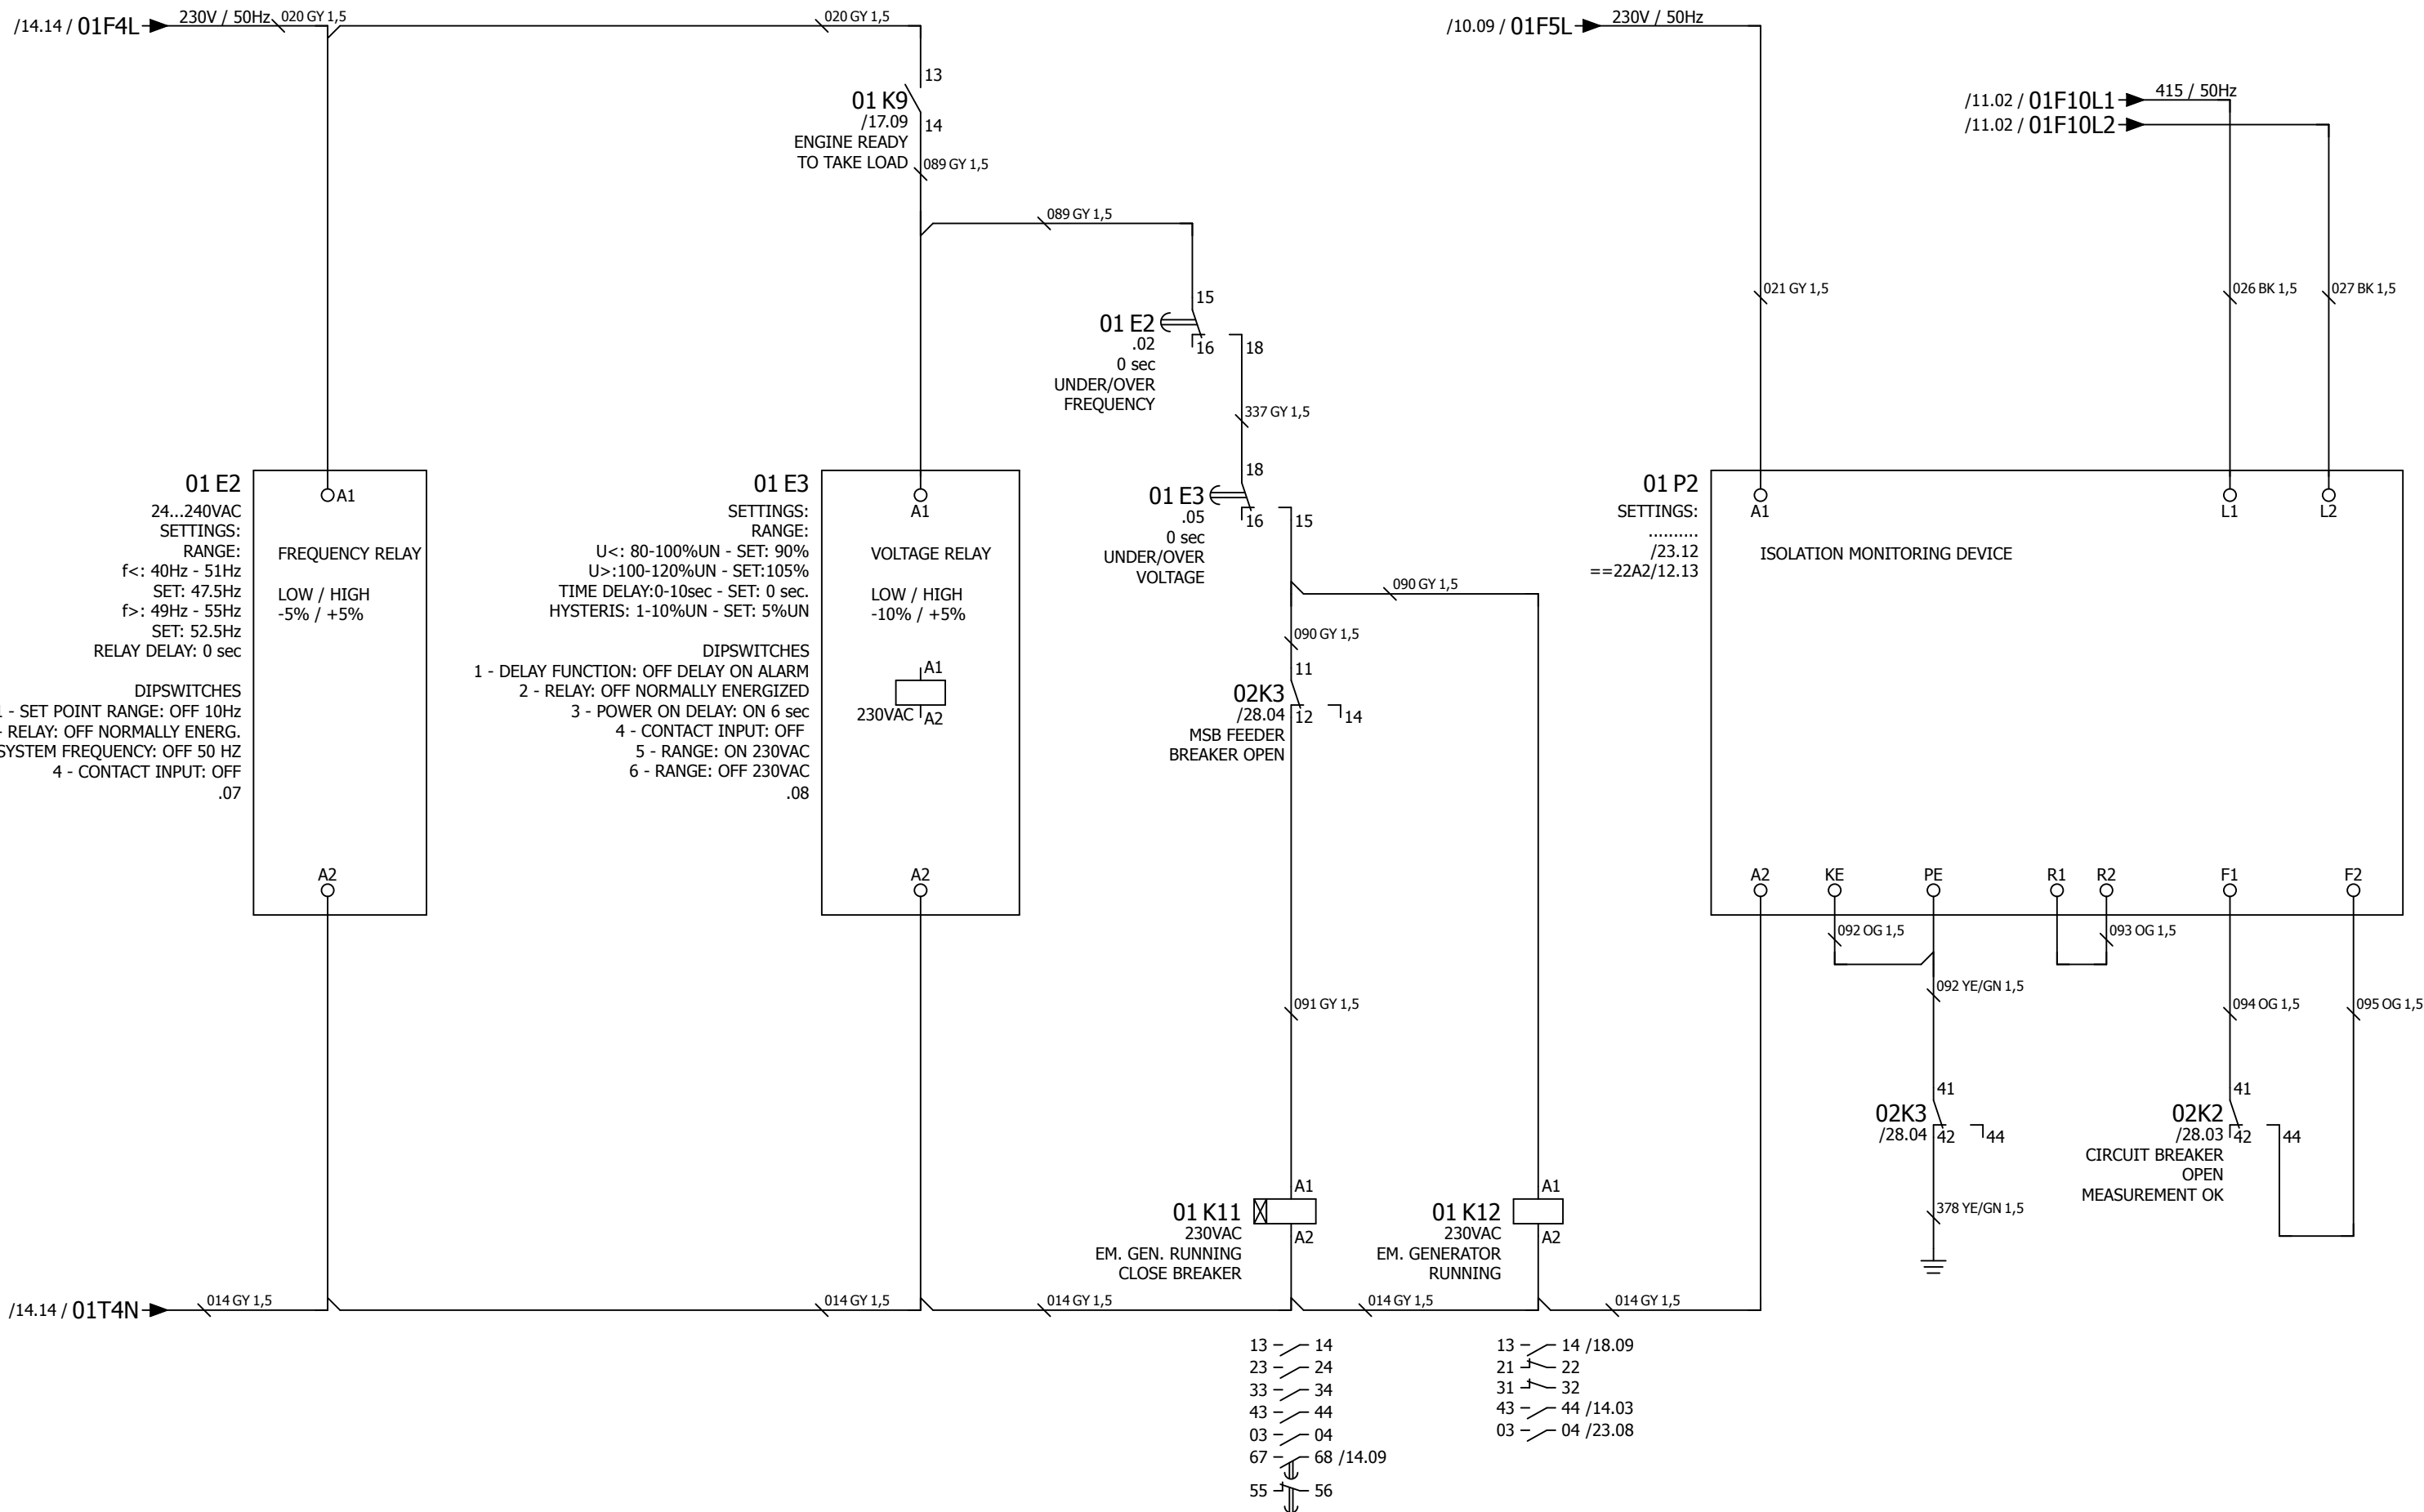


No part of this work may be copied, stored or published without prior written permission of Alewijnse Marine Systems.

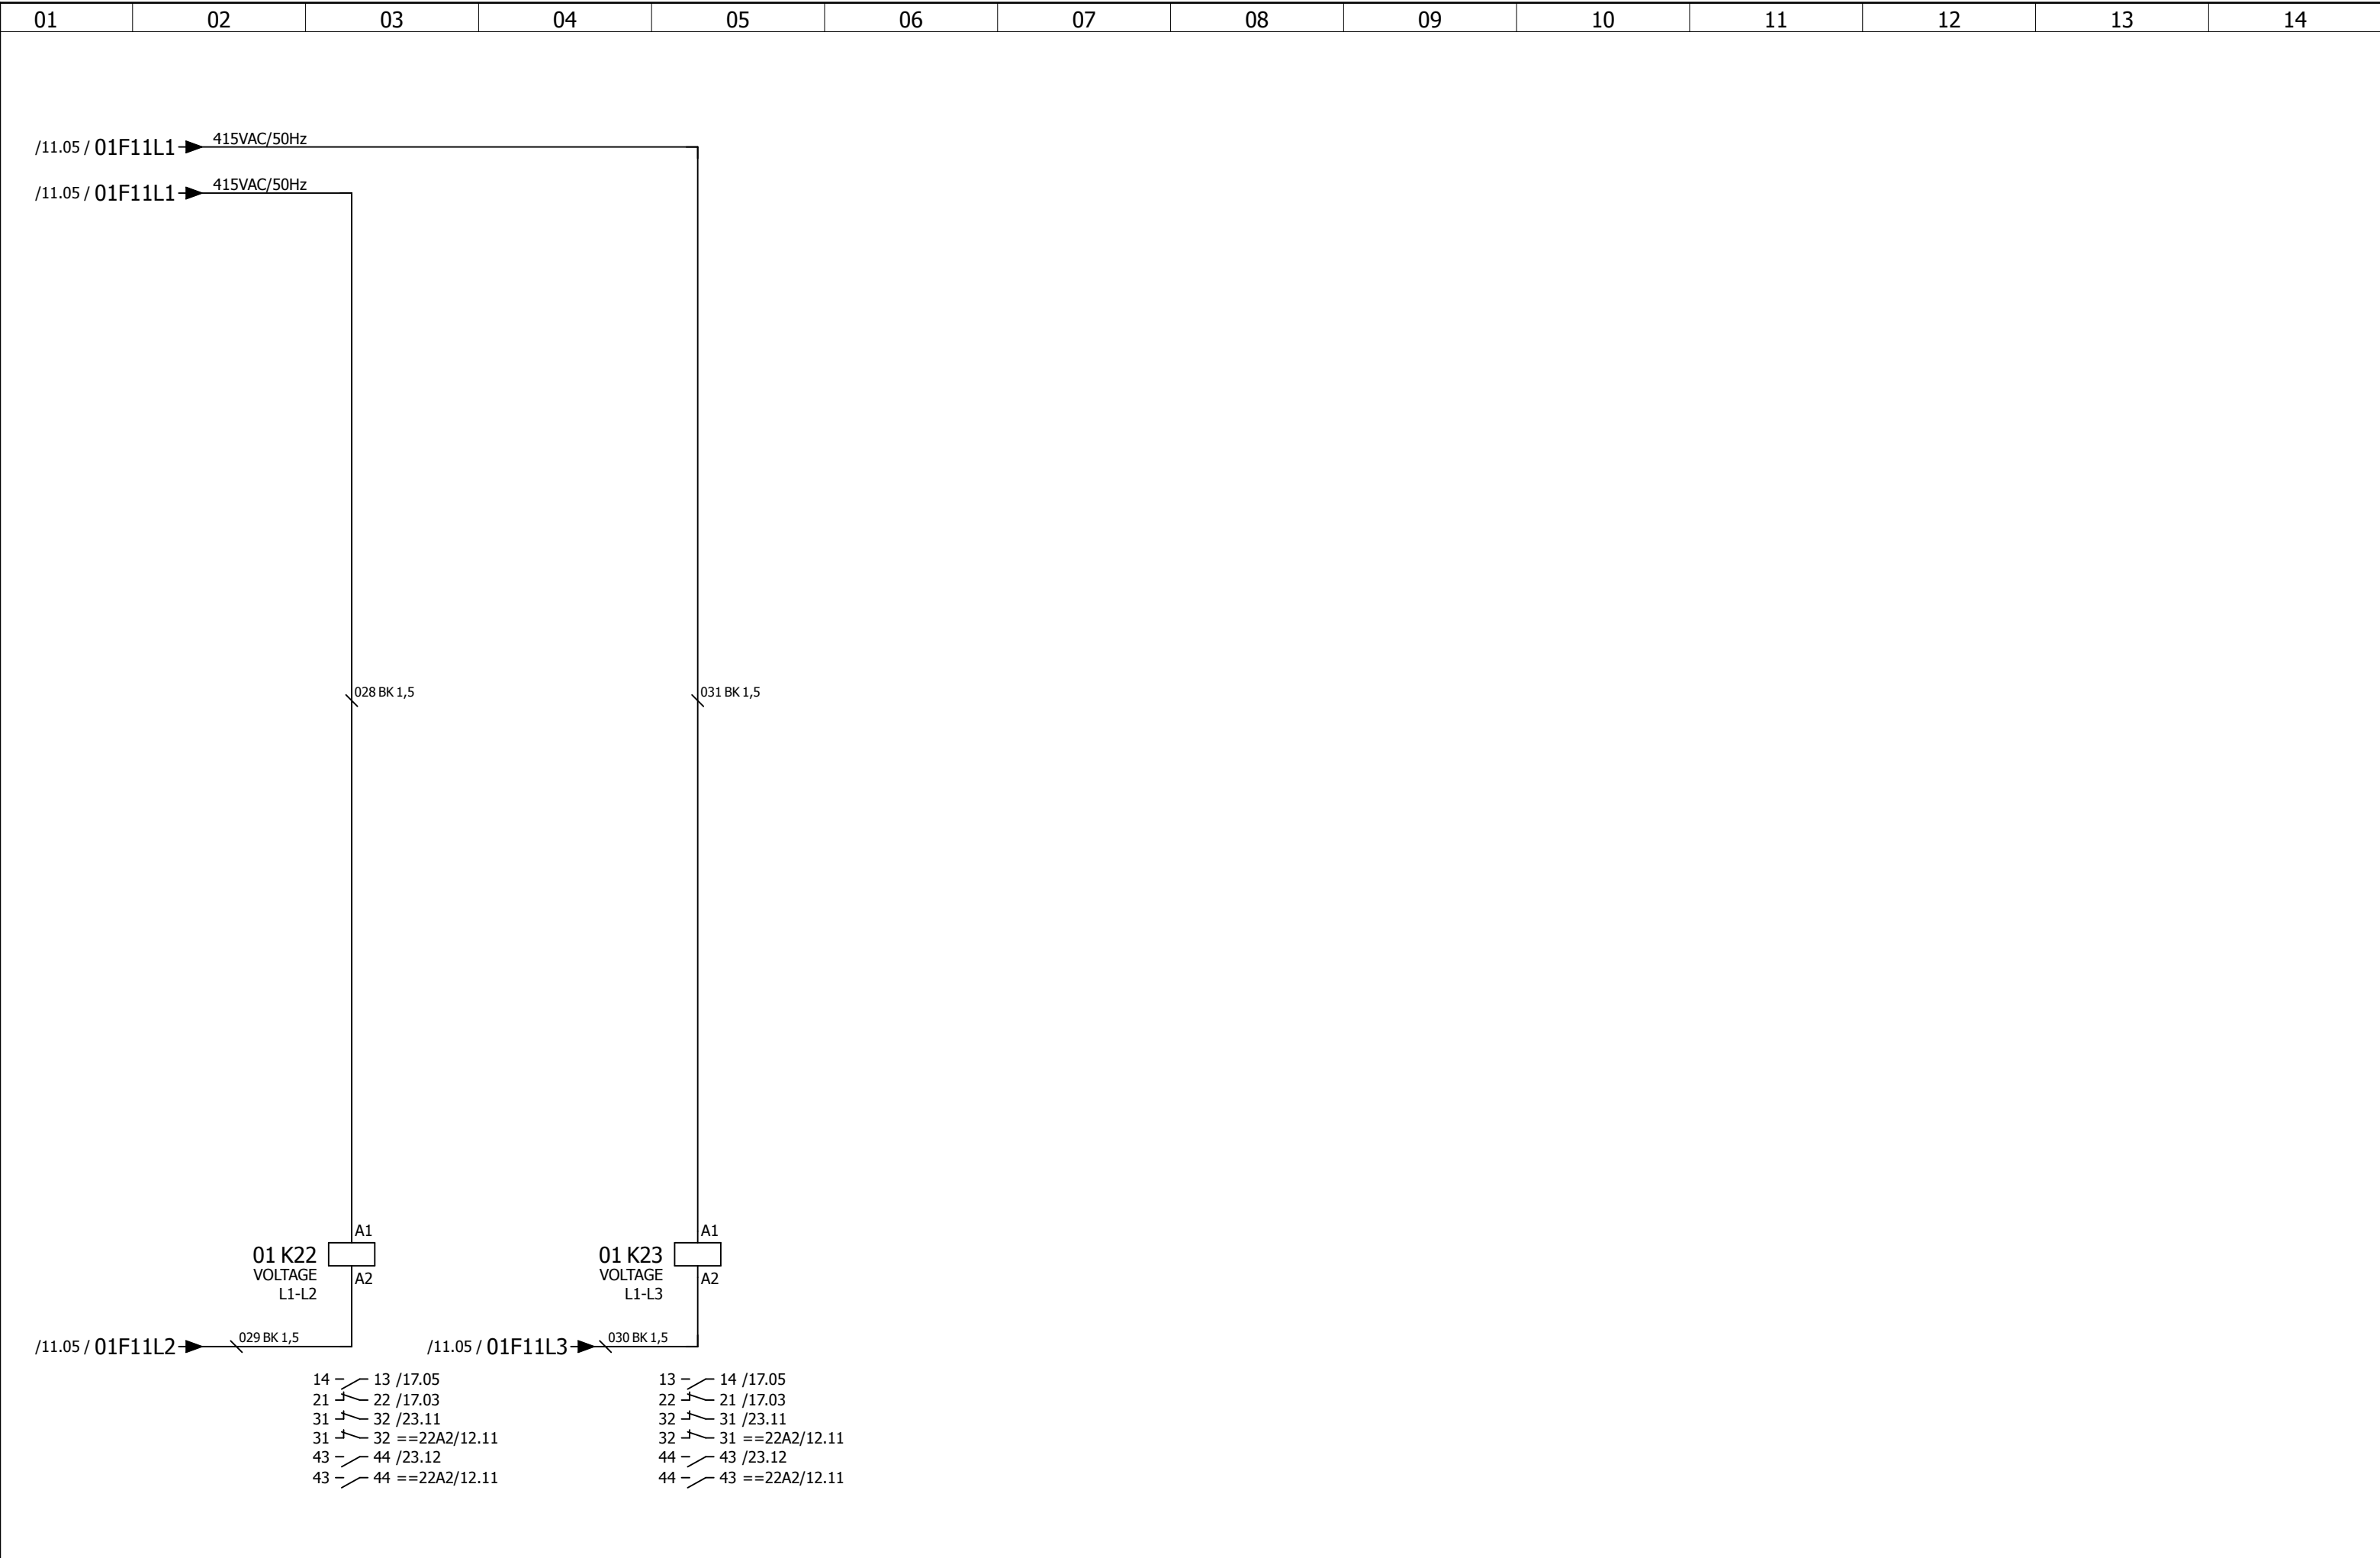


STAT	D	24-1-2011	PVR		* NO DELIVERY ALEWIJNSE			ALEWIJNSE MARINE B.V. ENERGIEWEG 46/C 6541 CX NIJMEGEN	IHC DREDGERS BV - TSHD5500 DCI-3 "12EP" EMERGENCY DISTRIBUTION BOARD 3X415V EMERGENCY GENERATOR MEASURING SECTION 1	Yard no : CO1266
	M	5-12-2013	IEN	REV						1
	AS BUILT					PANEL IP23				Class : LROS/IRS
		05-12-2013	IEN	CHK						Page : 12EP -20

No part of this work may be copied, stored or published without prior written permission of Alewijnse Marine Systems.

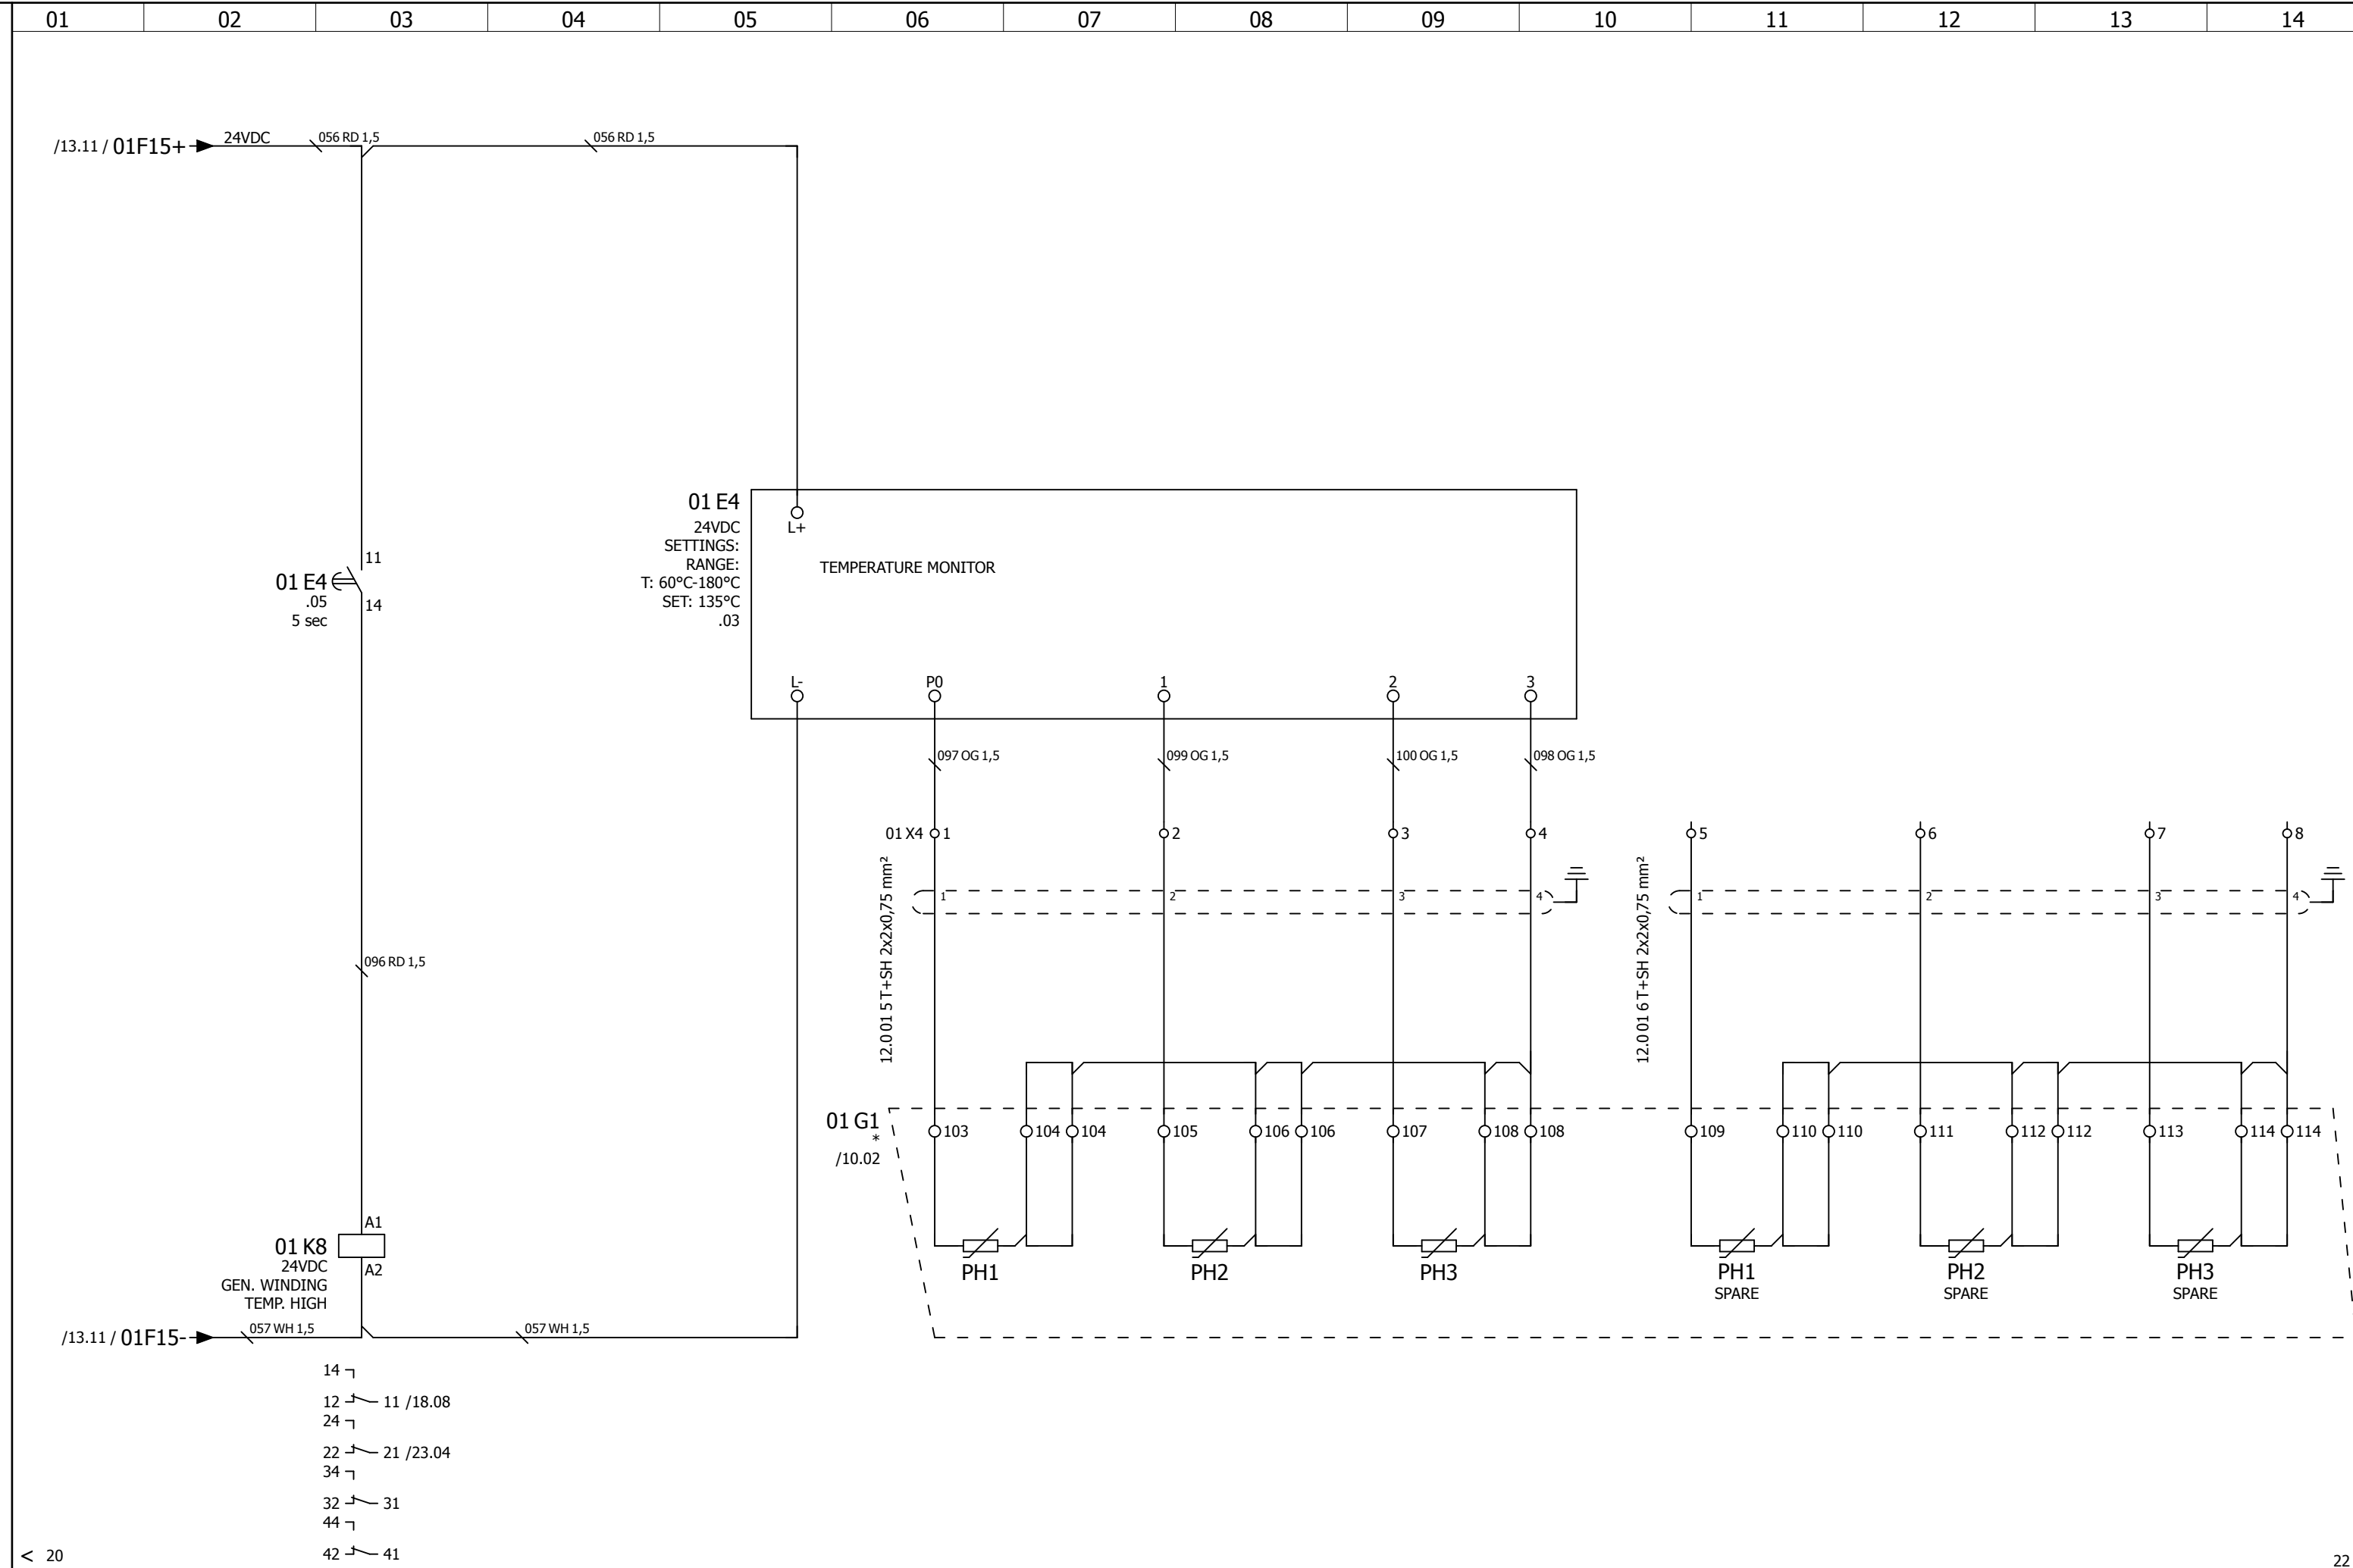


D	24-1-2011	PVR			* NO DELIVERY ALEWIJNSE			ALEWIJNSE MARINE B.V. ENERGIEWEG 46/C 6541 CX NIJMEGEN	IHC DREDGERS BV - TSHD5500 DCI-3 "12EP" EMERGENCY DISTRIBUTION BOARD 3X415V EMERGENCY GENERATOR MEASURING SECTION 1	Yard no : CO1266
M	5-12-2013	IEN	REV	1						Project : 23000143
STAT	AS BUILT				PANEL IP23					Class : LROS/IRS
	05-12-2013	IEN	CHK							Page : 12EP -21

No part of this work may be copied, stored or published without prior written permission of Alewijnse Marine Systems.

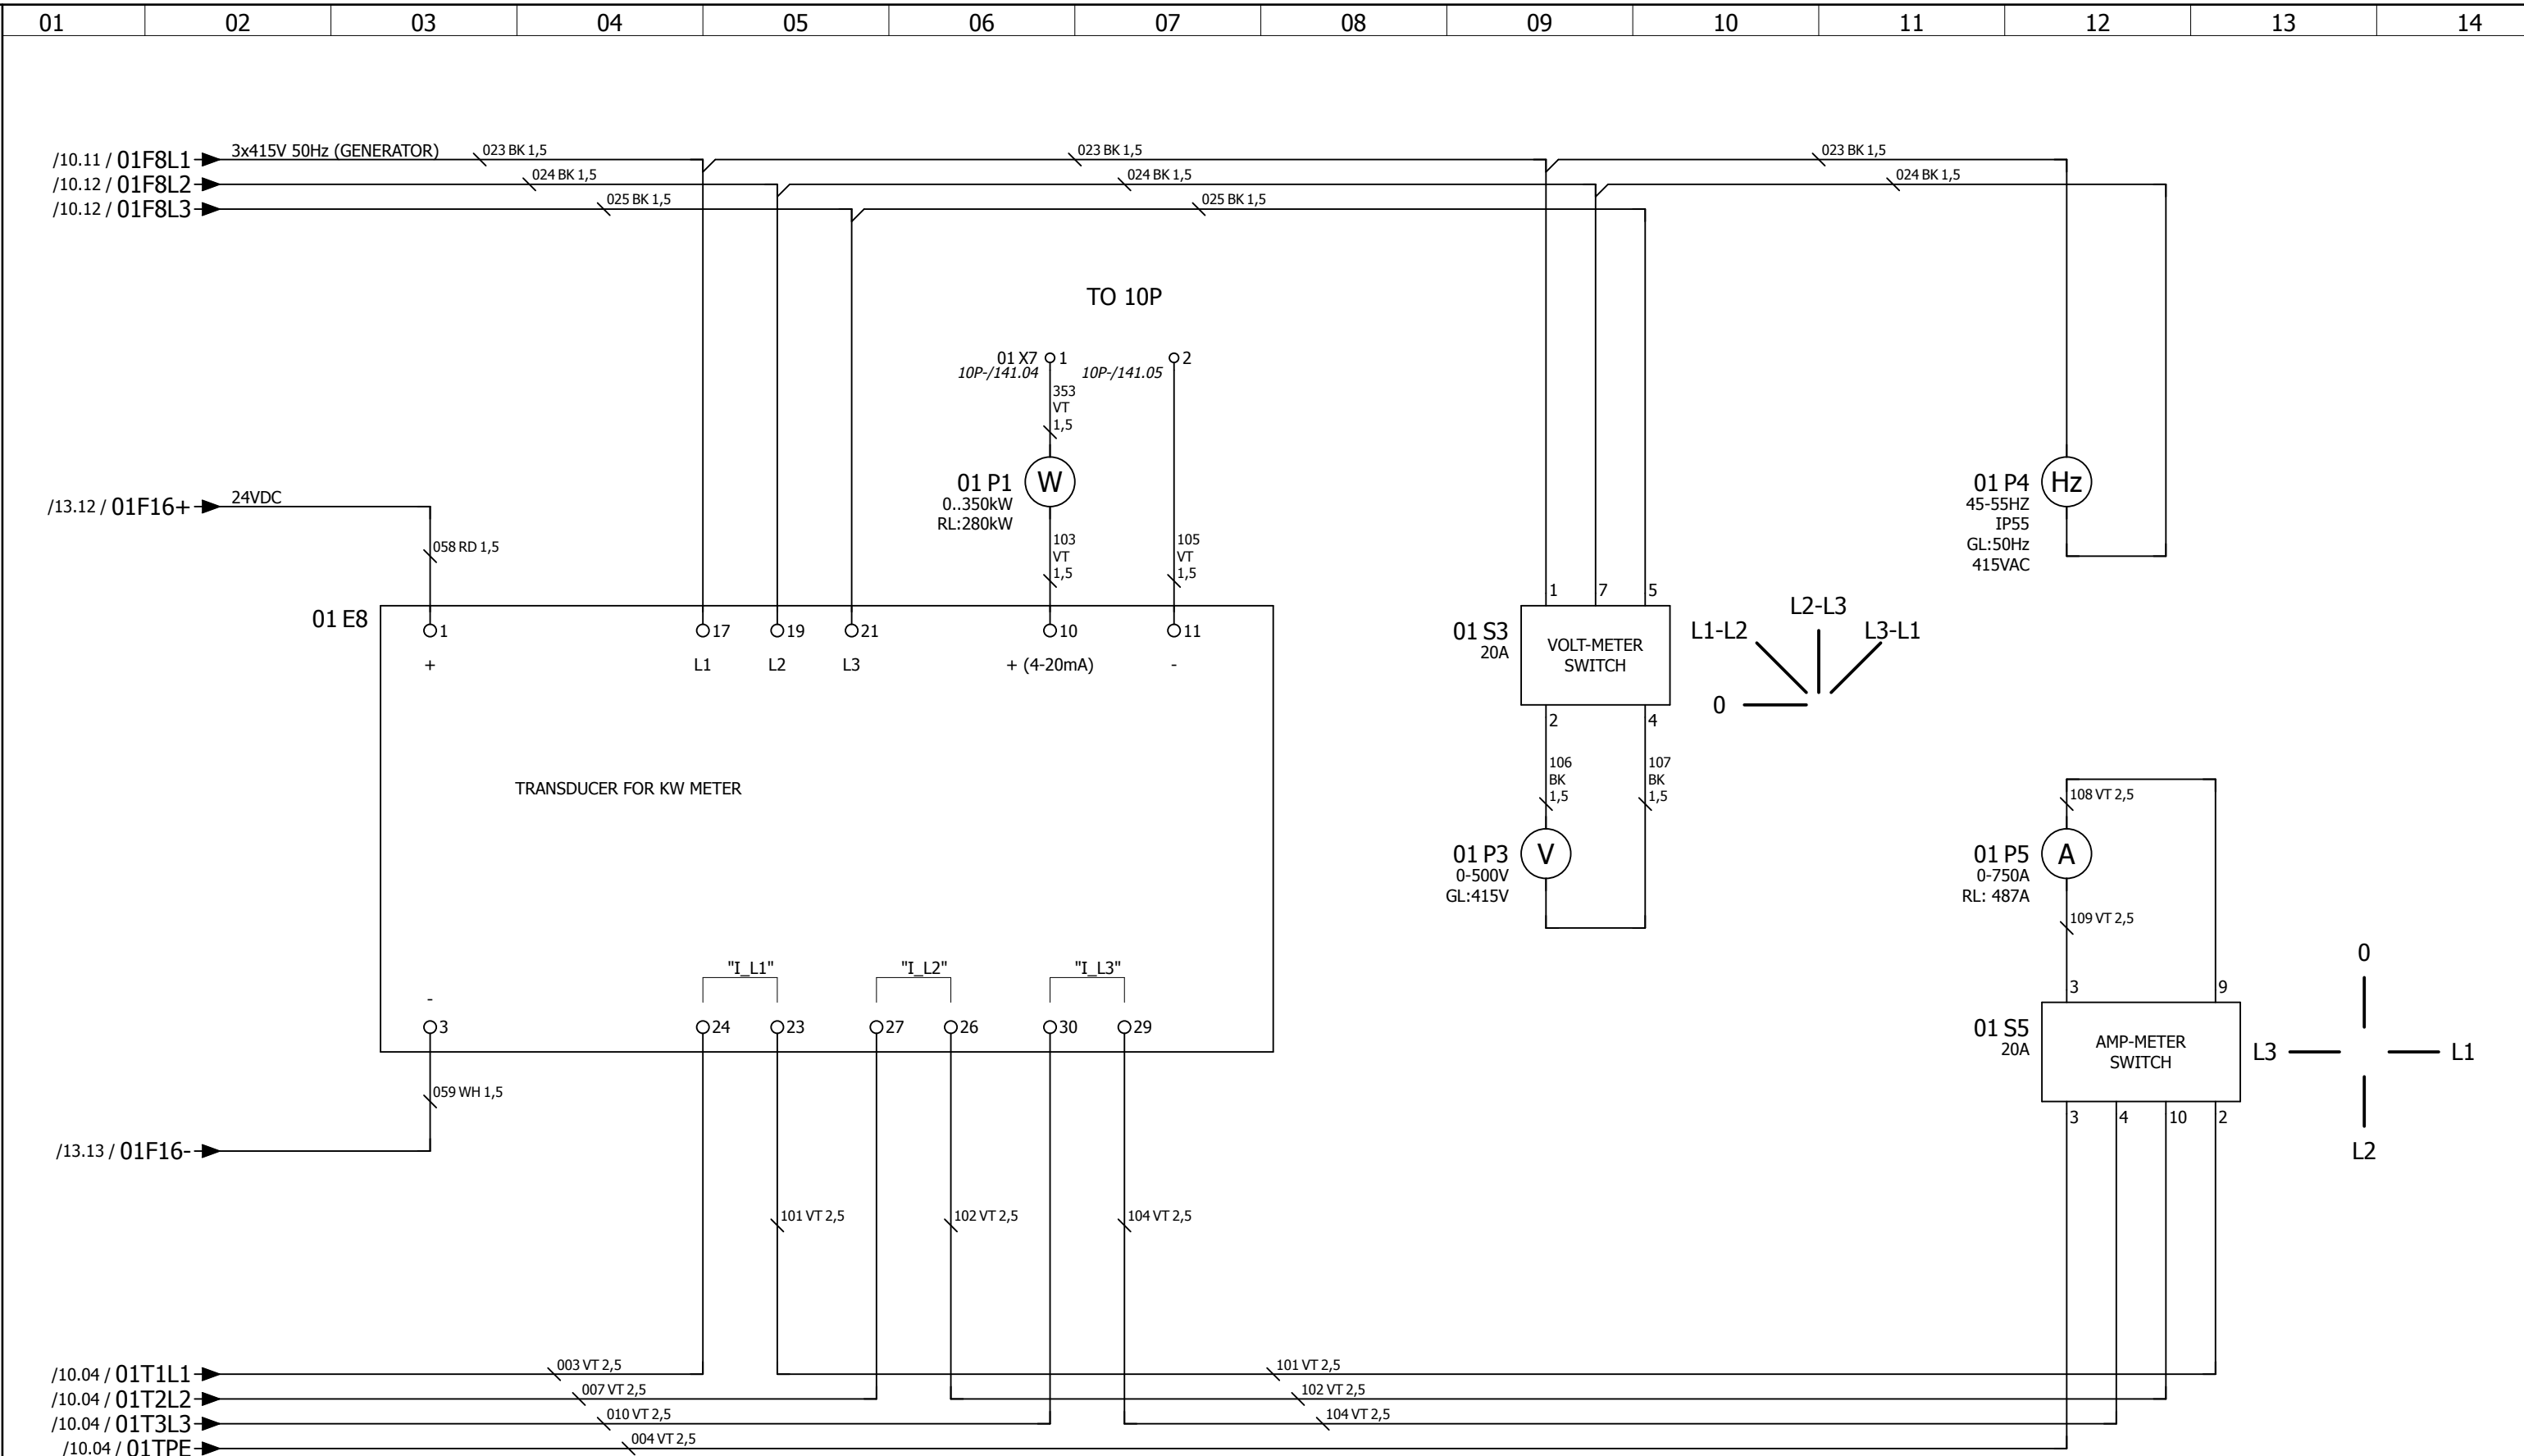

No part of this work may be copied, stored or published without prior written permission of Alewijnse Marine Systems.

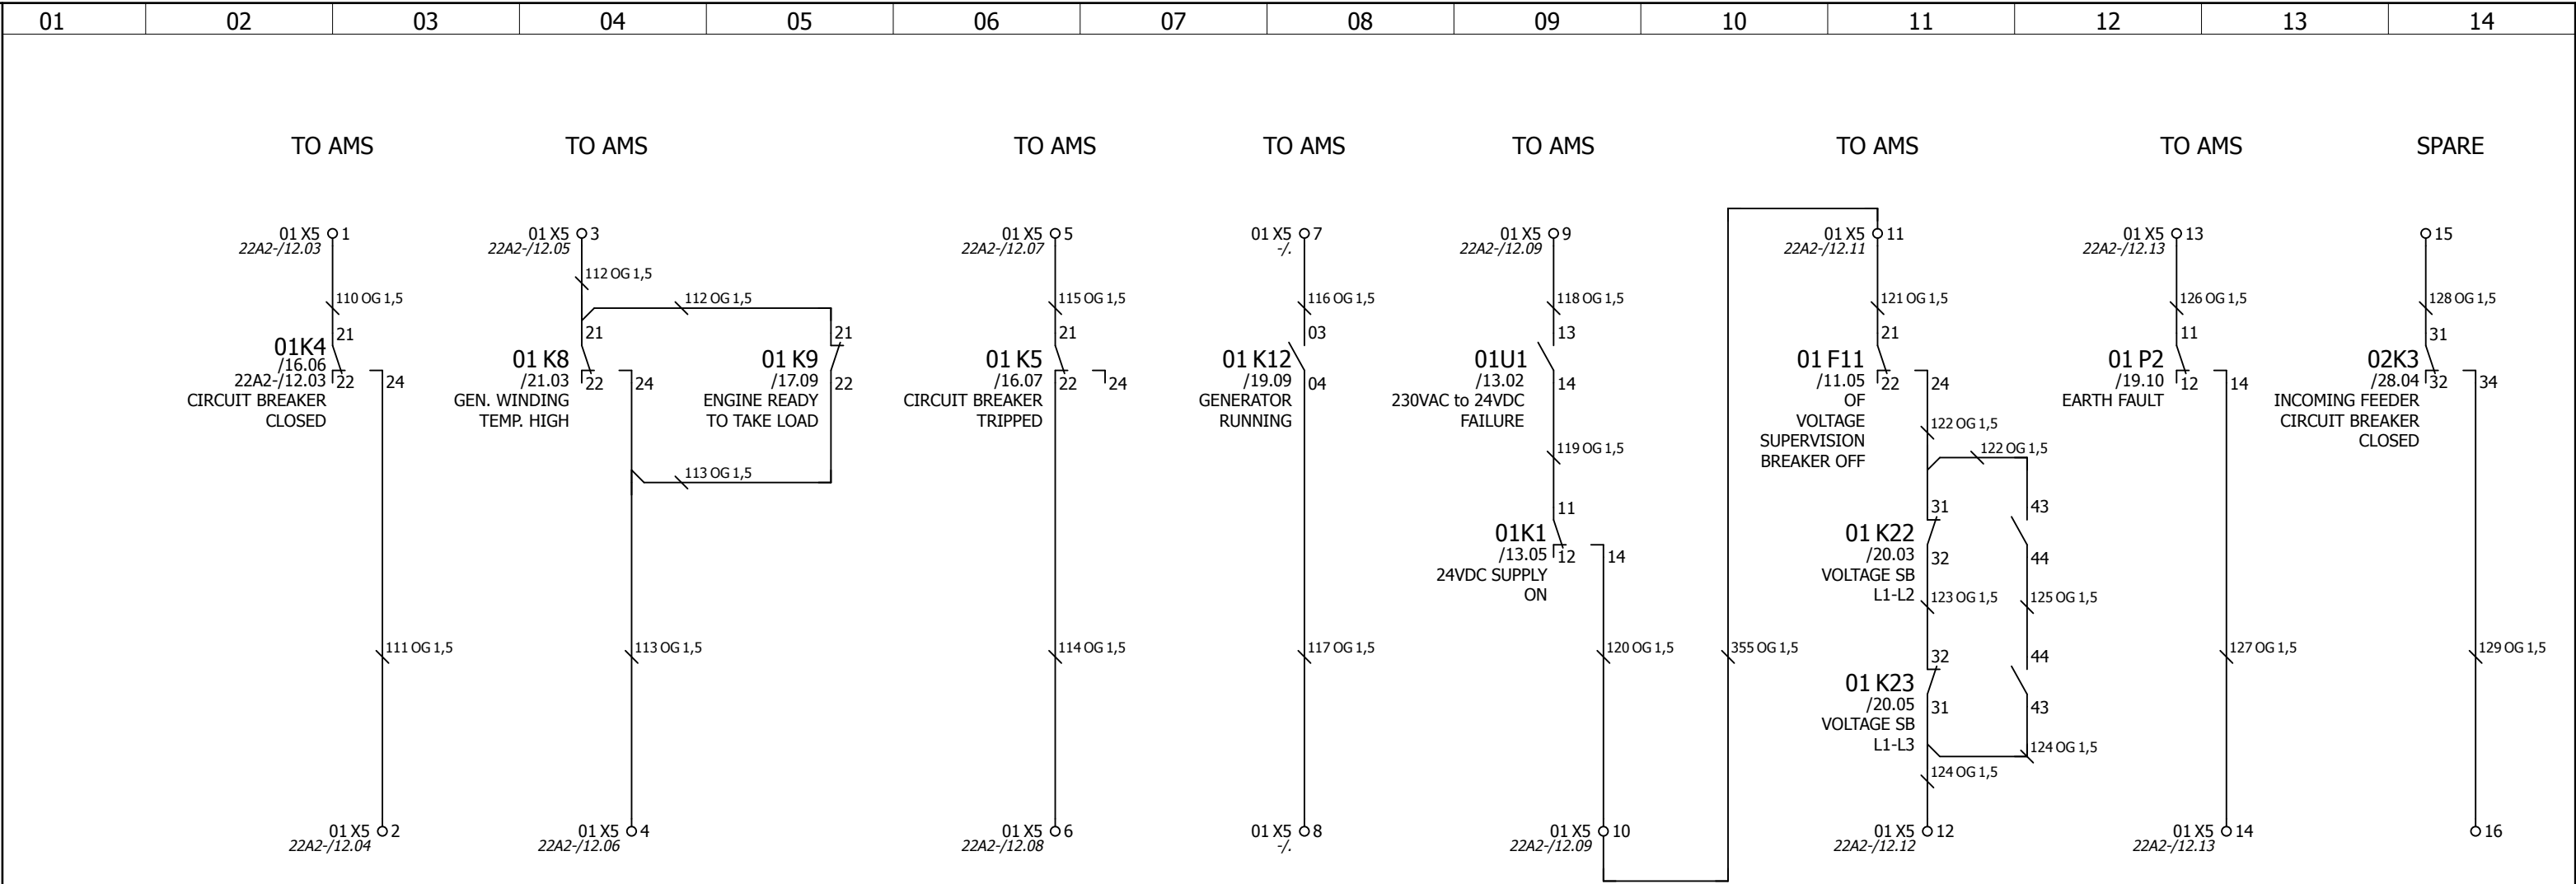

TO AMS

01 X5
22A2-/12.07

115 OG 1,5

21

01 K5
/16.07
CIRCUIT BREAKER
TRIPPED

22

24

114 OG 1,5

01 X5
22A2-/12.08

06

TO AMS

01 X5
-/-

116 OG 1,5

03

01 K12
/19.09
GENERATOR
RUNNING

04

117 OG 1,5

01 X5
-/-

08

TO AMS

01 X5
22A2-/12.09

118 OG 1,5

13

01U1
/13.02
230VAC to 24VDC
FAILURE

14

119 OG 1,5

11

01K1
/13.05
24VDC SUPPLY
ON

12

14

120 OG 1,5

01 X5
22A2-/12.09

10

TO AMS

01 X5
22A2-/12.11

121 OG 1,5

21

01 F11
/11.05
OF
VOLTAGE
SUPERVISION
BREAKER OFF

22

24

122 OG 1,5

31

01 K22
/20.03
VOLTAGE SB
L1-L2

32

123 OG 1,5

32

01 K23
/20.05
VOLTAGE SB
L1-L3

31

124 OG 1,5

01 X5
22A2-/12.12

12

122 OG 1,5

43

125 OG 1,5

44

124 OG 1,5

355 OG 1,5

11

12

TO AMS

01 X5
22A2-/12.13

126 OG 1,5

11

01 P2
/19.10
EARTH FAULT

12

14

127 OG 1,5

01 X5
22A2-/12.13

14

SPARE

128 OG 1,5

31

02K3
/28.04
INCOMING FEEDER
CIRCUIT BREAKER
CLOSED

32


34

129 OG 1,5

16


STAT	D	24-1-2011	PVR		* NO DELIVERY ALEWIJNSE			ALEWIJNSE MARINE B.V. ENERGIEWEG 46/C 6541 CX NIJMEGEN	IHC DREDGERS BV - TSHD5500 DCI-3 "12EP" EMERGENCY DISTRIBUTION BOARD 3X415V EMERGENCY GENERATOR ALARMS SECTION 1	Yard no : CO1266		
	M	5-12-2013	IEN	REV						1	Project : 23000143	
	AS BUILT									PANEL IP23	Class : LROS/IRS	
		05-12-2013	IEN	CHK							Page : 12EP -23	

No part of this work may be copied, stored or published without prior written permission of Alewijnse Marine Systems.

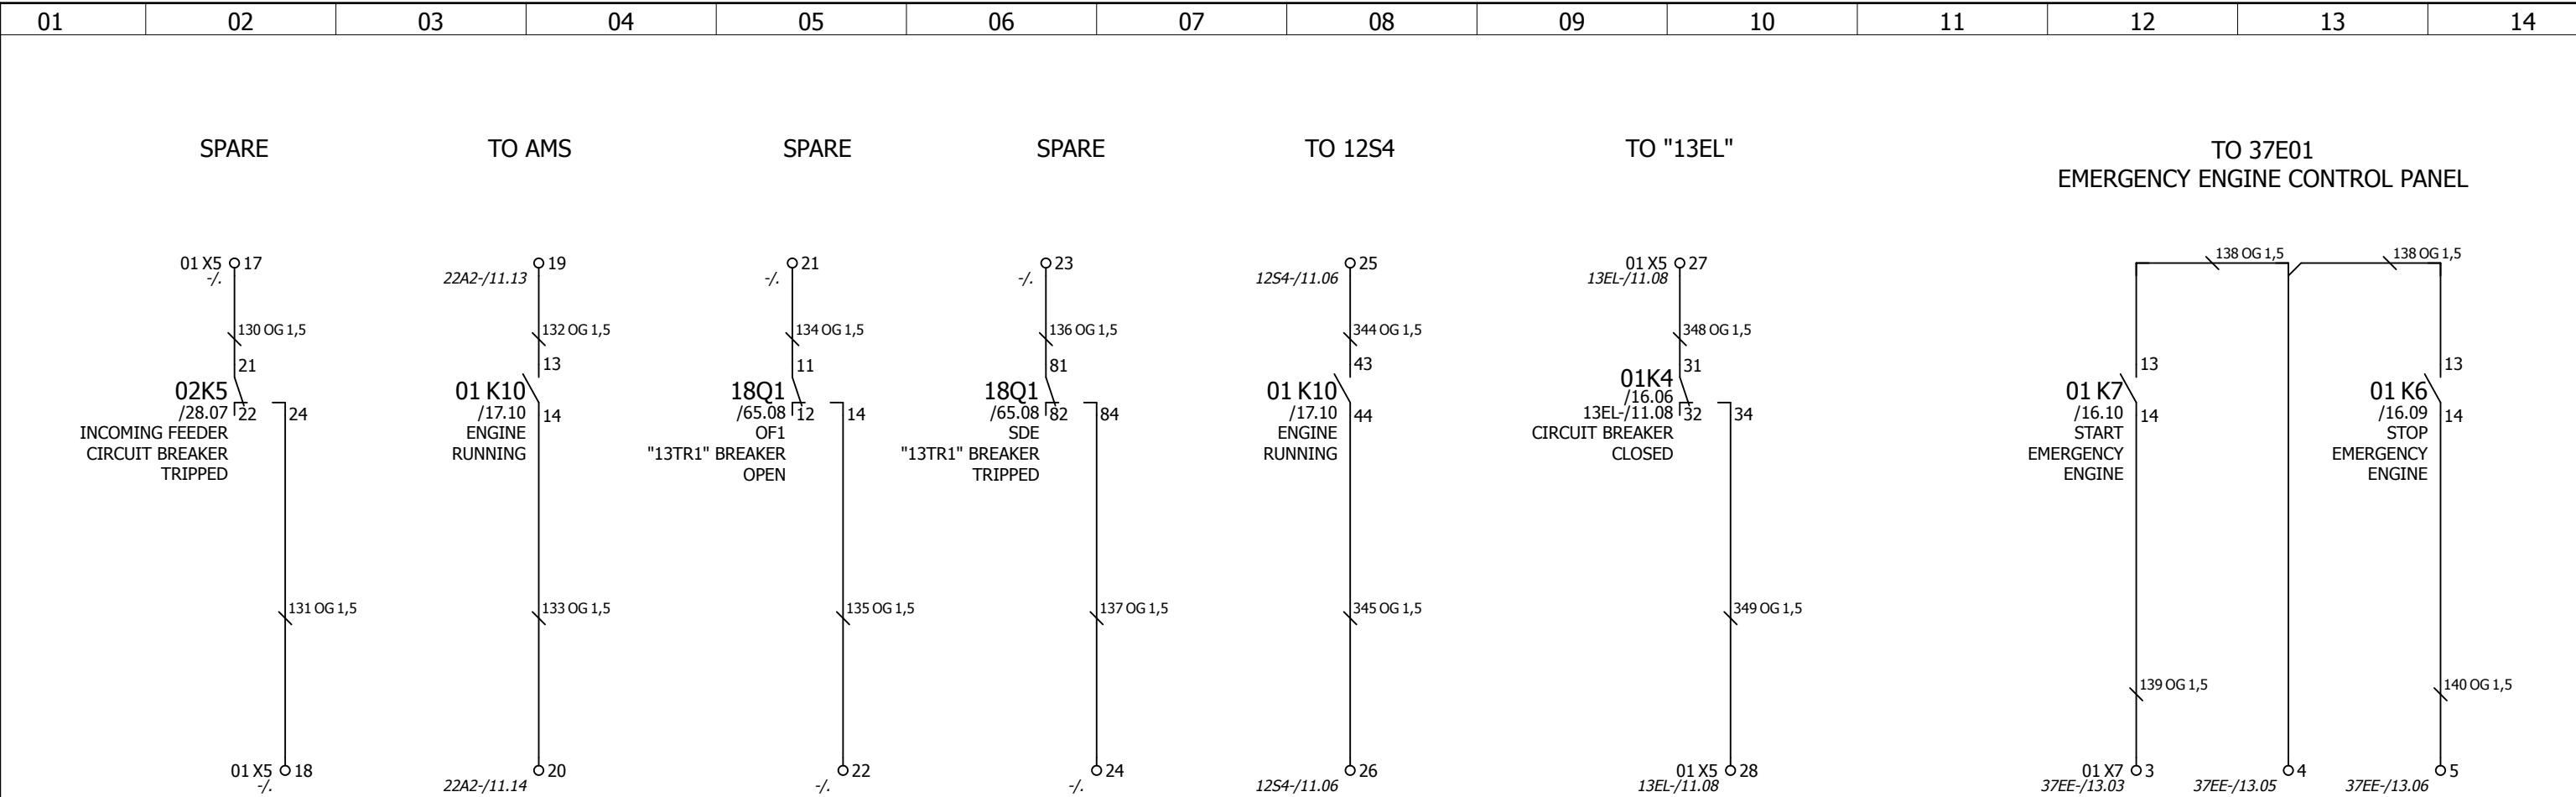


D	24-1-2011	PVR			* NO DELIVERY ALEWIJNSE			IHC DREDGERS BV - TSHD5500 DCI-3 "12EP" EMERGENCY DISTRIBUTION BOARD 3X415V EMERGENCY GENERATOR ALARMS SECTION 1	Yard no : CO1266		
M	5-12-2013	IEN	REV	1					Project : 23000143		
STAT	AS BUILT				PANEL IP23				Class : LROS/IRS		
	05-12-2013	IEN	CHK						Page : 12EP -23.a		

No part of this work may be copied, stored or published without prior written permission of Alewijnse Marine Systems.

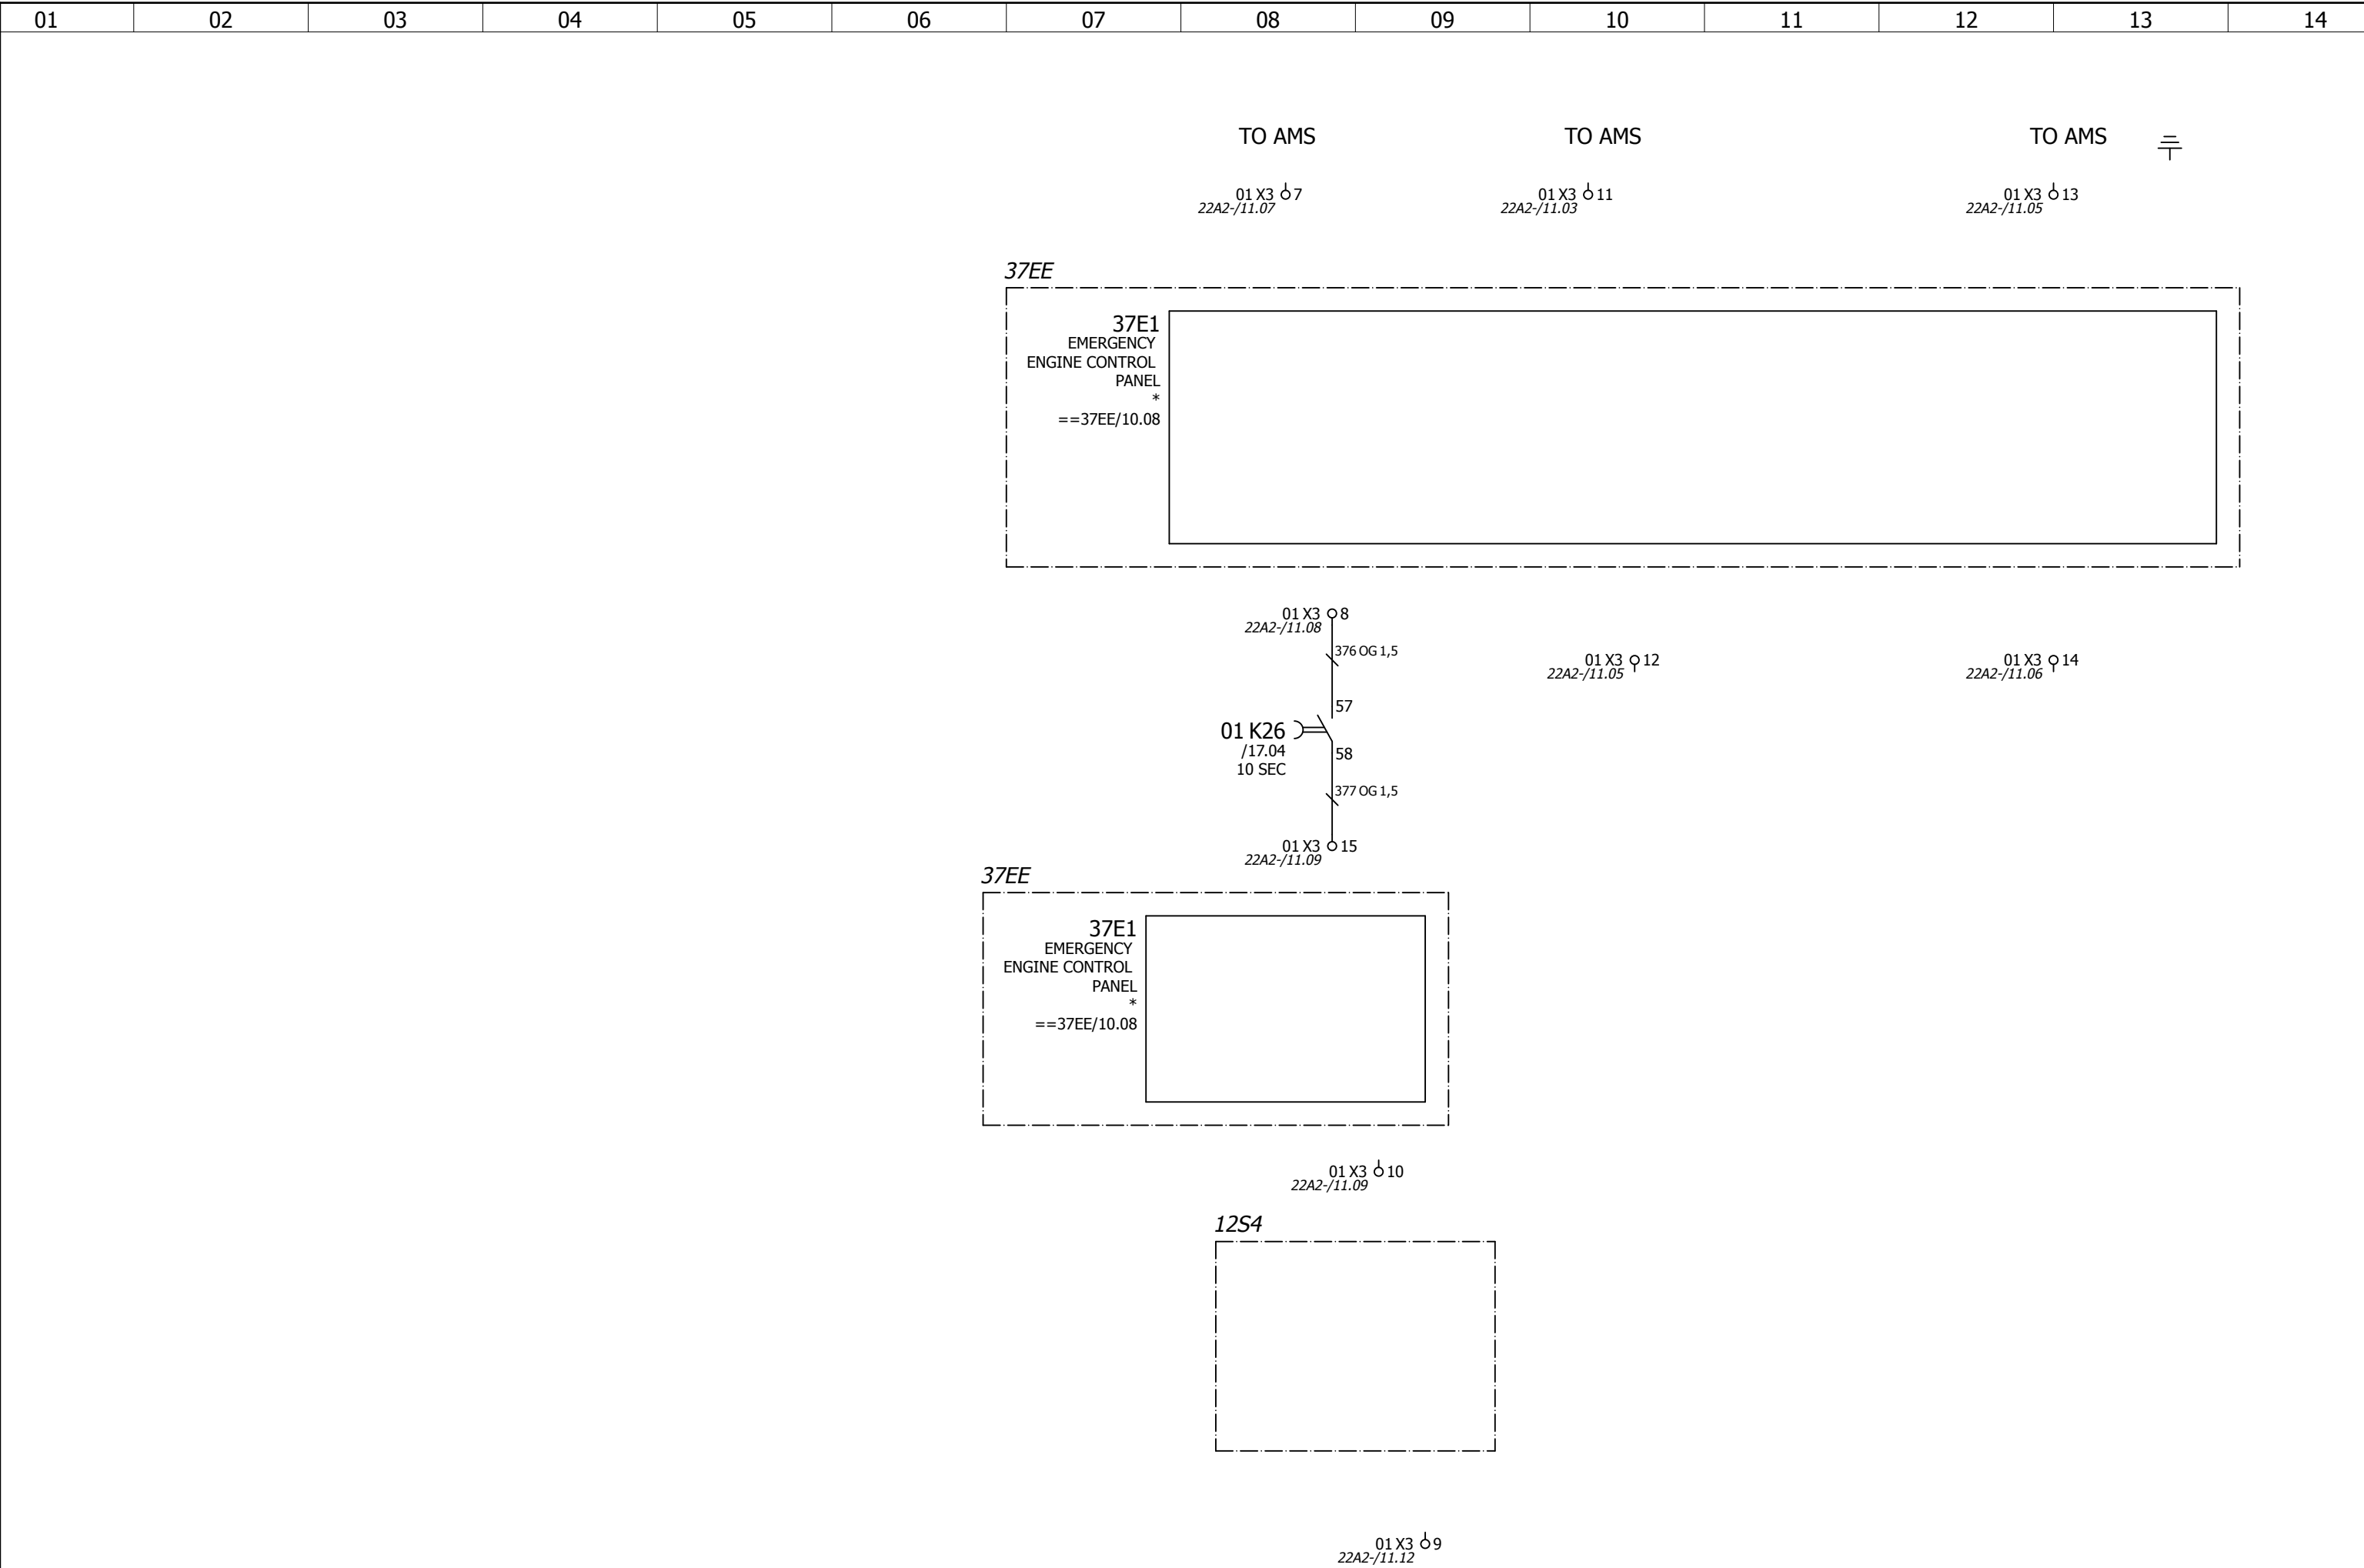


4-1-2011		PVR				* NO DELIVERY ALEWIJNSE PANEL IP23			IHC DREDGERS BV - TSHD5500 DCI-3 "12EP" EMERGENCY DISTRIBUTION BOARD 3X415V EMERGENCY GENERATOR INTERFACES SECTION 1	Yard no : CO1266	
-12-2013		IEN		REV 1						Project : 23000143	
S BUILT								Class : LROS/IRS			
5-12-2013		IEN		CHK				Page : 12EP -24			

No part of this work may be copied, stored or published without prior written permission of Alewijnse Marine Systems.

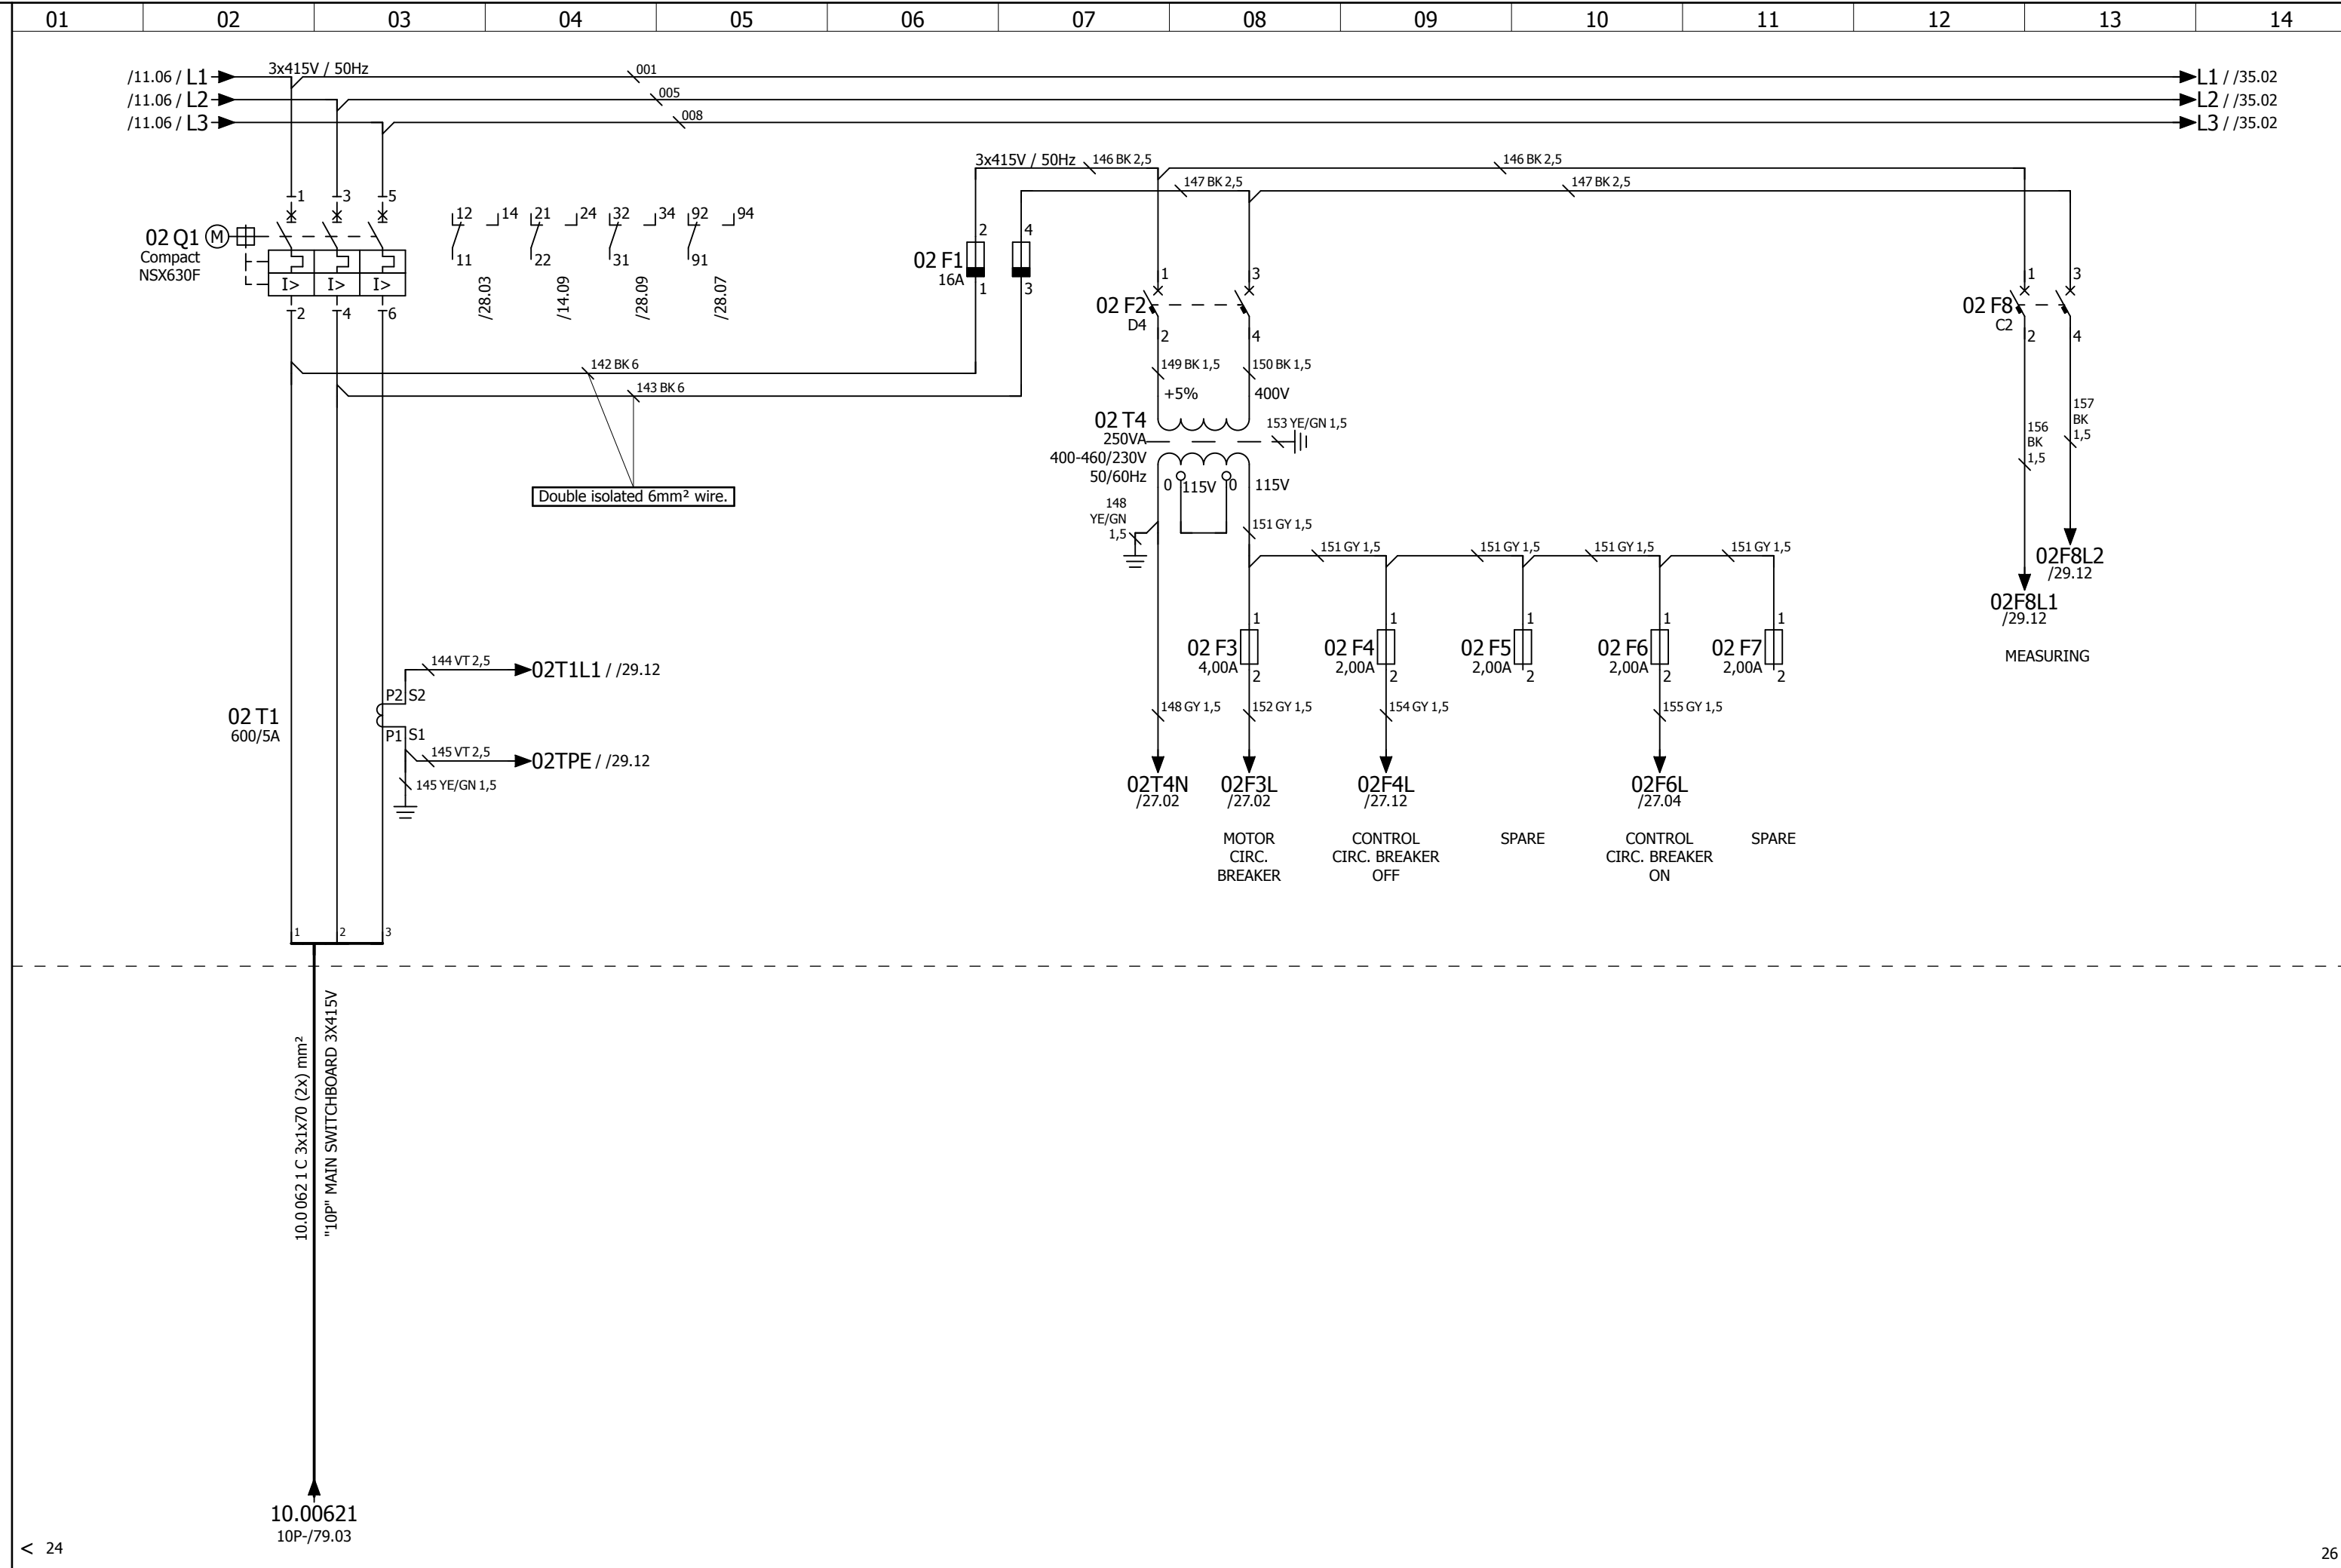


D	24-1-2011	PVR			* NO DELIVERY ALEWIJNSE			ALEWIJNSE MARINE B.V. ENERGIEWEG 46/C 6541 CX NIJMEGEN	IHC DREDGERS BV - TSHD5500 DCI-3 "12EP" EMERGENCY DISTRIBUTION BOARD 3X415V INCOMING FEEDER MSB MAIN CIRCUIT	Yard no : CO1266
M	5-12-2013	IEN	REV	1						Project : 23000143
STAT	AS BUILT				PANEL IP23					Class : LROS/IRS
	05-12-2013	IEN	CHK							Page : 12EP -25

No part of this work may be copied, stored or published without prior written permission of Alewijnse Marine Systems.

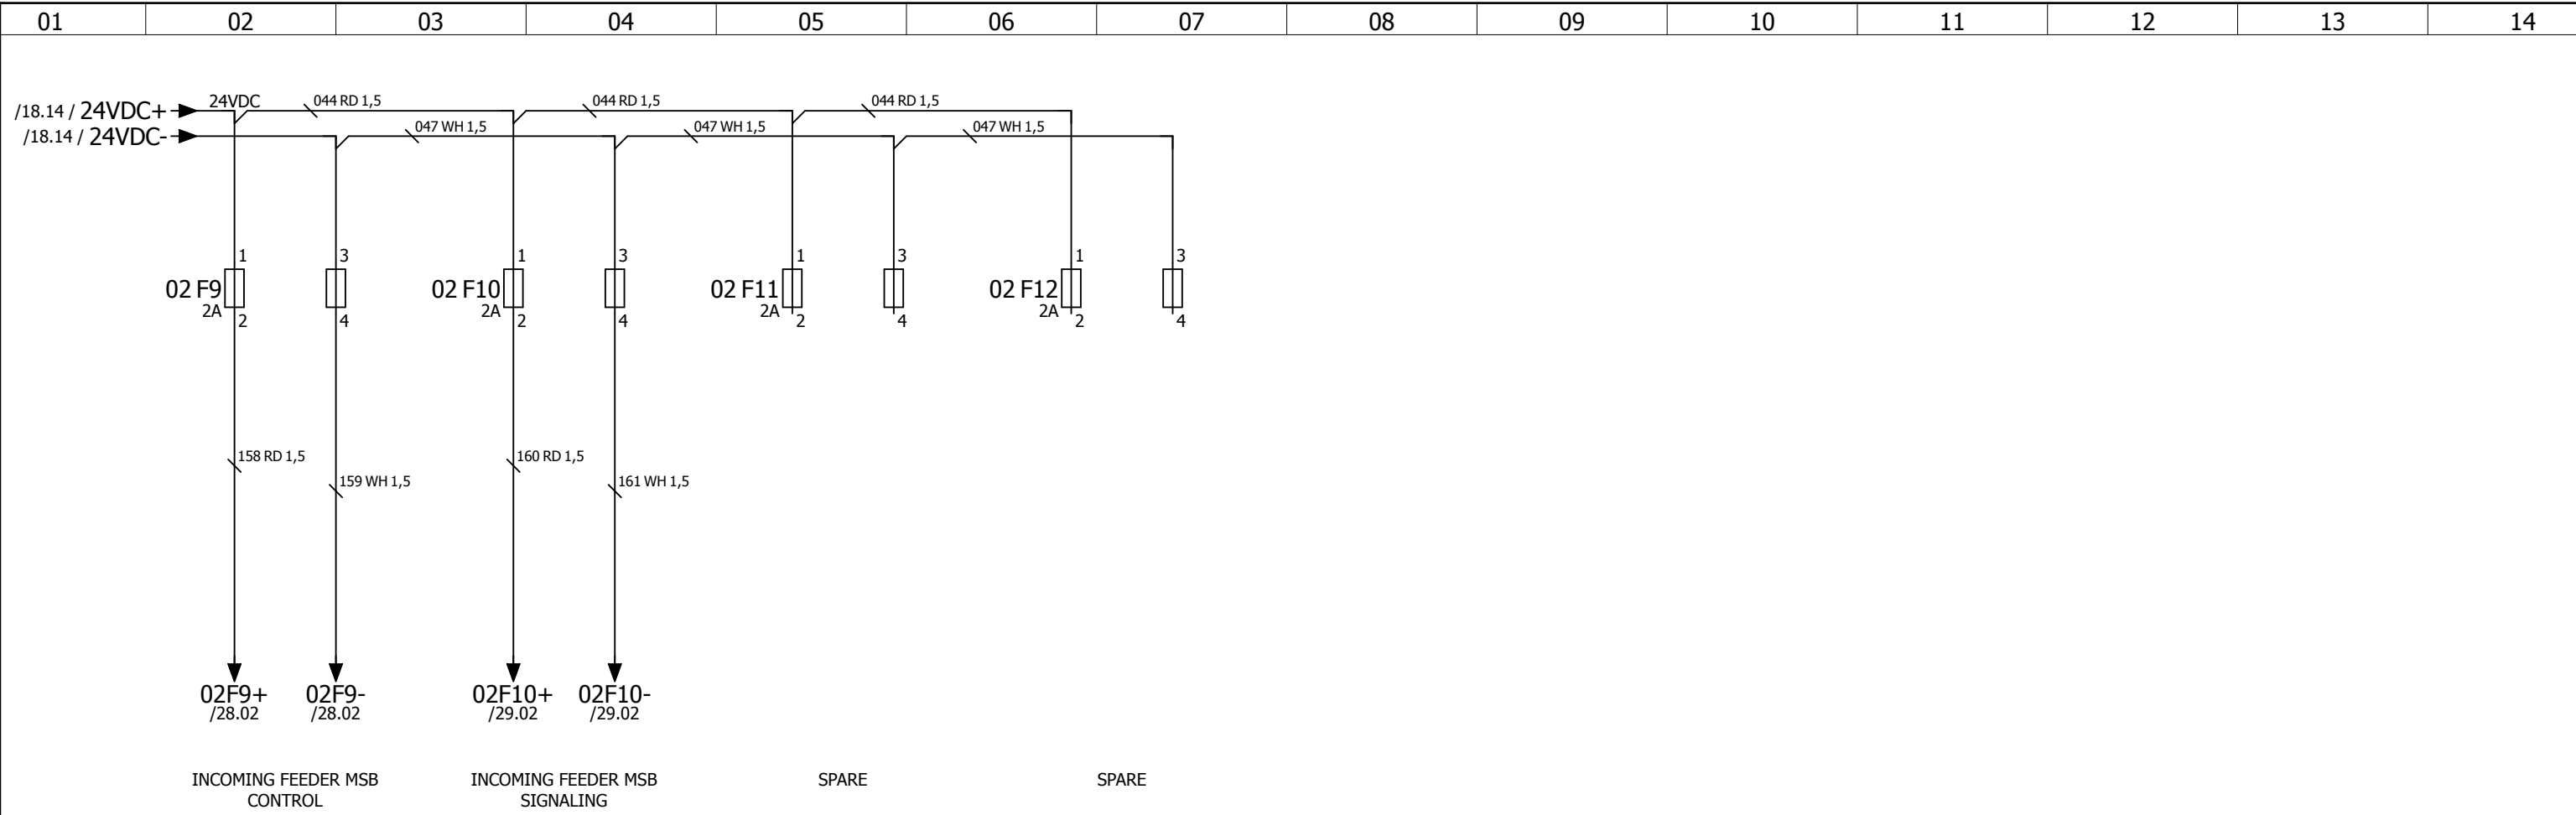


D	24-1-2011	PVR		* NO DELIVERY ALEWIJNSE			IHC DREDGERS BV - TSHD5500 DCI-3 "12EP" EMERGENCY DISTRIBUTION BOARD 3X415V DISTRIBUTION 24VDC MAIN CIRCUIT	Yard no : CO1266	
M	5-12-2013	IEN	REV 1					Project : 23000143	
STAT	AS BUILT			PANEL IP23		ALEWIJNSE MARINE B.V. ENERGIEWEG 46/C 6541 CX NIJMEGEN		Class : LROS/IRS	
	05-12-2013	IEN	CHK					Page : 12EP -26	

No part of this work may be copied, stored or published without prior written permission of Alewijnse Marine Systems.

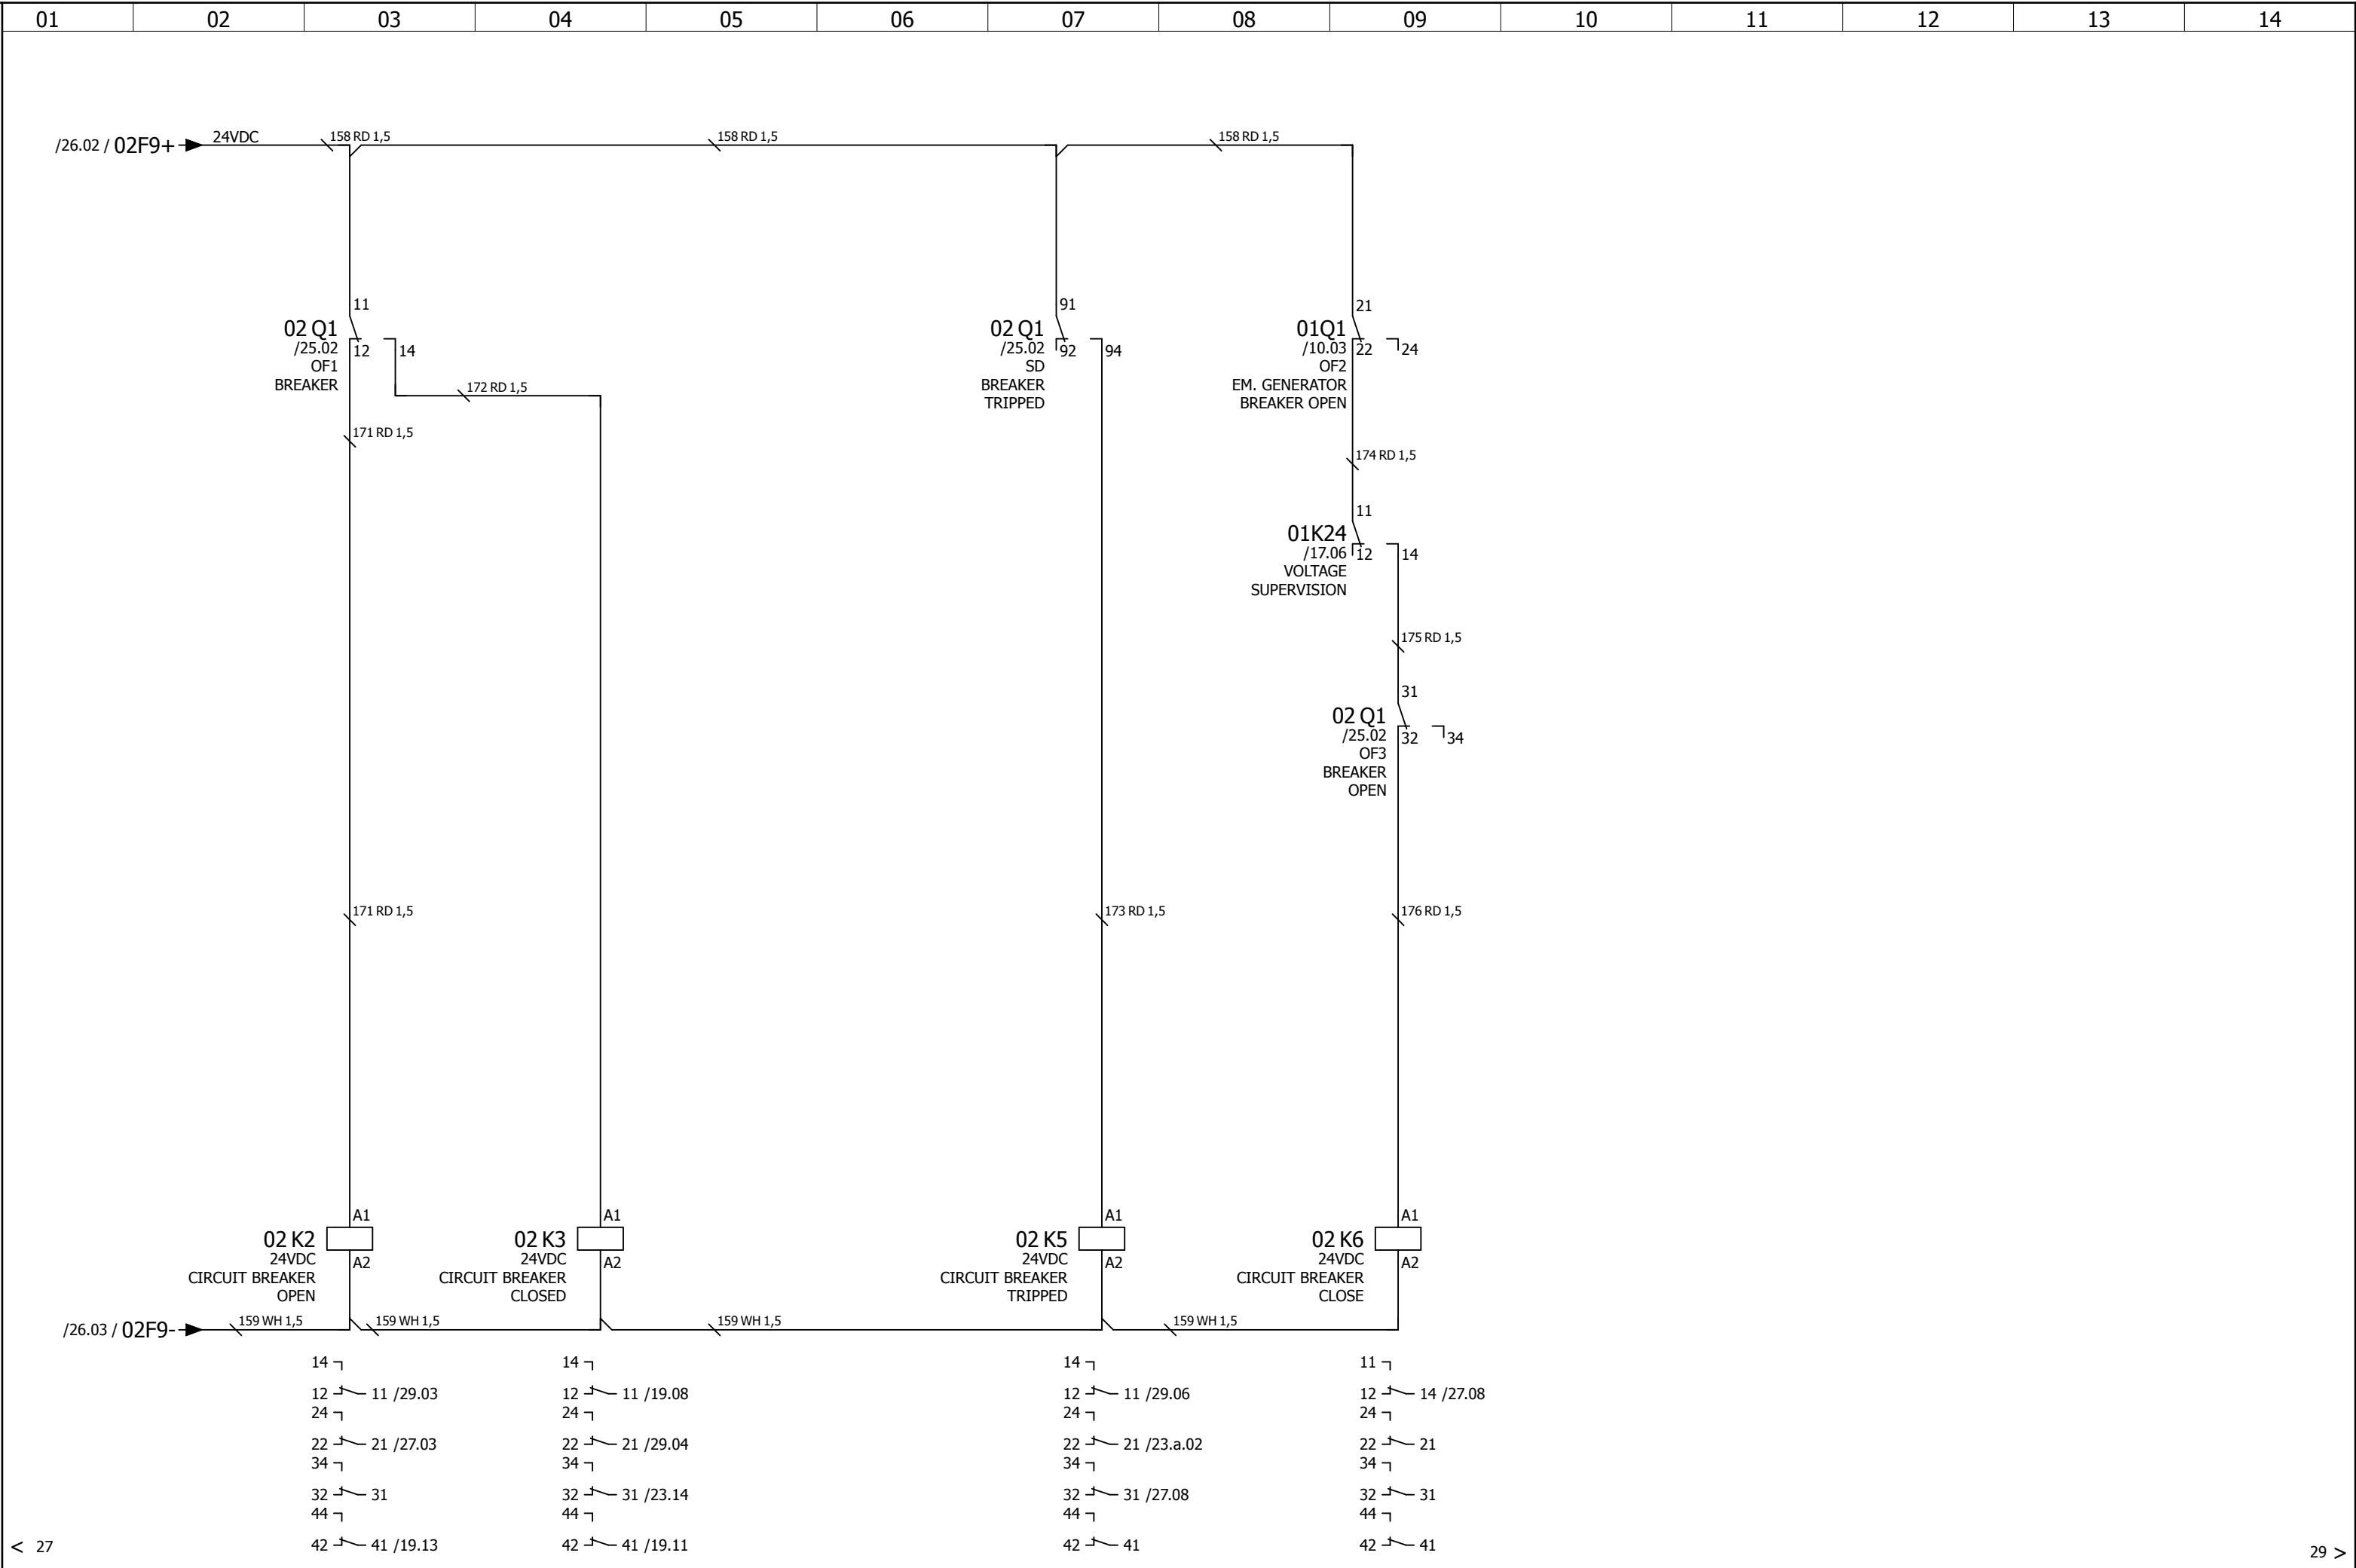


STAT	D	24-1-2011	PVR		* NO DELIVERY ALEWIJNSE			IHC DREDGERS BV - TSHD5500 DCI-3 "12EP" EMERGENCY DISTRIBUTION BOARD 3X415V INCOMING FEEDER MSB CONTROL CIRCUIT SECTION 2	Yard no : CO1266
	M	5-12-2013	IEN	REV					1
	AS BUILT					PANEL IP23		ALEWIJNSE MARINE B.V. ENERGIEWEG 46/C 6541 CX NIJMEGEN	Class : LROS/IRS
		05-12-2013	IEN	CHK					Page : 12EP -28


No part of this work may be copied, stored or published without prior written permission of Alewijnse Marine Systems.

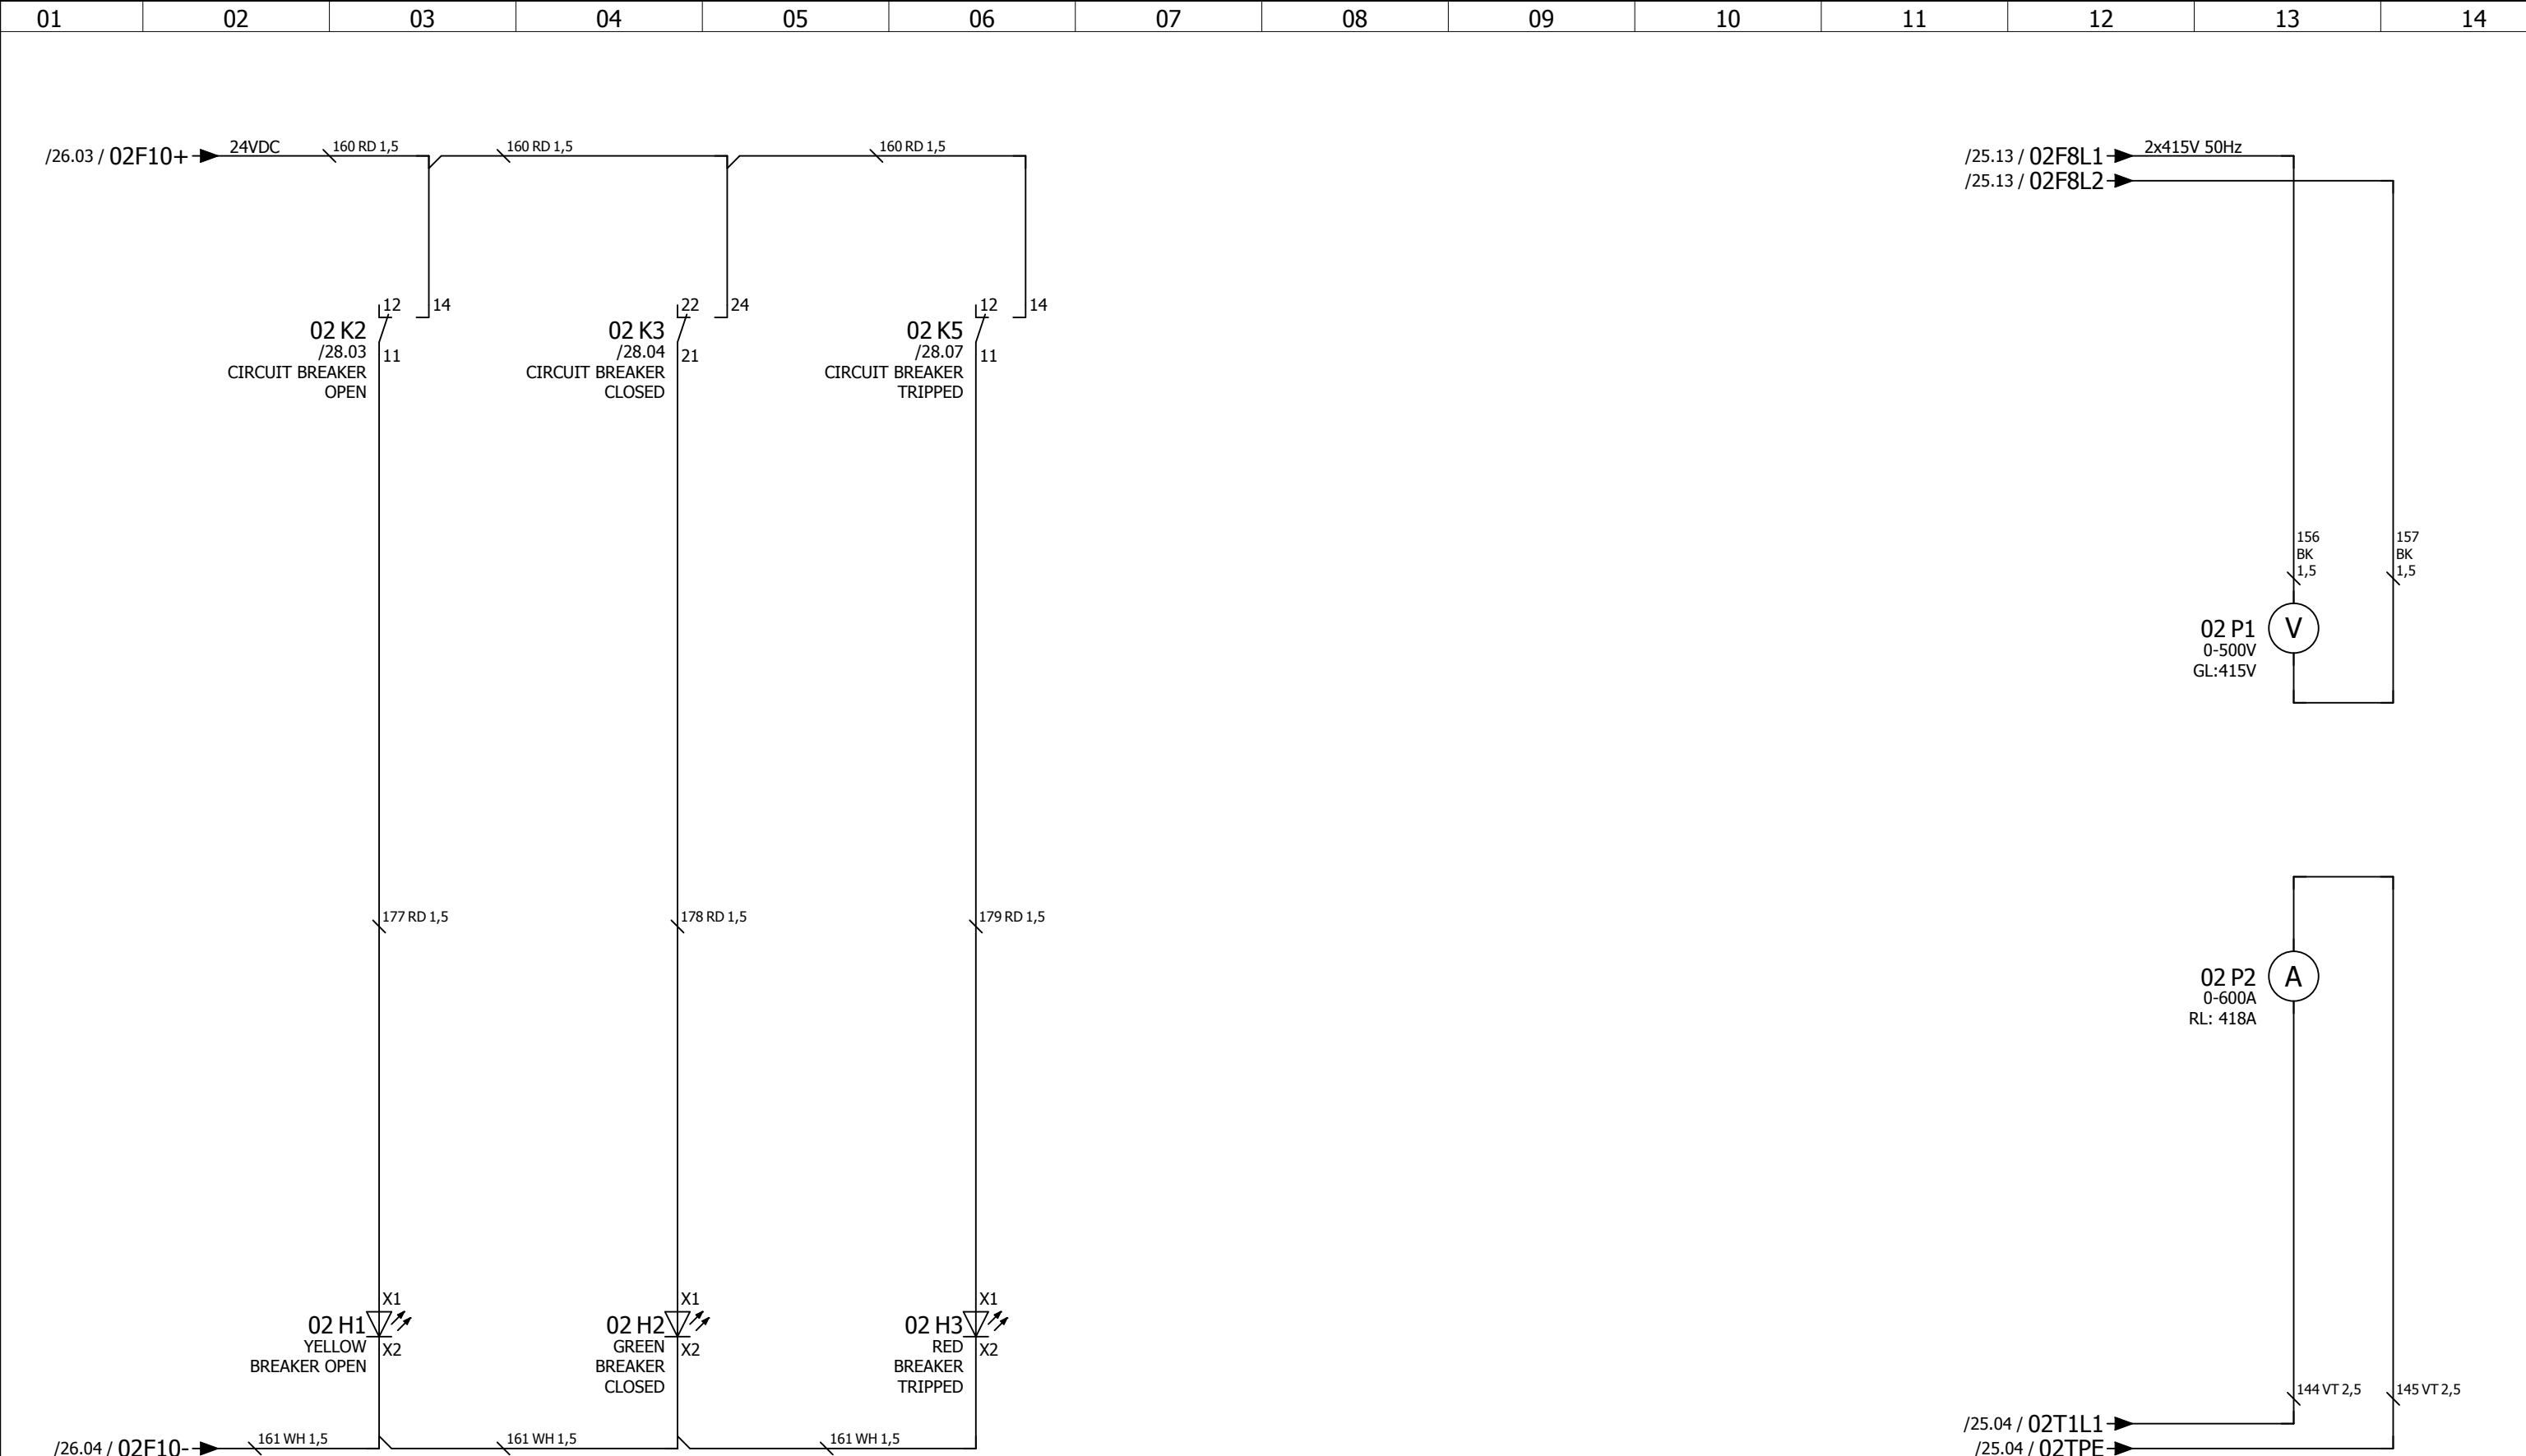

STAT	D	24-1-2011	PVR		* NO DELIVERY ALEWIJNSE			ALEWIJNSE MARINE B.V. ENERGIEWEG 46/C 6541 CX NIJMEGEN	IHC DREDGERS BV - TSHD5500 DCI-3 "12EP" EMERGENCY DISTRIBUTION BOARD 3X415V INCOMING FEEDER MSB SIGNALING & MEASURING SECTION 2	Yard no : CO1266
	M	5-12-2013	IEN	REV						1
	AS BUILT					PANEL IP23	Class : LROS/IRS			
		05-12-2013	IEN	CHK			Page : 12EP -29			

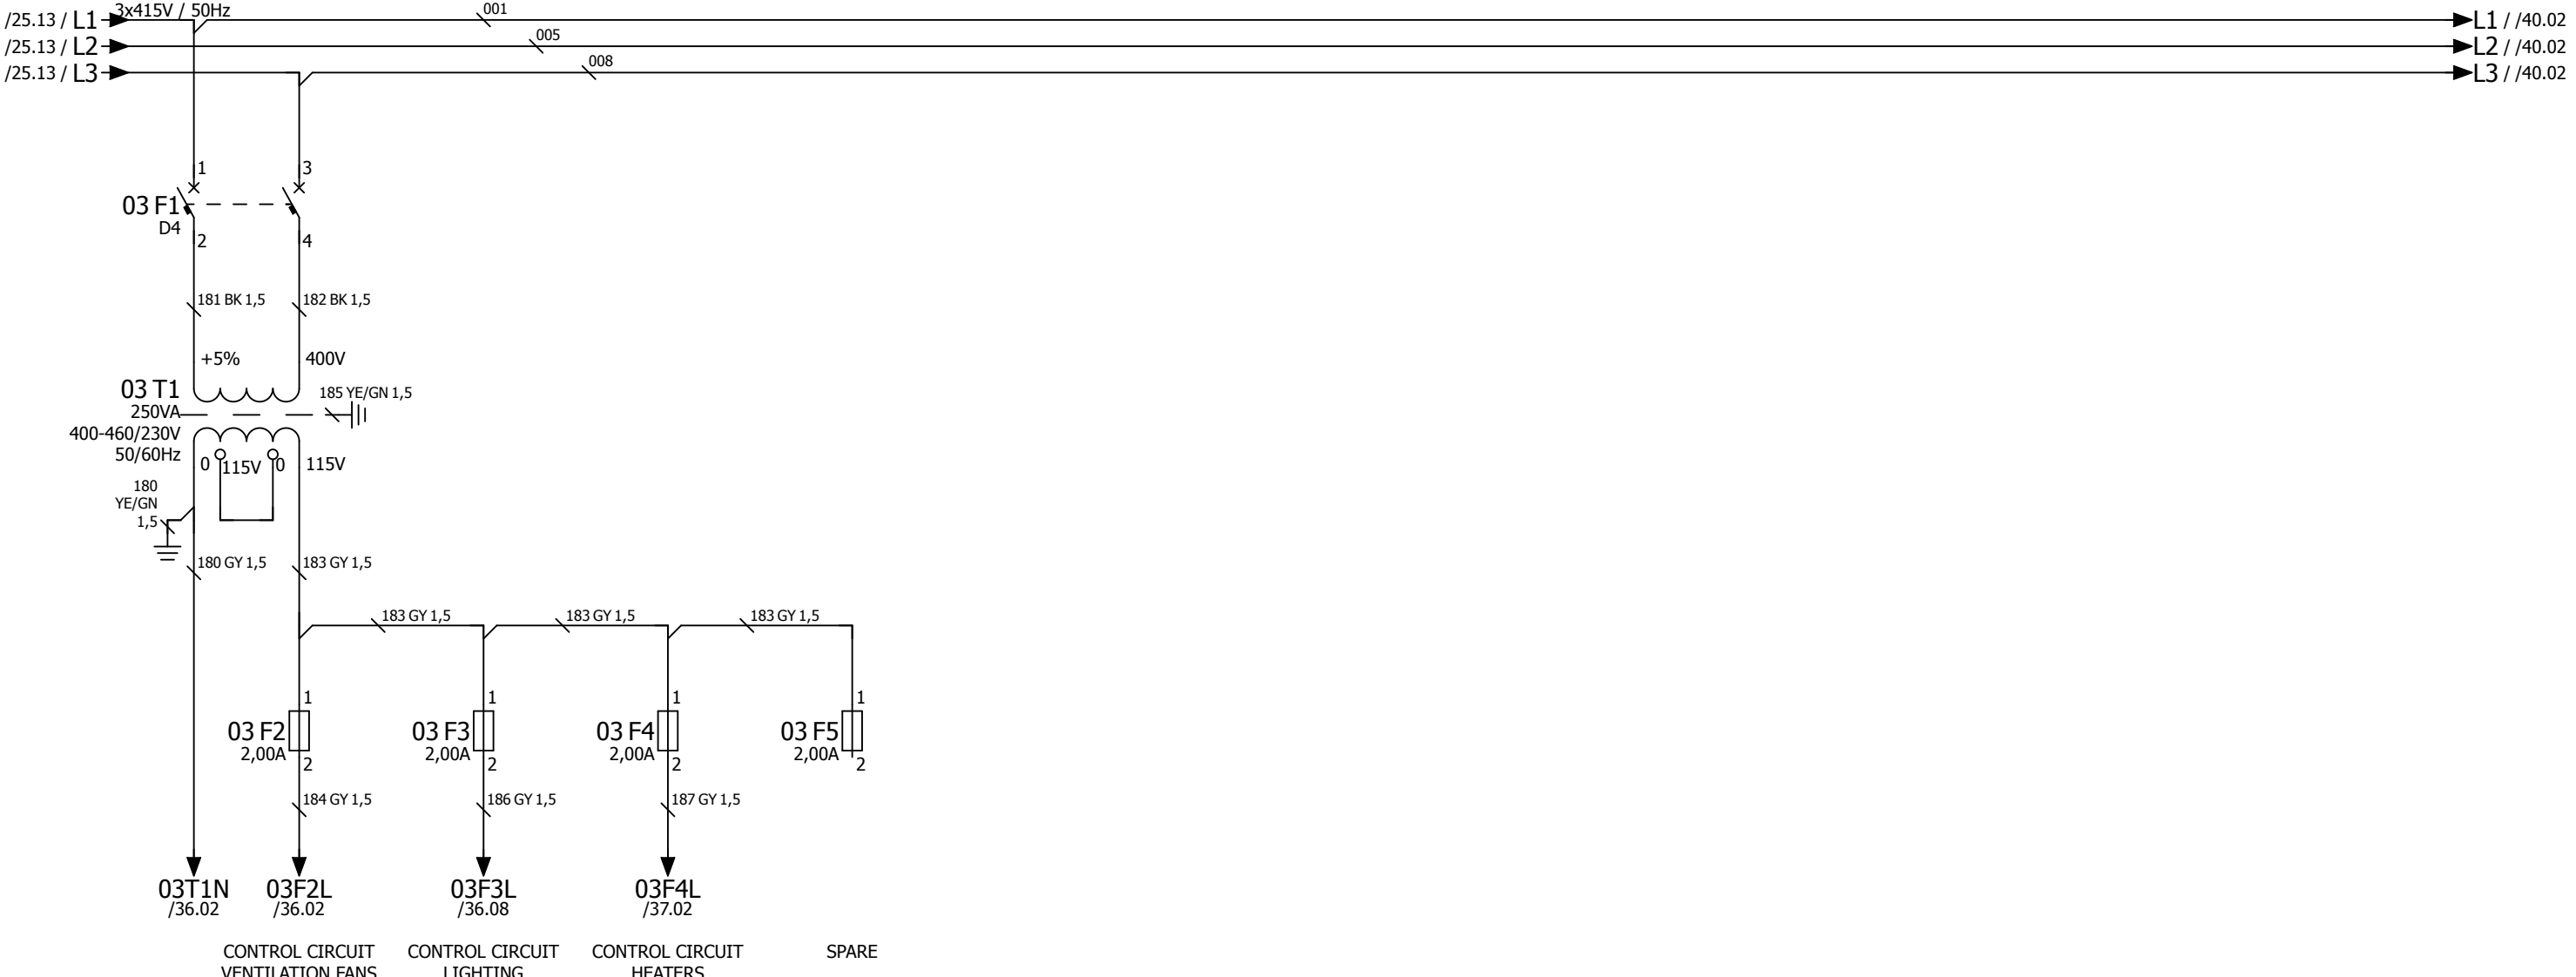


No part of this work may be copied, stored or published without prior written permission of Alewijnse Marine Systems.

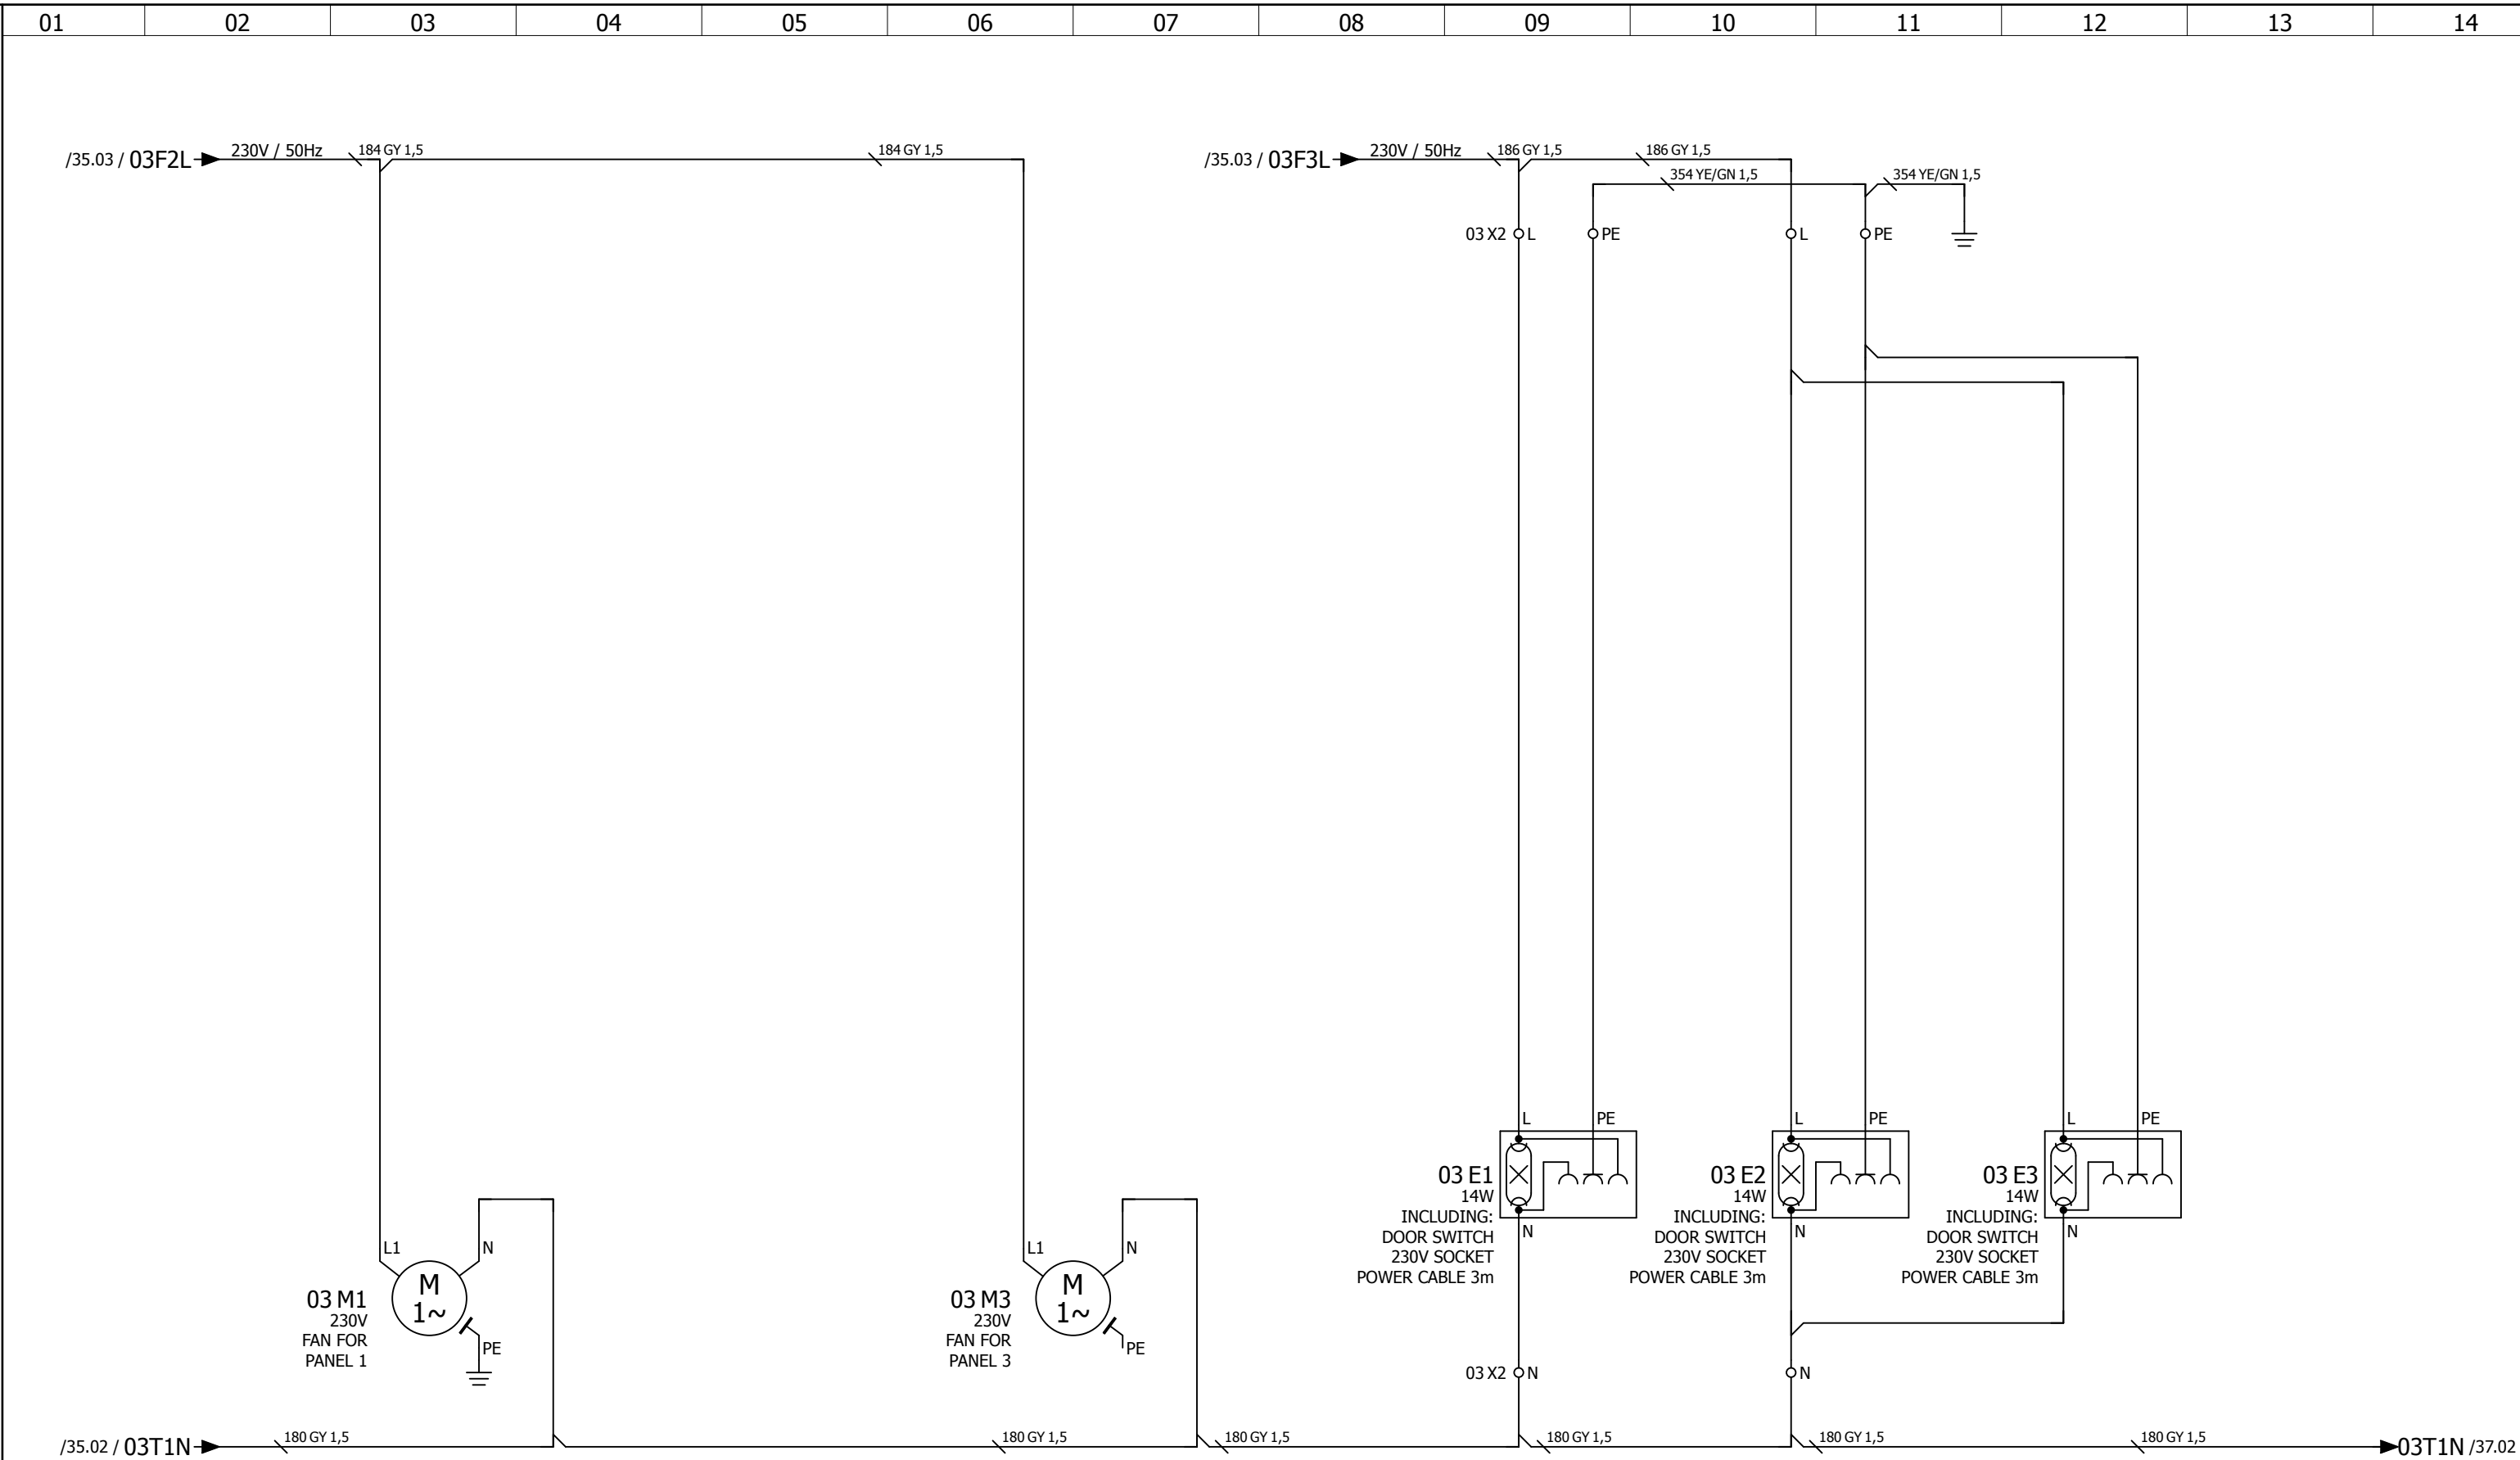


D	24-1-2011	PVR			* NO DELIVERY ALEWIJNSE			ALEWIJNSE MARINE B.V. ENERGIEWEG 46/C 6541 CX NIJMEGEN	IHC DREDGERS BV - TSHD5500 DCI-3 "12EP" EMERGENCY DISTRIBUTION BOARD 3X415V PANEL -LIGHTING / VENTILATION CONTROL CIRCUIT SECTION 3	Yard no : CO1266
M	5-12-2013	IEN	REV	1						Project : 23000143
STAT	AS BUILT				PANEL IP23			Class : LROS/IRS		
	05-12-2013	IEN	CHK					Page : 12EP -36		

No part of this work may be copied, stored or published without prior written permission of Alewijnse Marine Systems.

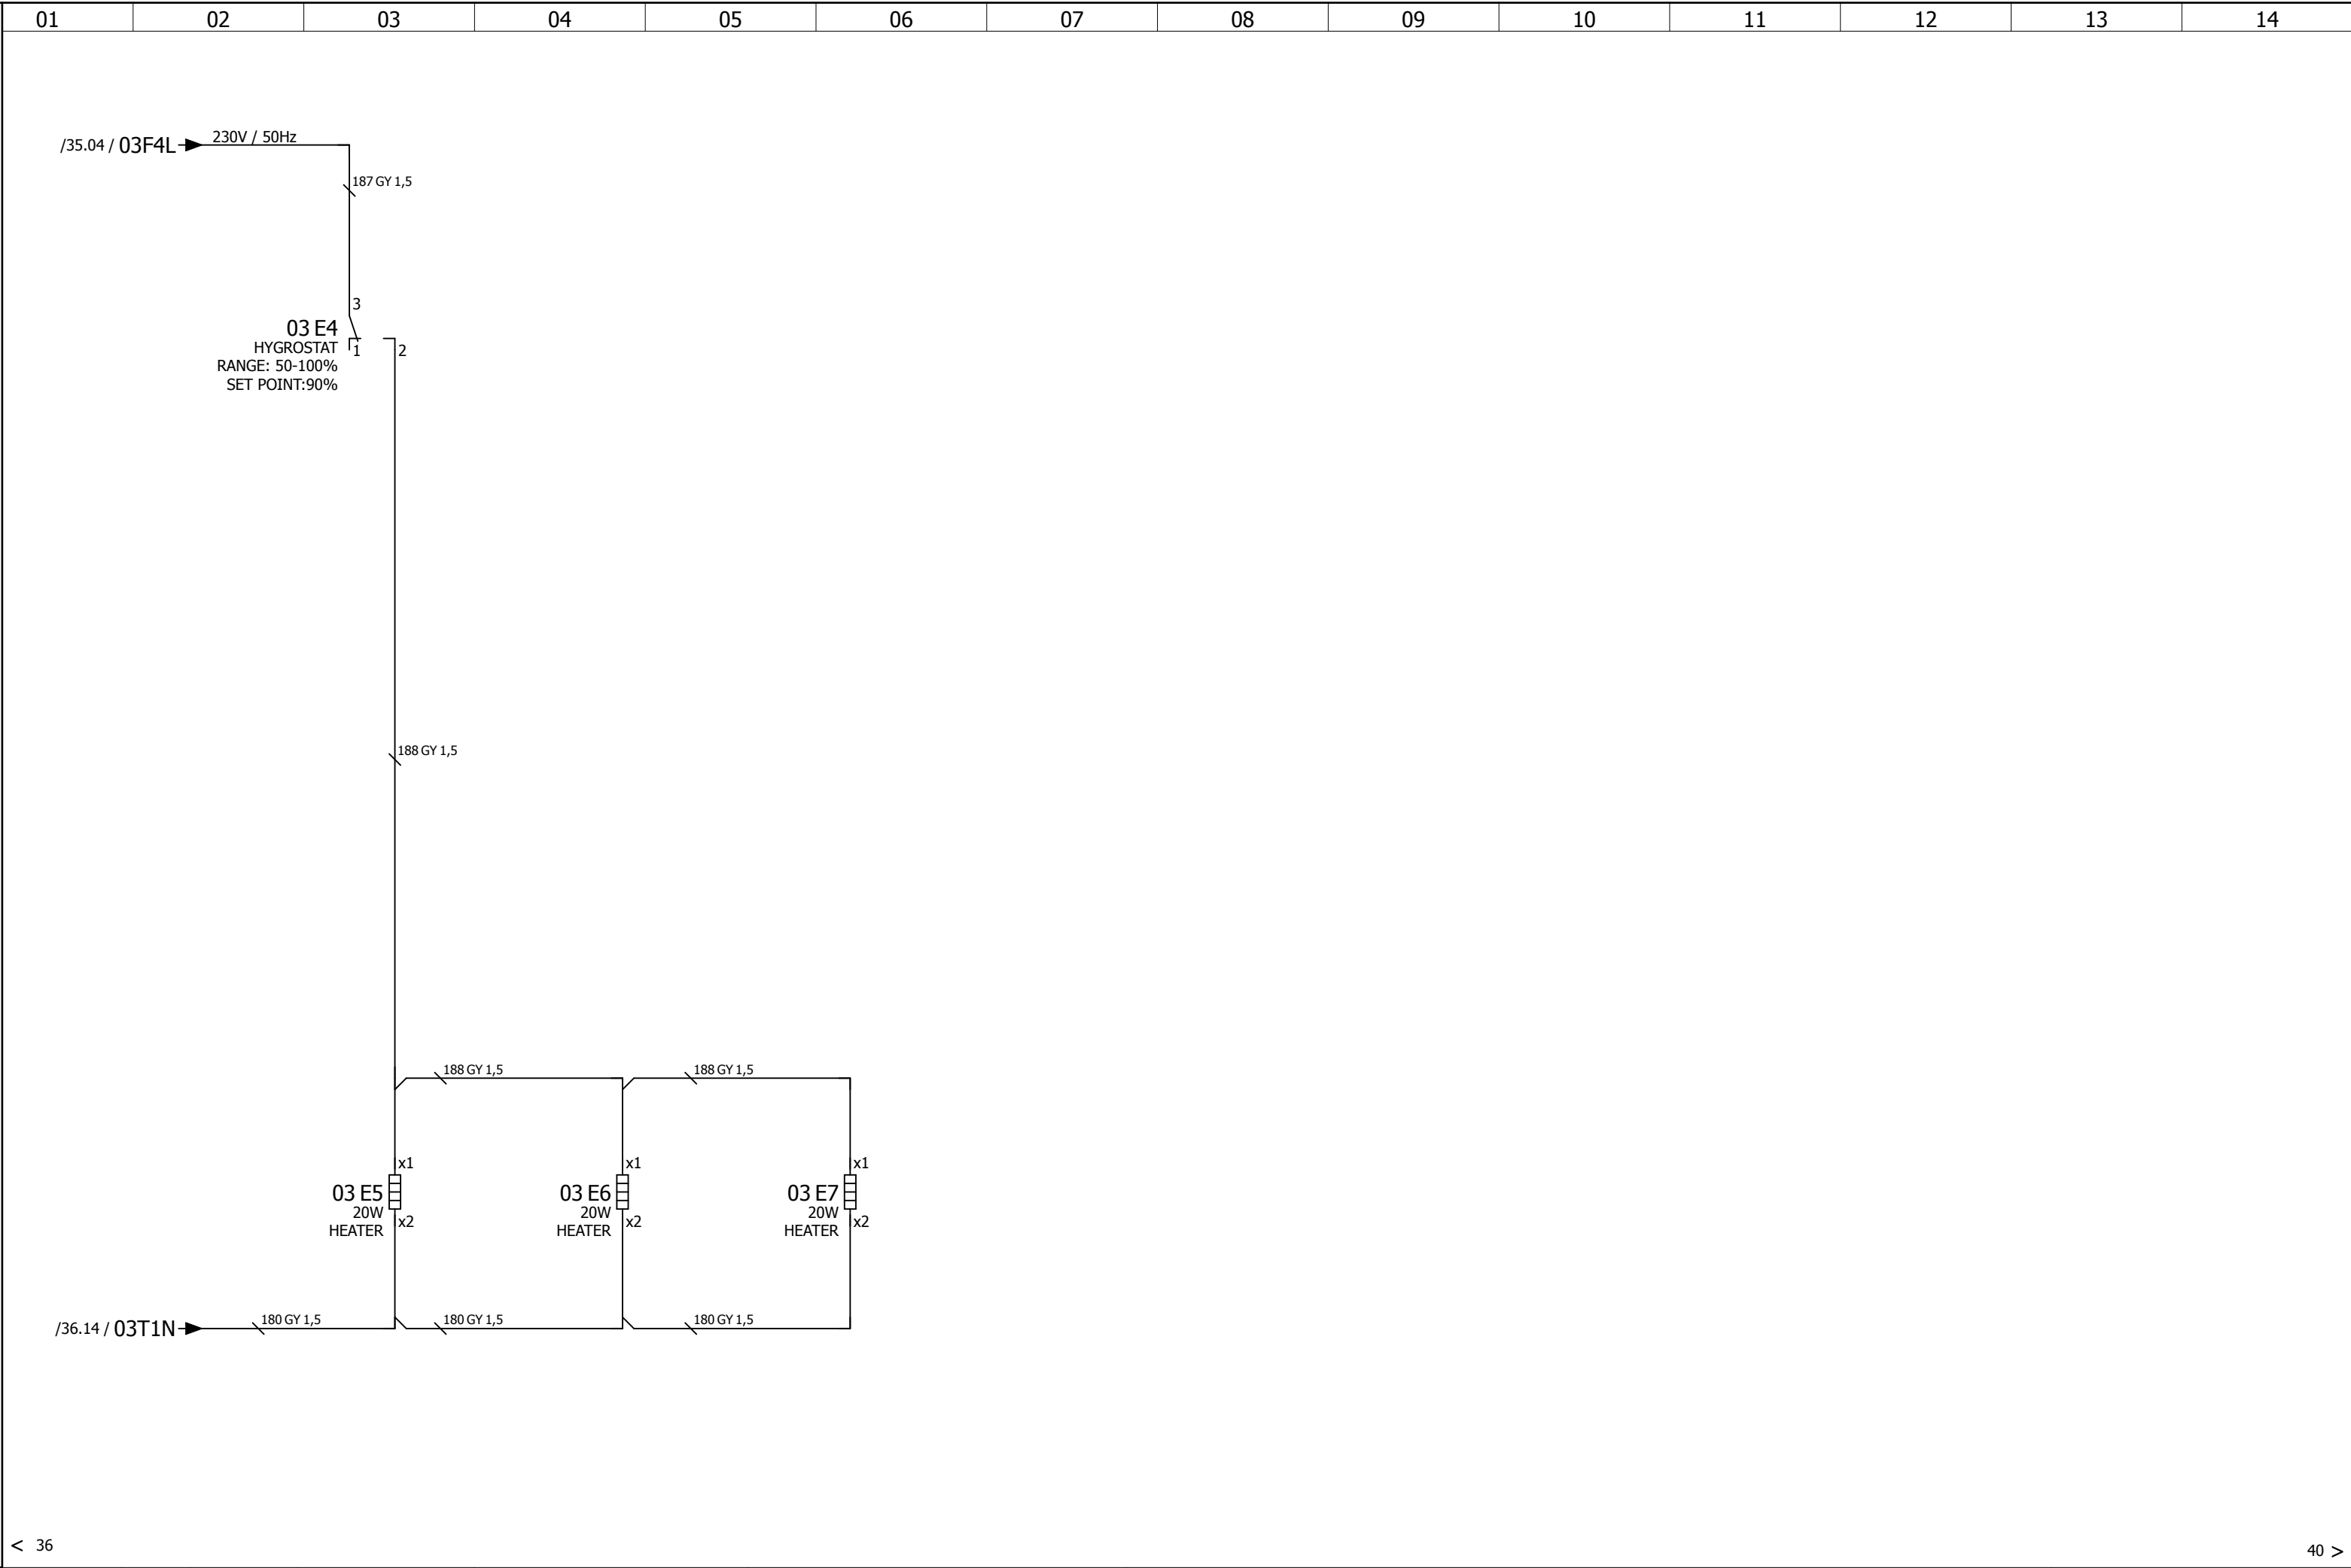


D	24-1-2011	PVR			* NO DELIVERY ALEWIJNSE			ALEWIJNSE MARINE B.V. ENERGIEWEG 46/C 6541 CX NIJMEGEN	IHC DREDGERS BV - TSHD5500 DCI-3 "12EP" EMERGENCY DISTRIBUTION BOARD 3X415V PANEL - HEATING CONTROL CIRCUIT SECTION 3	Yard no : CO1266
M	5-12-2013	IEN	REV	1						Project : 23000143
STAT	AS BUILT				PANEL IP23					Class : LROS/IRS
	05-12-2013	IEN	CHK							Page : 12EP -37

No part of this work may be copied, stored or published without prior written permission of Alewijnse Marine Systems.

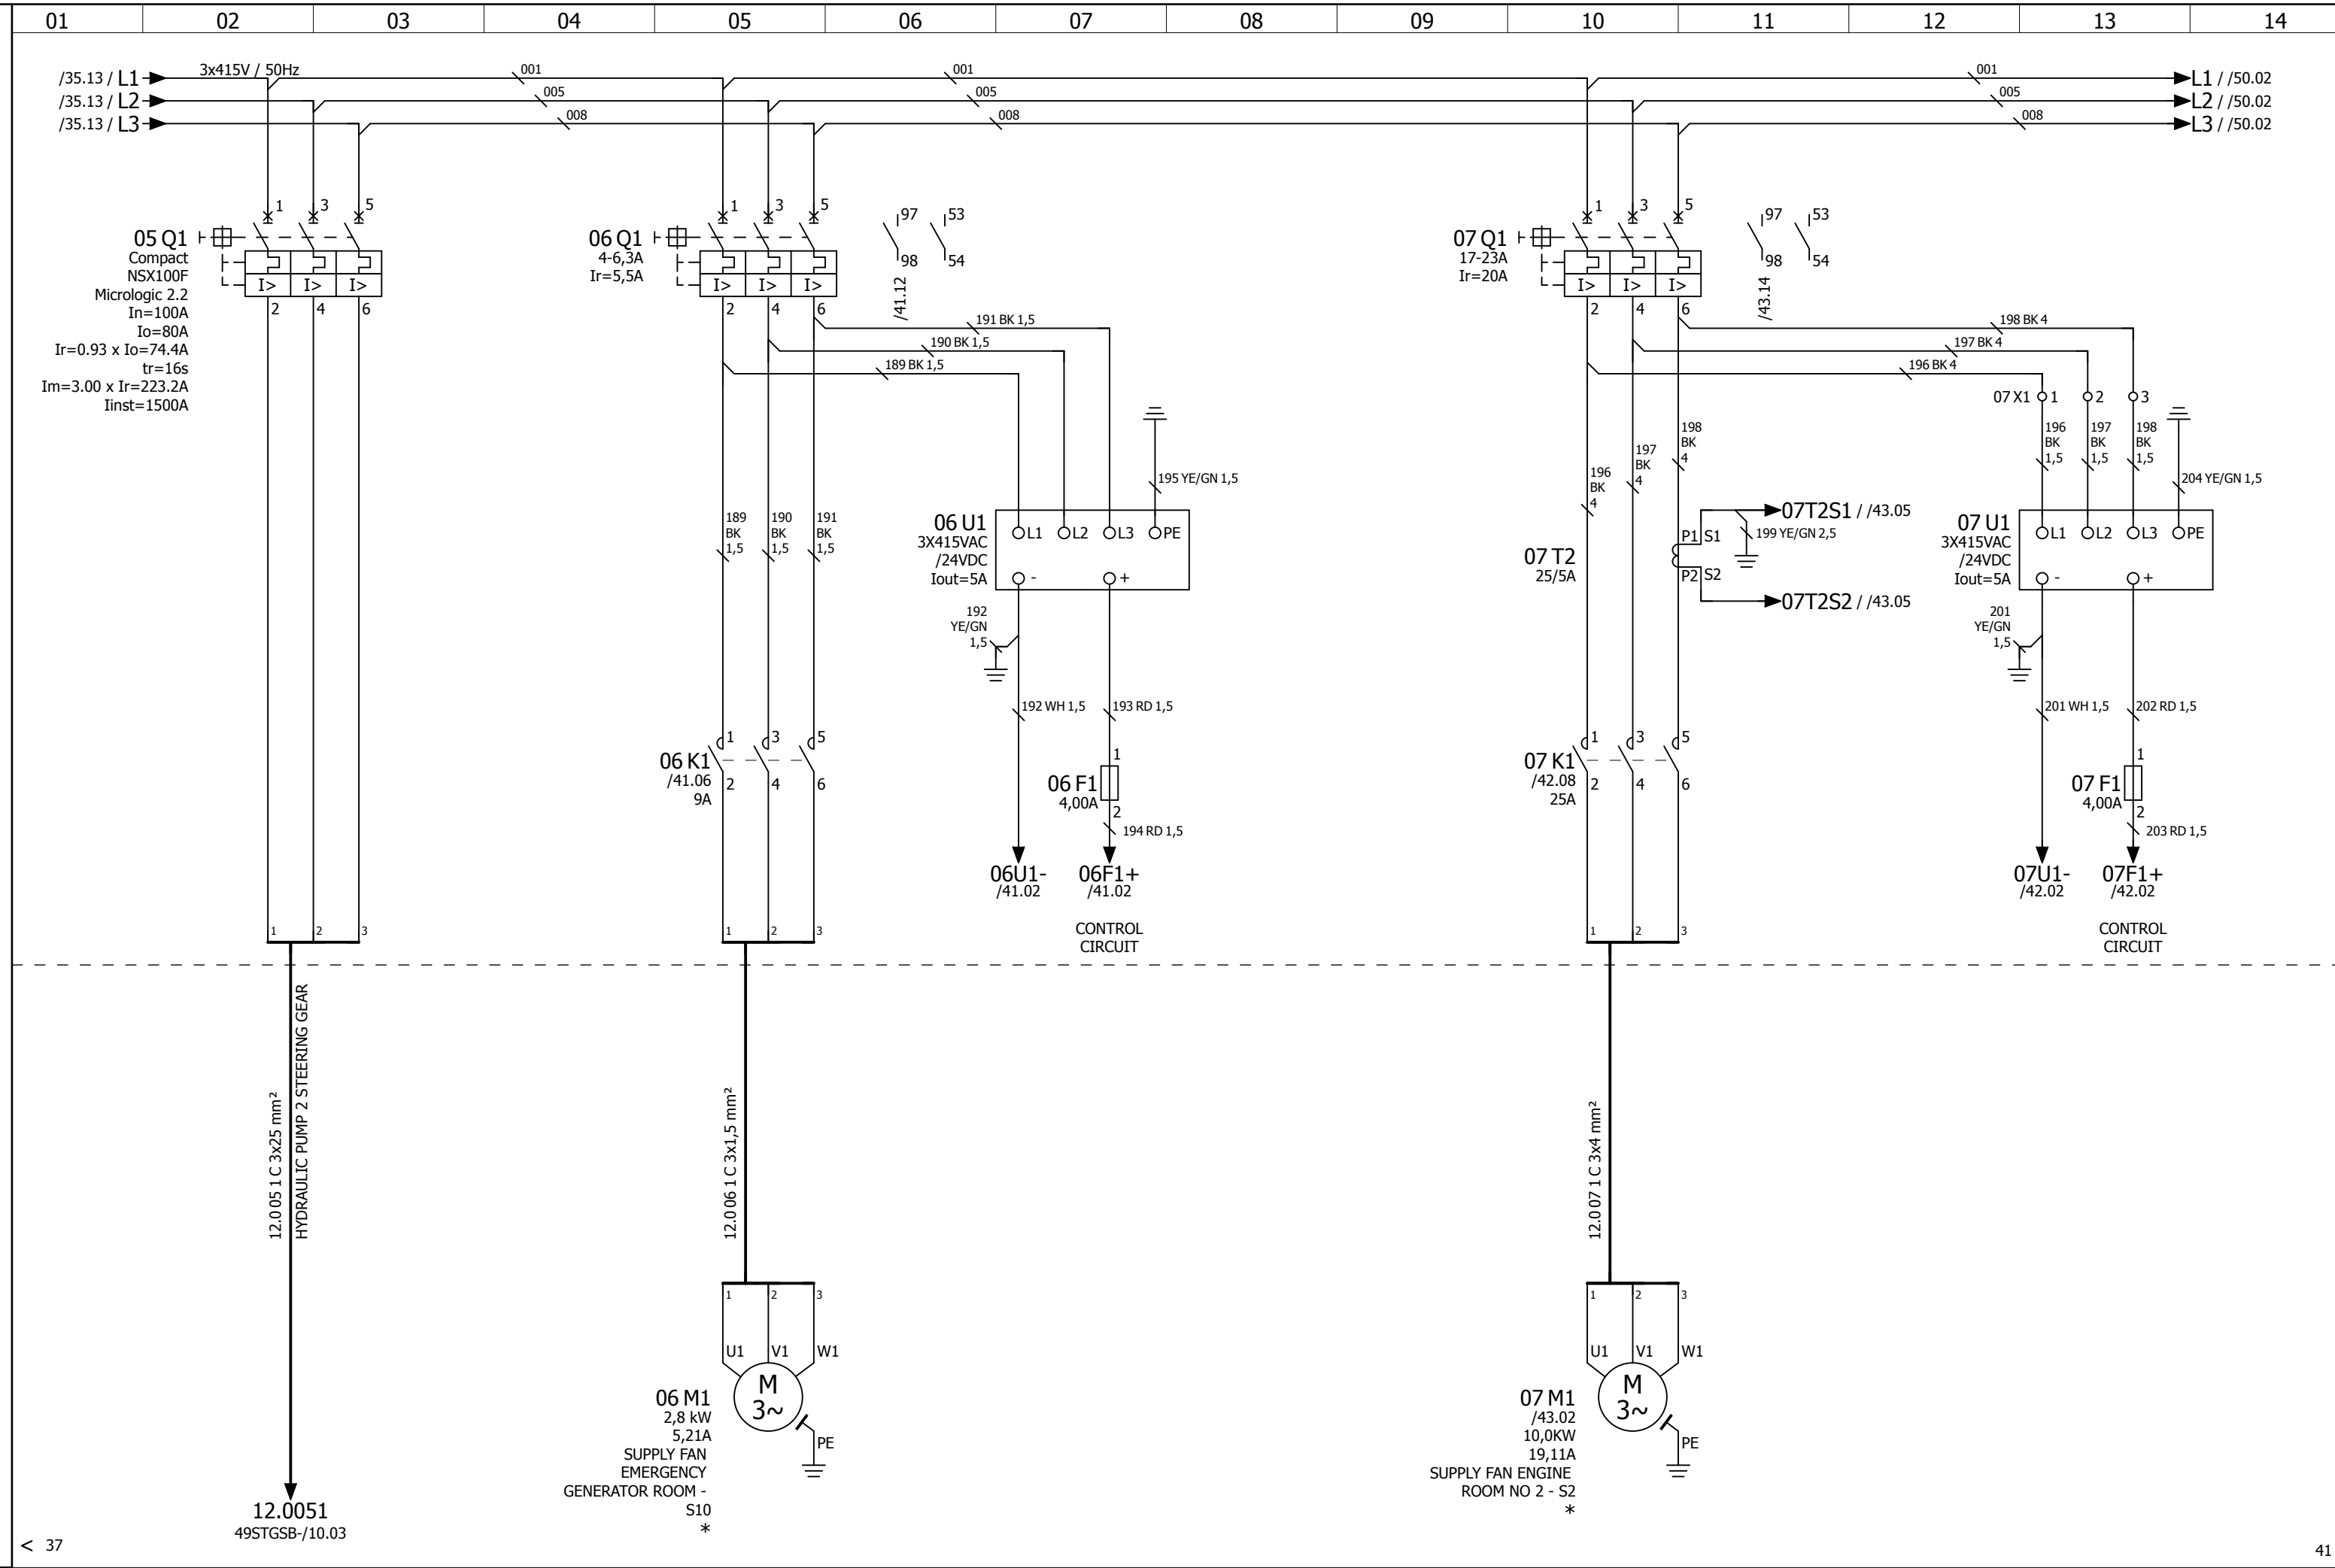


STAT	D	24-1-2011	PVR					ALEWIJNSE MARINE B.V. ENERGIEWEG 46/C 6541 CX NIJMEGEN	IHC DREDGERS BV - TSHD5500 DCI-3 "12EP" EMERGENCY DISTRIBUTION BOARD 3X415V STARTERS / DISTRIBUTION MAIN CIRCUIT SECTION 3	Yard no : CO1266
	M	5-12-2013	IEN	REV	1					Project : 23000143
	AS BUILT					PANEL IP23				Class : LROS/IRS
		05-12-2013	IEN	CHK						Page : 12EP -40

No part of this work may be copied, stored or published without prior written permission of Alewijnse Marine Systems.

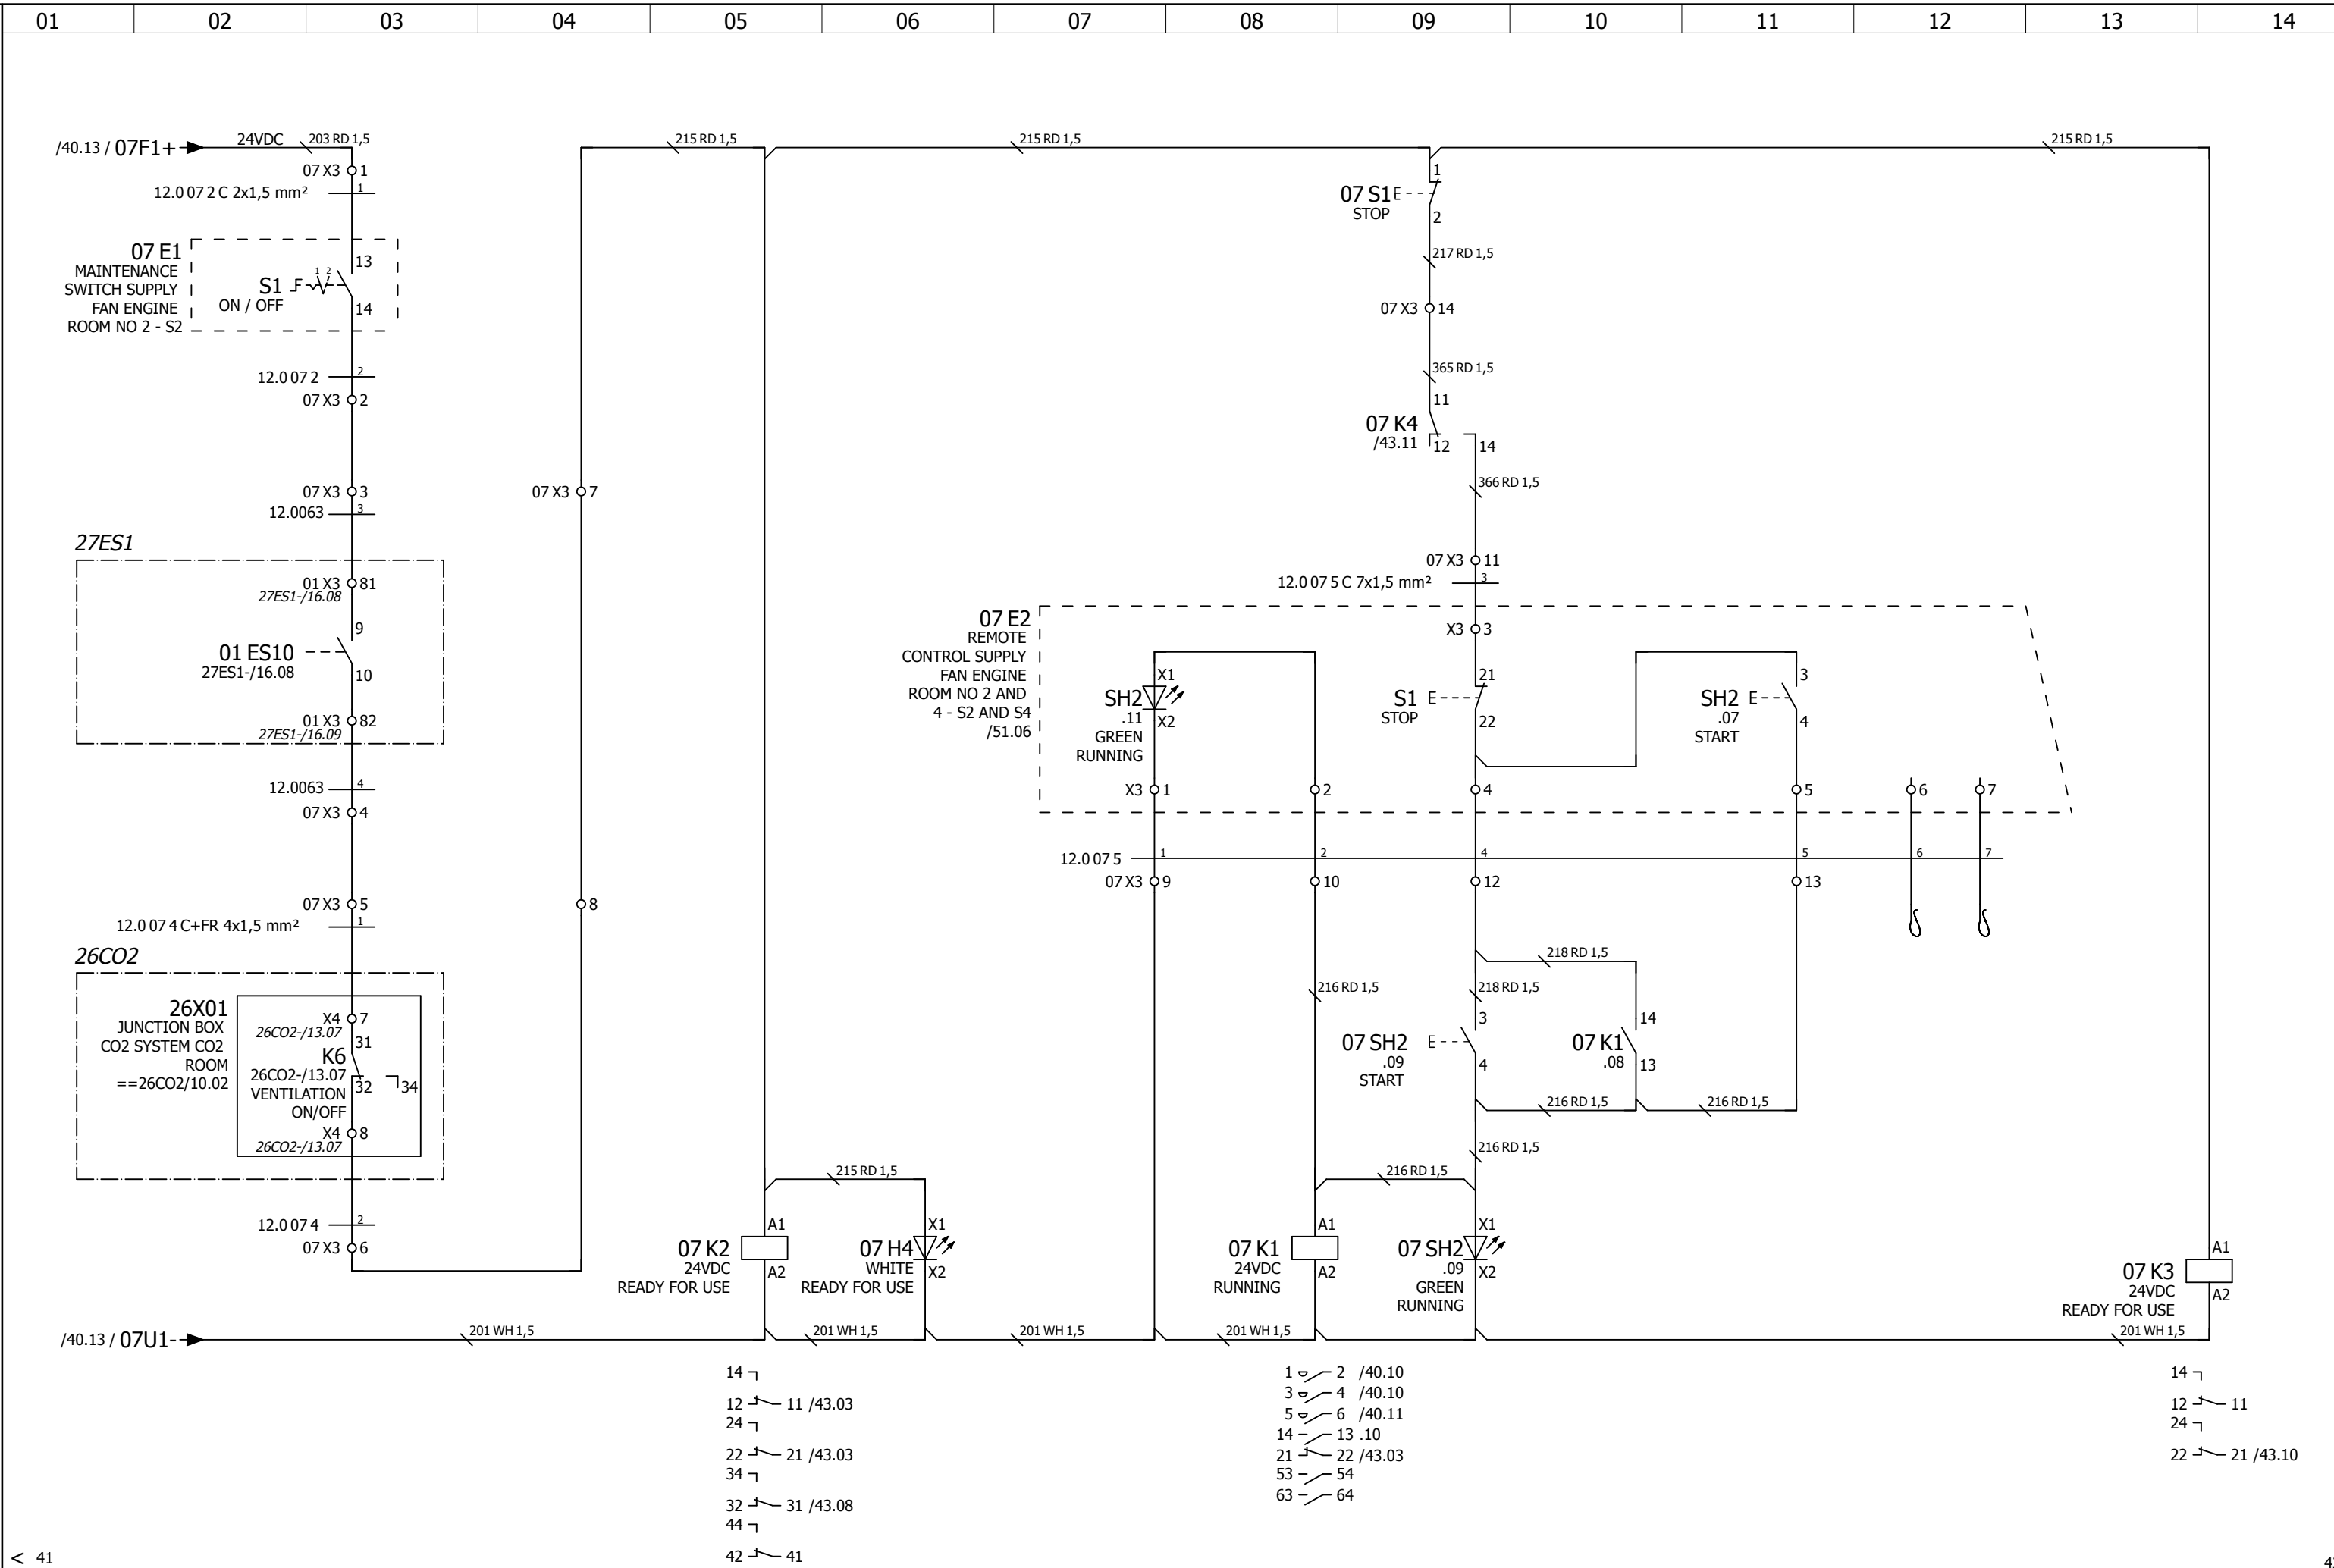


50 >

No part of this work may be copied, stored or published without prior written permission of Alewijnse Marine Systems.

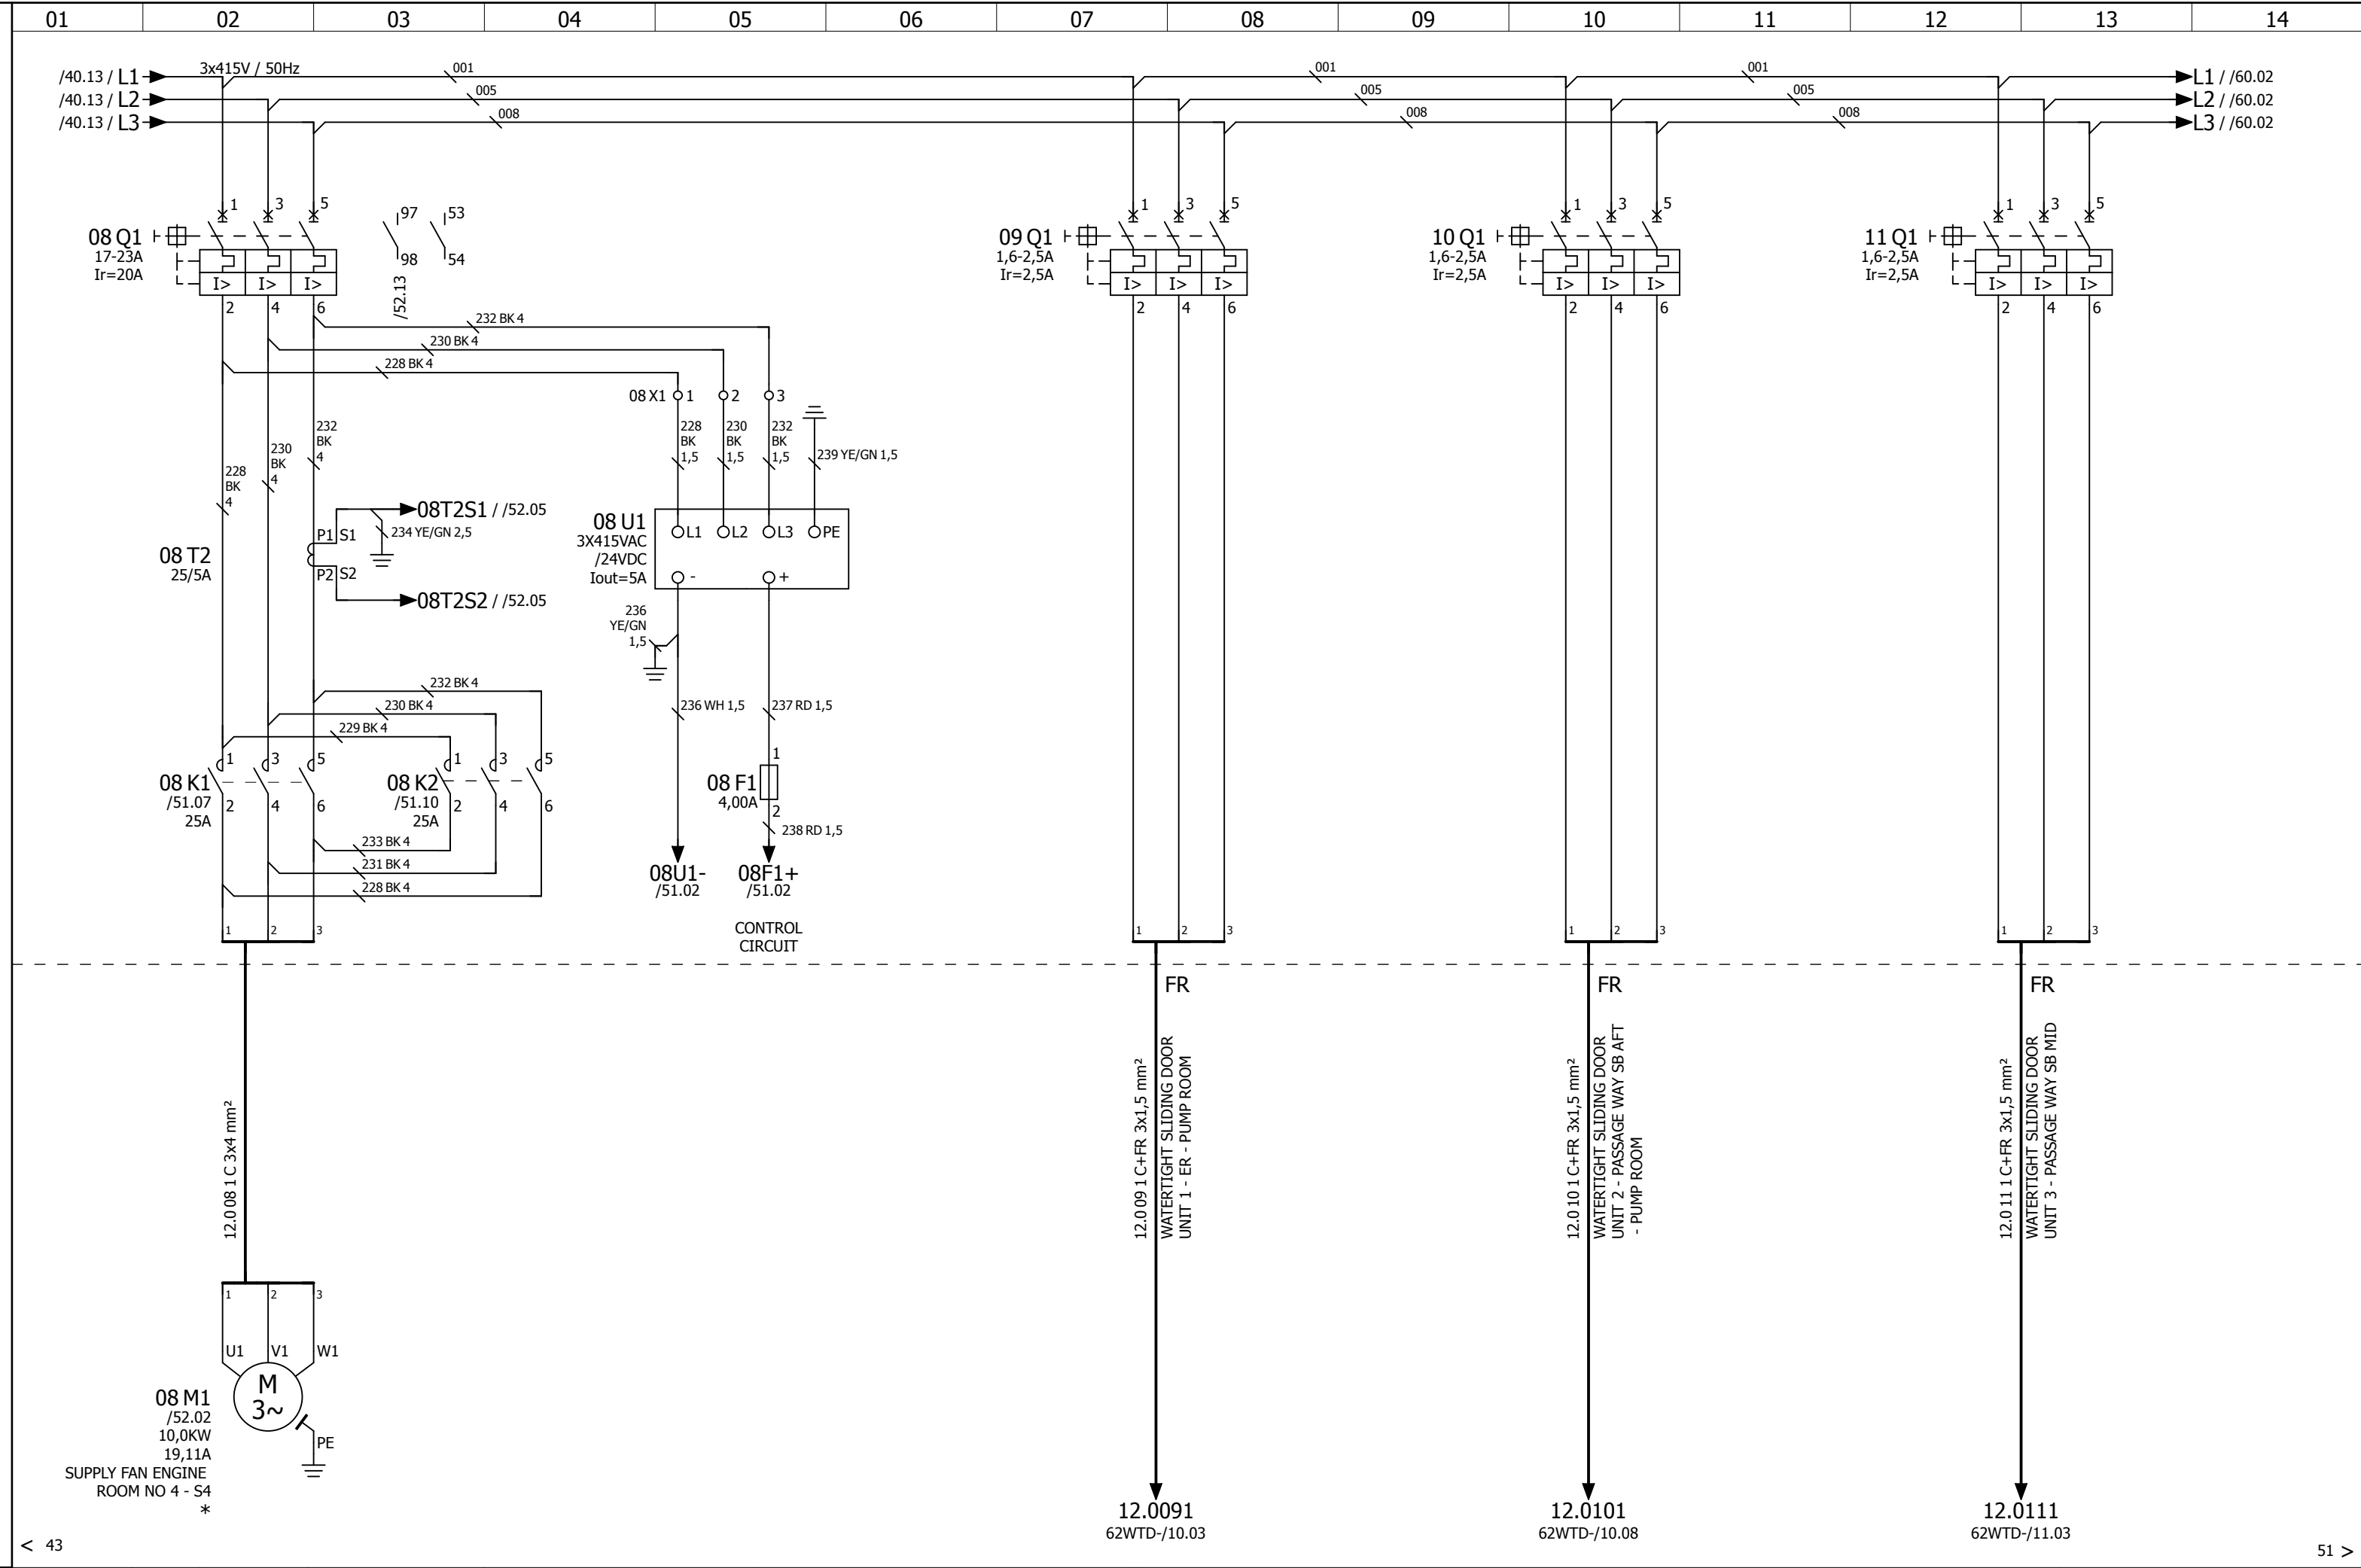


D	24-1-2011	PVR			* NO DELIVERY ALEWIJNSE			ALEWIJNSE MARINE B.V. ENERGIEWEG 46/C 6541 CX NIJMEGEN	IHC DREDGERS BV - TSHD5500 DCI-3 "12EP" EMERGENCY DISTRIBUTION BOARD 3X415V STARTERS / DISTRIBUTION MAIN CIRCUIT SECTION 3	Yard no : CO1266
M	5-12-2013	IEN	REV	1	PANEL IP23					Project : 23000143
STAT	AS BUILT									Class : LROS/IRS
	05-12-2013	IEN	CHK							Page : 12EP -50


No part of this work may be copied, stored or published without prior written permission of Alewijnse Marine Systems.

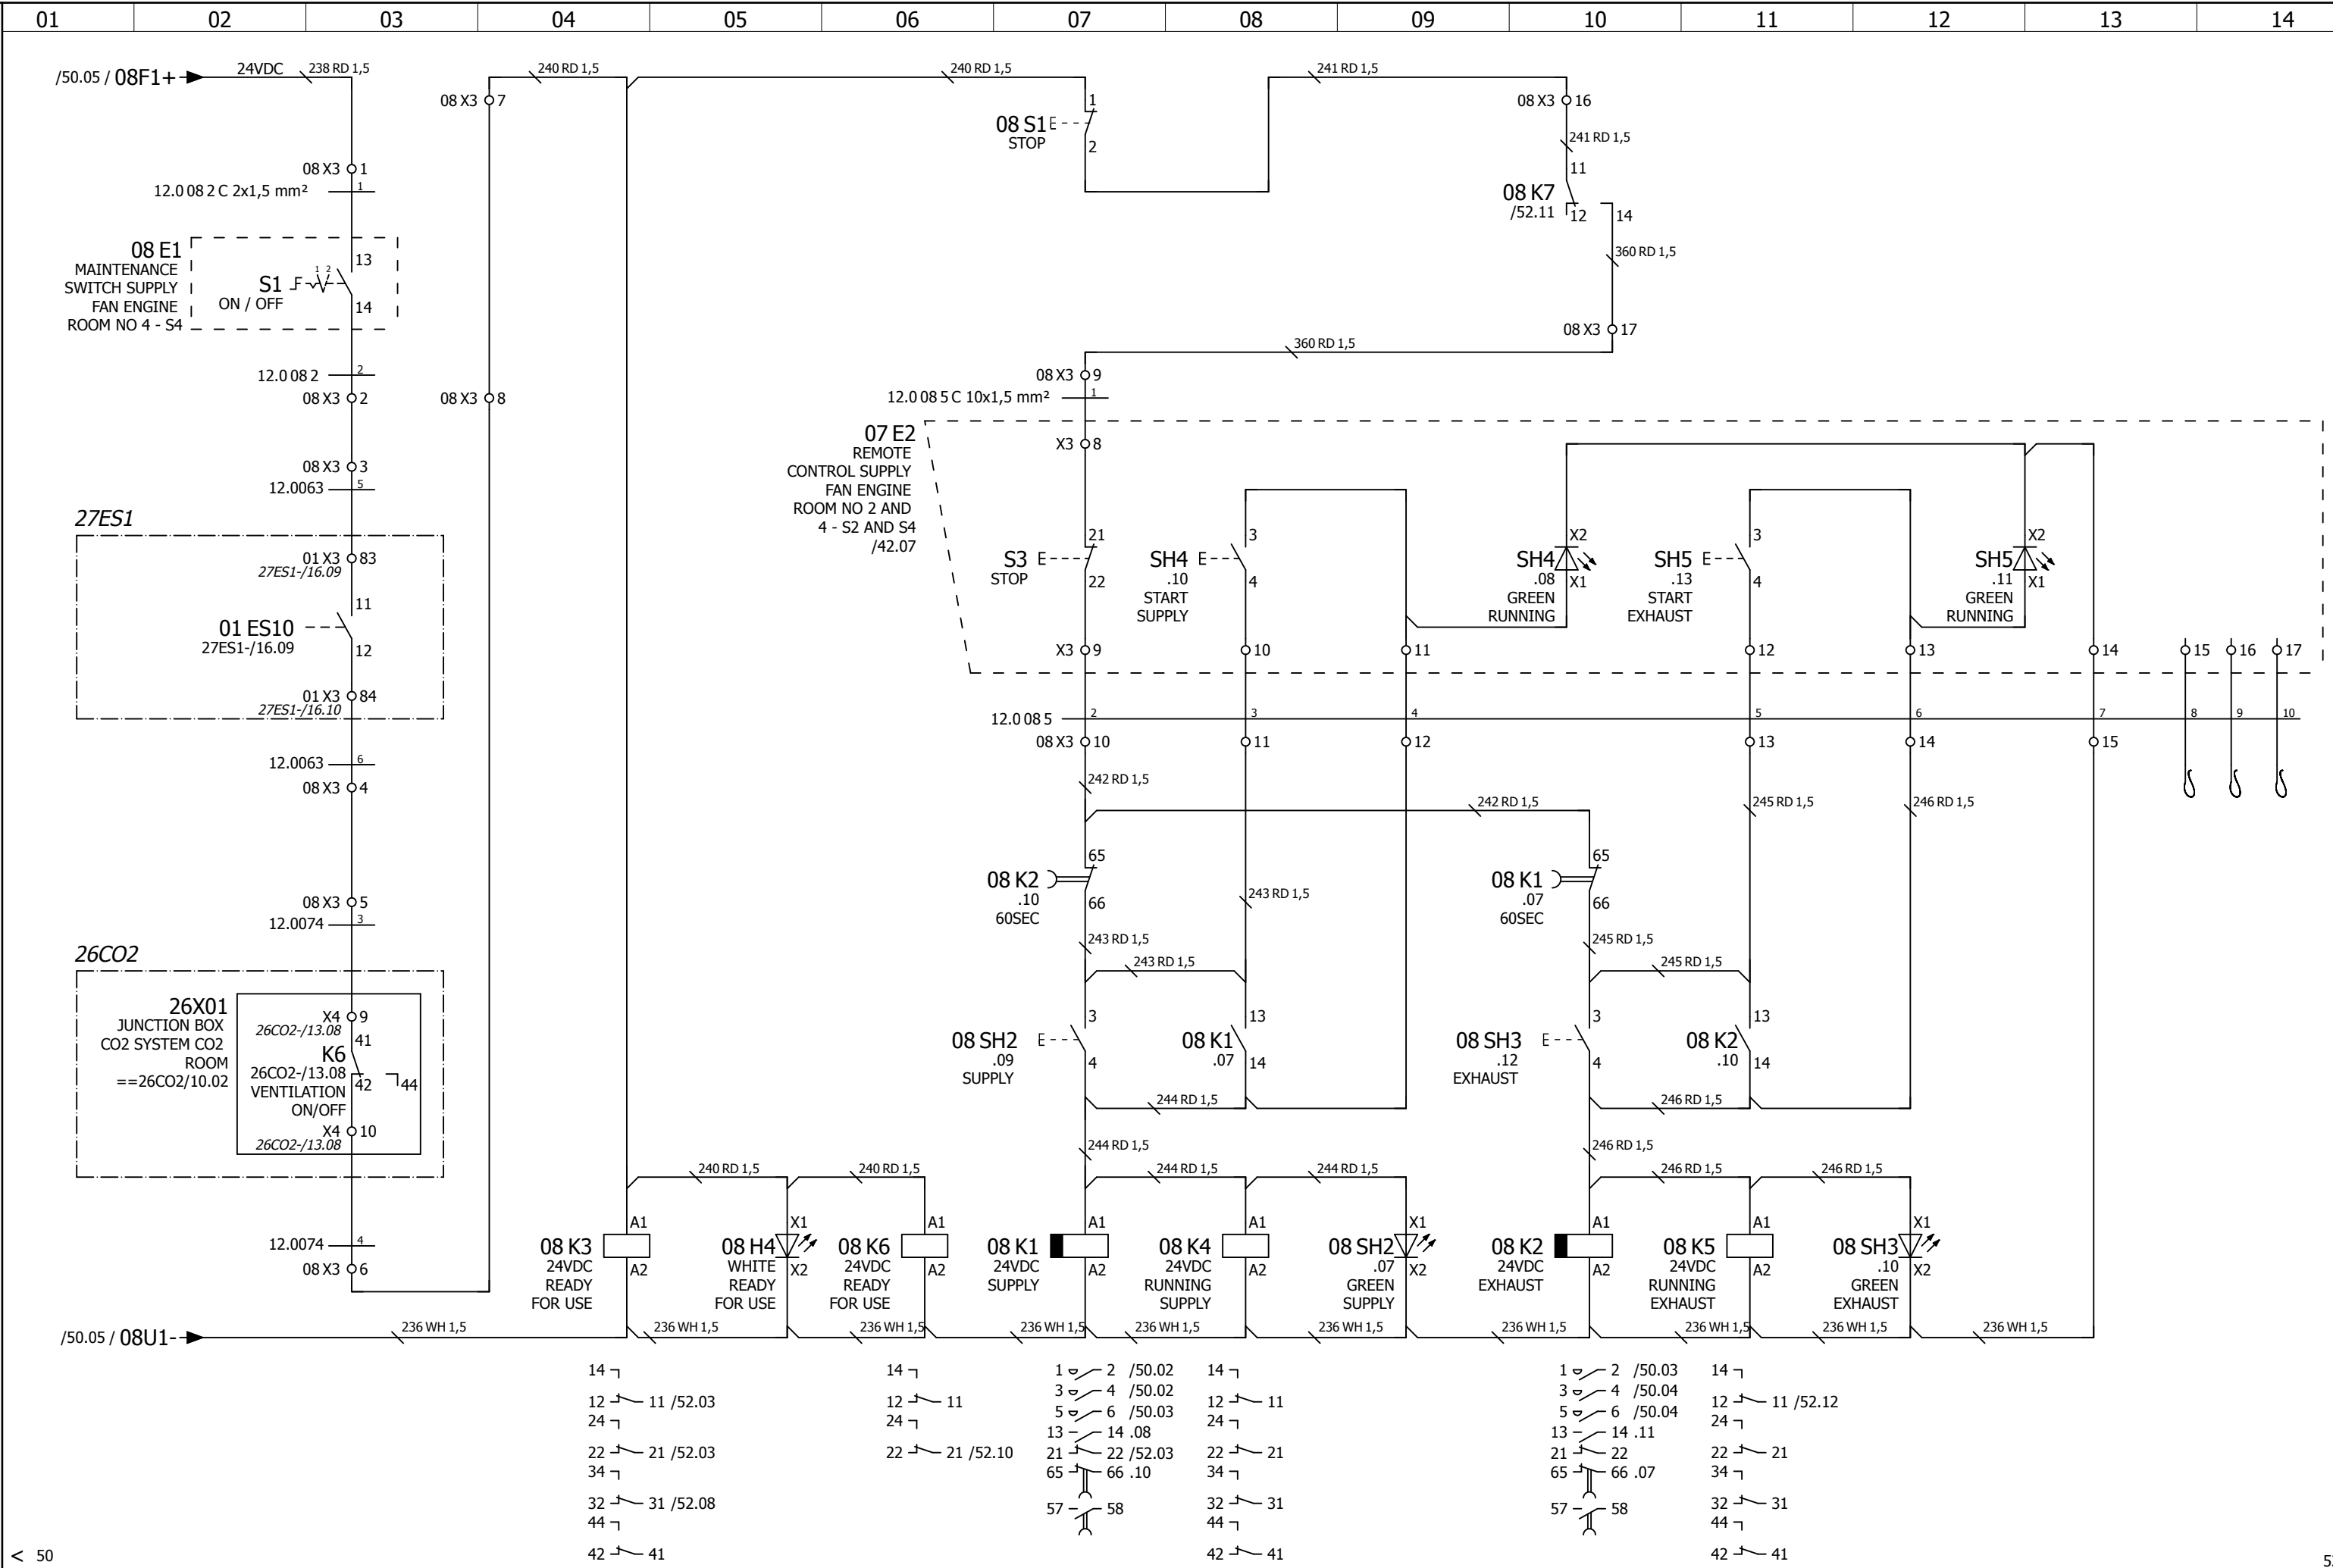

D	24-1-2011	PVR			* NO DELIVERY ALEWIJNSE			ALEWIJNSE MARINE B.V. ENERGIEWEG 46/C 6541 CX NIJMEGEN	IHC DREDGERS BV - TSHD5500 DCI-3 "12EP" EMERGENCY DISTRIBUTION BOARD 3X415V S4 - ENGINE ROOM SUPPLY FAN SB REVERSIBLE CONTROL CIRCUIT SECTION 3	Yard no : CO1266
M	5-12-2013	IEN	REV	1						Project : 23000143
STAT	AS BUILT				PANEL IP23			Class : LROS/IRS		
	05-12-2013	IEN	CHK					Page : 12EP -51		

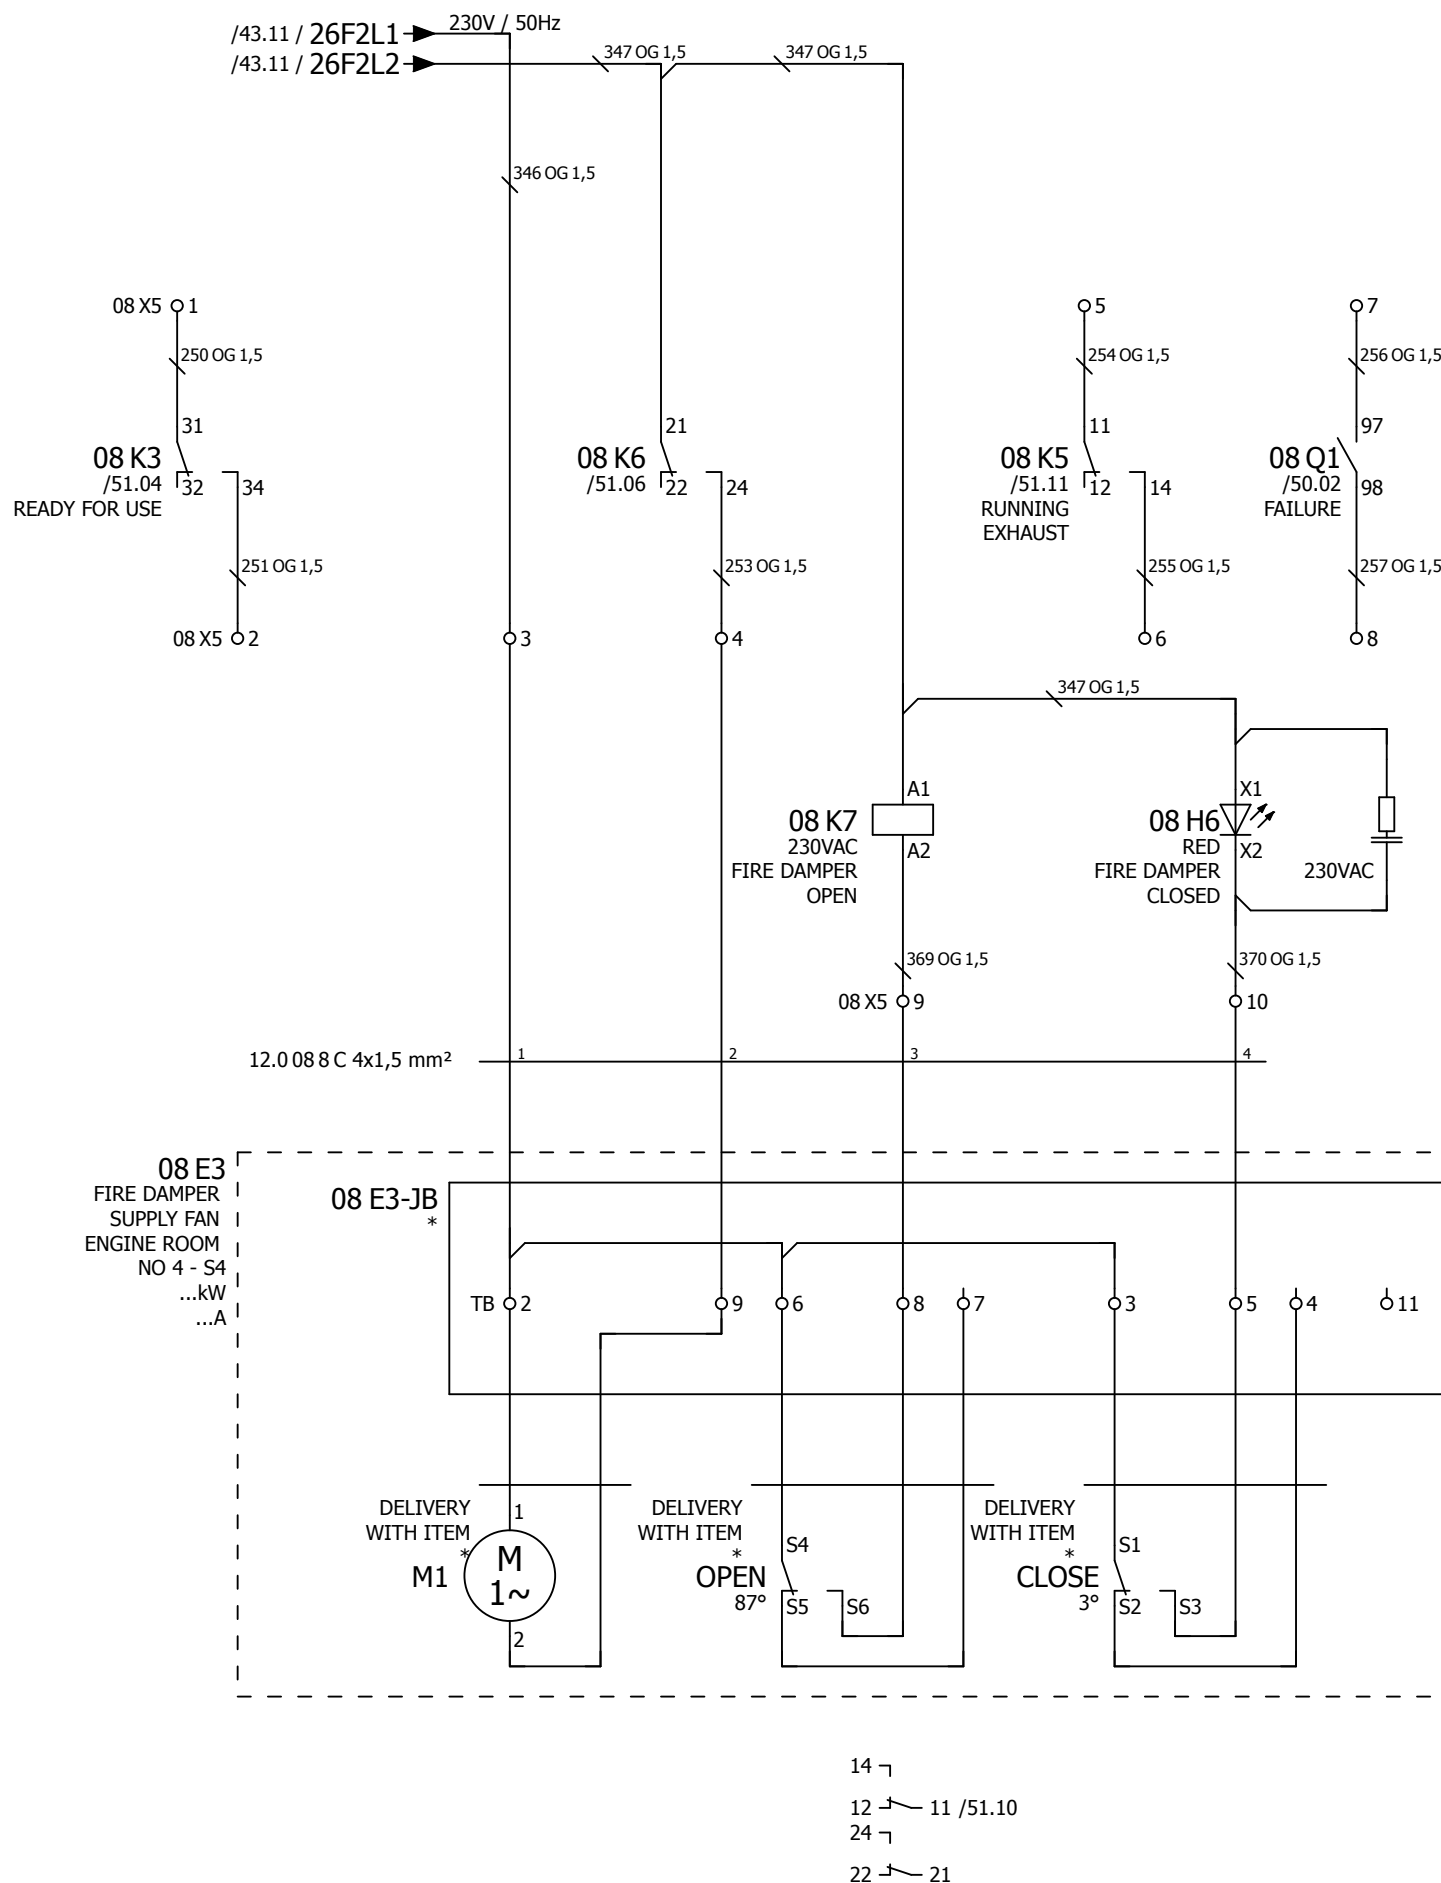


No part of this work may be copied, stored or published without prior written permission of Alewijnse Marine Systems.

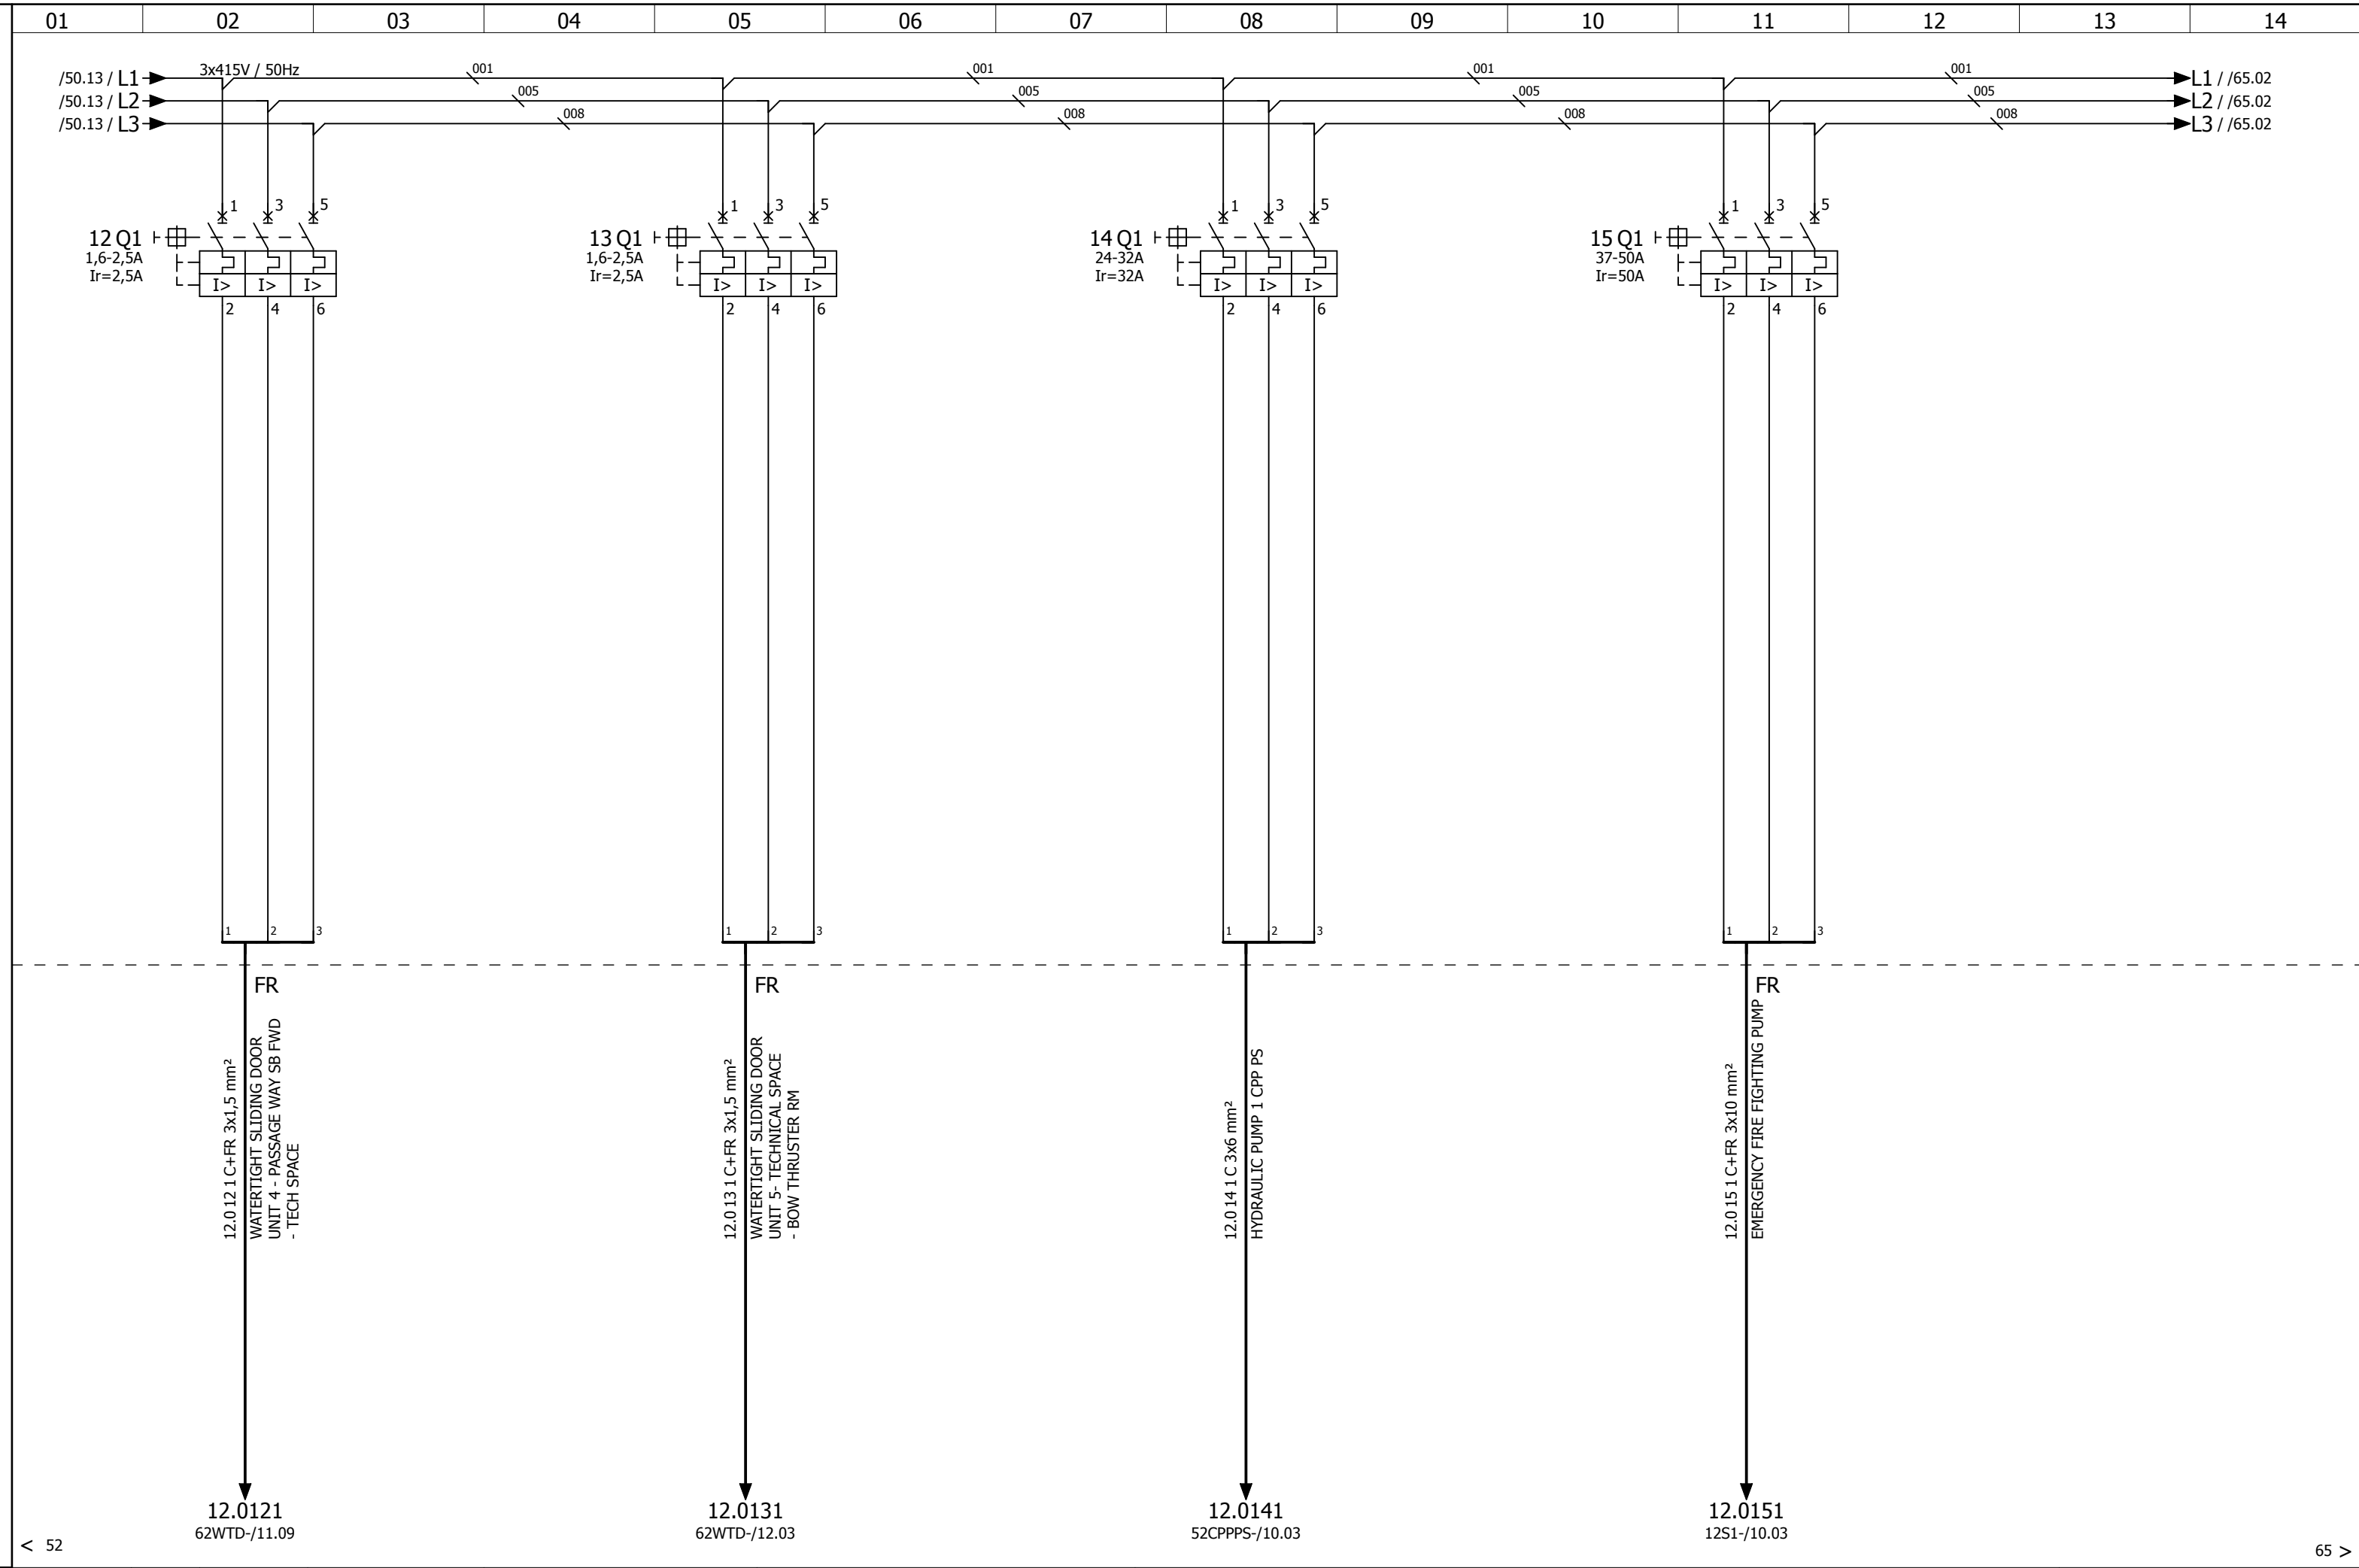


D	24-1-2011	PVR			* NO DELIVERY ALEWIJNSE			ALEWIJNSE MARINE B.V. ENERGIEWEG 46/C 6541 CX NIJMEGEN	IHC DREDGERS BV - TSHD5500 DCI-3 "12EP" EMERGENCY DISTRIBUTION BOARD 3X415V STARTERS / DISTRIBUTION MAIN CIRCUIT SECTION 3	Yard no : CO1266
M	5-12-2013	IEN	REV	1						Project : 23000143
STAT	AS BUILT				PANEL IP23			Class : LROS/IRS		
	05-12-2013	IEN	CHK					Page : 12EP -60		

No part of this work may be copied, stored or published without prior written permission of Alewijnse Marine Systems.

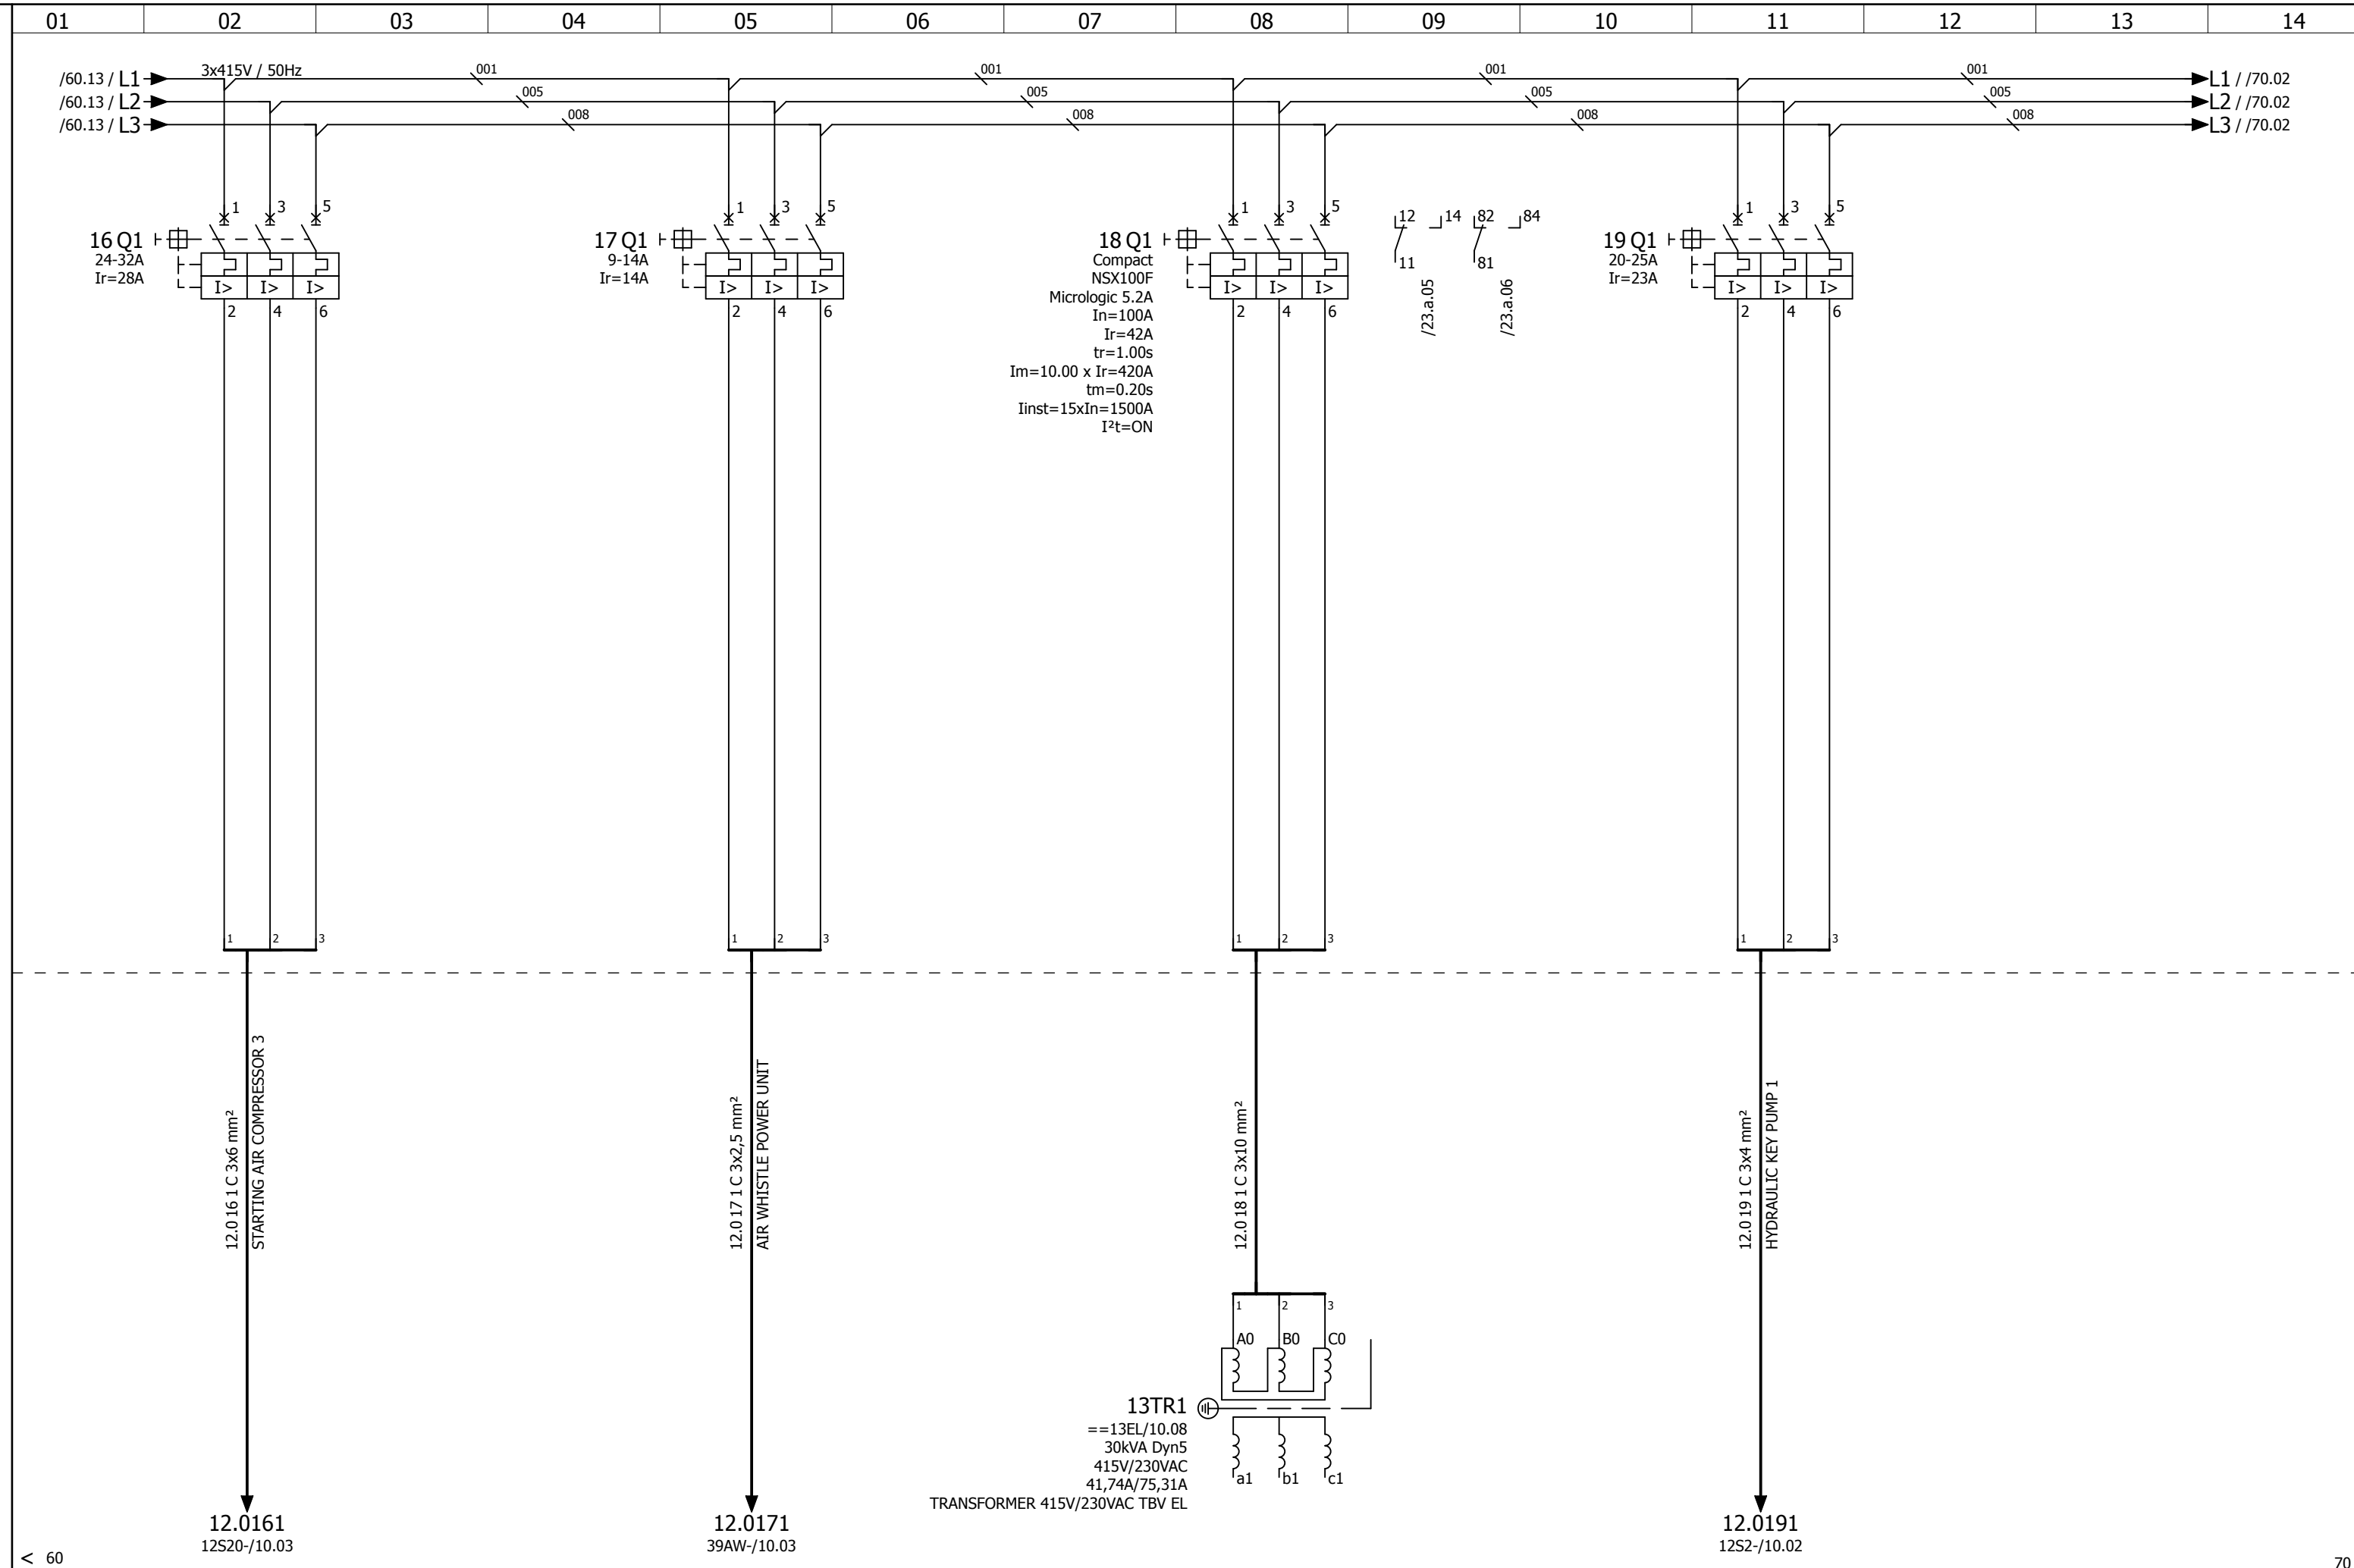

No part of this work may be copied, stored or published without prior written permission of Alewijnse Marine Systems.

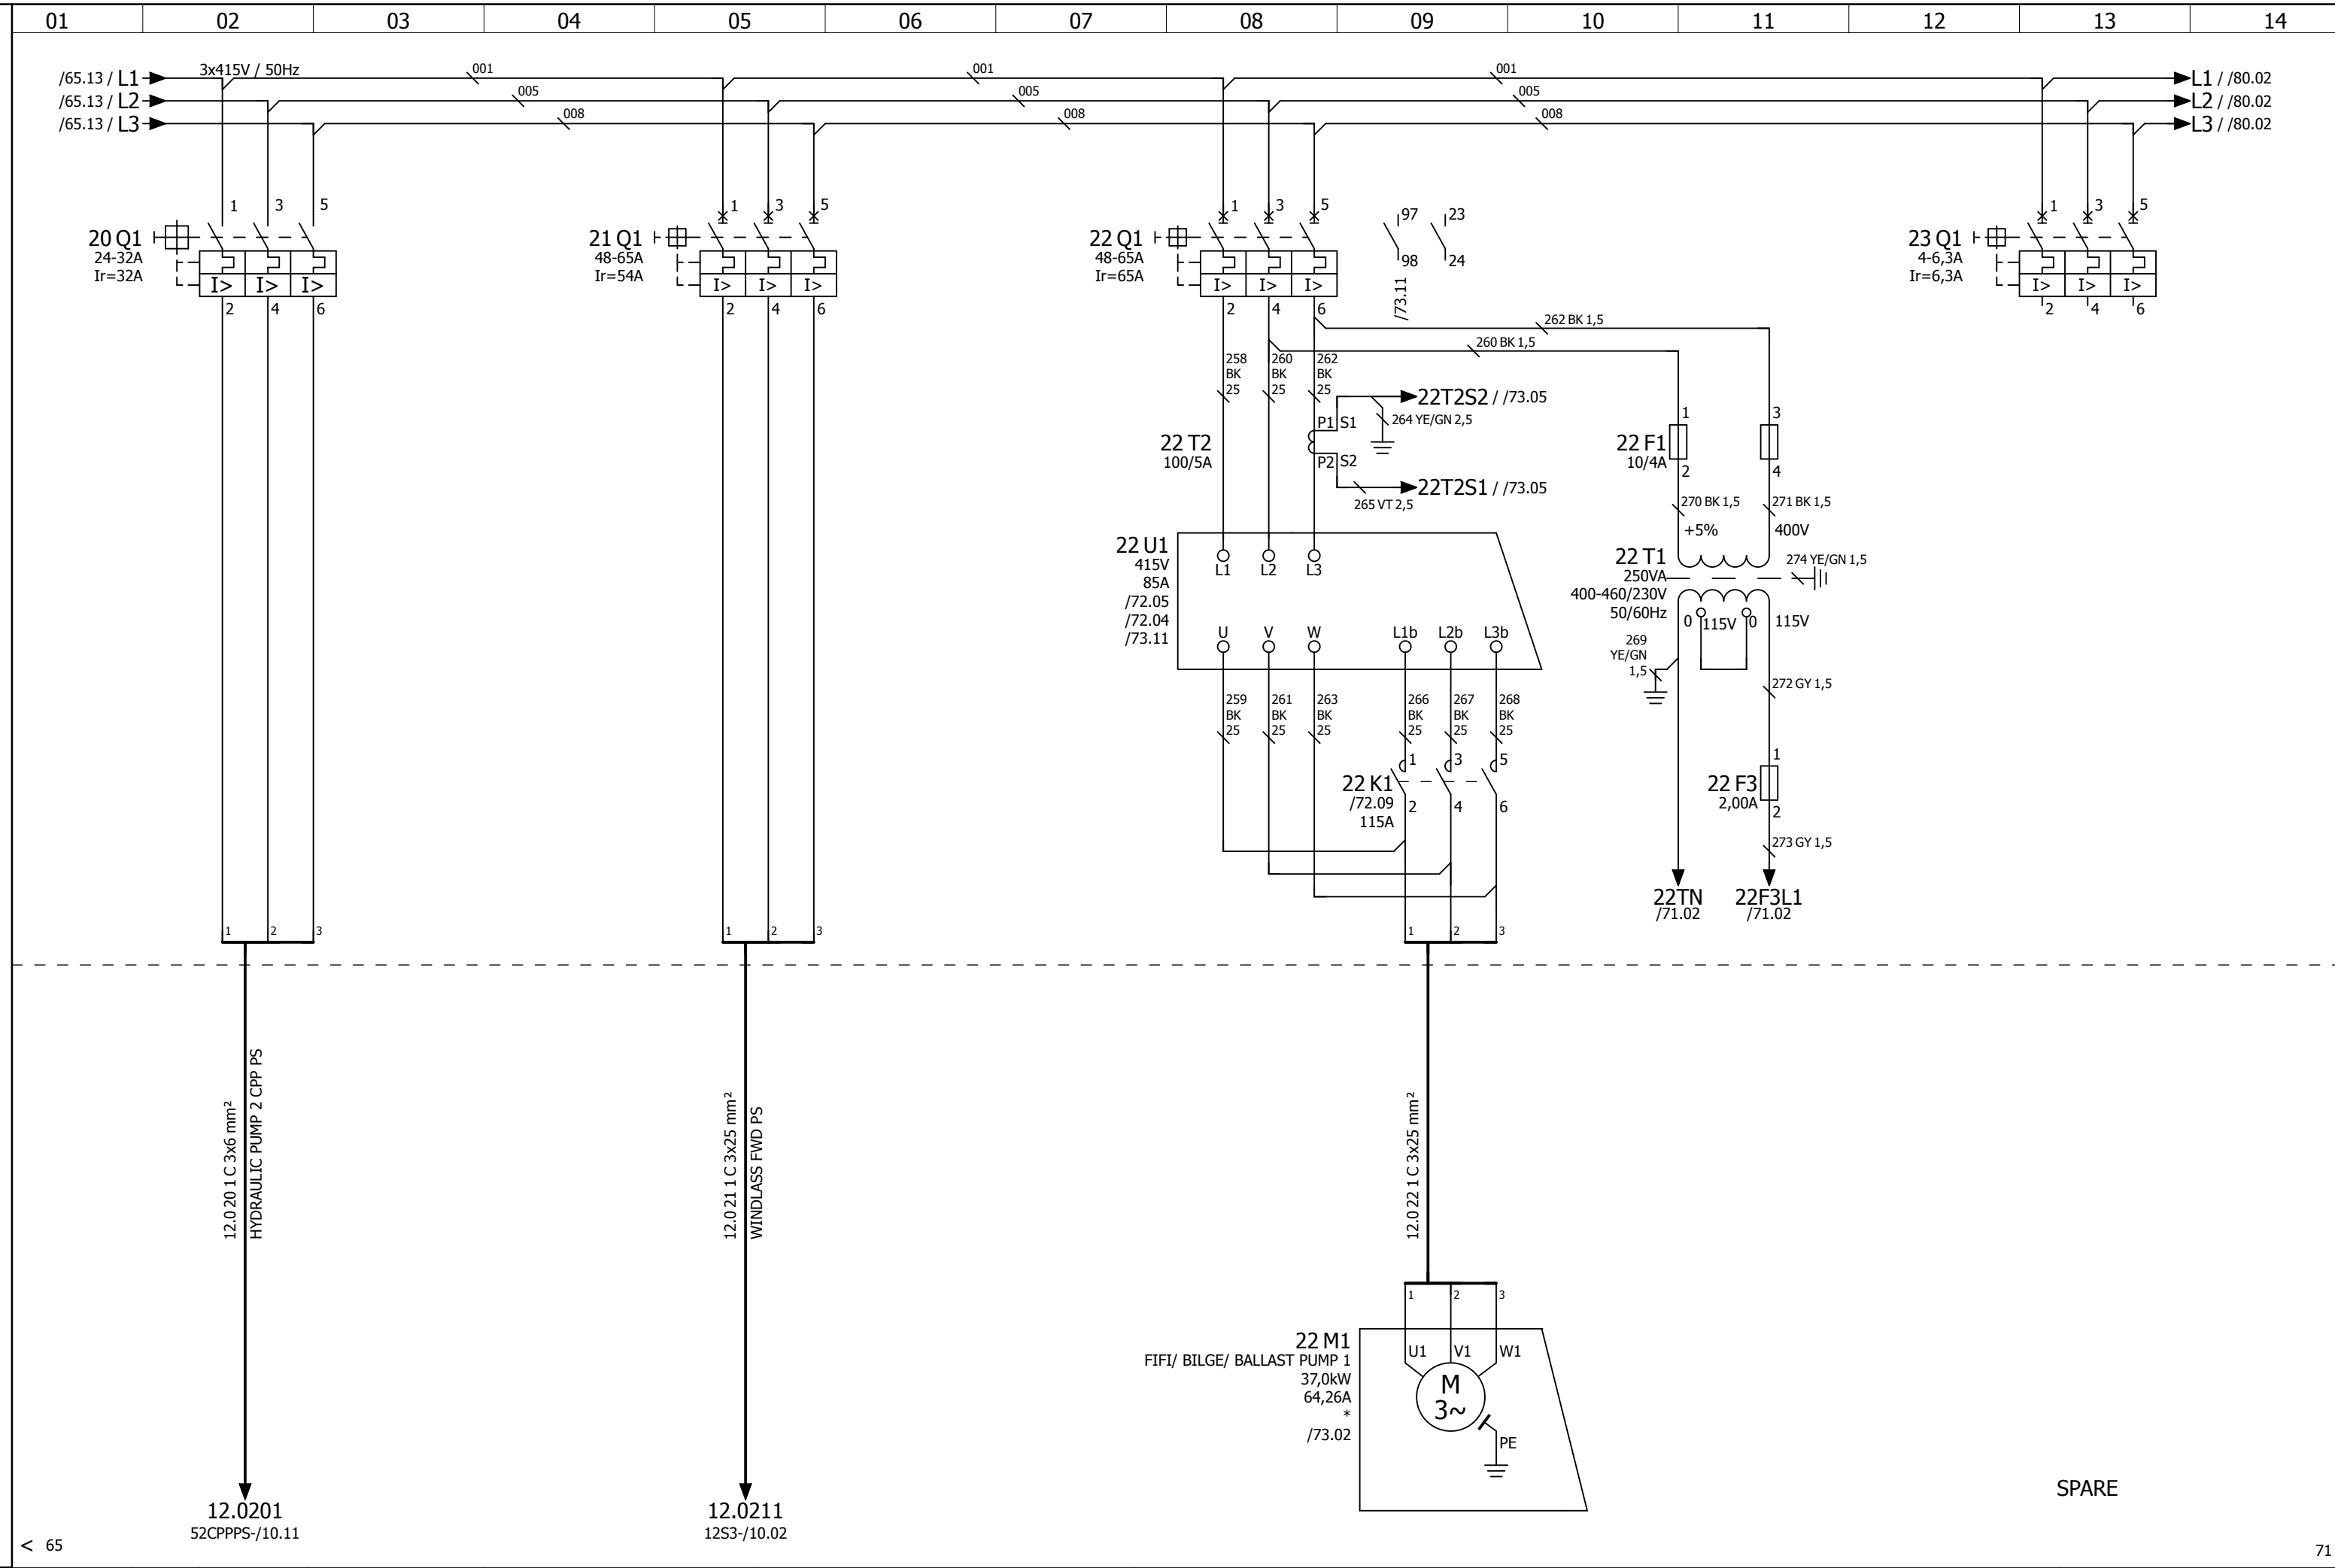


D	24-1-2011	PVR			* NO DELIVERY ALEWIJNSE	  ALEWIJNSE MARINE B.V. ENERGIEWEG 46/C 6541 CX NIJMEGEN	IHC DREDGERS BV - TSHD5500 DCI-3 "12EP" EMERGENCY DISTRIBUTION BOARD 3X415V STARTERS / DISTRIBUTION MAIN CIRCUIT SECTION 3	Yard no : CO1266
M	5-12-2013	IEN	REV	1				Project : 23000143
STAT	AS BUILT				PANEL IP23			Class : LROS/IRS
	05-12-2013	IEN	CHK					Page : 12EP -70



D M STAT	24-1-2011	PVR			* NO DELIVERY ALEWIJNSE			IHC DREDGERS BV - TSHD5500 DCI-3 "12EP" EMERGENCY DISTRIBUTION BOARD 3X415V FIFI/ BALLAST/ EMERGENCY BILGE PUMP CONTROL CIRCUIT SECTION 3	Yard no : CO1266
	5-12-2013	IEN	REV	1					Project : 23000143
	AS BUILT				PANEL IP23	Class : LROS/IRS			
	05-12-2013	IEN	CHK		ALEWIJNSE MARINE B.V. ENERGIEWEG 46/C 6541 CX NIJMEGEN	Page : 12EP -71			

No part of this work may be copied, stored or published without prior written permission of Alewijnse Marine Systems.

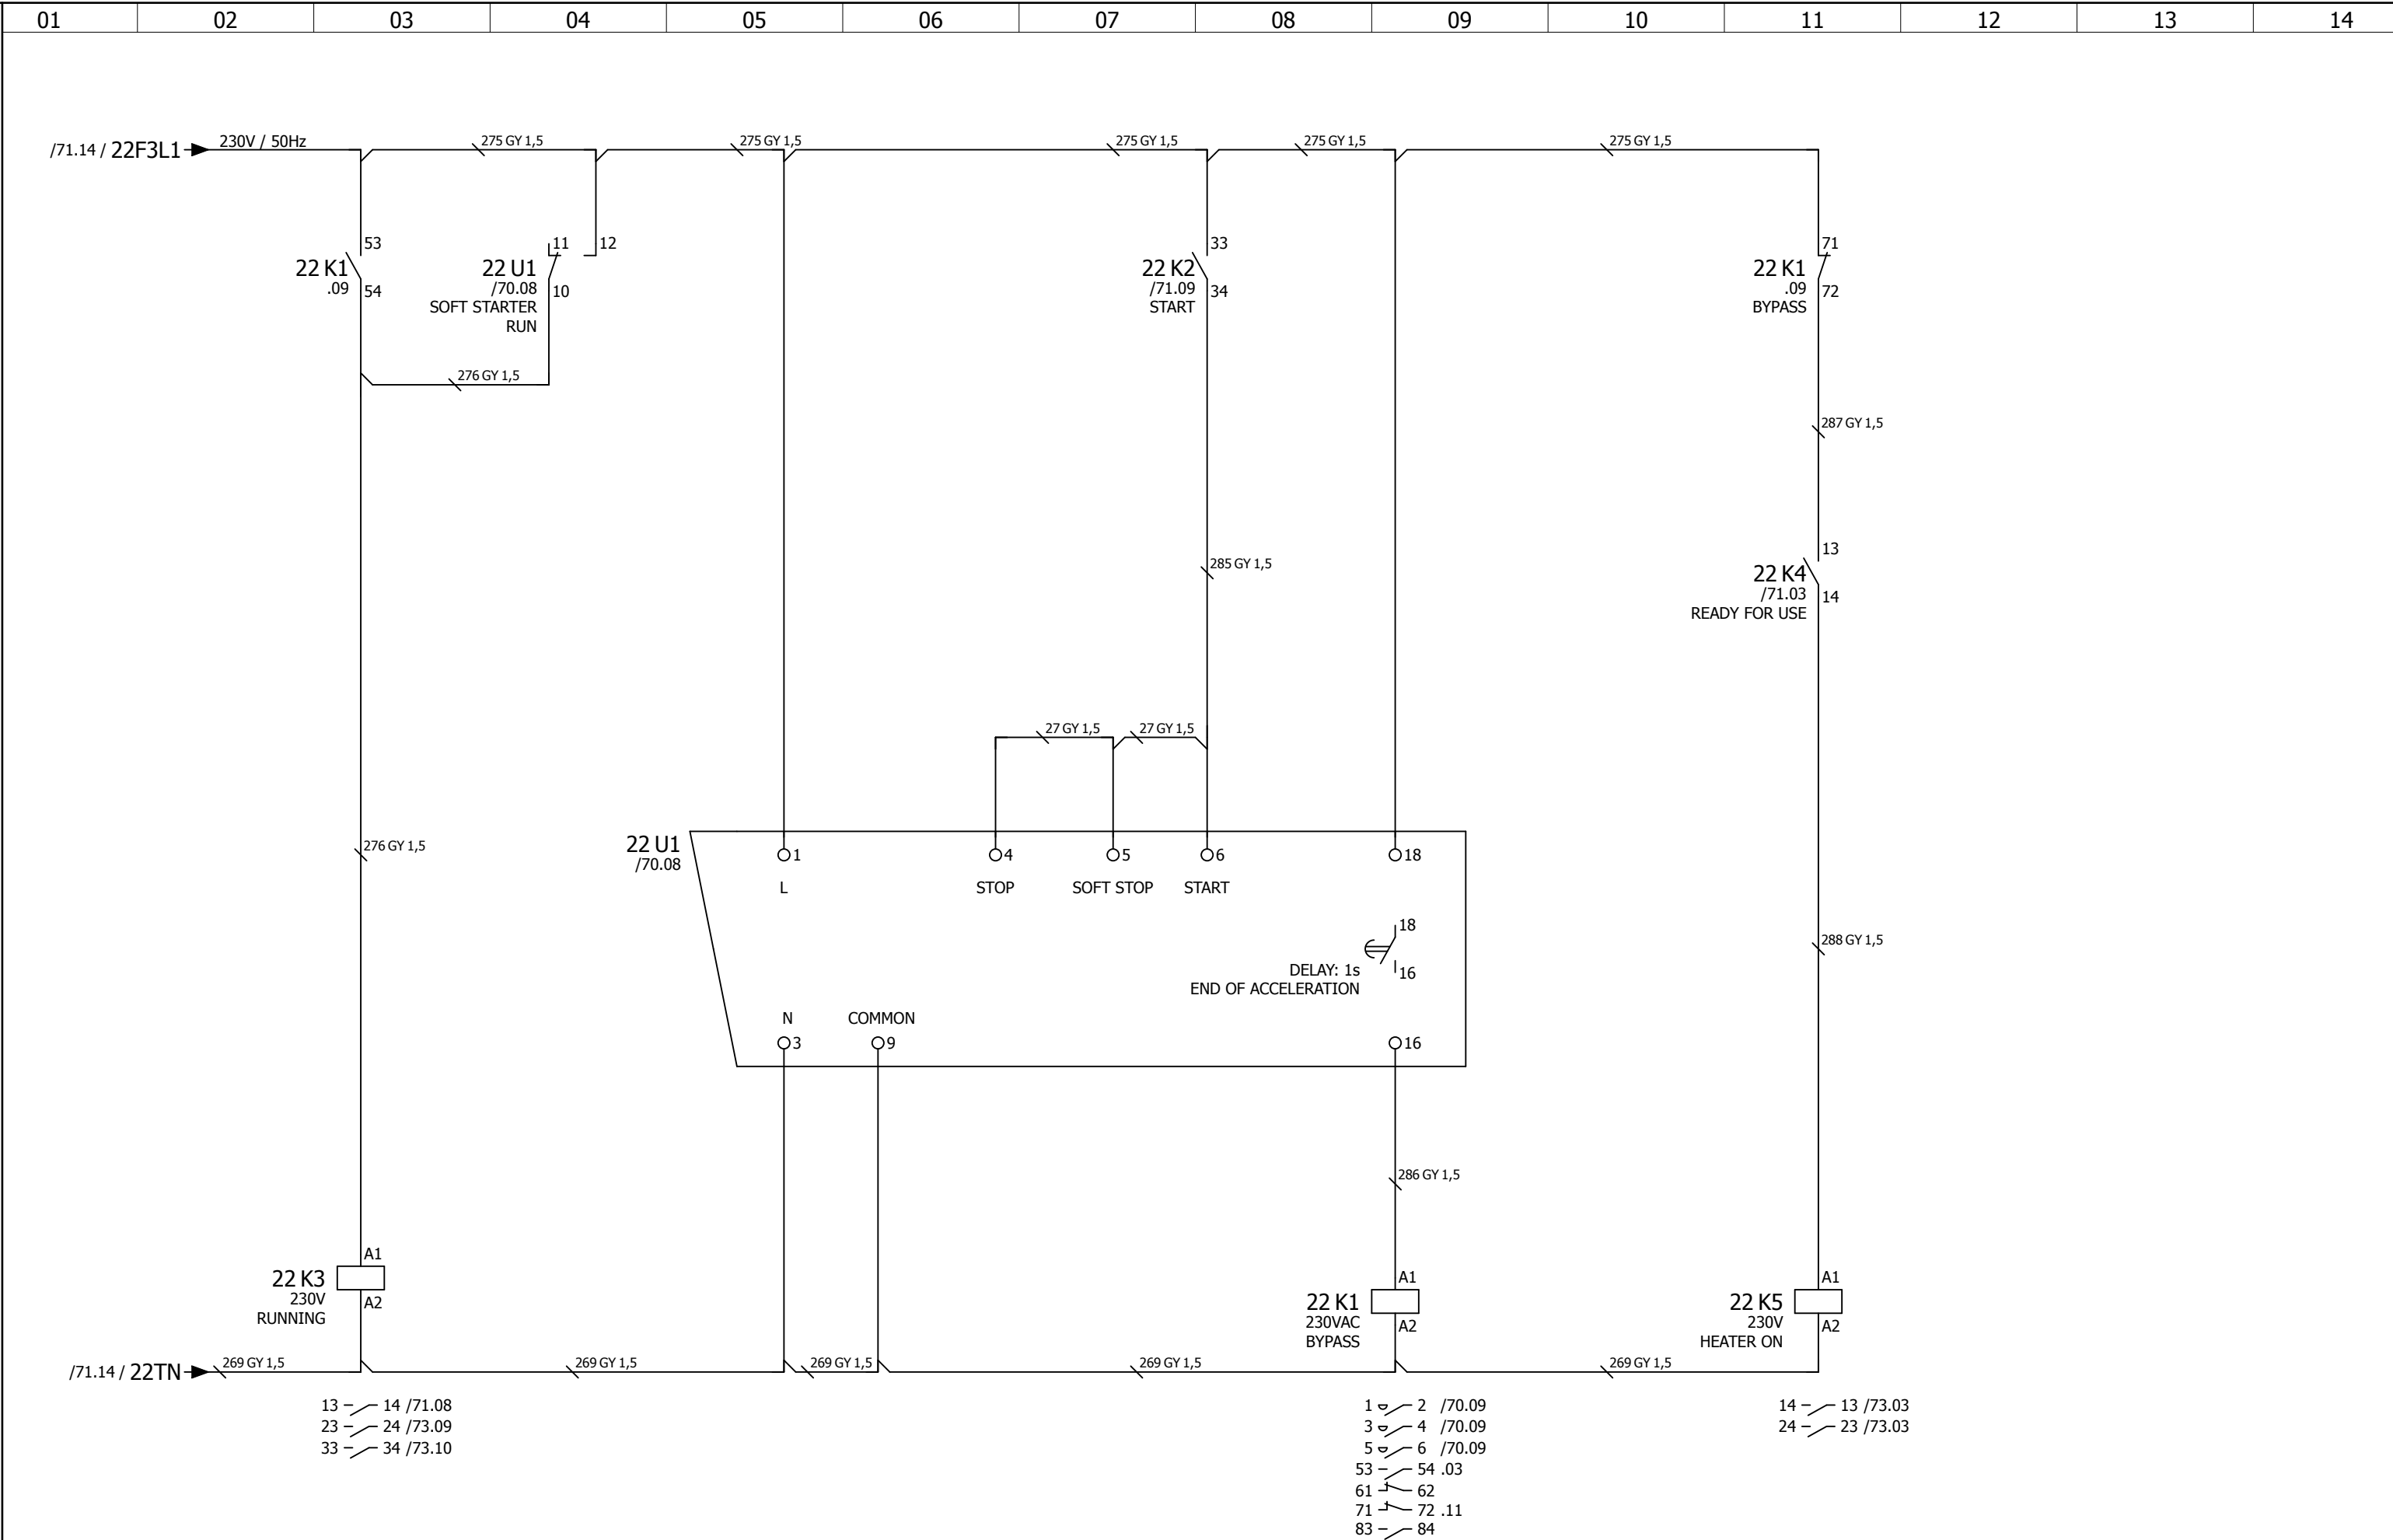


< 71

73 >


D	24-1-2011	PVR			* NO DELIVERY ALEWIJNSE			ALEWIJNSE MARINE B.V. ENERGIEWEG 46/C 6541 CX NIJMEGEN	IHC DREDGERS BV - TSHD5500 DCI-3 "12EP" EMERGENCY DISTRIBUTION BOARD 3X415V FIFI/ BALLAST/ EMERGENCY BILGE PUMP CONTROL CIRCUIT SECTION 3	Yard no : CO1266 Project : 23000143 Class : LROS/IRS Page : 12EP -72
M	5-12-2013	IEN	REV	1	PANEL IP23					
STAT	AS BUILT									
	05-12-2013	IEN	CHK							

No part of this work may be copied, stored or published without prior written permission of Alewijnse Marine Systems.

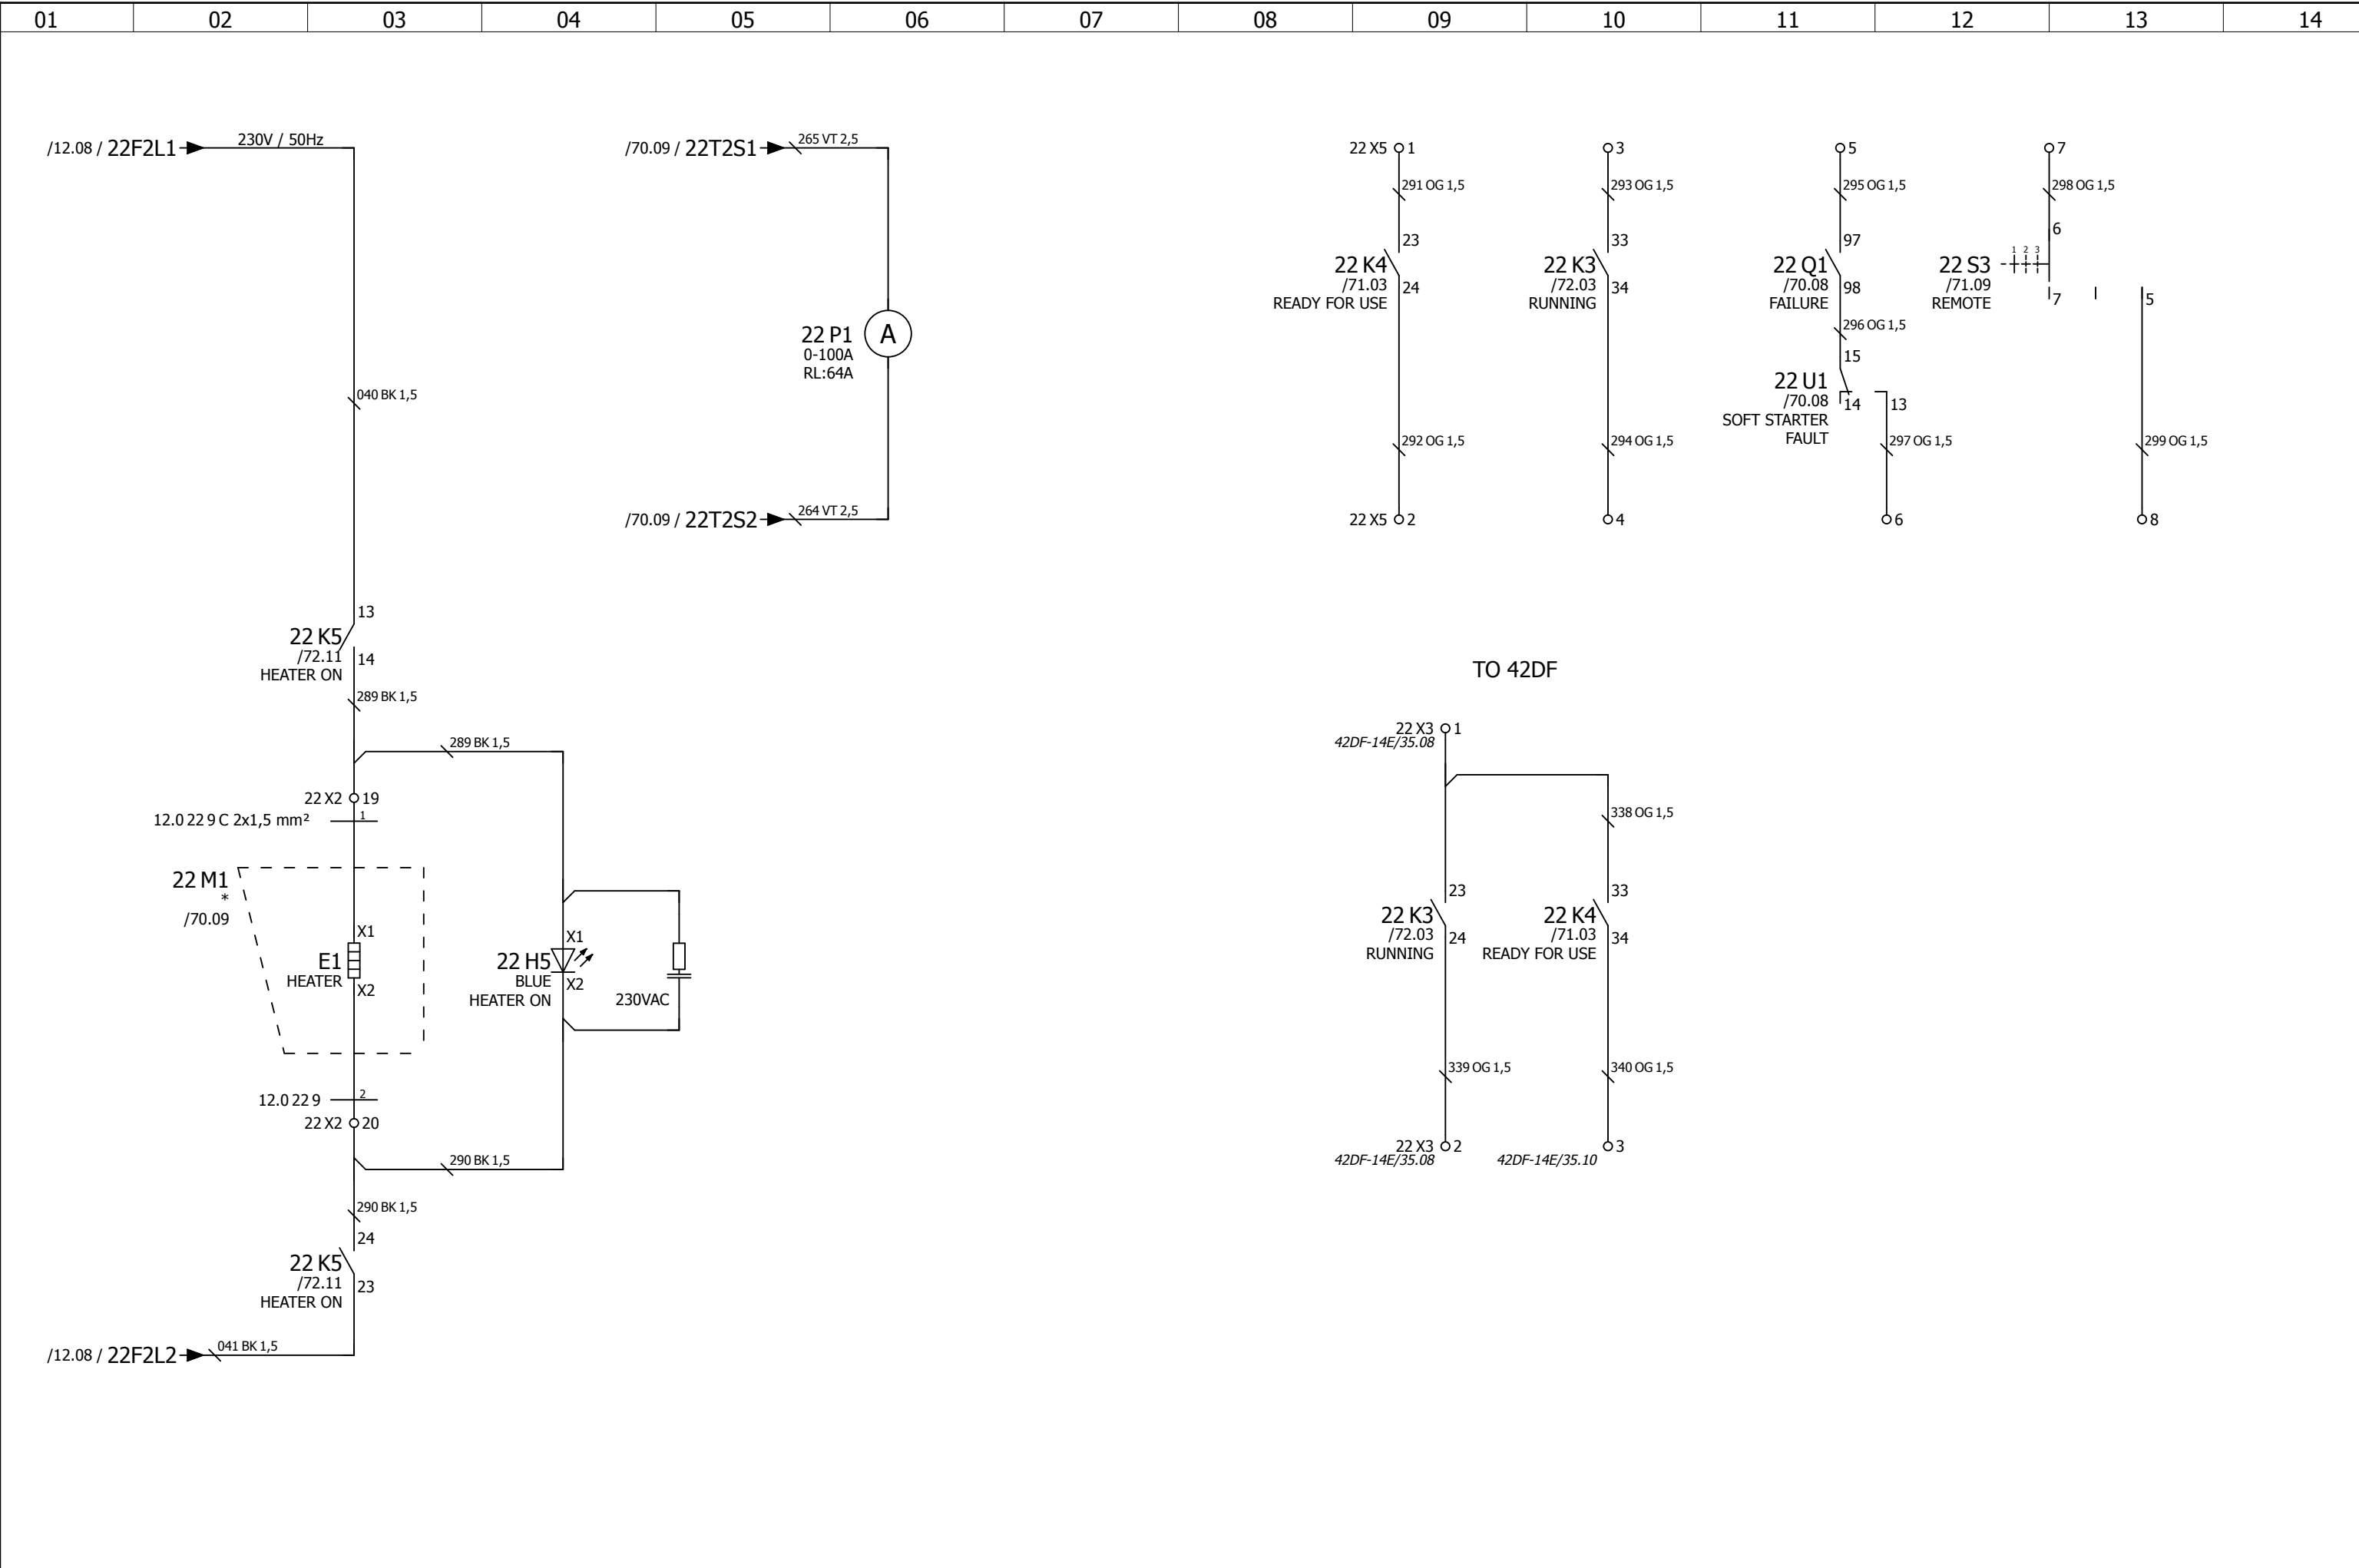


STAT	D	24-1-2011	PVR		* NO DELIVERY ALEWIJNSE			ALEWIJNSE MARINE B.V. ENERGIEWEG 46/C 6541 CX NIJMEGEN	IHC DREDGERS BV - TSHD5500 DCI-3 "12EP" EMERGENCY DISTRIBUTION BOARD 3X415V FIFI/ BALLAST/ EMERGENCY BILGE PUMP CONTROL CIRCUIT SECTION 3	Yard no : CO1266		
	M	5-12-2013	IEN	REV						1	Project : 23000143	
	AS BUILT					PANEL IP23				Class : LROS/IRS		
		05-12-2013	IEN	CHK						Page : 12EP -73		

No part of this work may be copied, stored or published without prior written permission of Alewijnse Marine Systems.

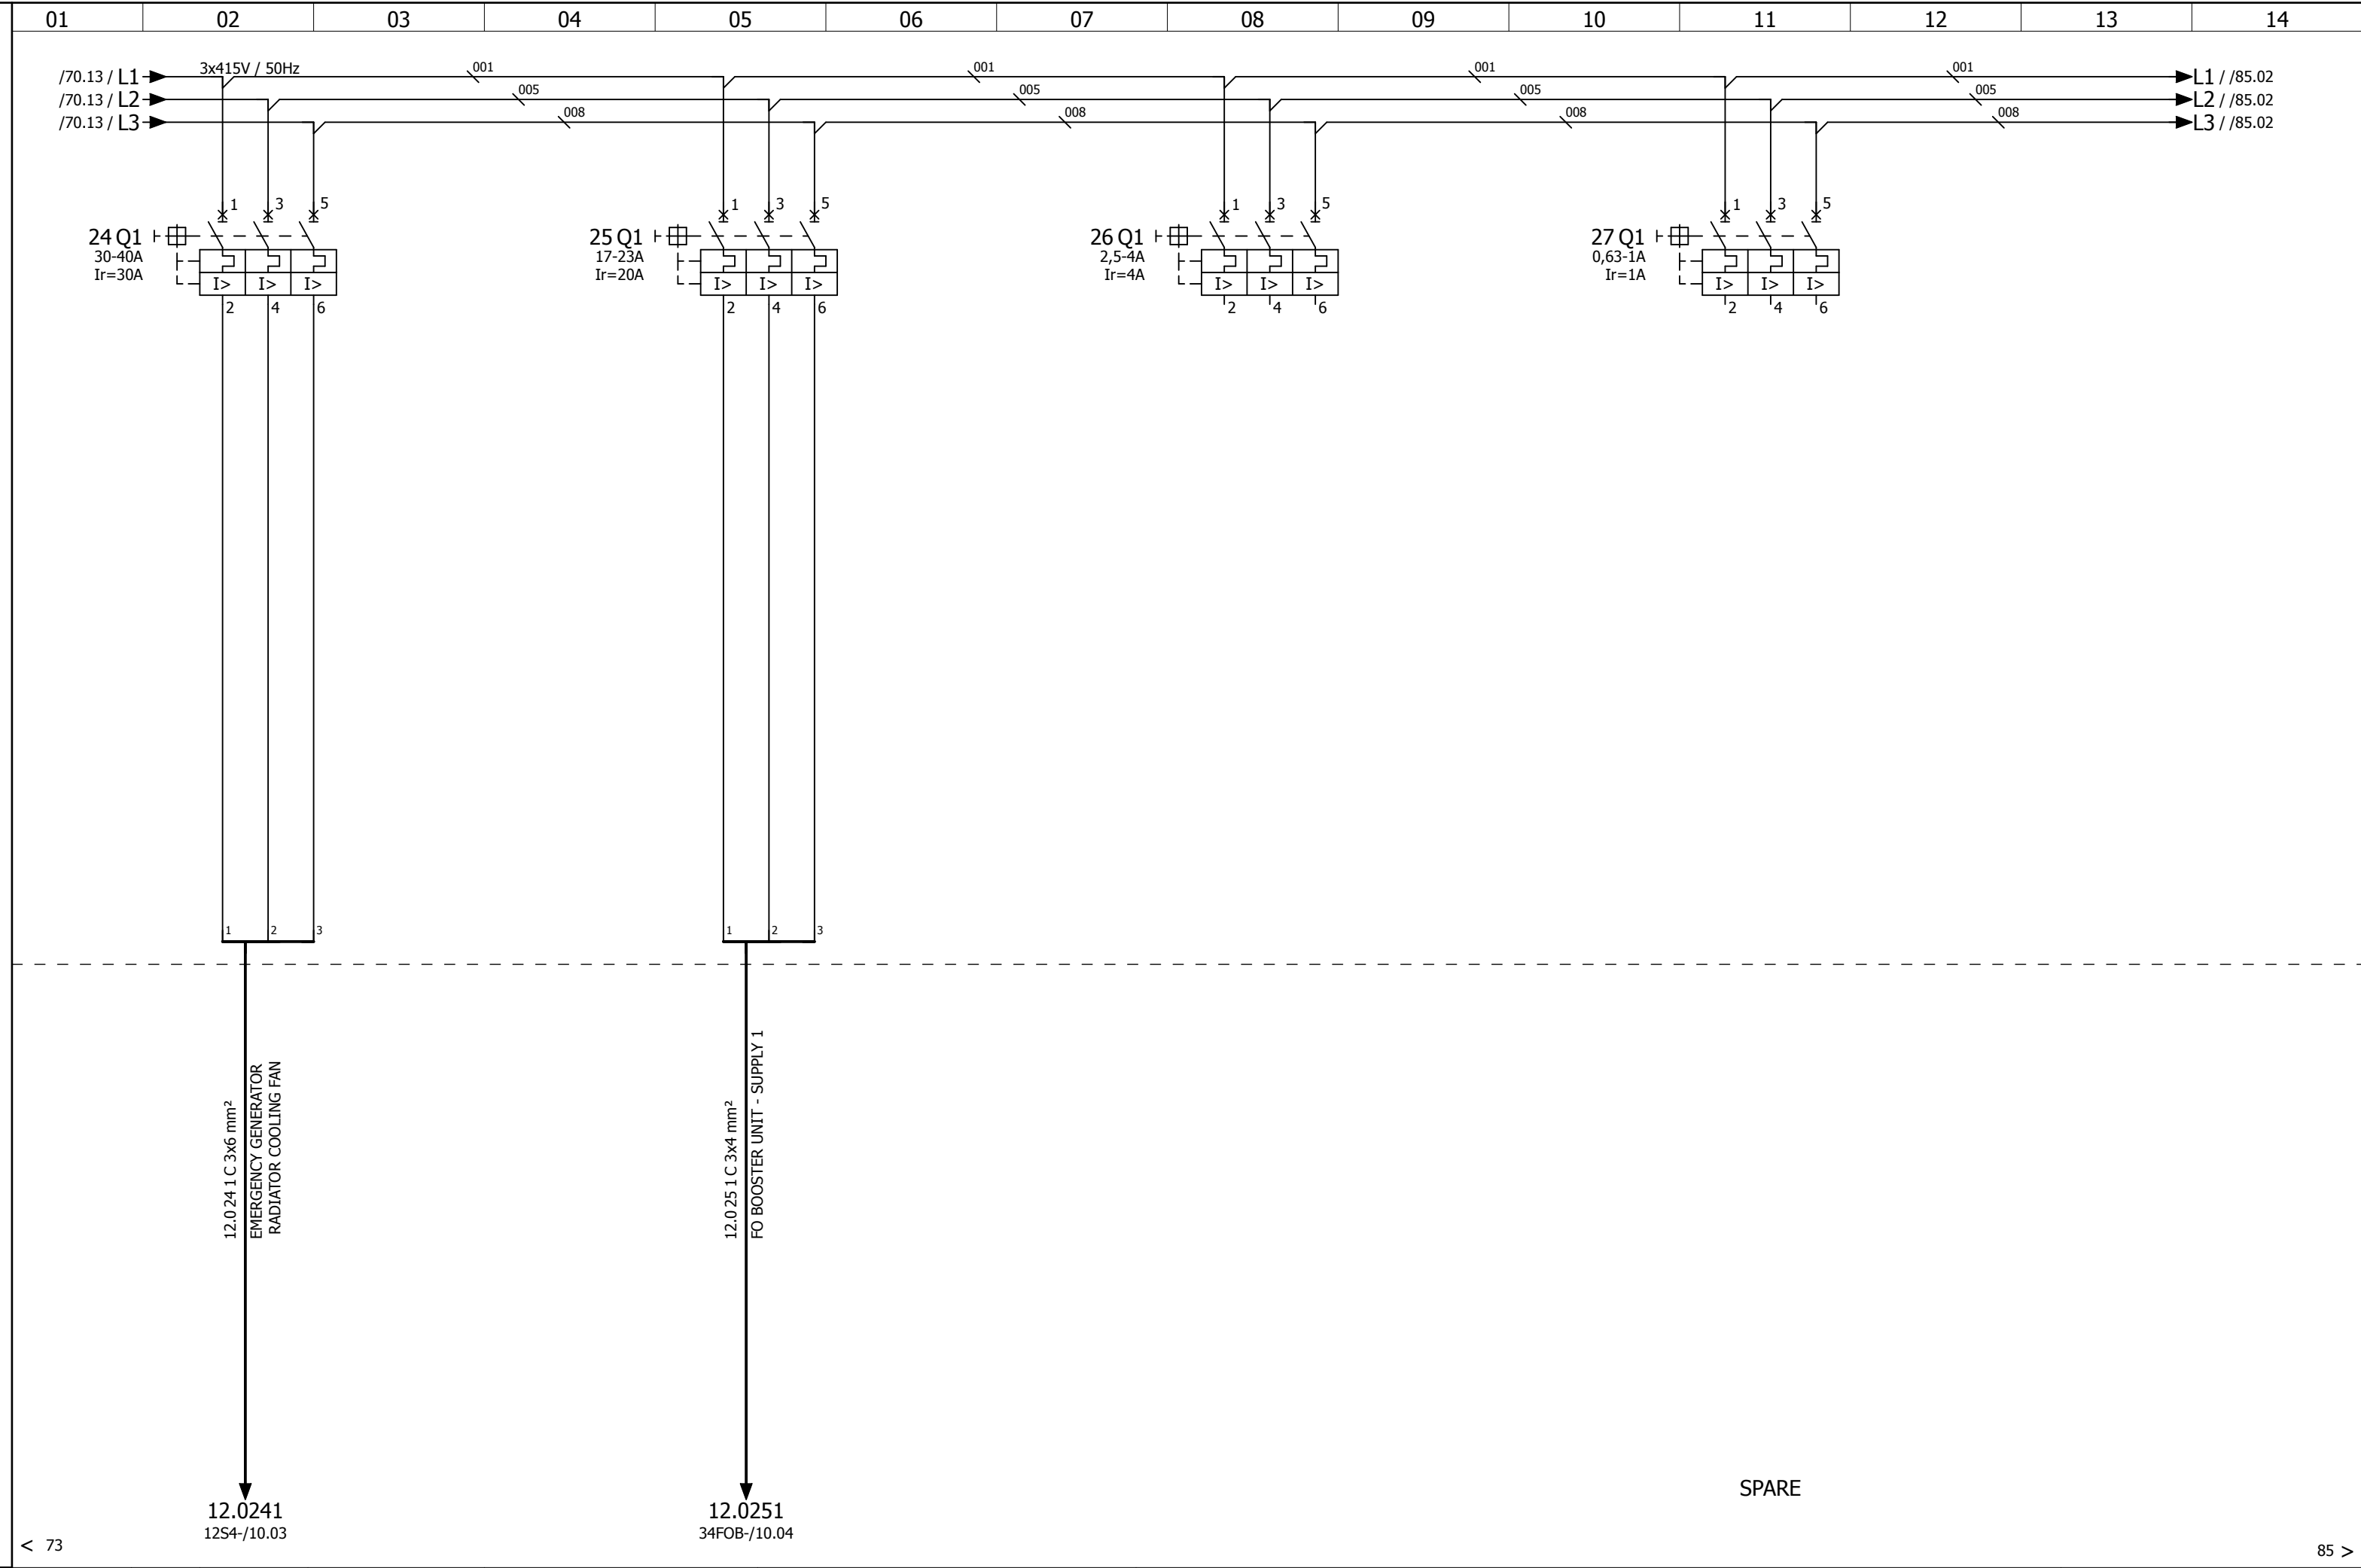


D	24-1-2011	PVR			* NO DELIVERY ALEWIJNSE			ALEWIJNSE MARINE B.V. ENERGIEWEG 46/C 6541 CX NIJMEGEN	IHC DREDGERS BV - TSHD5500 DCI-3 "12EP" EMERGENCY DISTRIBUTION BOARD 3X415V STARTERS / DISTRIBUTION MAIN CIRCUIT SECTION 3	Yard no : CO1266
M	5-12-2013	IEN	REV	1	PANEL IP23					Project : 23000143
STAT	AS BUILT									Class : LROS/IRS
	05-12-2013	IEN	CHK							Page : 12EP -80

No part of this work may be copied, stored or published without prior written permission of Alewijnse Marine Systems.

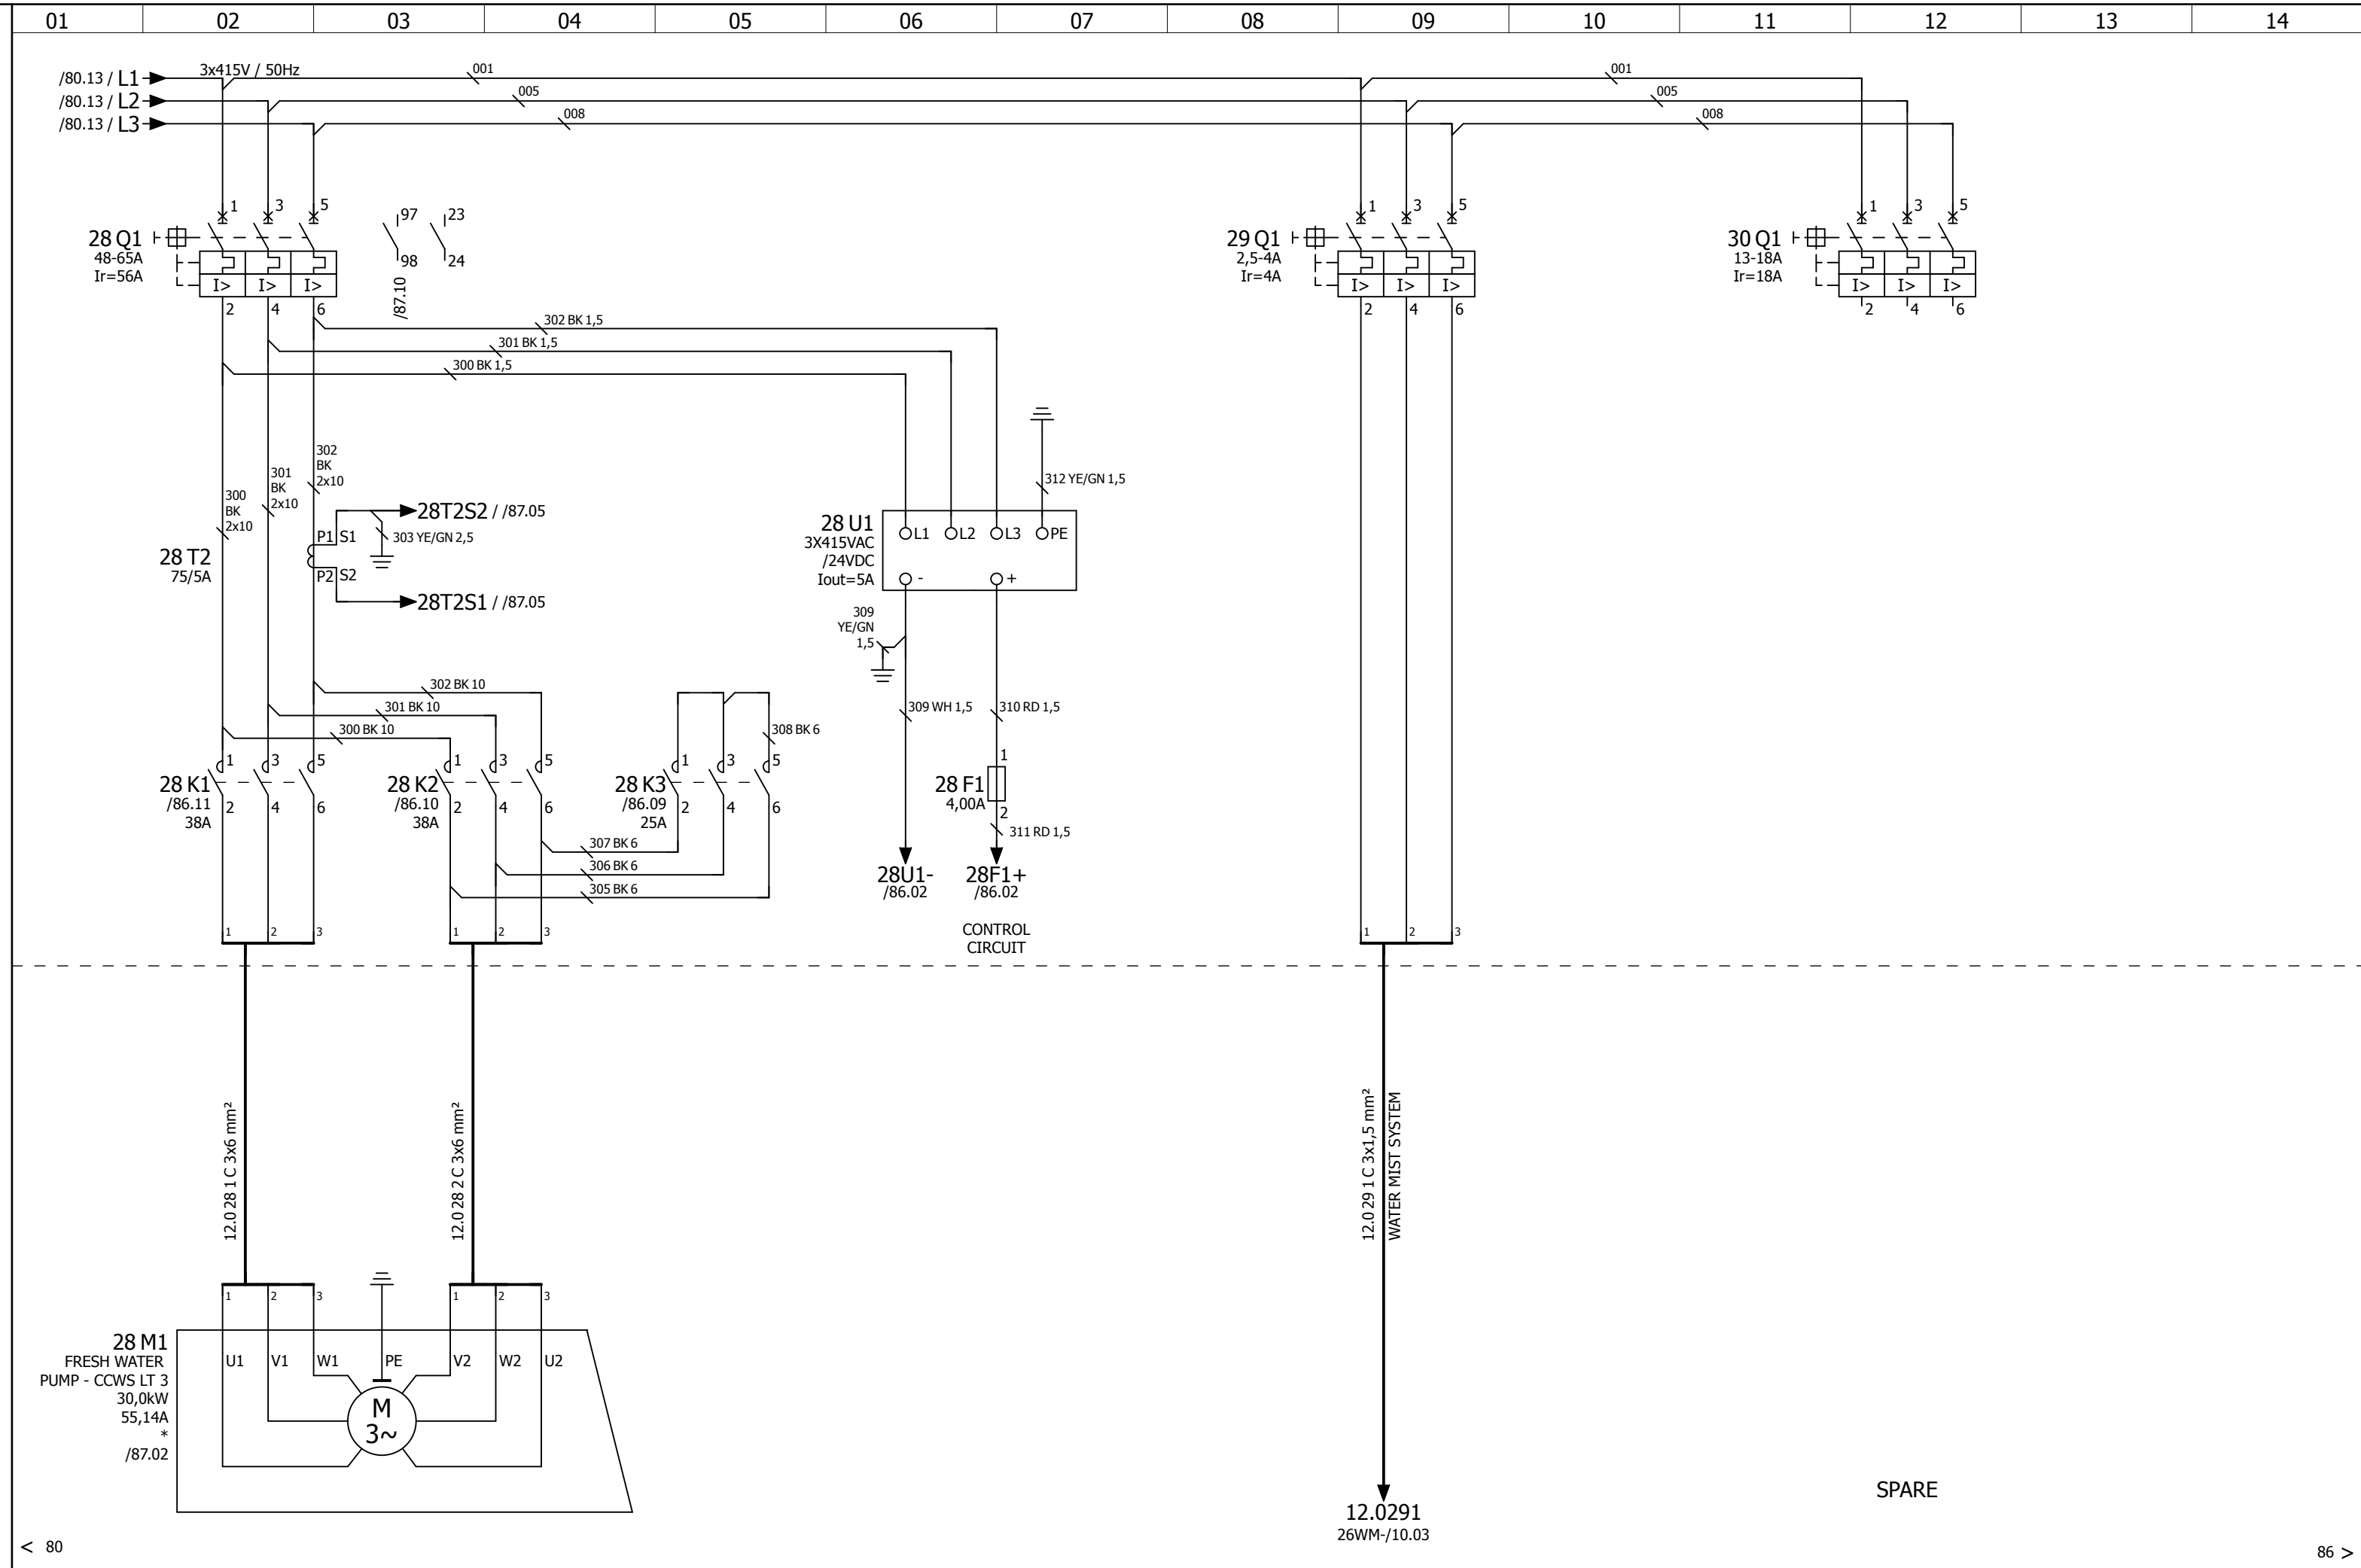


D	24-1-2011	PVR		* NO DELIVERY ALEWIJNSE			ALEWIJNSE MARINE B.V. ENERGIEWEG 46/C 6541 CX NIJMEGEN	IHC DREDGERS BV - TSHD5500 DCI-3 "12EP" EMERGENCY DISTRIBUTION BOARD 3X415V STARTERS / DISTRIBUTION MAIN CIRCUIT SECTION 3	Yard no : CO1266
M	5-12-2013	IEN	REV 1	PANEL IP23					Project : 23000143
STAT	AS BUILT								Class : LROS/IRS
	05-12-2013	IEN	CHK						Page : 12EP -85

No part of this work may be copied, stored or published without prior written permission of Alewijnse Marine Systems.

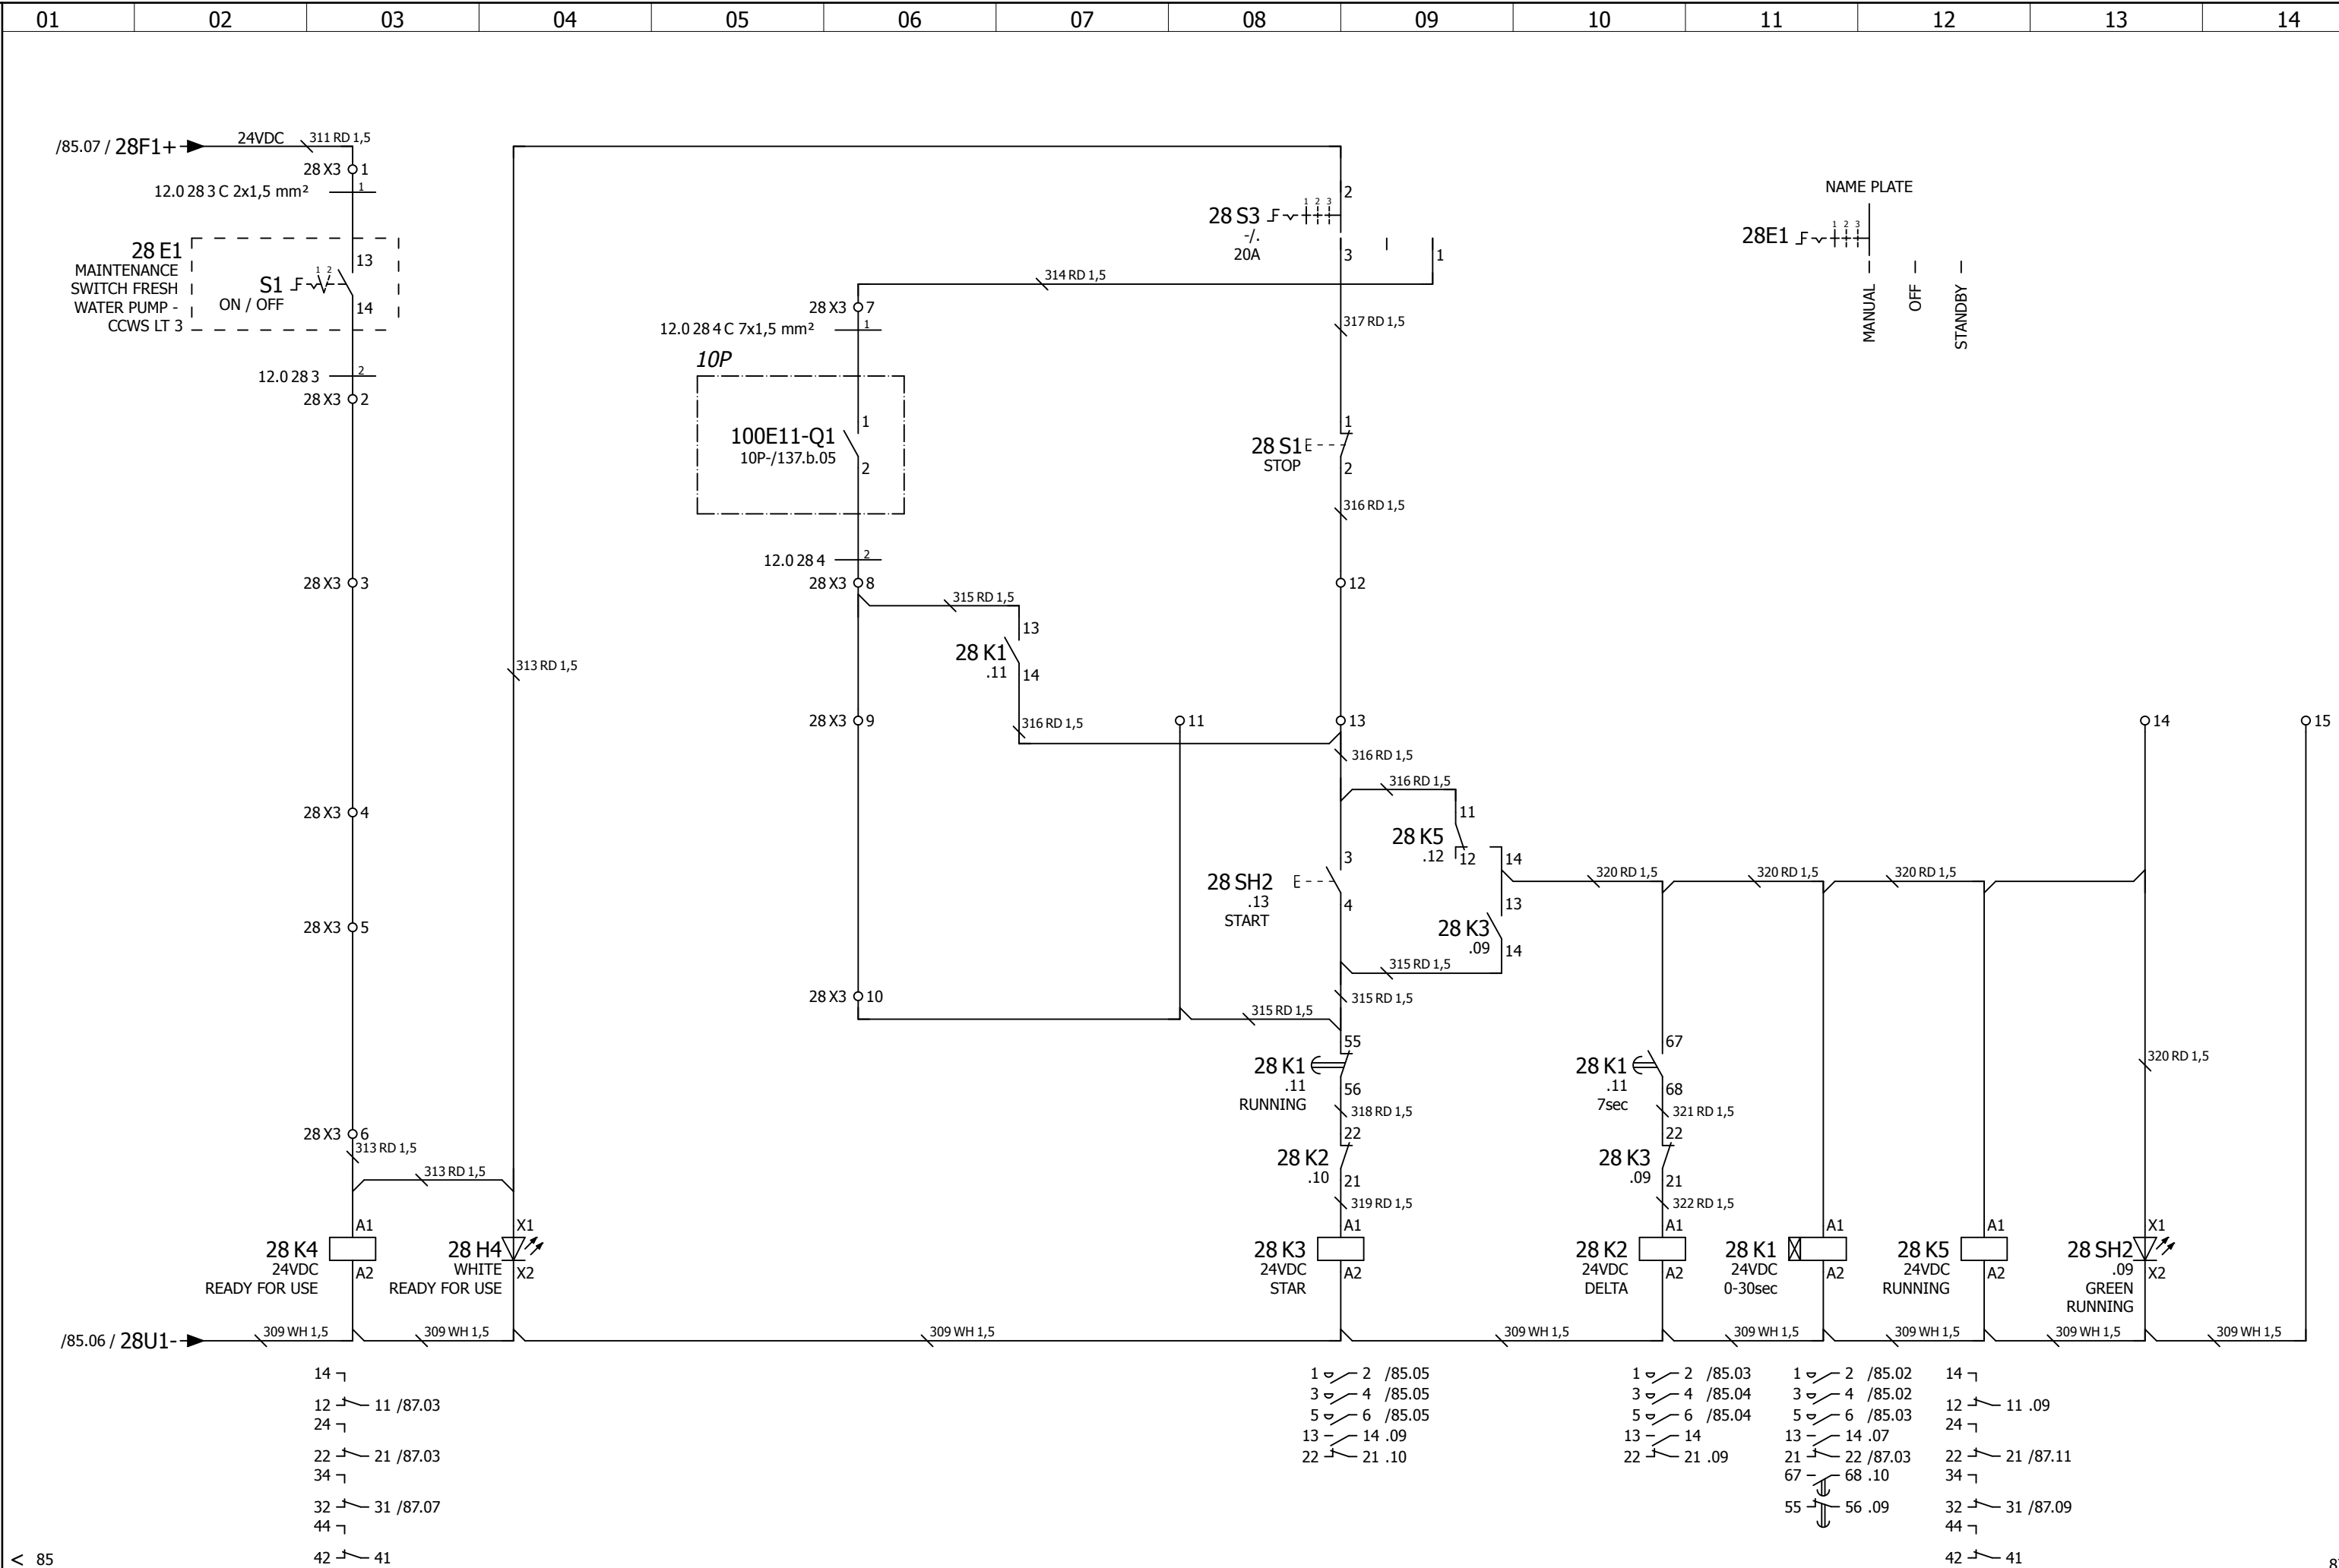

D	24-1-2011	PVR			* NO DELIVERY ALEWIJNSE			ALEWIJNSE MARINE B.V. ENERGIEWEG 46/C 6541 CX NIJMEGEN	IHC DREDGERS BV - TSHD5500 DCI-3 "12EP" EMERGENCY DISTRIBUTION BOARD 3X415V FRESH WATER PUMP - CCWS LT 3 - STANDBY CONTROL CIRCUIT SECTION 3	Yard no : CO1266 Project : 23000143 Class : LROS/IRS Page : 12EP -86
M	5-12-2013	IEN	REV	1	PANEL IP23					
STAT	AS BUILT									
	05-12-2013	IEN	CHK							

No part of this work may be copied, stored or published without prior written permission of Alewijnse Marine Systems.

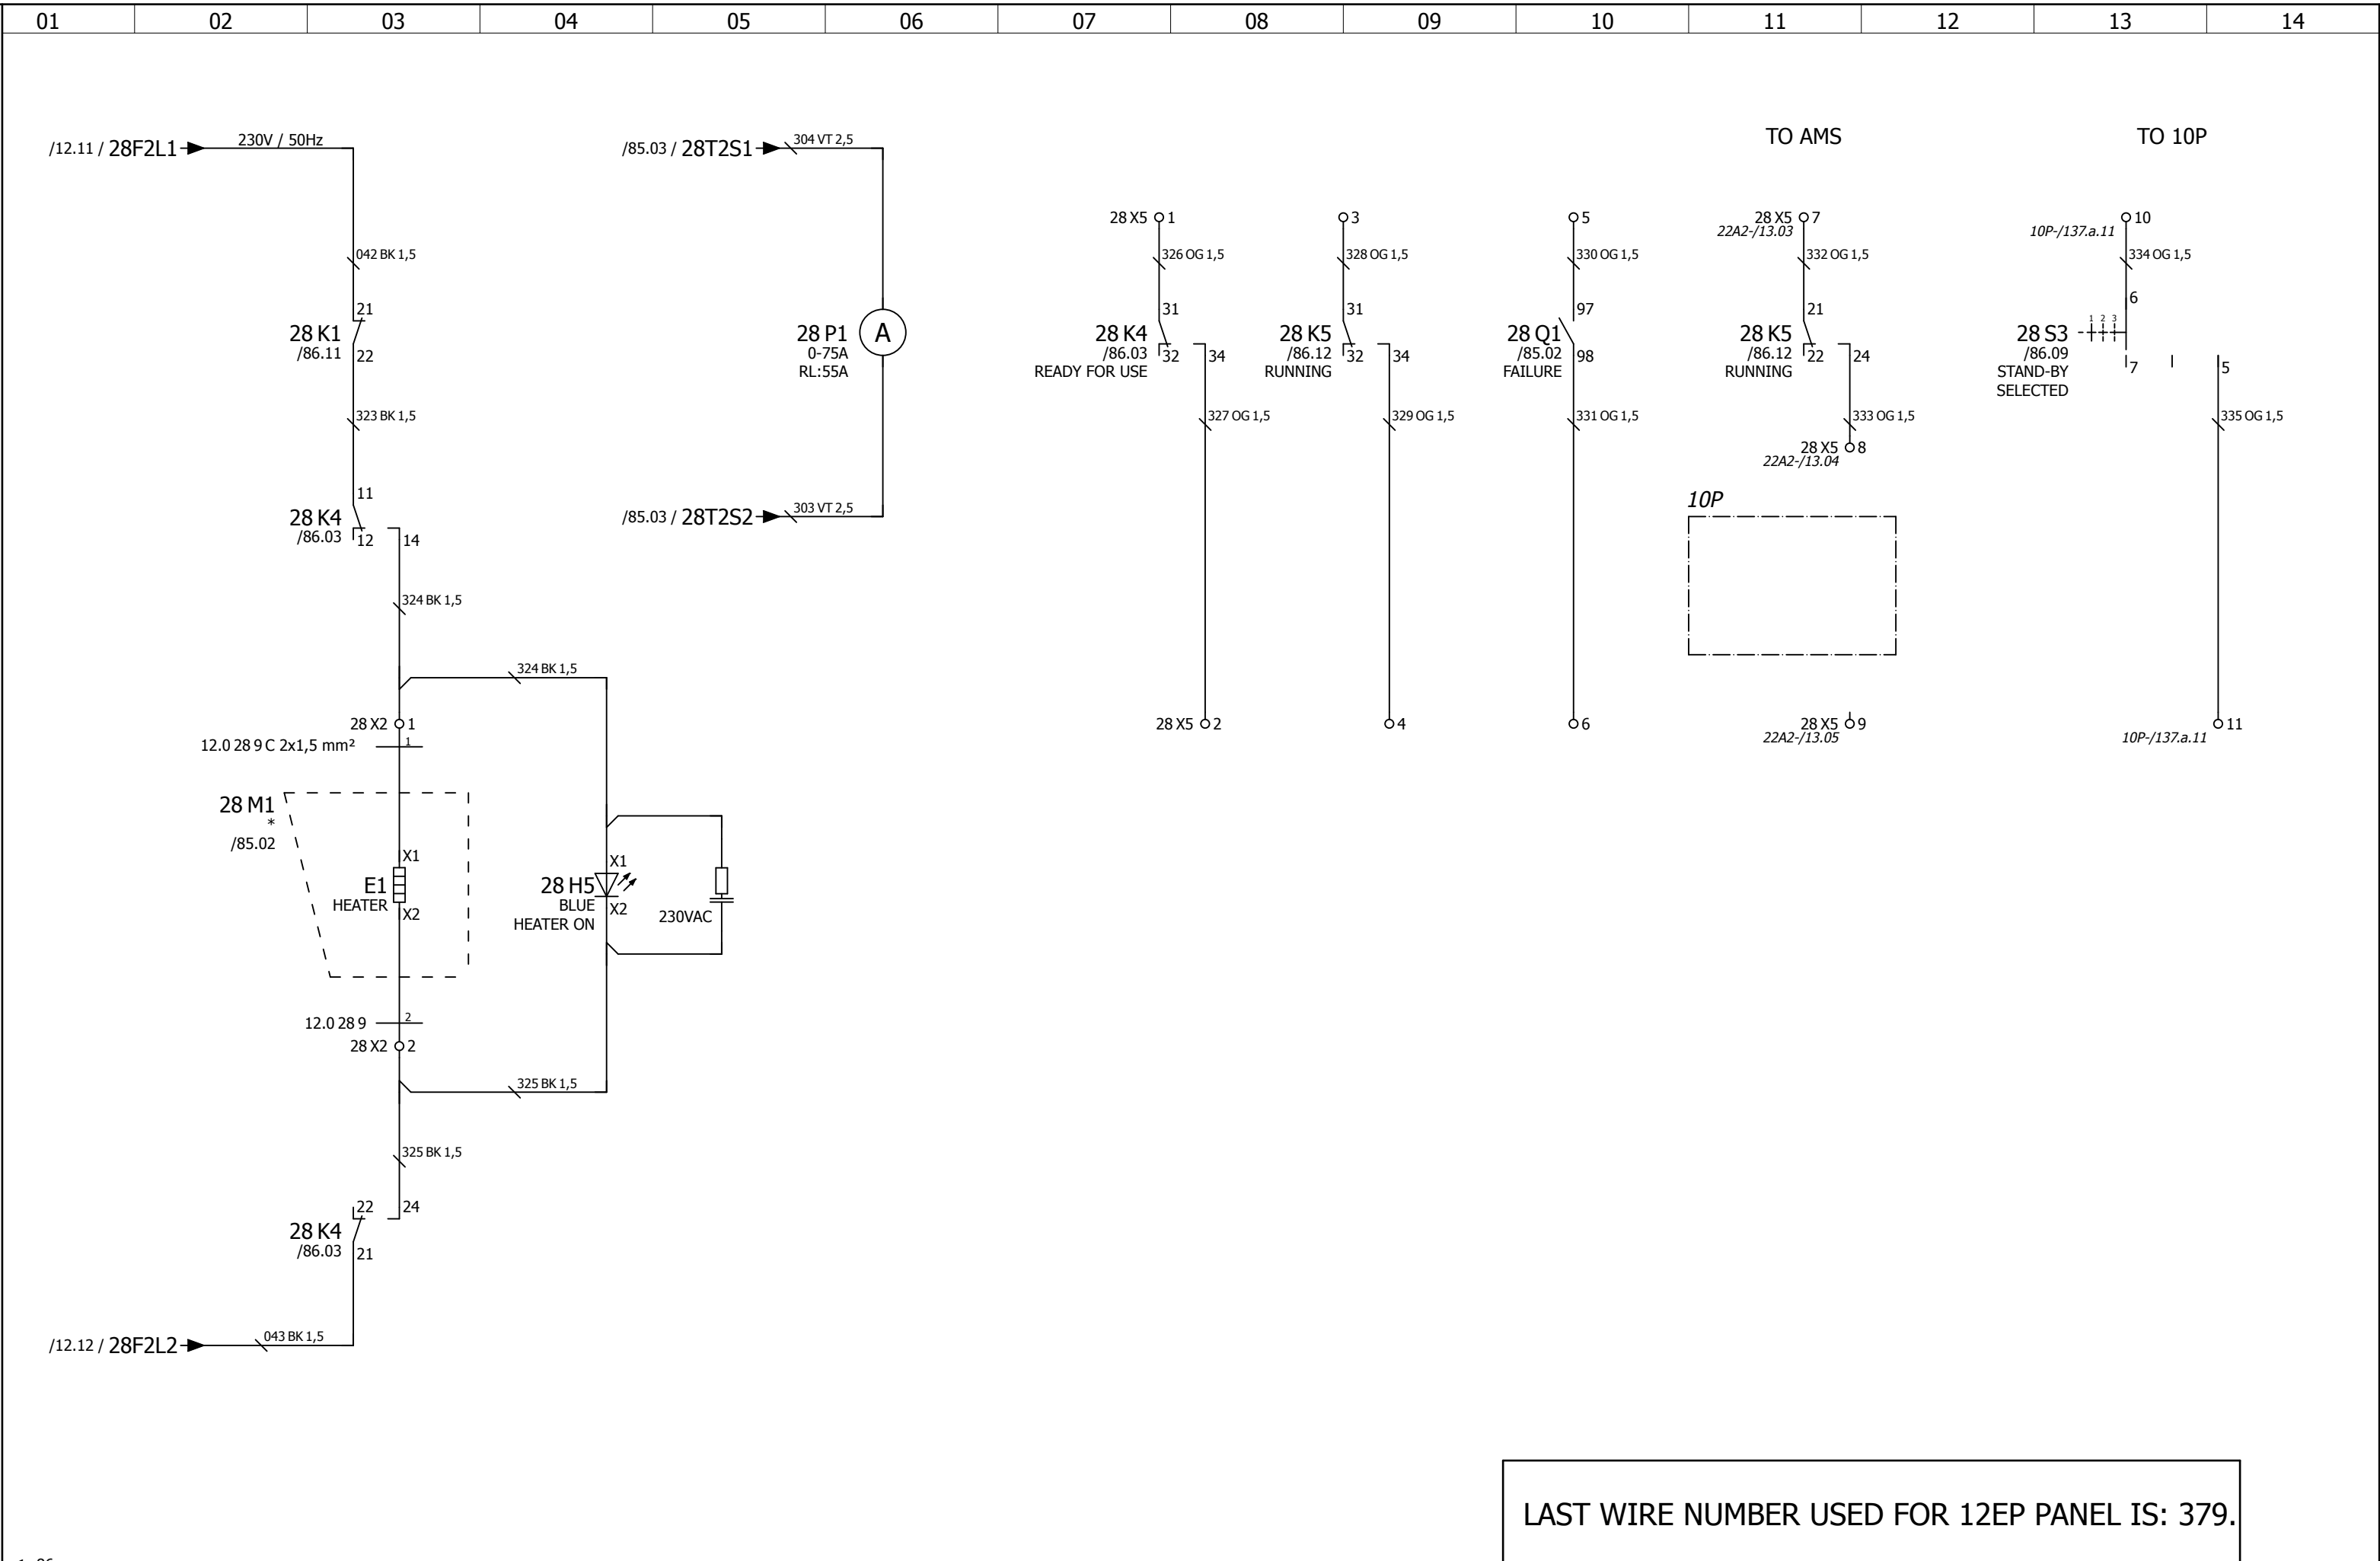

D	24-1-2011	PVR			* NO DELIVERY ALEWIJNSE			ALEWIJNSE MARINE B.V. ENERGIEWEG 46/C 6541 CX NIJMEGEN	IHC DREDGERS BV - TSHD5500 DCI-3 "12EP" EMERGENCY DISTRIBUTION BOARD 3X415V FRESH WATER PUMP - CCWS LT 3 - STANDBY CONTROL CIRCUIT SECTION 3	Yard no : CO1266
M	5-12-2013	IEN	REV	1						Project : 23000143
STAT	AS BUILT				PANEL IP23					Class : LROS/IRS
	05-12-2013	IEN	CHK							Page : 12EP -87

No part of this work may be copied, stored or published without prior written permission of Alewijnse Marine Systems.

01	02	03	04	05	06	07	08	09	10	11	12	13	14																																																																																																																																																																																																																																		
PARTS LIST														12EP																																																																																																																																																																																																																																	
DEVICE		QTY	DESCRIPTION					NAV. NUMBER	MANUFACTURER	PART NUMBER		TYPE NUMBER		PAGE																																																																																																																																																																																																																																	
-01D1.		1	DIODE MODULE 15A 800V					58911	Semikron BV	SEMI.SKKE15/08		SKKE15/08		-13/04																																																																																																																																																																																																																																	
-01D2.		1	DIODE MODULE 15A 800V					58911	Semikron BV	SEMI.SKKE15/08		SKKE15/08		-13/04																																																																																																																																																																																																																																	
-01D3.		1	DIODE MODULE 15A 800V					58911	Semikron BV	SEMI.SKKE15/08		SKKE15/08		-13/02																																																																																																																																																																																																																																	
-01D4.		1	DIODE MODULE 15A 800V					58911	Semikron BV	SEMI.SKKE15/08		SKKE15/08		-13/03																																																																																																																																																																																																																																	
-01E1.		1	COMPACT CB NS100..630 TIME DELAY MN 220-250V					42362	Schneider Electric BV	MERL.MN-DELAY_ADJUSTABLE		33682		-14/12																																																																																																																																																																																																																																	
-01E2.		1	FREQ. BEW RELAY 10 STEPS 0,1-30S					39517	Carlo Gavazzi BV	CARL.DFB01CM24		DFB01CM24		-19/02																																																																																																																																																																																																																																	
-01E3.		1	RELAY PLUG-IN VOLTAGE CONTROL 1F WINDOW AC					39512	Carlo Gavazzi BV	CARL.DUB02CT23		DUB02CT23		-19/05																																																																																																																																																																																																																																	
-01E4.		1								KRIWAN.INT300-13A221 (SPECIAL ORDER AISP)				-21/05																																																																																																																																																																																																																																	
-01E8.		1								DEIF.TAS-331DG/3W3 (SPECIAL ORDER AISP)				-22/03																																																																																																																																																																																																																																	
-01F1.		3	DII/E27 SIZE FUSE BASE 25A "TRITON"					40417	Wohner Benelux BV	WOHN.31173		31173		-10/07																																																																																																																																																																																																																																	
-01F1.		3	FUSE SIZE DII 16A SLOW					40004	Siemens Nederland NV	SIEM.5SB261		5SB261		-10/07																																																																																																																																																																																																																																	
-01F1.		3	FITTED SCREW SII 16 Amp					40014	Siemens Nederland NV	SIEM.5SH314		5SH314		-10/07																																																																																																																																																																																																																																	
-01F1.		3	SCREW CAP DII 25A AC DC 500V CERAMIKS					40041	Siemens Nederland NV	SIEM.5SH112		5SH112		-10/07																																																																																																																																																																																																																																	
-01F2.		1	CIRC. BREAKER 2P 04A D 10kA/230V Im=14xIn					42225	Schneider Electric BV	MERL.C60N-2P-D4		24583 // C60 N		-10/08																																																																																																																																																																																																																																	
-01F3.		1	GLASS FUSE 05x20mm 04,00A FAST VE10					40173	Technische Unie BV	ESKA.05X20\F4,00A		20.64.00.610		-10/08																																																																																																																																																																																																																																	
-01F3.		1	TERMINAL 4,00mm2 FUSE UT4-HESI (5x20) 6A Black					89264	Phoenix Contact	PHOE.UT4-HESI(5X20)		UT4-HESI(5X20)		-10/08																																																																																																																																																																																																																																	
-01F4.		1	GLASS FUSE 05x20mm 02,00A FAST VE10					40170	Technische Unie BV	ESKA.05X20\F2,00A		20.64.00.580		-10/09																																																																																																																																																																																																																																	
-01F4.		1	TERMINAL 4,00mm2 FUSE UT4-HESI (5x20) 6A Black					89264	Phoenix Contact	PHOE.UT4-HESI(5X20)		UT4-HESI(5X20)		-10/09																																																																																																																																																																																																																																	
-01F5.		1	GLASS FUSE 05x20mm 04,00A FAST VE10					40173	Technische Unie BV	ESKA.05X20\F4,00A		20.64.00.610		-10/09																																																																																																																																																																																																																																	
-01F5.		1	TERMINAL 4,00mm2 FUSE UT4-HESI (5x20) 6A Black					89264	Phoenix Contact	PHOE.UT4-HESI(5X20)		UT4-HESI(5X20)		-10/09																																																																																																																																																																																																																																	
-01F6.		1	GLASS FUSE 05x20mm 02,00A FAST VE10					40170	Technische Unie BV	ESKA.05X20\F2,00A		20.64.00.580		-10/10																																																																																																																																																																																																																																	
-01F6.		1	TERMINAL 4,00mm2 FUSE UT4-HESI (5x20) 6A Black					89264	Phoenix Contact	PHOE.UT4-HESI(5X20)		UT4-HESI(5X20)		-10/10																																																																																																																																																																																																																																	
-01F7.		1	GLASS FUSE 05x20mm 02,00A FAST VE10					40170	Technische Unie BV	ESKA.05X20\F2,00A		20.64.00.580		-10/11																																																																																																																																																																																																																																	
-01F7.		1	TERMINAL 4,00mm2 FUSE UT4-HESI (5x20) 6A Black					89264	Phoenix Contact	PHOE.UT4-HESI(5X20)		UT4-HESI(5X20)		-10/11																																																																																																																																																																																																																																	
-01F8.		1	CIRC. BREAKER 3P 02A C 10kA/400V Im=10xIn					40782	Schneider Electric BV	MERL.C60N-3P-C2		24278 // C60 N		-10/11																																																																																																																																																																																																																																	
-01F9.		1	CIRC. BREAKER 2P 02A C 10kA/230V Im=10xIn					40961	Schneider Electric BV	MERL.C60N-2P-C2		24264 // C60 N		-10/13																																																																																																																																																																																																																																	
-01F10.		1	CIRC. BREAKER 2P 02A C 15kA/230V Im=10xIn					40861	Schneider Electric BV	MERL.C60H-2P-C2		24914 // C60 H		-11/02																																																																																																																																																																																																																																	
-01F11.		1	CIRC. BREAKER 4P 02A C 15kA/400V Im=10xIn					40916	Schneider Electric BV	MERL.C60H-4P-C2		24942 // C60 H		-11/05																																																																																																																																																																																																																																	
-01F11.		1	AUX. CONTACT FOR C60H 1xAUX + 1xAUX/TRIP					40952	Schneider Electric BV	MERL.C60-OF+SD/OF		26929		-11/05																																																																																																																																																																																																																																	
-01F12.		2	GLASS FUSE 05x25mm 10,00A VE10					40334	SIBA-Nederland GmbH	SIBA.05X25/F10,00A/1,5KA		172526.10		-12/03																																																																																																																																																																																																																																	
-01F12.		2								PHOE.UT10-DRESHI				-12/03																																																																																																																																																																																																																																	
-01F13.		2	GLASS FUSE 05x20mm 02,00A FAST VE10					40170	Technische Unie BV	ESKA.05X20\F2,00A		20.64.00.580		-13/08																																																																																																																																																																																																																																	
-01F13.		2	TERMINAL 4,00mm2 FUSE UT4-HESI (5x20) 6A Black					89264	Phoenix Contact	PHOE.UT4-HESI(5X20)		UT4-HESI(5X20)		-13/08																																																																																																																																																																																																																																	
-01F14.		2	GLASS FUSE 05x20mm 02,00A FAST VE10					40170	Technische Unie BV	ESKA.05X20\F2,00A		20.64.00.580		-13/09																																																																																																																																																																																																																																	
-01F14.		2	TERMINAL 4,00mm2 FUSE UT4-HESI (5x20) 6A Black					89264	Phoenix Contact	PHOE.UT4-HESI(5X20)		UT4-HESI(5X20)		-13/09																																																																																																																																																																																																																																	
-01F15.		2	GLASS FUSE 05x20mm 02,00A FAST VE10					40170	Technische Unie BV	ESKA.05X20\F2,00A		20.64.00.580		-13/11																																																																																																																																																																																																																																	
-01F15.		2	TERMINAL 4,00mm2 FUSE UT4-HESI (5x20) 6A Black					89264	Phoenix Contact	PHOE.UT4-HESI(5X20)		UT4-HESI(5X20)		-13/11																																																																																																																																																																																																																																	
-01F16.		2	GLASS FUSE 05x20mm 02,00A FAST VE10					40170	Technische Unie BV	ESKA.05X20\F2,00A		20.64.00.580		-13/12																																																																																																																																																																																																																																	
-01F16.		2	TERMINAL 4,00mm2 FUSE UT4-HESI (5x20) 6A Black					89264	Phoenix Contact	PHOE.UT4-HESI(5X20)		UT4-HESI(5X20)		-13/12																																																																																																																																																																																																																																	
-01H11.		1	PILOT LIGHT P-LED YELLOW 24VAC/DC HARMONY					75004	Schneider Electric BV	TELE.XB4BVB5		XB4BVB5		-18/03																																																																																																																																																																																																																																	
< 87														8000.a >																																																																																																																																																																																																																																	
4-1-2011		PVR																																																																																																																																																																																																																																													

No part of this work may be copied, stored or published without prior written permission of Alewijnse Marine Systems.

01	02	03	04	05	06	07	08	09	10	11	12	13	14	
PARTS LIST 12EP														
DEVICE	QTY	DESCRIPTION				NAV. NUMBER	MANUFACTURER	PART NUMBER		TYPE NUMBER		PAGE		
-01H12.	1	PILOT LIGHT P-LED GREEN 24VAC/DC HARMONY				75005	Schneider Electric BV	TELE.XB4BVB3		XB4BVB3		-18/04		
-01H13.	1	PILOT LIGHT P-LED RED 24VAC/DC HARMONY				75002	Schneider Electric BV	TELE.XB4BVB4		XB4BVB4		-18/06		
-01H14.	1	PILOT LIGHT P-LED RED 24VAC/DC HARMONY				75002	Schneider Electric BV	TELE.XB4BVB4		XB4BVB4		-18/08		
-01H15.	1	PILOT LIGHT P-LED GREEN 24VAC/DC HARMONY				75005	Schneider Electric BV	TELE.XB4BVB3		XB4BVB3		-18/13		
-01H16.	1	PILOT LIGHT P-LED GREEN 24VAC/DC HARMONY				75005	Schneider Electric BV	TELE.XB4BVB3		XB4BVB3		-18/09		
-01H17.	1	PILOT LIGHT P-LED BLUE 230VAC HARMONY				75016	Schneider Electric BV	TELE.XB4BVM6		XB4BVM6		-15/07		
-01H17.	1	OVER VOLTAGE ELEMENT 230VAC HARMONY				75010	Schneider Electric BV	TELE.ZBZ-VM		ZBZ-VM		-15/07		
-01K1.	1	AUX. RELAY MINIATURE 4P 7A 24VDC COMPLETE				35460	Finder	FIND.58.34.9.024.0050		58.34.9.024.0050		-13/05		
-01K2.	1	AUX. RELAY 3NO+2NC 024VDC 10A TESYS				28287	Schneider Electric BV	TELE.CAD32BD		CAD32BD		-16/03		
-01K3.	1	AUX. RELAY MINIATURE 4P 7A 24VDC COMPLETE				35460	Finder	FIND.58.34.9.024.0050		58.34.9.024.0050		-16/04		
-01K4.	1	AUX. RELAY MINIATURE 4P 7A 24VDC COMPLETE				35460	Finder	FIND.58.34.9.024.0050		58.34.9.024.0050		-16/06		
-01K5.	1	AUX. RELAY MINIATURE 4P 7A 24VDC COMPLETE				35460	Finder	FIND.58.34.9.024.0050		58.34.9.024.0050		-16/07		
-01K6.	1	AUX. RELAY 3NO+2NC 024VDC 10A TESYS				28287	Schneider Electric BV	TELE.CAD32BD		CAD32BD		-16/09		
-01K6.	1	AUX. CONTACT TIME 1NO+1NC OFF DELAY 30SEC.				28391	Schneider Electric BV	TELE.LADR2		LADR2		-16/09		
-01K7.	1	AUX. RELAY 3NO+2NC 024VDC 10A TESYS				28287	Schneider Electric BV	TELE.CAD32BD		CAD32BD		-16/10		
-01K8.	1	AUX. RELAY MINIATURE 4P 7A 24VDC COMPLETE				35460	Finder	FIND.58.34.9.024.0050		58.34.9.024.0050		-21/03		
-01K9.	1	AUX. RELAY 3NO+2NC 024VDC 10A TESYS				28287	Schneider Electric BV	TELE.CAD32BD		CAD32BD		-17/09		
-01K10.	1	AUX. RELAY 3NO+2NC 024VDC 10A TESYS				28287	Schneider Electric BV	TELE.CAD32BD		CAD32BD		-17/10		
-01K11.	1	AUX. RELAY 5NO+0NC 230VAC 10A TESYS				28293	Schneider Electric BV	TELE.CAD50P7		CAD50P7		-19/08		
-01K11.	1	AUX. CONTACT TIME 1NO+1NC ON DELAY*/Y30SEC.V.BRC				28389	Schneider Electric BV	TELE.LADS2		LADS2		-19/08		
-01K12.	1	AUX. RELAY 3NO+2NC 230VAC 10A TESYS				28294	Schneider Electric BV	TELE.CAD32P7		CAD32P7		-19/09		
-01K21.	1	AUX. RELAY 3NO+2NC 024VDC 10A TESYS				28287	Schneider Electric BV	TELE.CAD32BD		CAD32BD		-17/03		
-01K21.	1	AUX. CONTACT TIME 1NO+1NC ON DELAY*/Y30SEC.V.BRC				28389	Schneider Electric BV	TELE.LADS2		LADS2		-17/03		
-01K22.	1							ABB.K6-22Z/GJH121-1001-R8225 (SPECIAL ORDER)				-20/03		
-01K23.	1							ABB.K6-22Z/GJH121-1001-R8225 (SPECIAL ORDER)				-20/05		
-01K24.	1	AUX. RELAY MINIATURE 2P 8A 24VDC COMPLETE				35450	Finder	FIND.48.52.7.024.0050		48.52.7.024.0050		-17/06		
-01K25.	1	AUX. RELAY 3NO+2NC 024VDC 10A TESYS				28287	Schneider Electric BV	TELE.CAD32BD		CAD32BD		-17/13		
-01K25.	1	AUX. CONTACT TIME 1NO+1NC OFF DELAY 30SEC.				28391	Schneider Electric BV	TELE.LADR2		LADR2		-17/13		
-01K26.	1	AUX. RELAY 3NO+2NC 024VDC 10A TESYS				28287	Schneider Electric BV	TELE.CAD32BD		CAD32BD		-17/04		
-01K26.	1	AUX. CONTACT TIME 1NO+1NC OFF DELAY 30SEC.				28391	Schneider Electric BV	TELE.LADR2		LADR2		-17/04		
-01P1.	1							DEIF.DQ96-X 4-20mA/0..350kW (SPECIAL ORDER AISP)				-22/06		
-01P2.	1							BENDER.IRDH375-435/B91065000 (SPECIAL ORDER AISP)				-19/10		
-01P3.	1							DEIF.EQ96-X 0-500V AC (SPECIAL ORDER AISP)				-22/09		
-01P4.	1							DEIF.FQ96-X/45-55HZ/415VAC (SPECIAL ORDER AISP)				-22/12		
-01P5.	1							DEIF.EQ96-X 5A/0-750A (SPECIAL ORDER AISP)				-22/12		
-01Q1.	1							MERL.NSX630F (SPECIAL ORDER AISP)				-10/03		
-01S1.	1	PUSHBUTTON BODY 2NO HARMONY				75073	Schneider Electric BV	TELE.ZB4BZ103		ZB4BZ103		-14/04		
-01S1.	1	HEAD PUSHBUTTON RED HARMONY				75132	Schneider Electric BV	TELE.ZB4BA4		ZB4BA4		-14/04		
-01S1.	1	DOUBLE CONTACT ELEMENT 2NO HARMONY				75063	Schneider Electric BV	TELE.ZBE203		ZBE203		-14/04		
-01S2.	1	SELECTOR SWITCH 2P 20A 0-1 CH10 A291 FT2-V				19562	Kraus & Naimer	KRAU.CH10-A291FT2-V		CH10-A291FT2-V		-15/03		
< 8000 8000.b >														
4-1-2011	PVR						IHC DREDGERS BV - TSHD5500 DCI-3 "12EP" EMERGENCY DISTRIBUTION BOARD 3X415V PARTS LIST						Yard no : CO1266	
-12-2013	IEN	REV	1	Project : 23000143										
S BUILT				Class : LROS/IRS										
5-12-2013	IEN	CHK											Page : 12EP -8000.a	

No part of this work may be copied, stored or published without prior written permission of Alewijnse Marine Systems.

01	02	03	04	05	06	07	08	09	10	11	12	13	14	
PARTS LIST 12EP														
DEVICE		QTY	DESCRIPTION				NAV. NUMBER	MANUFACTURER	PART NUMBER		TYPE NUMBER		PAGE	
-01S3.		1	SELECTOR SWITCH VOLT INDICATOR 4 CG8 A004-624FT2-V				19531	Kraus & Naimer	KRAU.CH10-A004624FT2-V		CH10-A004624FT2-V		-22/09	
-01S5.		1	SELECTOR SWITCH AMP meter CG8 CG8 3xCT				19532	Kraus & Naimer	KRAU.CH10-A048FT2-V		CH10-A048FT2-V		-22/12	
-01S6.		1	PUSHBUTTON BODY 1NO HARMONY				75071	Schneider Electric BV	TELE.ZB4BZ101		ZB4BZ101		-16/10	
-01S6.		1	HEAD PUSHBUTTON GREEN HARMONY				75145	Schneider Electric BV	TELE.ZB4BA3		ZB4BA3		-16/10	
-01S7.		1	PUSHBUTTON BODY 1NO HARMONY				75071	Schneider Electric BV	TELE.ZB4BZ101		ZB4BZ101		-16/09	
-01S7.		1	HEAD PUSHBUTTON RED HARMONY				75132	Schneider Electric BV	TELE.ZB4BA4		ZB4BA4		-16/09	
-01T1.		1	CURRENT TRAFO for RAIL 750/5 7.5VA KL1				38609	ELEQ BV	FAGE.RM70N-E4A-750/5		RM70N-E4A-750/5		-10/03	
-01T2.		1	CURRENT TRAFO for RAIL 750/5 7.5VA KL1				38609	ELEQ BV	FAGE.RM70N-E4A-750/5		RM70N-E4A-750/5		-10/03	
-01T3.		1	CURRENT TRAFO for RAIL 750/5 7.5VA KL1				38609	ELEQ BV	FAGE.RM70N-E4A-750/5		RM70N-E4A-750/5		-10/03	
-01T4.		1	TRANSFORMER 250VA 400-460/230V TRAVOPA				38004	Transformatorenfabriek Trafa	TRAF.400-460/230V-50/60Hz-250VA		779.250		-10/08	
-01U1.		1	POWER SUPPLY 230VAC//18-29,5VDC-10A+1NO+SFB				38411	Phoenix Contact	PHOE.QUINT/1AC/24DC/10		QUINT/1AC/24DC/10		-13/02	
-01X2.		8	TERMINAL 2,50mm2 UT2,5 Screw Grey NS35/7,5/15				89200	Phoenix Contact	PHOE.UT2,5		UT2,5		-12/02	
-01X2.		1	END PART. for UT2,5-UT10 D-UT 2,5/10				89706	Phoenix Contact	PHOE.D-UT2,5/10		D-UT2,5/10		-12/02	
-01X2.		2	END-BRACKET FAST FIT CLIPFIX 35-5				89820	Phoenix Contact	PHOE.CLIPFIX35-5		CLIPFIX35-5		-12/02	
-01X3.		15	TERMINAL 2,50mm2 UT2,5 Screw Grey NS35/7,5/15				89200	Phoenix Contact	PHOE.UT2,5		UT2,5		-13/02	
-01X3.		1	END PART. for UT2,5-UT10 D-UT 2,5/10				89706	Phoenix Contact	PHOE.D-UT2,5/10		D-UT2,5/10		-13/02	
-01X3.		1	END-BRACKET FAST FIT CLIPFIX 35-5				89820	Phoenix Contact	PHOE.CLIPFIX35-5		CLIPFIX35-5		-13/02	
-01X4.		8	TERMINAL 2,50mm2 UT2,5 Screw Grey NS35/7,5/15				89200	Phoenix Contact	PHOE.UT2,5		UT2,5		-21/06	
-01X4.		1	END PART. for UT2,5-UT10 D-UT 2,5/10				89706	Phoenix Contact	PHOE.D-UT2,5/10		D-UT2,5/10		-21/06	
-01X4.		1	END-BRACKET FAST FIT CLIPFIX 35-5				89820	Phoenix Contact	PHOE.CLIPFIX35-5		CLIPFIX35-5		-21/06	
-01X5.		28	TERMINAL 2,50mm2 UT2,5 Screw Grey NS35/7,5/15				89200	Phoenix Contact	PHOE.UT2,5		UT2,5		-23/03	
-01X5.		1	END PART. for UT2,5-UT10 D-UT 2,5/10				89706	Phoenix Contact	PHOE.D-UT2,5/10		D-UT2,5/10		-23/03	
-01X5.		1	END-BRACKET FAST FIT CLIPFIX 35-5				89820	Phoenix Contact	PHOE.CLIPFIX35-5		CLIPFIX35-5		-23/03	
-01X7.		5	TERMINAL 2,50mm2 UT2,5 Screw Grey NS35/7,5/15				89200	Phoenix Contact	PHOE.UT2,5		UT2,5		-22/07	
-01X7.		1	END PART. for UT2,5-UT10 D-UT 2,5/10				89706	Phoenix Contact	PHOE.D-UT2,5/10		D-UT2,5/10		-22/07	
-01X7.		1	END-BRACKET FAST FIT CLIPFIX 35-5				89820	Phoenix Contact	PHOE.CLIPFIX35-5		CLIPFIX35-5		-22/07	
-02E1.		1	COMPACT CB NS100..630 TIME DELAY MN 220-250V				42362	Schneider Electric BV	MERL.MN-DELAY_ADJUSTABLE		33682		-27/12	
-02F1.		2	DII/E27 SIZE FUSE BASE 25A "TRITON"				40417	Wohner Benelux BV	WOHN.31173		31173		-25/06	
-02F1.		2	FUSE SIZE DII 16A SLOW				40004	Siemens Nederland NV	SIEM.5SB261		5SB261		-25/06	
-02F1.		2	FITTED SCREW SII 16 Amp				40014	Siemens Nederland NV	SIEM.5SH314		5SH314		-25/06	
-02F1.		2	SCREW CAP DII 25A AC DC 500V CERAMIKS				40041	Siemens Nederland NV	SIEM.5SH112		5SH112		-25/06	
-02F2.		1	CIRC. BREAKER 2P 04A D 10kA/230V Im=14xIn				42225	Schneider Electric BV	MERL.C60N-2P-D4		24583 // C60 N		-25/07	
-02F3.		1	GLASS FUSE 05x20mm 04,00A FAST VE10				40173	Technische Unie BV	ESKA.05X20\F4,00A		20.64.00.610		-25/08	
-02F3.		1	TERMINAL 4,00mm2 FUSE UT4-HESI (5x20) 6A Black				89264	Phoenix Contact	PHOE.UT4-HESI(5X20)		UT4-HESI(5X20)		-25/08	
-02F4.		1	GLASS FUSE 05x20mm 02,00A FAST VE10				40170	Technische Unie BV	ESKA.05X20\F2,00A		20.64.00.580		-25/09	
-02F4.		1	TERMINAL 4,00mm2 FUSE UT4-HESI (5x20) 6A Black				89264	Phoenix Contact	PHOE.UT4-HESI(5X20)		UT4-HESI(5X20)		-25/09	
-02F5.		1	GLASS FUSE 05x20mm 02,00A FAST VE10				40170	Technische Unie BV	ESKA.05X20\F2,00A		20.64.00.580		-25/10	
-02F5.		1	TERMINAL 4,00mm2 FUSE UT4-HESI (5x20) 6A Black				89264	Phoenix Contact	PHOE.UT4-HESI(5X20)		UT4-HESI(5X20)		-25/10	
-02F6.		1	GLASS FUSE 05x20mm 02,00A FAST VE10				40170	Technische Unie BV	ESKA.05X20\F2,00A		20.64.00.580		-25/10	
-02F6.		1	TERMINAL 4,00mm2 FUSE UT4-HESI (5x20) 6A Black				89264	Phoenix Contact	PHOE.UT4-HESI(5X20)		UT4-HESI(5X20)		-25/10	
< 8000.a 8000.c >														
4-1-2011	PVR					IHC DREDGERS BV - TSHD5500 DCI-3 "12EP" EMERGENCY DISTRIBUTION BOARD 3X415V PARTS LIST							Yard no : C01266	
-12-2013	IEN	REV	1										Project : 23000143	
S BUILT													Class : LROS/IRS	
5-12-2013	IEN	CHK											Page : 12EP -8000.b	

No part of this work may be copied, stored or published without prior written permission of Alewijnse Marine Systems.	01	02	03	04	05	06	07	08	09	10	11	12	13	14
	PARTS LIST 12EP													
	DEVICE	QTY	DESCRIPTION				NAV. NUMBER	MANUFACTURER	PART NUMBER		TYPE NUMBER		PAGE	
	-03F3.	1	TERMINAL 4,00mm2 FUSE UT4-HESI (5x20) 6A Black				89264	Phoenix Contact	PHOE.UT4-HESI(5X20)		UT4-HESI(5X20)		-35/03	
	-03F4.	1	GLASS FUSE 05x20mm 02,00A FAST VE10				40170	Technische Unie BV	ESKA.05X20\F2,00A		20.64.00.580		-35/04	
	-03F4.	1	TERMINAL 4,00mm2 FUSE UT4-HESI (5x20) 6A Black				89264	Phoenix Contact	PHOE.UT4-HESI(5X20)		UT4-HESI(5X20)		-35/04	
	-03F5.	1	GLASS FUSE 05x20mm 02,00A FAST VE10				40170	Technische Unie BV	ESKA.05X20\F2,00A		20.64.00.580		-35/05	
	-03F5.	1	TERMINAL 4,00mm2 FUSE UT4-HESI (5x20) 6A Black				89264	Phoenix Contact	PHOE.UT4-HESI(5X20)		UT4-HESI(5X20)		-35/05	
	-03M1.	1	FAN 230VAC 180-205m3/h 255x255mm				50363	Rittal	RITT.SK3240.100		SK3240.100		-36/03	
	-03M3.	1	FAN 230VAC 230-250m3/h 255x255mm				50364	Rittal	RITT.SK3241.100		SK3241.100		-36/06	
	-03T1.	1	TRANSFORMER 250VA 400-460/230V TRAVOPA				38004	Transformatorenfabriek Trafa	TRAF.400-460/230V-50/60Hz-250VA		779.250		-35/02	
	-05Q1.	1	COMPACT CB NSX100F FRAME 3P 36kA 400VAC				98730	Schneider Electric BV	MERL.NSX100F-3P		LV429003		-40/02	
	-05Q1.	1	COMPACT CB NSX100-250 PROT. 3P 036-100A MICROLOGIC 2.2				98754	Schneider Electric BV	MERL.NSX100-250/M2.2/100A/3P		LV429070		-40/02	
	-06F1.	1	GLASS FUSE 05x20mm 04,00A FAST VE10				40173	Technische Unie BV	ESKA.05X20\F4,00A		20.64.00.610		-40/07	
	-06F1.	1	TERMINAL 4,00mm2 FUSE UT4-HESI (5x20) 6A Black				89264	Phoenix Contact	PHOE.UT4-HESI(5X20)		UT4-HESI(5X20)		-40/07	
	-06H4.	1	PILOT LIGHT P-LED WHITE 24VAC/DC HARMONY				75009	Schneider Electric BV	TELE.XB4BVB1		XB4BVB1		-41/04	
	-06K1.	1	CONTACTOR 3P 009A AC3 1NO+1NC 24VDC BR.B				28349	Schneider Electric BV	TELE.LC1D09BD		LC1D09BD		-41/06	
	-06K1.	1	AUX. CONTACT 2NO+2NC for LC1-D TESYS				28393	Schneider Electric BV	TELE.LADN22		LADN-22		-41/06	
	-06K2.	1	AUX. RELAY MINIATURE 4P 7A 24VDC COMPLETE				35460	Finder	FIND.58.34.9.024.0050		58.34.9.024.0050		-41/03	
	-06Q1.	1	MOTOR PROT. THER. MAGN 4-6,3A ROTARY				28740	Schneider Electric BV	TELE.GV2P10		GV2P10		-40/05	
	-06Q1.	1	AUX. CONTACT 1NO+1NO (fault) SIDE CONN. for GV2 TESYS				28159	Schneider Electric BV	TELE.GVAD1010		GVAD1010		-40/05	
	-06S1.	1							KRAU.CH10-A291*NLB406FT2				-41/03	
	-06S3.	1	HEAD PUSHBUTTON RED HARMONY				75132	Schneider Electric BV	TELE.ZB4BA4		ZB4BA4		-41/06	
	-06S3.	1	PUSHBUTTON BODY 1NC HARMONY				75072	Schneider Electric BV	TELE.ZB4BZ102		ZB4BZ102		-41/06	
	-06SH2.	1	HEAD ILL. PUSHBUTTON GREEN for LED HARMONY				75175	Schneider Electric BV	TELE.ZB4BW333		ZB4BW333		-41/06	
	-06SH2.	1	PUSHBUTTON BODY 1NO + P-LED GREEN 24V HARMONY				75085	Schneider Electric BV	TELE.ZB4BW0B31		ZB4BW0B31		-41/06	
	-06U1.	1	POWER SUPPLY 3ph-400VAC//22,5-29,5VDC-5A				38397	Phoenix Contact	PHOE.TRIO-PS/3AC/24DC/5		TRIO-PS/3AC/24DC/5		-40/07	
	-06X3.	6	TERMINAL 2,50mm2 UT2,5 Screw Grey NS35/7,5/15				89200	Phoenix Contact	PHOE.UT2,5		UT2,5		-41/03	
	-06X3.	1	END PART. for UT2,5-UT10 D-UT 2,5/10				89706	Phoenix Contact	PHOE.D-UT2,5/10		D-UT2,5/10		-41/03	
	-06X3.	2	END-BRACKET FAST FIT CLIPFIX 35-5				89820	Phoenix Contact	PHOE.CLIPFIX35-5		CLIPFIX35-5		-41/03	
	-06X5.	8	TERMINAL 2,50mm2 UT2,5 Screw Grey NS35/7,5/15				89200	Phoenix Contact	PHOE.UT2,5		UT2,5		-41/10	
	-06X5.	1	END PART. for UT2,5-UT10 D-UT 2,5/10				89706	Phoenix Contact	PHOE.D-UT2,5/10		D-UT2,5/10		-41/10	
-06X5.	1	END-BRACKET FAST FIT CLIPFIX 35-5				89820	Phoenix Contact	PHOE.CLIPFIX35-5		CLIPFIX35-5		-41/10		
-07F1.	1	GLASS FUSE 05x20mm 04,00A FAST VE10				40173	Technische Unie BV	ESKA.05X20\F4,00A		20.64.00.610		-40/13		
-07F1.	1	TERMINAL 4,00mm2 FUSE UT4-HESI (5x20) 6A Black				89264	Phoenix Contact	PHOE.UT4-HESI(5X20)		UT4-HESI(5X20)		-40/13		
-07F2.	2	GLASS FUSE 05x20mm 02,00A FAST VE10				40170	Technische Unie BV	ESKA.05X20\F2,00A		20.64.00.580		-12/05		
-07F2.	2	TERMINAL 4,00mm2 FUSE UT4-HESI (5x20) 6A Black				89264	Phoenix Contact	PHOE.UT4-HESI(5X20)		UT4-HESI(5X20)		-12/05		
-07H4.	1	PILOT LIGHT P-LED WHITE 24VAC/DC HARMONY				75009	Schneider Electric BV	TELE.XB4BVB1		XB4BVB1		-42/06		
-07H5.	1	PILOT LIGHT P-LED BLUE 230VAC HARMONY				75016	Schneider Electric BV	TELE.XB4BVM6		XB4BVM6		-43/04		
-07H5.	1	OVER VOLTAGE ELEMENT 230VAC HARMONY				75010	Schneider Electric BV	TELE.ZBZ-VM		ZBZ-VM		-43/04		
-07H6.	1	PILOT LIGHT P-LED RED 230VAC HARMONY				75012	Schneider Electric BV	TELE.XB4BVM4		XB4BVM4		-43/13		
-07H6.	1	OVER VOLTAGE ELEMENT 230VAC HARMONY				75010	Schneider Electric BV	TELE.ZBZ-VM		ZBZ-VM		-43/13		
-07K1.	1	CONTACTOR 3P 025A AC3 1NO+1NC 24V TESYS LC1D25BD				28563	Schneider Electric BV	TELE.LC1D25BD		LC1D25BD		-42/08		
< 8000.c														8000.e >
D	24-1-2011	PVR					IHC DREDGERS BV - TSHD5500 DCI-3 "12EP" EMERGENCY DISTRIBUTION BOARD 3X415V PARTS LIST						Yard no : CO1266	
M	5-12-2013	IEN	REV	1									Project : 23000143	
STAT	AS BUILT												Class : LROS/IRS	
	05-12-2013	IEN	CHK										Page : 12EP -8000.d	
					ALEWIJNSE MARINE B.V. ENERGIEWEG 46/C 6541 CX NIJMEGEN									

No part of this work may be copied, stored or published without prior written permission of Alewijnse Marine Systems.

01	02	03	04	05	06	07	08	09	10	11	12	13	14		
PARTS LIST12EP															
DEVICE		QTY	DESCRIPTION				NAV. NUMBER	MANUFACTURER	PART NUMBER		TYPE NUMBER		PAGE		
-07K1.		1	AUX. CONTACT 2NO+0NC for LC1-D TESYS				28376	Schneider Electric BV	TELE.LADN20		LADN20		-42/08		
-07K2.		1	AUX. RELAY MINIATURE 4P 7A 24VDC COMPLETE				35460	Finder	FIND.58.34.9.024.0050		58.34.9.024.0050		-42/05		
-07K3.		1	AUX. RELAY MINIATURE 2P 8A 24VDC COMPLETE				35450	Finder	FIND.48.52.7.024.0050		48.52.7.024.0050		-42/14		
-07K4.		1	AUX. RELAY MINIATURE 2P 8A 230VAC COMPLETE				35451	Finder	FIND.48.52.8.230.0060		48.52.8.230.0060		-43/11		
-07P1.		1							DEIF.EQ96-X 5A/0-25//50A (SPECIAL ORDER AISP)				-43/06		
-07Q1.		1	MOTOR PROT. THER. MAGN 17-23A ROTARY				28712	Schneider Electric BV	TELE.GV2P21		GV2P21		-40/10		
-07Q1.		1	AUX. CONTACT 1NO+1NO (fault) SIDE CONN. for GV2 TESYS				28159	Schneider Electric BV	TELE.GVAD1010		GVAD1010		-40/10		
-07S1.		1	HEAD PUSHBUTTON RED HARMONY				75132	Schneider Electric BV	TELE.ZB4BA4		ZB4BA4		-42/09		
-07S1.		1	PUSHBUTTON BODY 1NC HARMONY				75072	Schneider Electric BV	TELE.ZB4BZ102		ZB4BZ102		-42/09		
-07SH2.		1	HEAD ILL. PUSHBUTTON GREEN for LED HARMONY				75175	Schneider Electric BV	TELE.ZB4BW333		ZB4BW333		-42/09		
-07SH2.		1	PUSHBUTTON BODY 1NO + P-LED GREEN 24V HARMONY				75085	Schneider Electric BV	TELE.ZB4BW0B31		ZB4BW0B31		-42/09		
-07T2.		1	CURRENT TRAFO for RAIL 25/5 0,5VA KL3				38651	ELEQ BV	FAGE.RM60N-E2A-25/5		RM60N-E2A-25/5		-40/11		
-07U1.		1	POWER SUPPLY 3ph-400VAC//22,5-29,5VDC-5A				38397	Phoenix Contact	PHOE.TRIO-PS/3AC/24DC/5		TRIO-PS/3AC/24DC/5		-40/13		
-07X1.		3	TERMINAL 4,00mm2 UT4 Screw Grey NS35/7,5/15				89240	Phoenix Contact	PHOE.UT4		UT4		-40/13		
-07X1.		1	END PART. for UT2,5-UT10 D-UT 2,5/10				89706	Phoenix Contact	PHOE.D-UT2,5/10		D-UT2,5/10		-40/13		
-07X1.		2	END-BRACKET FAST FIT CLIPFIX 35-5				89820	Phoenix Contact	PHOE.CLIPFIX35-5		CLIPFIX35-5		-40/13		
-07X2.		2	TERMINAL 2,50mm2 UT2,5 Screw Grey NS35/7,5/15				89200	Phoenix Contact	PHOE.UT2,5		UT2,5		-43/03		
-07X2.		1	END PART. for UT2,5-UT10 D-UT 2,5/10				89706	Phoenix Contact	PHOE.D-UT2,5/10		D-UT2,5/10		-43/03		
-07X2.		1	END-BRACKET FAST FIT CLIPFIX 35-5				89820	Phoenix Contact	PHOE.CLIPFIX35-5		CLIPFIX35-5		-43/03		
-07X3.		14	TERMINAL 2,50mm2 UT2,5 Screw Grey NS35/7,5/15				89200	Phoenix Contact	PHOE.UT2,5		UT2,5		-42/03		
-07X3.		1	END PART. for UT2,5-UT10 D-UT 2,5/10				89706	Phoenix Contact	PHOE.D-UT2,5/10		D-UT2,5/10		-42/03		
-07X3.		1	END-BRACKET FAST FIT CLIPFIX 35-5				89820	Phoenix Contact	PHOE.CLIPFIX35-5		CLIPFIX35-5		-42/03		
-07X5.		8	TERMINAL 2,50mm2 UT2,5 Screw Grey NS35/7,5/15				89200	Phoenix Contact	PHOE.UT2,5		UT2,5		-43/08		
-07X5.		1	END PART. for UT2,5-UT10 D-UT 2,5/10				89706	Phoenix Contact	PHOE.D-UT2,5/10		D-UT2,5/10		-43/08		
-07X5.		1	END-BRACKET FAST FIT CLIPFIX 35-5				89820	Phoenix Contact	PHOE.CLIPFIX35-5		CLIPFIX35-5		-43/08		
-08F1.		1	GLASS FUSE 05x20mm 04,00A FAST VE10				40173	Technische Unie BV	ESKA.05X20\F4,00A		20.64.00.610		-50/05		
-08F1.		1	TERMINAL 4,00mm2 FUSE UT4-HESI (5x20) 6A Black				89264	Phoenix Contact	PHOE.UT4-HESI(5X20)		UT4-HESI(5X20)		-50/05		
-08F2.		2	GLASS FUSE 05x20mm 02,00A FAST VE10				40170	Technische Unie BV	ESKA.05X20\F2,00A		20.64.00.580		-12/06		
-08F2.		2	TERMINAL 4,00mm2 FUSE UT4-HESI (5x20) 6A Black				89264	Phoenix Contact	PHOE.UT4-HESI(5X20)		UT4-HESI(5X20)		-12/06		
-08H4.		1	PILOT LIGHT P-LED WHITE 24VAC/DC HARMONY				75009	Schneider Electric BV	TELE.XB4BVB1		XB4BVB1		-51/05		
-08H5.		1	PILOT LIGHT P-LED BLUE 230VAC HARMONY				75016	Schneider Electric BV	TELE.XB4BVM6		XB4BVM6		-52/04		
-08H5.		1	OVER VOLTAGE ELEMENT 230VAC HARMONY				75010	Schneider Electric BV	TELE.ZBZ-VM		ZBZ-VM		-52/04		
-08H6.		1	PILOT LIGHT P-LED RED 230VAC HARMONY				75012	Schneider Electric BV	TELE.XB4BVM4		XB4BVM4		-52/13		
-08H6.		1	OVER VOLTAGE ELEMENT 230VAC HARMONY				75010	Schneider Electric BV	TELE.ZBZ-VM		ZBZ-VM		-52/13		
-08K1.		1	CONTACTOR 3P 025A AC3 1NO+1NC 24V TESYS LC1D25BD				28563	Schneider Electric BV	TELE.LC1D25BD		LC1D25BD		-51/07		
-08K1.		1	AUX. CONTACT TIME 1NO+1NC OFF DELAY 180SEC.				28392	Schneider Electric BV	TELE.LADR4		LADR4		-51/07		
-08K2.		1	CONTACTOR 3P 025A AC3 1NO+1NC 24V TESYS LC1D25BD				28563	Schneider Electric BV	TELE.LC1D25BD		LC1D25BD		-51/10		
-08K2.		1	AUX. CONTACT TIME 1NO+1NC OFF DELAY 180SEC.				28392	Schneider Electric BV	TELE.LADR4		LADR4		-51/10		
-08K3.		1	AUX. RELAY MINIATURE 4P 7A 24VDC COMPLETE				35460	Finder	FIND.58.34.9.024.0050		58.34.9.024.0050		-51/04		
-08K4.		1	AUX. RELAY MINIATURE 4P 7A 24VDC COMPLETE				35460	Finder	FIND.58.34.9.024.0050		58.34.9.024.0050		-51/08		
< 8000.d8000.f >															
4-1-2011		PVR				 ALEWIJNSE MARINE B.V. ENERGIEWEG 46/C 6541 CX NIJMEGEN		IHC DREDGERS BV - TSHD5500 DCI-3 "12EP" EMERGENCY DISTRIBUTION BOARD 3X415V PARTS LIST					Yard no : CO1266		
-12-2013		IEN		REV1									Project : 23000143		
S BUILT					Class : LROS/IRS										
5-12-2013		IEN		CHK									Page : 12EP -8000.e		

No part of this work may be copied, stored or published without prior written permission of Alewijnse Marine Systems.

01	02	03	04	05	06	07	08	09	10	11	12	13	14	
PARTS LIST12EP														
DEVICE	QTY	DESCRIPTION					NAV. NUMBER	MANUFACTURER	PART NUMBER		TYPE NUMBER		PAGE	
-08K5.	1	AUX. RELAY MINIATURE 4P 7A 24VDC COMPLETE					35460	Finder	FIND.58.34.9.024.0050		58.34.9.024.0050		-51/11	
-08K6.	1	AUX. RELAY MINIATURE 2P 8A 24VDC COMPLETE					35450	Finder	FIND.48.52.7.024.0050		48.52.7.024.0050		-51/06	
-08K7.	1	AUX. RELAY MINIATURE 2P 8A 230VAC COMPLETE					35451	Finder	FIND.48.52.8.230.0060		48.52.8.230.0060		-52/11	
-08P1.	1								DEIF.EQ96-X 5A/0-25//50A (SPECIAL ORDER AISP)				-52/06	
-08Q1.	1	MOTOR PROT. THER. MAGN 17-23A ROTARY					28712	Schneider Electric BV	TELE.GV2P21		GV2P21		-50/02	
-08Q1.	1	AUX. CONTACT 1NO+1NO (fault) SIDE CONN. for GV2 TESYS					28159	Schneider Electric BV	TELE.GVAD1010		GVAD1010		-50/02	
-08S1.	1	HEAD PUSHBUTTON RED HARMONY					75132	Schneider Electric BV	TELE.ZB4BA4		ZB4BA4		-51/07	
-08S1.	1	PUSHBUTTON BODY 1NC HARMONY					75072	Schneider Electric BV	TELE.ZB4BZ102		ZB4BZ102		-51/07	
-08SH2.	1	HEAD ILL. PUSHBUTTON GREEN for LED HARMONY					75175	Schneider Electric BV	TELE.ZB4BW333		ZB4BW333		-51/07	
-08SH2.	1	PUSHBUTTON BODY 1NO + P-LED GREEN 24V HARMONY					75085	Schneider Electric BV	TELE.ZB4BW0B31		ZB4BW0B31		-51/07	
-08SH3.	1	HEAD ILL. PUSHBUTTON GREEN for LED HARMONY					75175	Schneider Electric BV	TELE.ZB4BW333		ZB4BW333		-51/10	
-08SH3.	1	PUSHBUTTON BODY 1NO + P-LED GREEN 24V HARMONY					75085	Schneider Electric BV	TELE.ZB4BW0B31		ZB4BW0B31		-51/10	
-08T2.	1	CURRENT TRAFO for RAIL 25/5 0,5VA KL3					38651	ELEQ BV	FAGE.RM60N-E2A-25/5		RM60N-E2A-25/5		-50/03	
-08U1.	1	POWER SUPPLY 3ph-400VAC//22,5-29,5VDC-5A					38397	Phoenix Contact	PHOE.TRIO-PS/3AC/24DC/5		TRIO-PS/3AC/24DC/5		-50/05	
-08X1.	3	TERMINAL 4,00mm2 UT4 Screw Grey NS35/7,5/15					89240	Phoenix Contact	PHOE.UT4		UT4		-50/06	
-08X1.	1	END PART. for UT2,5-UT10 D-UT 2,5/10					89706	Phoenix Contact	PHOE.D-UT2,5/10		D-UT2,5/10		-50/06	
-08X1.	2	END-BRACKET FAST FIT CLIPFIX 35-5					89820	Phoenix Contact	PHOE.CLIPFIX35-5		CLIPFIX35-5		-50/06	
-08X2.	2	TERMINAL 2,50mm2 UT2,5 Screw Grey NS35/7,5/15					89200	Phoenix Contact	PHOE.UT2,5		UT2,5		-52/03	
-08X2.	1	END PART. for UT2,5-UT10 D-UT 2,5/10					89706	Phoenix Contact	PHOE.D-UT2,5/10		D-UT2,5/10		-52/03	
-08X2.	1	END-BRACKET FAST FIT CLIPFIX 35-5					89820	Phoenix Contact	PHOE.CLIPFIX35-5		CLIPFIX35-5		-52/03	
-08X3.	17	TERMINAL 2,50mm2 UT2,5 Screw Grey NS35/7,5/15					89200	Phoenix Contact	PHOE.UT2,5		UT2,5		-51/03	
-08X3.	1	END PART. for UT2,5-UT10 D-UT 2,5/10					89706	Phoenix Contact	PHOE.D-UT2,5/10		D-UT2,5/10		-51/03	
-08X3.	1	END-BRACKET FAST FIT CLIPFIX 35-5					89820	Phoenix Contact	PHOE.CLIPFIX35-5		CLIPFIX35-5		-51/03	
-08X5.	10	TERMINAL 2,50mm2 UT2,5 Screw Grey NS35/7,5/15					89200	Phoenix Contact	PHOE.UT2,5		UT2,5		-52/08	
-08X5.	1	END PART. for UT2,5-UT10 D-UT 2,5/10					89706	Phoenix Contact	PHOE.D-UT2,5/10		D-UT2,5/10		-52/08	
-08X5.	1	END-BRACKET FAST FIT CLIPFIX 35-5					89820	Phoenix Contact	PHOE.CLIPFIX35-5		CLIPFIX35-5		-52/08	
-09Q1.	1	MOTOR PROT. THER. MAGN 1,6-2,5A ROTARY					28738	Schneider Electric BV	TELE.GV2P07		GV2P07		-50/07	
-10Q1.	1	MOTOR PROT. THER. MAGN 1,6-2,5A ROTARY					28738	Schneider Electric BV	TELE.GV2P07		GV2P07		-50/10	
-11Q1.	1	MOTOR PROT. THER. MAGN 1,6-2,5A ROTARY					28738	Schneider Electric BV	TELE.GV2P07		GV2P07		-50/12	
-12Q1.	1	MOTOR PROT. THER. MAGN 1,6-2,5A ROTARY					28738	Schneider Electric BV	TELE.GV2P07		GV2P07		-60/02	
-13Q1.	1	MOTOR PROT. THER. MAGN 1,6-2,5A ROTARY					28738	Schneider Electric BV	TELE.GV2P07		GV2P07		-60/05	
-14Q1.	1	MOTOR PROT. THER. MAGN 24-32A ROTARY					28714	Schneider Electric BV	TELE.GV2P32		GV2P32		-60/08	
-15Q1.	1	MOTOR PROT. THER. MAGN 37-50A ROTARY					29182	Schneider Electric BV	TELE.GV3P50		GV3P50		-60/11	
-16Q1.	1	MOTOR PROT. THER. MAGN 24-32A ROTARY					28714	Schneider Electric BV	TELE.GV2P32		GV2P32		-65/02	
-17Q1.	1	MOTOR PROT. THER. MAGN 9-14A ROTARY					28742	Schneider Electric BV	TELE.GV2P16		GV2P16		-65/05	
-18Q1.	1	COMPACT CB NSX100F FRAME 3P 36kA 400VAC					98730	Schneider Electric BV	MERL.NSX100F-3P		LV429003		-65/08	
-18Q1.	1								MERL.NSX100/M5.2A/100A/3P (LV429090)				-65/08	
-18Q1.	2	NSX100-630 AUX.CONTACT 1XCO OF/SD/SDE/SDV					42296	Schneider Electric BV	MERL.NSX100-630/OF SD SDE SDV		29450		-65/08	
-19Q1.	1	MOTOR PROT. THER. MAGN 20-25A ROTARY					28713	Schneider Electric BV	TELE.GV2P22		GV2P22		-65/11	
-20Q1.	1	MOTOR PROT. THER. MAGN 24-32A ROTARY					28714	Schneider Electric BV	TELE.GV2P32		GV2P32		-70/02	
< 8000.e8000.g >														
4-1-2011	PVR						IHC DREDGERS BV - TSHD5500 DCI-3 "12EP" EMERGENCY DISTRIBUTION BOARD 3X415V PARTS LIST						Yard no : CO1266	
-12-2013	IEN	REV	1										Project : 23000143	
S BUILT													Class : LROS/IRS	
5-12-2013	IEN	CHK											Page : 12EP -8000.f	

No part of this work may be copied, stored or published without prior written permission of Alewijnse Marine Systems.

No part of this work may be copied, stored or published without prior written permission of Alewijnse Marine Systems.	01	02	03	04	05	06	07	08	09	10	11	12	13	14		
	PARTS LIST 12EP															
	DEVICE	QTY	DESCRIPTION				NAV. NUMBER	MANUFACTURER	PART NUMBER		TYPE NUMBER		PAGE			
	-21Q1.	1	MOTOR PROT. THER. MAGN 48-65A ROTARY				29183	Schneider Electric BV	TELE.GV3P65		GV3P65		-70/05			
	-22F1.	2	FUSE 5x25mm 04,00A FAST 70KA 7008913E				40605	SIBA-Nederland GmbH	SIBA.05X25/F4,00A/70KA		7008913.4		-70/11			
	-22F1.	2	FUSE BASE 5x25 SAKS1/35 050152				59631	Weidmuller BV	WEID.SAKS 1/35 (5X25)		SAKS 1/35 (5X25)		-70/11			
	-22F1.	1	COVER PLATE AP ASK 1 PA 038036				59657	Weidmuller BV	WEID.ASK1-COVER		AP ASK1		-70/11			
	-22F2.	2	GLASS FUSE 05x20mm 02,00A FAST VE10				40170	Technische Unie BV	ESKA.05X20\F2,00A		20.64.00.580		-12/08			
	-22F2.	2	TERMINAL 4,00mm2 FUSE UT4-HESI (5x20) 6A Black				89264	Phoenix Contact	PHOE.UT4-HESI(5X20)		UT4-HESI(5X20)		-12/08			
	-22F3.	1	GLASS FUSE 05x20mm 02,00A FAST VE10				40170	Technische Unie BV	ESKA.05X20\F2,00A		20.64.00.580		-70/11			
	-22F3.	1	TERMINAL 4,00mm2 FUSE UT4-HESI (5x20) 6A Black				89264	Phoenix Contact	PHOE.UT4-HESI(5X20)		UT4-HESI(5X20)		-70/11			
	-22H4.	1	PILOT LIGHT P-LED WHITE 230VAC HARMONY				75019	Schneider Electric BV	TELE.XB4BVM1		XB4BVM1		-71/04			
	-22H4.	1	OVER VOLTAGE ELEMENT 230VAC HARMONY				75010	Schneider Electric BV	TELE.ZBZ-VM		ZBZ-VM		-71/04			
	-22H5.	1	PILOT LIGHT P-LED BLUE 230VAC HARMONY				75016	Schneider Electric BV	TELE.XB4BVM6		XB4BVM6		-73/04			
	-22H5.	1	OVER VOLTAGE ELEMENT 230VAC HARMONY				75010	Schneider Electric BV	TELE.ZBZ-VM		ZBZ-VM		-73/04			
	-22K1.	1	COIL for LC1-F115/150 230VAC/40-400Hz				34348	Schneider Electric BV	TELE.LX9FF220		LX9FF220		-72/09			
	-22K1.	1	CONTACTOR 3P 115A AC3 EXCL. COIL				28007	Schneider Electric BV	TELE.LC1F115		LC1F115		-72/09			
	-22K1.	1	AUX. CONTACT 2NO+2NC for LC1-D TESYS				28393	Schneider Electric BV	TELE.LADN22		LADN-22		-72/09			
	-22K2.	1							ABB.K6-31Z/GJH121-1001-R8310 (SPECIAL ORDER)				-71/09			
	-22K3.	1							ABB.K6-40E/GJH121-1001-R8400 (SPECIAL ORDER)				-72/03			
	-22K4.	1							ABB.K6-40E/GJH121-1001-R8400 (SPECIAL ORDER)				-71/03			
	-22K5.	1							ABB.K6-40E/GJH121-1001-R8400 (SPECIAL ORDER)				-72/11			
	-22P1.	1							DEIF.EQ96-X 5A/0-100//200A (SPECIAL ORDER AISP)				-73/06			
	-22Q1.	1	MOTOR PROT. THER. MAGN 48-65A ROTARY				29183	Schneider Electric BV	TELE.GV3P65		GV3P65		-70/08			
	-22Q1.	1	AUX. CONTACT 1NO (fault) + 1NO FRONT for GV3 TESYS				29175	Schneider Electric BV	TELE.GVAED101		GVAED101		-70/08			
	-22S1.	1	HEAD PUSHBUTTON RED HARMONY				75132	Schneider Electric BV	TELE.ZB4BA4		ZB4BA4		-71/09			
	-22S1.	1	PUSHBUTTON BODY 1NC HARMONY				75072	Schneider Electric BV	TELE.ZB4BZ102		ZB4BZ102		-71/09			
	-22S3.	1	SELECTOR SWITCH 2P 20A 1-0-2 CH10 A211 FT2-V				19581	Kraus & Naimer	KRAU.CH10-A211FT2-V		CH10-A211FT2-V		-71/09			
	-22SH2.	1	HEAD ILL. PUSHBUTTON GREEN for LED HARMONY				75175	Schneider Electric BV	TELE.ZB4BW333		ZB4BW333		-71/09			
	-22SH2.	1	PUSHBUTTON BODY 1NO + P-LED GREEN 230V HARMONY				75105	Schneider Electric BV	TELE.ZB4BW0M31		ZB4BW0M31		-71/09			
	-22SH2.	1	OVER VOLTAGE ELEMENT 230VAC HARMONY				75010	Schneider Electric BV	TELE.ZBZ-VM		ZBZ-VM		-71/09			
	-22T1.	1	TRANSFORMER 250VA 400-460/230V TRAVOPA				38004	Transformatorenfabriek Trafa	TRAF.400-460/230V-50/60Hz-250VA		779.250		-70/11			
	-22T2.	1	CURRENT TRAFO for RAIL 100/5 2VA KL1				38618	ELEQ BV	FAGE.RM60N-E3A-100/5		RM60N-E3A-100/5		-70/08			
	-22U1.	1							SOLC.RVS-DN85-400-230-230-9-M-S				-70/08			
	-22X2.	20	TERMINAL 2,50mm2 UT2,5 Screw Grey NS35/7,5/15				89200	Phoenix Contact	PHOE.UT2,5		UT2,5		-71/03			
	-22X2.	1	END PART. for UT2,5-UT10 D-UT 2,5/10				89706	Phoenix Contact	PHOE.D-UT2,5/10		D-UT2,5/10		-71/03			
	-22X2.	2	END-BRACKET FAST FIT CLIPFIX 35-5				89820	Phoenix Contact	PHOE.CLIPFIX35-5		CLIPFIX35-5		-71/03			
	-22X3.	3	TERMINAL 2,50mm2 UT2,5 Screw Grey NS35/7,5/15				89200	Phoenix Contact	PHOE.UT2,5		UT2,5		-73/09			
	-22X3.	1	END PART. for UT2,5-UT10 D-UT 2,5/10				89706	Phoenix Contact	PHOE.D-UT2,5/10		D-UT2,5/10		-73/09			
	-22X3.	1	END-BRACKET FAST FIT CLIPFIX 35-5				89820	Phoenix Contact	PHOE.CLIPFIX35-5		CLIPFIX35-5		-73/09			
	-22X5.	8	TERMINAL 2,50mm2 UT2,5 Screw Grey NS35/7,5/15				89200	Phoenix Contact	PHOE.UT2,5		UT2,5		-73/09			
-22X5.	1	END PART. for UT2,5-UT10 D-UT 2,5/10				89706	Phoenix Contact	PHOE.D-UT2,5/10		D-UT2,5/10		-73/09				
-22X5.	1	END-BRACKET FAST FIT CLIPFIX 35-5				89820	Phoenix Contact	PHOE.CLIPFIX35-5		CLIPFIX35-5		-73/09				
< 8000.f																
D	24-1-2011	PVR					IHC DREDGERS BV - TSHD5500 DCI-3							Yard no : CO1266		
M	5-12-2013	IEN	REV	1			"12EP" EMERGENCY DISTRIBUTION BOARD 3X415V							Project : 23000143		
STAT	AS BUILT						PARTS LIST							Class : LROS/IRS		
	05-12-2013	IEN	CHK											Page : 12EP -8000.g		
						ALEWIJNSE MARINE B.V. ENERGIEWEG 46/C 6541 CX NIJMEGEN										

No part of this work may be copied, stored or published without prior written permission of Alewijnse Marine Systems.

01	02	03	04	05	06	07	08	09	10	11	12	13	14
PARTS LIST 12EP													
DEVICE	QTY	DESCRIPTION				NAV. NUMBER	MANUFACTURER	PART NUMBER		TYPE NUMBER		PAGE	
-23Q1.	1	MOTOR PROT. THER. MAGN 4-6,3A ROTARY				28740	Schneider Electric BV	TELE.GV2P10		GV2P10		-70/13	
-24Q1.	1	MOTOR PROT. THER. MAGN 30-40A ROTARY				29181	Schneider Electric BV	TELE.GV3P40		GV3P40		-80/02	
-25Q1.	1	MOTOR PROT. THER. MAGN 17-23A ROTARY				28712	Schneider Electric BV	TELE.GV2P21		GV2P21		-80/05	
-26F2.	2	GLASS FUSE 05x20mm 04,00A FAST VE10				40173	Technische Unie BV	ESKA.05X20\F4,00A		20.64.00.610		-12/09	
-26F2.	2	TERMINAL 4,00mm2 FUSE UT4-HESI (5x20) 6A Black				89264	Phoenix Contact	PHOE.UT4-HESI(5X20)		UT4-HESI(5X20)		-12/09	
-26Q1.	1	MOTOR PROT. THER. MAGN 2,5-4A ROTARY				28739	Schneider Electric BV	TELE.GV2P08		GV2P08		-80/08	
-27Q1.	1	MOTOR PROT. THER. MAGN 0,63-1A ROTARY				28735	Schneider Electric BV	TELE.GV2P05		GV2P05		-80/11	
-28F1.	1	GLASS FUSE 05x20mm 04,00A FAST VE10				40173	Technische Unie BV	ESKA.05X20\F4,00A		20.64.00.610		-85/07	
-28F1.	1	TERMINAL 4,00mm2 FUSE UT4-HESI (5x20) 6A Black				89264	Phoenix Contact	PHOE.UT4-HESI(5X20)		UT4-HESI(5X20)		-85/07	
-28F2.	2	GLASS FUSE 05x20mm 02,00A FAST VE10				40170	Technische Unie BV	ESKA.05X20\F2,00A		20.64.00.580		-12/11	
-28F2.	2	TERMINAL 4,00mm2 FUSE UT4-HESI (5x20) 6A Black				89264	Phoenix Contact	PHOE.UT4-HESI(5X20)		UT4-HESI(5X20)		-12/11	
-28H4.	1	PILOT LIGHT P-LED WHITE 24VAC/DC HARMONY				75009	Schneider Electric BV	TELE.XB4BVB1		XB4BVB1		-86/04	
-28H5.	1	PILOT LIGHT P-LED BLUE 230VAC HARMONY				75016	Schneider Electric BV	TELE.XB4BVM6		XB4BVM6		-87/04	
-28H5.	1	OVER VOLTAGE ELEMENT 230VAC HARMONY				75010	Schneider Electric BV	TELE.ZBZ-VM		ZBZ-VM		-87/04	
-28K1.	1	CONTACTOR 3P 038A AC3 1NO+1NC 24VDC LC1-D38 TESI				28511	Schneider Electric BV	TELE.LC1D38BD		LC1D38BD		-86/11	
-28K1.	1	AUX. CONTACT TIME 1NO+1NC ON DELAY*/Y30SEC.V.BRC				28389	Schneider Electric BV	TELE.LADS2		LADS2		-86/11	
-28K2.	1	CONTACTOR 3P 038A AC3 1NO+1NC 24VDC LC1-D38 TESI				28511	Schneider Electric BV	TELE.LC1D38BD		LC1D38BD		-86/10	
-28K3.	1	CONTACTOR 3P 025A AC3 1NO+1NC 24V TESYS LC1D25BD				28563	Schneider Electric BV	TELE.LC1D25BD		LC1D25BD		-86/09	
-28K4.	1	AUX. RELAY MINIATURE 4P 7A 24VDC COMPLETE				35460	Finder	FIND.58.34.9.024.0050		58.34.9.024.0050		-86/03	
-28K5.	1	AUX. RELAY MINIATURE 4P 7A 24VDC COMPLETE				35460	Finder	FIND.58.34.9.024.0050		58.34.9.024.0050		-86/12	
-28P1.	1							DEIF.EQ96-X 5A/0-75//150A (SPECIAL ORDER AISP)				-87/06	
-28Q1.	1	MOTOR PROT. THER. MAGN 48-65A ROTARY				29183	Schneider Electric BV	TELE.GV3P65		GV3P65		-85/02	
-28Q1.	1	AUX. CONTACT 1NO (fault) + 1NO FRONT for GV3 TESYS				29175	Schneider Electric BV	TELE.GVAED101		GVAED101		-85/02	
-28S1.	1	HEAD PUSHBUTTON RED HARMONY				75132	Schneider Electric BV	TELE.ZB4BA4		ZB4BA4		-86/09	
-28S1.	1	PUSHBUTTON BODY 1NC HARMONY				75072	Schneider Electric BV	TELE.ZB4BZ102		ZB4BZ102		-86/09	
-28S3.	1	SELECTOR SWITCH 2P 20A 1-0-2 CH10 A211 FT2-V				19581	Kraus & Naimer	KRAU.CH10-A211FT2-V		CH10-A211FT2-V		-86/09	
-28SH2.	1	HEAD ILL. PUSHBUTTON GREEN for LED HARMONY				75175	Schneider Electric BV	TELE.ZB4BW333		ZB4BW333		-86/09	
-28SH2.	1	PUSHBUTTON BODY 1NO + P-LED GREEN 24V HARMONY				75085	Schneider Electric BV	TELE.ZB4BW0B31		ZB4BW0B31		-86/09	
-28T2.	1	CURRENT TRAFO for RAIL 75/5 2VA KL1				38619	ELEQ BV	FAGE.RM60N-E2A-75/5		RM60N-E2A-75/5		-85/03	
-28U1.	1	POWER SUPPLY 3ph-400VAC//22,5-29,5VDC-5A				38397	Phoenix Contact	PHOE.TRIO-PS/3AC/24DC/5		TRIO-PS/3AC/24DC/5		-85/06	
-28X2.	2	TERMINAL 2,50mm2 UT2,5 Screw Grey NS35/7,5/15				89200	Phoenix Contact	PHOE.UT2,5		UT2,5		-87/03	
-28X2.	1	END PART. for UT2,5-UT10 D-UT 2,5/10				89706	Phoenix Contact	PHOE.D-UT2,5/10		D-UT2,5/10		-87/03	
-28X2.	2	END-BRACKET FAST FIT CLIPFIX 35-5				89820	Phoenix Contact	PHOE.CLIPFIX35-5		CLIPFIX35-5		-87/03	
-28X3.	15	TERMINAL 2,50mm2 UT2,5 Screw Grey NS35/7,5/15				89200	Phoenix Contact	PHOE.UT2,5		UT2,5		-86/03	
-28X3.	1	END PART. for UT2,5-UT10 D-UT 2,5/10				89706	Phoenix Contact	PHOE.D-UT2,5/10		D-UT2,5/10		-86/03	
-28X3.	1	END-BRACKET FAST FIT CLIPFIX 35-5				89820	Phoenix Contact	PHOE.CLIPFIX35-5		CLIPFIX35-5		-86/03	
-28X5.	11	TERMINAL 2,50mm2 UT2,5 Screw Grey NS35/7,5/15				89200	Phoenix Contact	PHOE.UT2,5		UT2,5		-87/08	
-28X5.	1	END PART. for UT2,5-UT10 D-UT 2,5/10				89706	Phoenix Contact	PHOE.D-UT2,5/10		D-UT2,5/10		-87/08	
-28X5.	1	END-BRACKET FAST FIT CLIPFIX 35-5				89820	Phoenix Contact	PHOE.CLIPFIX35-5		CLIPFIX35-5		-87/08	
-29Q1.	1	MOTOR PROT. THER. MAGN 2,5-4A ROTARY				28739	Schneider Electric BV	TELE.GV2P08		GV2P08		-85/09	
< 8000.g 8000.i >													
4-1-2011	PVR			  ALEWIJNSE MARINE B.V. ENERGIEWEG 46/C 6541 CX NIJMEGEN	IHC DREDGERS BV - TSHD5500 DCI-3 "12EP" EMERGENCY DISTRIBUTION BOARD 3X415V PARTS LIST							Yard no : CO1266	
-12-2013	IEN	REV	1									Project : 23000143	
S BUILT												Class : LROS/IRS	
5-12-2013	IEN	CHK										Page : 12EP -8000.h	

No part of this work may be copied, stored or published without prior written permission of Alewijnse Marine Systems.

< 8000.h

==12S1/0 >

	01	02	03	04	05	06	07	08	09	10	11	12	13	14
PARTS LIST12EP														
DEVICE	QTY	DESCRIPTION					NAV. NUMBER	MANUFACTURER	PART NUMBER		TYPE NUMBER		PAGE	
-30F2.	2	GLASS FUSE 05x20mm 02,00A FAST VE10					40170	Technische Unie BV	ESKA.05X20\F2,00A		20.64.00.580		-12/13	
-30F2.	2	TERMINAL 4,00mm2 FUSE UT4-HESI (5x20) 6A Black					89264	Phoenix Contact	PHOE.UT4-HESI(5X20)		UT4-HESI(5X20)		-12/13	
-30Q1.	1	MOTOR PROT. THER. MAGN 13-18A ROTARY					28743	Schneider Electric BV	TELE.GV2P20		GV2P20		-85/12	